



FAX BEING SENT BY:

2-18-98

208 West El Piñado Dr.
Danville, CA 94526

Aqua Science Engineers, Inc.
2411 Old Crow Canyon Road, #4
San Ramon, CA 94583
Phone (510) 820-9391
Fax (510) 837-4853

Informed. David
location is okay. He
will submit a
workplan.

DATE: 2-9-98

TO: Mr. Larry Seto

FROM: David Allan

NUMBER OF PAGES TO FOLLOW: 1

*****Please Phone If This Fax Is Received Incomplete*****

MESSAGE:

Please provide opinion to location of the
3 proposed monitoring wells to be located on
726 Harrison Street. Please call me at
820-9391 when you've reviewed the case.

Thanks,
Dave




NORTH

SCALE
1" = 50'

GROUNDWATER
FLOW DIRECTION
BASED ON
NEIGHBORING SITES

Southwest

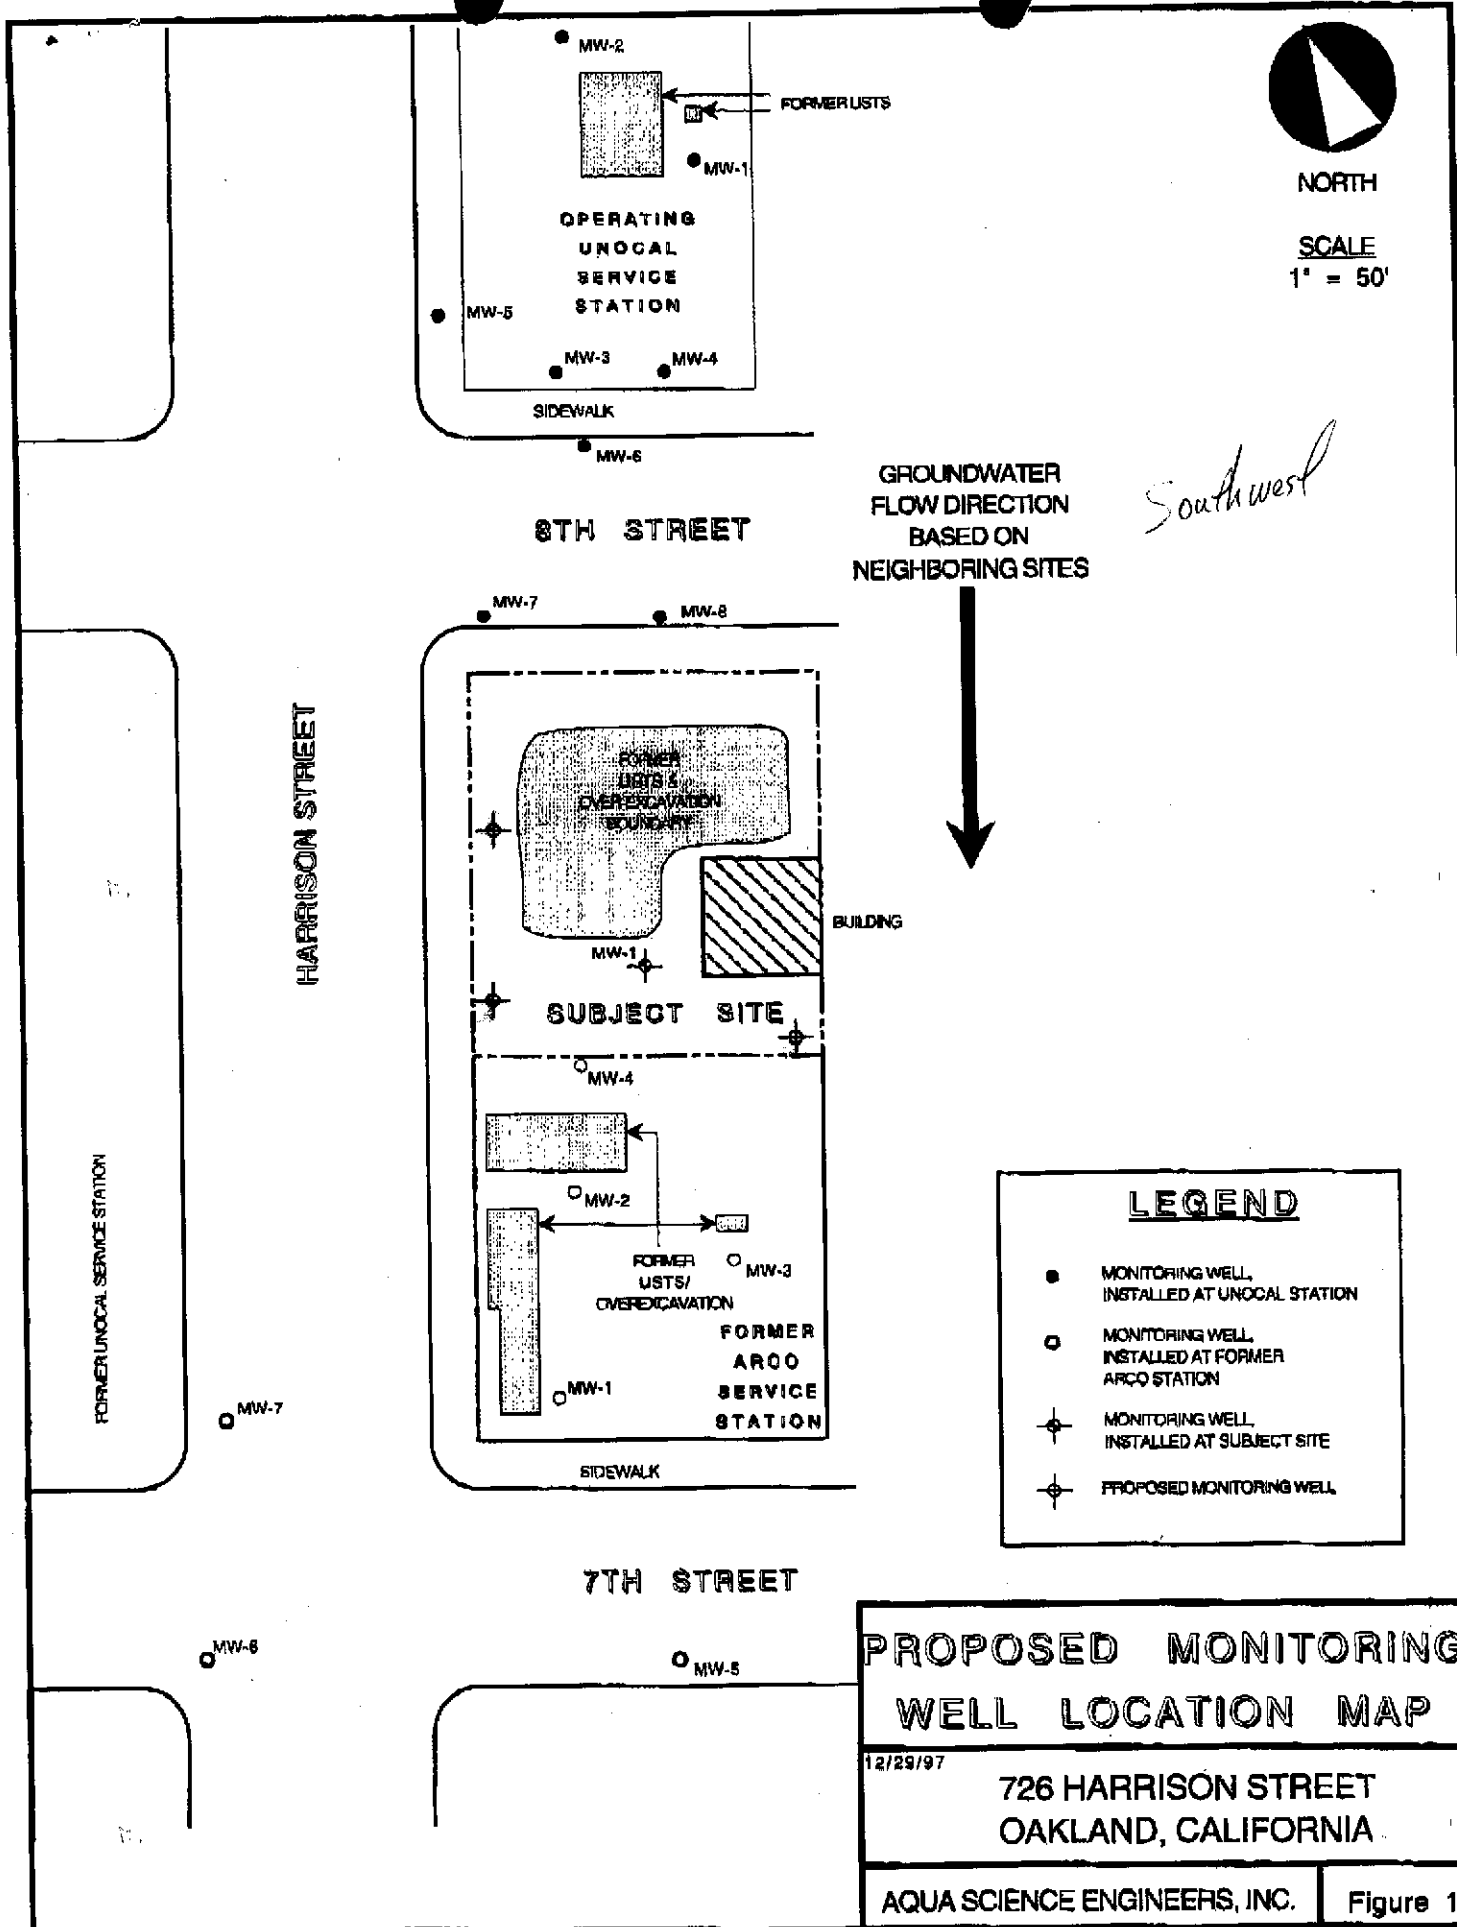

LEGEND

- MONITORING WELL, INSTALLED AT UNOCAL STATION
- MONITORING WELL, INSTALLED AT FORMER ARCO STATION
- ⊕ MONITORING WELL, INSTALLED AT SUBJECT SITE
- ⊕ MONITORING WELL, PROPOSED

PROPOSED MONITORING WELL LOCATION MAP

12/29/97
726 HARRISON STREET
OAKLAND, CALIFORNIA