

LETTER OF TRANSMITTAL

DATE <u>10/4/94</u>	JOB NO.
ATTENTION <u>WENDY</u>	
RE:	

TO: ECRV, INC
1611 S AIRPORT WAY
STOCKTON, CA 95206
STID 1683

WE ARE SENDING YOU Attached Under separate cover via _____ the following items:

- Shop drawings Prints Plans Samples Specifications
 Copy of letter Change Order _____

COPIES	DATE	NO.	DESCRIPTION
			TABLE 1 - SOIL SAMPLE ANALYTICAL RESULTS
			TABLE 2 - SOIL SAMPLE ANALYTICAL RESULTS
			SITE PLAN

THESE ARE TRANSMITTED as checked below:

- For approval Approved as submitted Resubmit _____ copies for approval
 For your use Approved as noted Submit _____ copies for distribution
 As requested Returned for corrections Return _____ corrected prints
 For review and comments _____
 FOR BIDS DUE _____ 19____ PRINTS RETURNED AFTER LOAN TO US

REMARKS _____

COPY TO _____

SIGNED: Lee Huchins

If enclosures are not as noted, kindly notify us at once.

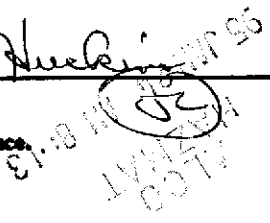


TABLE 2
SUMMARY OF SOIL SAMPLE ANALYTICAL RESULTS
FOR METALS
(ppm¹)

Sample ID Name	Date	Cadmium	Chromium	Lead	Nickel	Zinc
WO-1	08/05/94	<.250	12.000	4.300	38.000	71.000

¹ PARTS PER MILLION


TABLE 1
SUMMARY OF SOIL SAMPLE ANALYTICAL RESULTS
(ppm¹)

Sample ID Name	Date	Depth (Feet)	TPHD	TPHG	Benzene	Toluene	Ethyl-benzene	Xylenes	Oil & Grease
S-1	08/05/94	11	NA ²	6.500	.180	.082	.370	1.200	NA
S-2	08/05/94	11	NA	3.200	.110	<.0050	.160	.210	NA
S-3	08/05/94	11	NA	540.000	<1.500	4.100	24.000	72.000	NA
S-4	08/05/94	11	NA	73.000	<.067	.210	1.500	6.800	NA
S-5	08/05/94	11	NA	.840	<.0050	<.0050	<.0050	.031	NA
S-6	08/05/94	11	NA	40.000	<.014	.059	.250	.600	NA
SP1-A, B, C, D	08/05/94	1.5	NA	150.000	<.074	.140	1.700	4.500	NA
WO-1 ³	08/05/94	6	1.200	21.000	<.015	.110	.340	1.500	94.000

¹ PARTS PER MILLION


² NOT ANALYZED

³ ALSO ANALYZED FOR VOLATILE ORGANICS BY EPA METHOD 8010; ALL RESULTS WERE NONDETECTABLE.

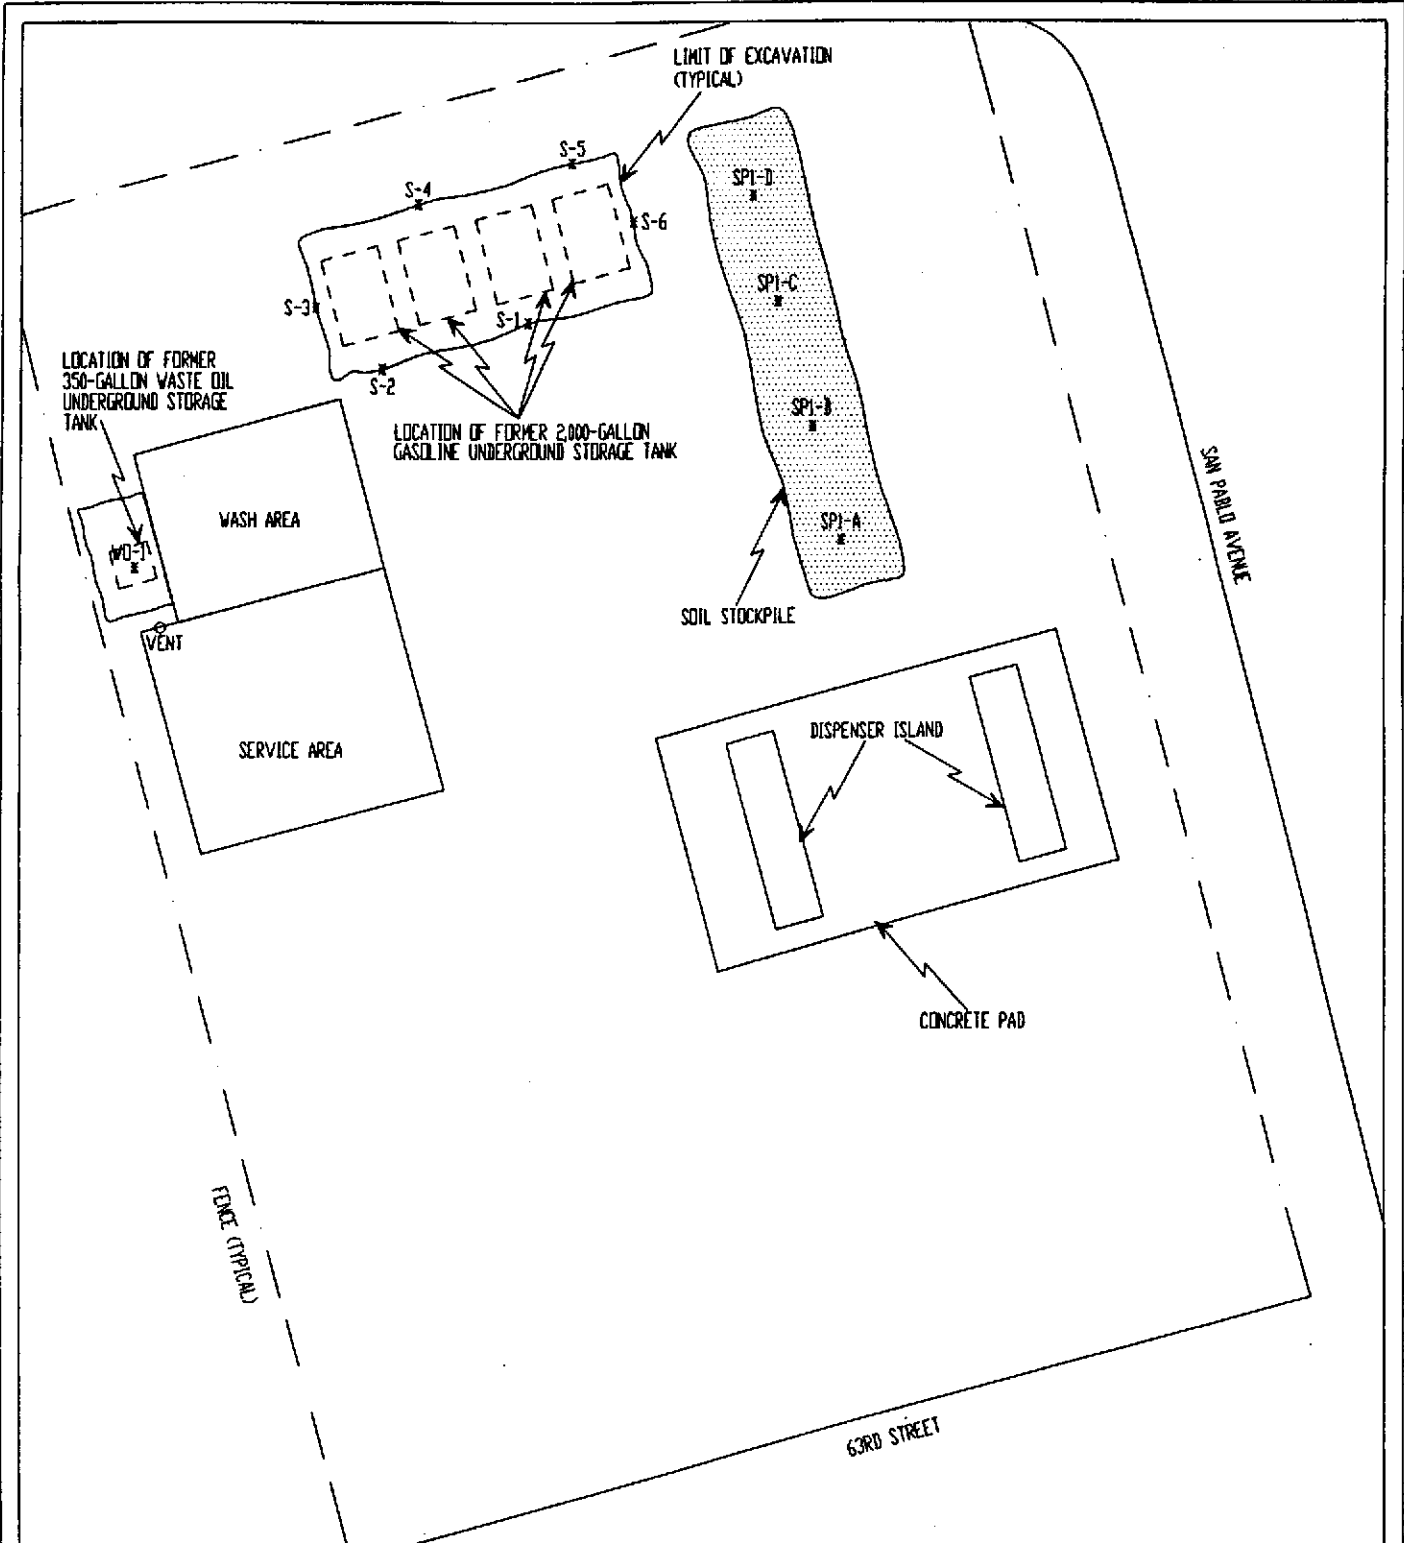

LEGEND

SPI-A * NAME AND LOCATION OF SOIL SAMPLE

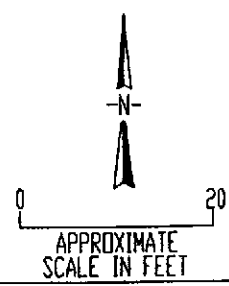

TANK PROTECT ENGINEERING

SITE PLAN:
TANK REMOVAL (8/5/94)

ECRU, INC.
6301 SAN PABLO AVENUE
OAKLAND, CA 94608

DATE	8/15/94
FIGURE	1
FILE #	314-1
DRAWN BY	NT
CHECKED BY	