



LETTER OF TRANSMITTAL

DATE	8/17/94	JOB NO.	314
ATTENTION	Susan Hugo		
RE:	ECRU, Inc.		

TO: Alameda County Health Care Services Agency
1131 Harbor Bay Parkway, 2nd Floor
Alameda, CA 94502

WE ARE SENDING YOU Attached Under separate cover via mail the following items:

- Shop drawings
 Prints
 Plans
 Samples
 Specifications
 Copy of letter
 Change Order

COPIES	DATE	NO.	DESCRIPTION
1	8/5/94		Site Plan: Tank Removal (8/5/94)
1	8/17/94		Underground Storage Tank Unauthorized Release (Leak)/Contamination Site Report

THESE ARE TRANSMITTED as checked below:

- For approval
 Approved as submitted
 Resubmit _____ copies for approval
 For your use
 Approved as noted
 Submit _____ copies for distribution
 As requested file
 Returned for corrections
 Return _____ corrected prints
 For review and ~~document~~

 FOR BIDS DUE _____ 19____ PRINTS RETURNED AFTER LOAN TO US


REMARKS _____

COPY TO File

82:8 113 61 NOV 16
 19 AUG 19 PM 3:28
 HAZMAT
 COPY


SIGNED: *[Signature]*

If enclosures are not as noted, kindly notify us at once.

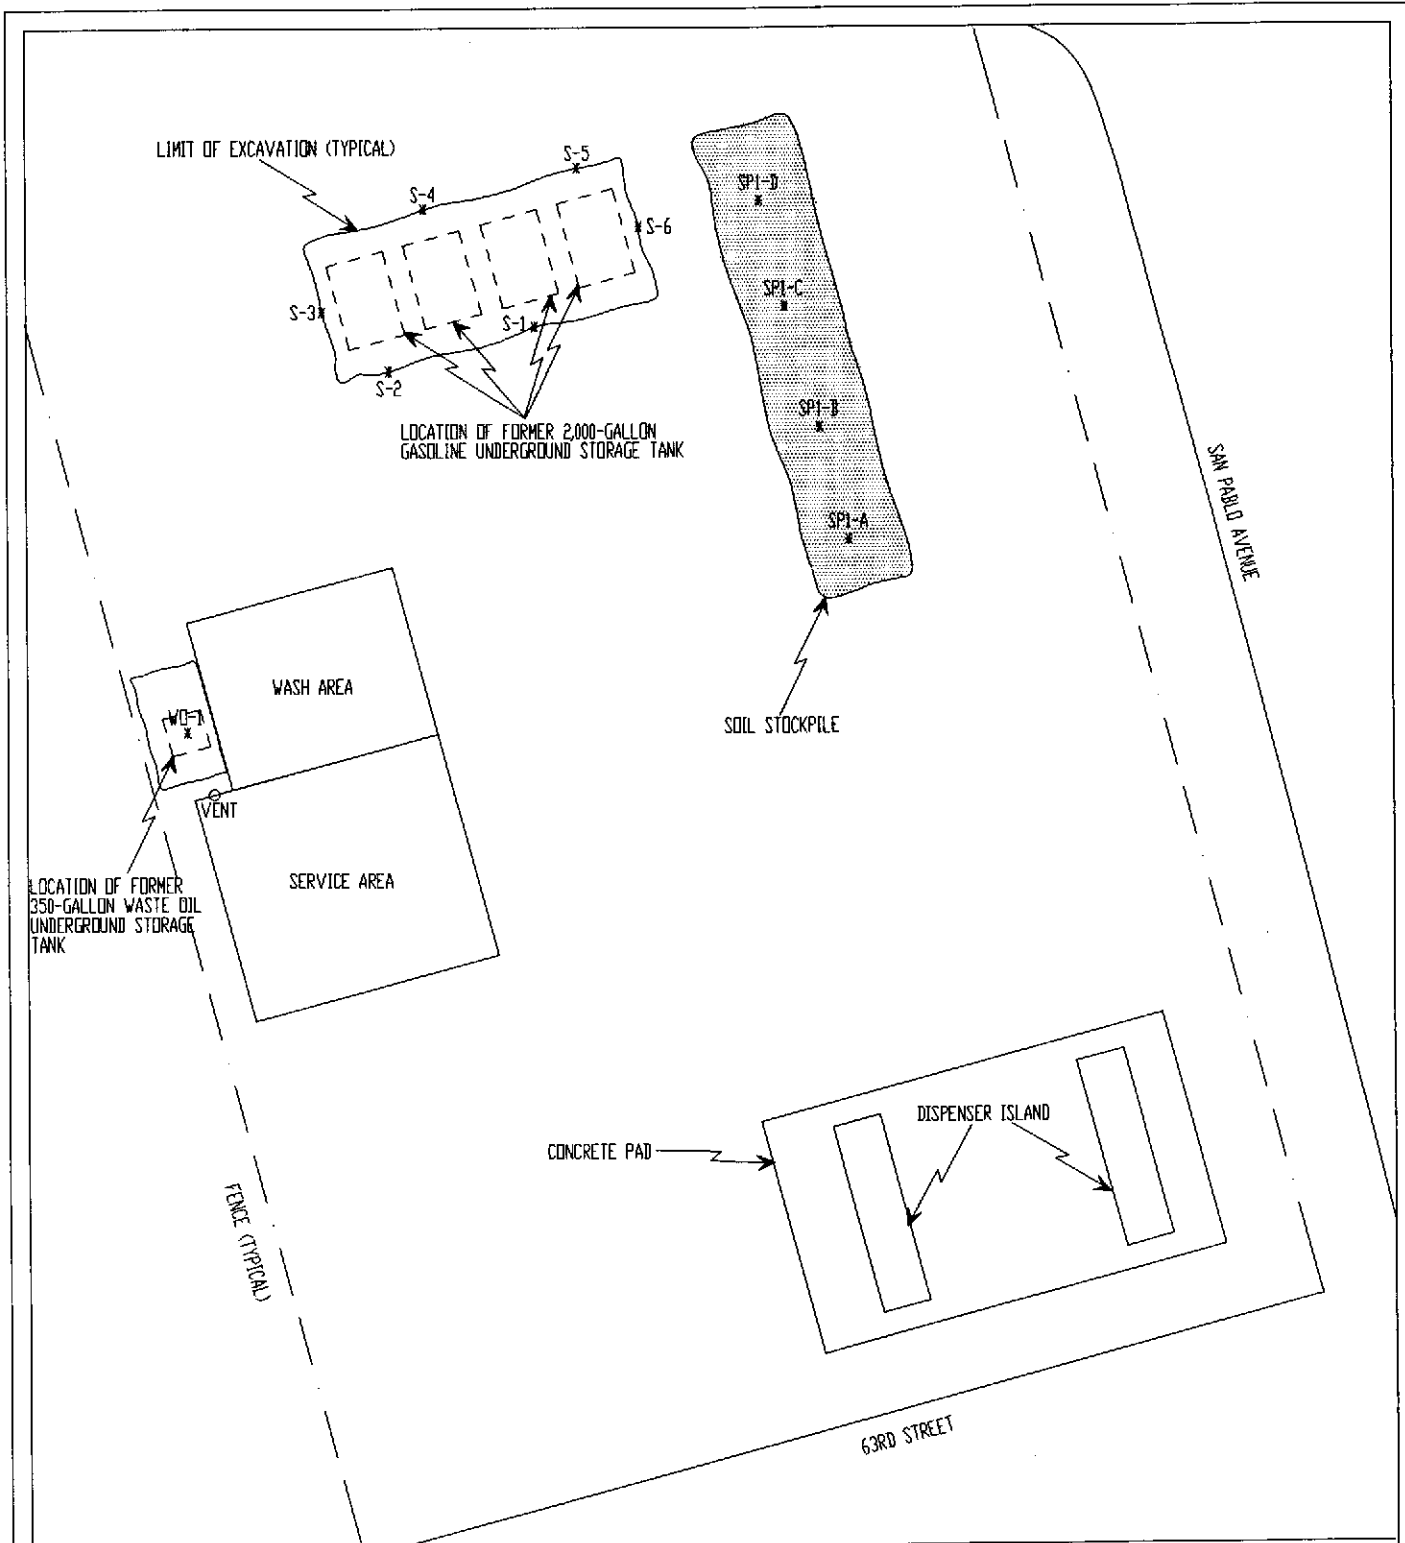

LEGEND

SP1-A * NAME AND LOCATION OF SOIL SAMPLE

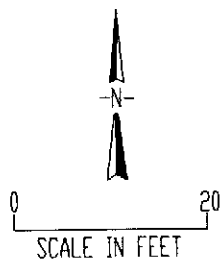

TANK PROTECT ENGINEERING

SITE PLAN:
TANK REMOVAL (8/5/94)

ECRU, INC.
6301 SAN PABLO AVENUE
OAKLAND, CA 94608

DATE	8/15/94
FIGURE	1
FILE #	314-1
DRAWN BY	MT
CHECKED BY	