

ALAMEDA COUNTY  
HEALTH CARE SERVICES

AGENCY  
DAVID J. KEARS, Agency Director



RAFAT A. SHAHID, Assistant Agency Director

DEPARTMENT OF ENVIRONMENTAL HEALTH  
Hazardous Materials Division  
80 Swan Way, Rm. 200  
Oakland, CA 94621  
(510) 271-4320

**REMEDIAL ACTION COMPLETION CERTIFICATION**

StID 714 - 14100 Doolittle Dr, San Leandro, CA 94577

March 27, 1995

Mr. Don Elgie  
P.O. Box 203  
Orinda, CA 94563

Dear Mr. Elgie:

This letter confirms the completion of site investigation and remedial action for the 8,000 gallon gasoline underground storage tank removed from the above site in July 1987.

Based upon the available information and with the provision that the information provided to this agency was accurate and representative of site conditions, no further action related to the underground tank release is required.

This notice is issued pursuant to a regulation contained in Title 23, Division 3, Chapter 16, Section 2721(e) of the California Code of Regulations. Please contact Ms. Eva Chu at (510) 567-6700 if you have any questions regarding this matter.

Very truly yours,

Rafat A. Shahid, Director

cc: Edgar B. Howell, Chief, Hazardous Materials Division  
Kevin Graves, RWQCB  
Mike Harper, SWRCB (with attachment)  
files (elgie2)

MAR 13 1995 KG

95 MAR 21 PM 1:56

QUALITY CONTROL BOARD

CASE CLOSURE SUMMARY
Leaking Underground Fuel Storage Tank Program

I. AGENCY INFORMATION

Date: January 20, 1995

Agency name: Alameda County-HazMat
City/State/Zip: Alameda, CA 94502
Responsible staff person: Eva Chu

Address: 1131 Harbor Bay Pkwy
Phone: (510) 567-6700
Title: Hazardous Materials Spec.

II. CASE INFORMATION

Site facility name: Don Elgie Property
Site facility address: 14100 Doolittle Dr, San Leandro 94577
RB LUSTIS Case No: N/A Local Case No./LOP Case No.: 714
URF filing date: 1/20/95 SWEEPS No: N/A

Responsible Parties: Don Elgie
Addresses: P.O. Box 203, Orinda 94563
Phone Numbers: 510-254-1376

Table with 5 columns: Tank No, Size in gal., Contents, Closed in-place or removed?, Date. Row 1: 1, 8,000, Gasoline, Removed, July 1987

III. RELEASE AND SITE CHARACTERIZATION INFORMATION

Cause and type of release: Unknown
Site characterization complete? YES
Date approved by oversight agency: 1/4/95
Monitoring Wells installed? Yes Number: 3
Proper screened interval? Yes, 13.5 - 24' bgs
Highest GW depth below ground surface: 2.80' Lowest depth: 4.18'
Flow direction: NW
Most sensitive current use: Domestic well
Are drinking water wells affected? No Aquifer name:
Is surface water affected? No Nearest affected SW name: NA
Off-site beneficial use impacts (addresses/locations): NA

Report(s) on file? YES Where is report(s) filed? Alameda County
1131 Harbor Bay Pkwy
Alameda, CA 94502

**Treatment and Disposal of Affected Material:**

<u>Material</u>	<u>Amount (include units)</u>	<u>Action (Treatment or Disposal w/destination)</u>	<u>Date</u>
Tank	1 UST	Erickson	July 1987
Piping			
Free Product			
Soil			
Groundwater			
Barrels			

Contaminant	Maximum Documented Contaminant Concentrations - - Before and After Cleanup			
	Soil (ppm)		Water (ppb)	
	<u>Before</u>	<u>After</u>	<u>Before</u>	<u>After</u>
TPH (Gas)	NT	110	1,400*	ND
TPH (Diesel)				
Benzene	NT	.084	ND	ND
Toluene		ND	ND	ND
Ethylbenzene		1.5	ND	ND
Xylenes		11.0	10	ND
Oil & Grease				
Heavy metals				
Other				

\* Initial groundwater sample from well MW-1, on 1/13/89.

**Comments (Depth of Remediation, etc.):**

A groundwater grab sample collected from the pit at the time of the UST removal exhibited up to 170 ppm TPH-G, 91, 260, 1,800 ppb BTX, respectively. No soil samples were collected at the time of removal.

**IV. CLOSURE**


Does completed corrective action protect existing beneficial uses per the Regional Board Basin Plan? **YES**  
 Does completed corrective action protect potential beneficial uses per the Regional Board Basin Plan? **YES**  
 Does corrective action protect public health for current land use? **YES**  
 Site management requirements: **None**

Should corrective action be reviewed if land use changes? **YES**  
 Monitoring wells Decommissioned: **None, pending site closure**  
 Number Decommissioned: **0** Number Retained: **3**  
 List enforcement actions taken: **None**

List enforcement actions rescinded: **NA**

V. LOCAL AGENCY REPRESENTATIVE DATA

Name: Eva Chu Title: Haz Mat Specialist


Signature:  Date: 3/9/95

Reviewed by

Name: Robert Weston Title: Sr. Haz Mat Specialist

Signature:  Date: 3/9/95


Name: Madhulla Logan Title: Haz Mat Specialist

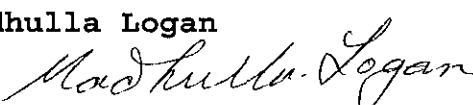Signature:  Date: 3/9/95

VI. RWQCB NOTIFICATION

Date Submitted to RB: 3/10/95 RB Response: 

RWQCB Staff Name: Kevin Graves Title: AWRCE <sup>EG (Spec)</sup>

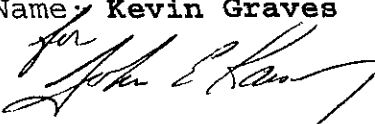Signature:  Date: 3/11/95

VII. ADDITIONAL COMMENTS, DATA, ETC.

When an 8K gasoline UST was removed in July 1987, a groundwater grab sample collected exhibited up to 170,000 ppb TPH-G, 91, 260, and 1,800 ppb BTX, respectively. Soil samples were not collected.

On Jan 5, 1989 a monitoring well was installed within the former tank pit. Soil samples collected from the boring at 13, 18, and 23' depths did not detect TPH-G or BTEX above the detection limits. However, groundwater detected low levels of TPH-G and xylene. Following three additional quarterly sampling events, groundwater still detected up to 590 ppb TPH-G, 7.5 ppb benzene and low levels of toluene, ethylbenzene, and xylenes.

Another well MW-2 was installed within 7.0' and southwest of the former tank pit. Soil from 5' exhibited 110 ppm TPH-G, 84, 350, and 2,800 ppb BEX, respectively. A groundwater sample detected 380 ppb TPH-G, 21, 19, 12, and 86 ppb BETX, respectively.

To verify groundwater flow direction three temporary piezometers were installed. Groundwater appears to flow to the N-NW, with a hydraulic gradient of .002 ft/ft. The piezometers were immediately abandoned by drilling out the casings and filling with cement grout after surveying.

So, well MW-3 was installed N-NW of the former tank pit in February 1991. Soil from 5' detected up to 91 ppm TPH-G, .051, .320, 1.5, and 11 ppm BTEX, respectively. The groundwater samples did not detect these constituents.



It appears there are two shallow, perched zones, one at 4-5.5' and the other at 9.2-11.0' depths. A deeper, silty sand water-bearing zone beginning at approximately 14' depth is confined. Well MW-3 is screened in the confined aquifer. This aquifer does not appear to be impacted by the petroleum hydrocarbon release as verified by 5 consecutive quarters of sampling, from Feb 1991 - Mar 1993, without detecting TPH-G or BTEX.

The shallow perched waters appear to be impacted with low levels of petroleum hydrocarbons. However, levels do not exceed RBCA lookup tables. It does not appear to have migrated to the lower aquifer. Residual hydrocarbons in soil and perched waters should naturally attenuate through absorption, dispersion, and biodegradation. Continued monitoring is not warranted, and site closure is recommended.

DOOLITTLE DRIVE


BUILDING

CATALINA STREET

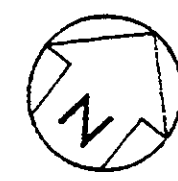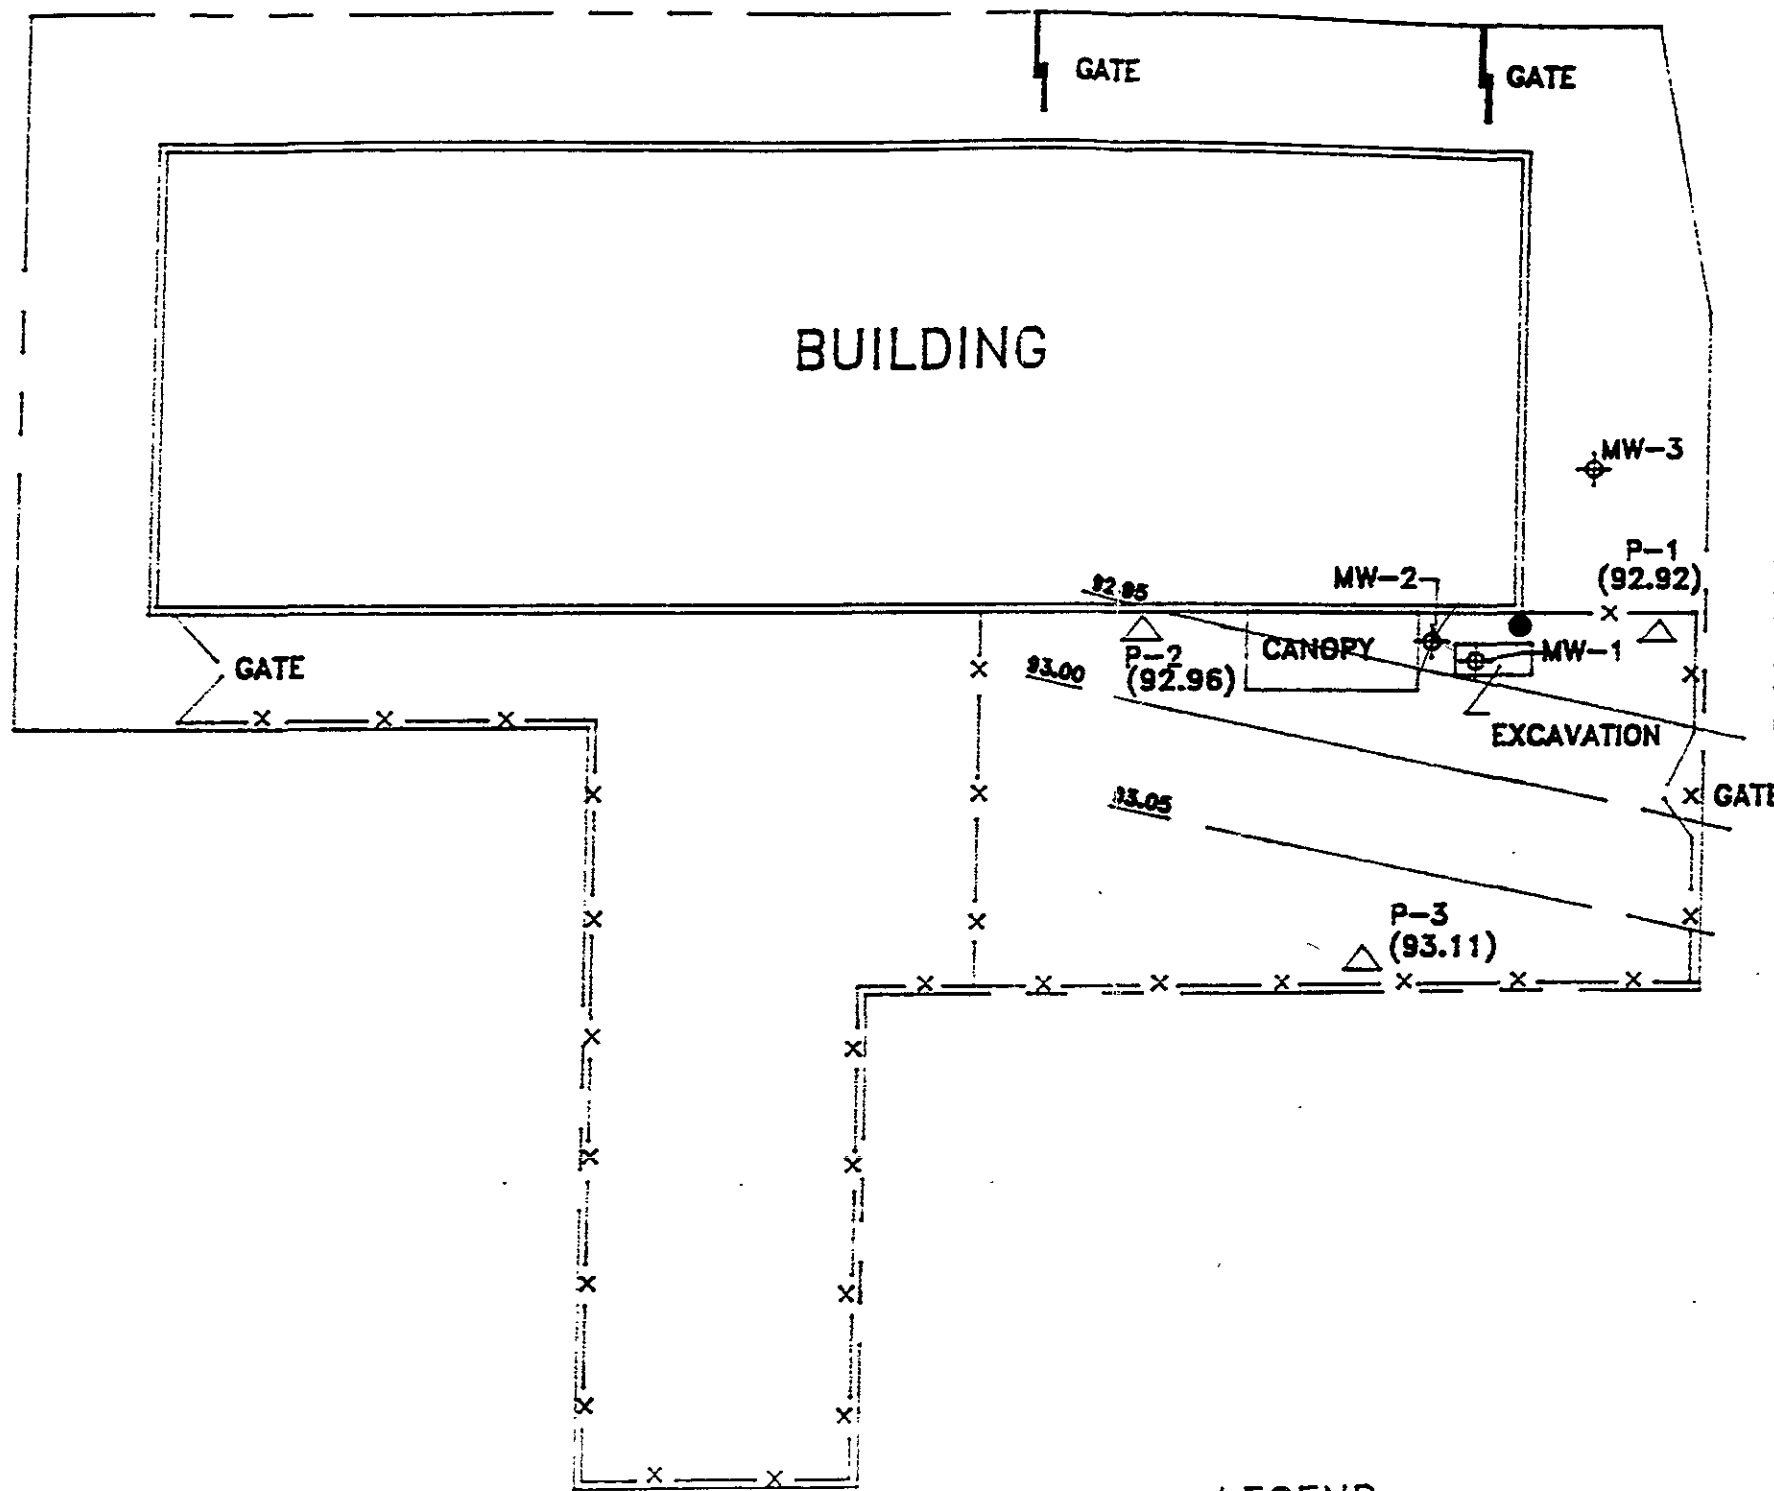

↑  
DIRECTION  
OF  
GROUNDWATER  
FLOW

WATER LEVEL  
MEASUREMENTS  
TAKEN ON  
JANUARY 31, 1991.

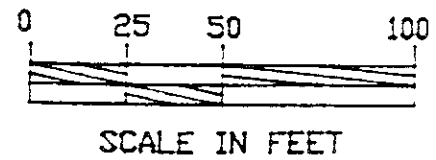

LEGEND

- ⊕ MONITORING WELL
- △ PIEZOMETER
- (93.11) GROUNDWATER ELEVATION (IN FEET)
- BENCHMARK (ASSUMED 100 FEET)

REV	DESCRIPTION	DATE BY
BLYMYER ENGINEERS, INC ALAMEDA, CALIFORNIA		
SCALE SHOWN	FOR DON ELGE PROPERTY SAN LEANDRO, CA	
DRAWN DATE	LW 2/91	
APPROVED	TITLE	GROUNDWATER CONTOUR MAP
JOB 91012	DWG. NO.	FIGURE 3

**Table 1. Summary of Soil Sample Analytical Results**  
**BEI Job No. 91012, Don Elgie Property**  
**14100 Doolittle Drive, San Leandro, CA**

Sample Identification (feet bgs)	Modified EPA Method 8015 (mg/kg)	EPA Method 8020 (µg/kg)			
	TPH as Gasoline	Benzene	Ethylbenzene	Toluene	Total Xylenes
MW-1 (13-13.5')	<1	<40	<40	<40	<40
MW-1 (18-18.5')	<1	<40	<40	<40	<40
MW-1 (23-23.5')	<1	<40	<40	<40	<40
MW-2 (5')	110	84	850	<25	2,800
MW-2 (11')	<1	<2.5	<2.5	<2.5	5
MW-3 (5')	91	51	1,500	320	11,000
MW-3 (9')	<1	<2.5	2.6	11	<2.5
MW-3 (14')	<1	<2.5	<2.5	<2.5	<2.5

< x = not detected at or above method detection limit (x)  
 bgs = below grade surface  
 mg/kg = milligrams per kilogram  
 µg/kg = microgram per kilogram  
 TPH = Total Petroleum Hydrocarbons

**Table II. Summary of Groundwater Sample Analytical Results**  
**BEL Job No. 91012, Dan Elgie Property**  
**14100 Daofittle Drive, San Leandro, CA**

Well No.	Sampling Date	Modified Method 8015 (mg/L)	EPA Method 8020 (µg/L)			
			TPH as Gasoline	Benzene	Ethylbenzene	Toluene
MW-1	1/5/89*	1.4	<10	<10	<10	10
	3/29/89	0.20	<0.1	2.2	0.49	6.2
	8/22/89	0.59	7.5	3.4	6.2	22
	11/21/89	0.24	3.4	2.3	0.71	9.1
	5/30/91	0.20	0.6	0.6	0.8	<0.5
	8/29/91	0.25	6.8	15	<0.5	10
	12/6/91	0.12	<0.5	<0.5	<0.5	0.7
	3/10/92	<0.05	<0.5	<0.5	<0.5	<0.5
	7/27/94	ND	ND	ND	ND	ND
MW-2	8/27/90	0.38	21	19	12	89
	5/30/91	0.25	9.9	11	<0.5	16
	8/29/91	0.21	<0.5	<0.5	<0.5	0.8
	12/6/91	0.33	18	20	1.3	30
	3/10/92	0.72 720	38	45	3.7	93
MW-3	2/28/91	<0.05	<0.5	<0.5	<0.5	<0.5
	5/30/91	<0.05	<0.5	<0.5	<0.5	<0.5
	8/29/91	<0.05	<0.5	<0.5	<0.5	<0.5
	12/6/91	<0.05	<0.5	<0.5	<0.5	<0.5
	3/10/92	<0.05	<0.5	<0.5	<0.5	<0.5

<x = not detected at or above method detection limit (x)  
mg/L = milligrams per Liter  
µg/L = microgram per Liter  
TPH = Total Petroleum Hydrocarbons





INDUSTRIAL HYGIENE SERVICES  
8190 Old Tunnel Road  
Lafayette, CA 94549  
(415) 930-8282

CGA CORPORATION MONITORING WELL  
14100 DOOLITTLE DRIVE  
SAN LEANDRO, CA  
AS-BUILT DIAGRAM


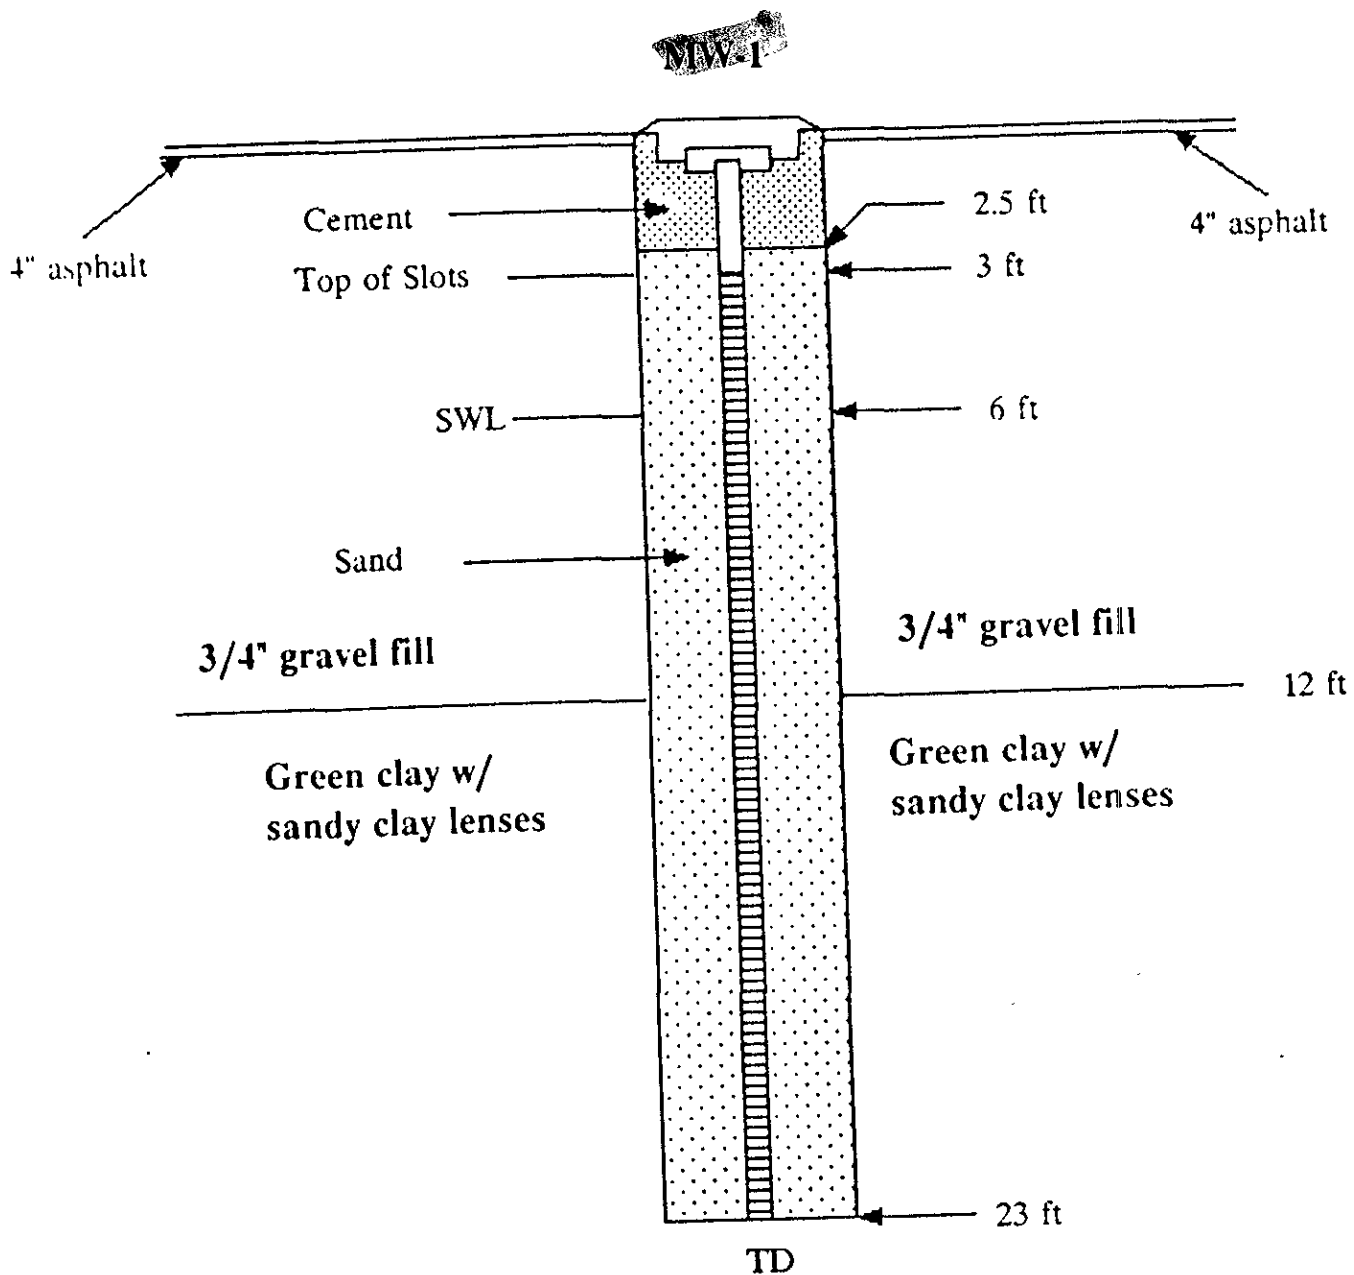


FIGURE 3

# BLMYER ENGINEERS, INC.

CLIENT DON ELGIE  
 SITE 14100 DOOLITTLE AVE  
 SAN LEANDRO, CA  
 DRILLER GREGG DRILLING  
 LOGGED BY DELANE FITZPATRICK

BORING/WELL NO ~~1012~~  
 TOP OF CASING ELEV  
 GROUND SURFACE ELEV  
 DATUM  
 JOB # 90250

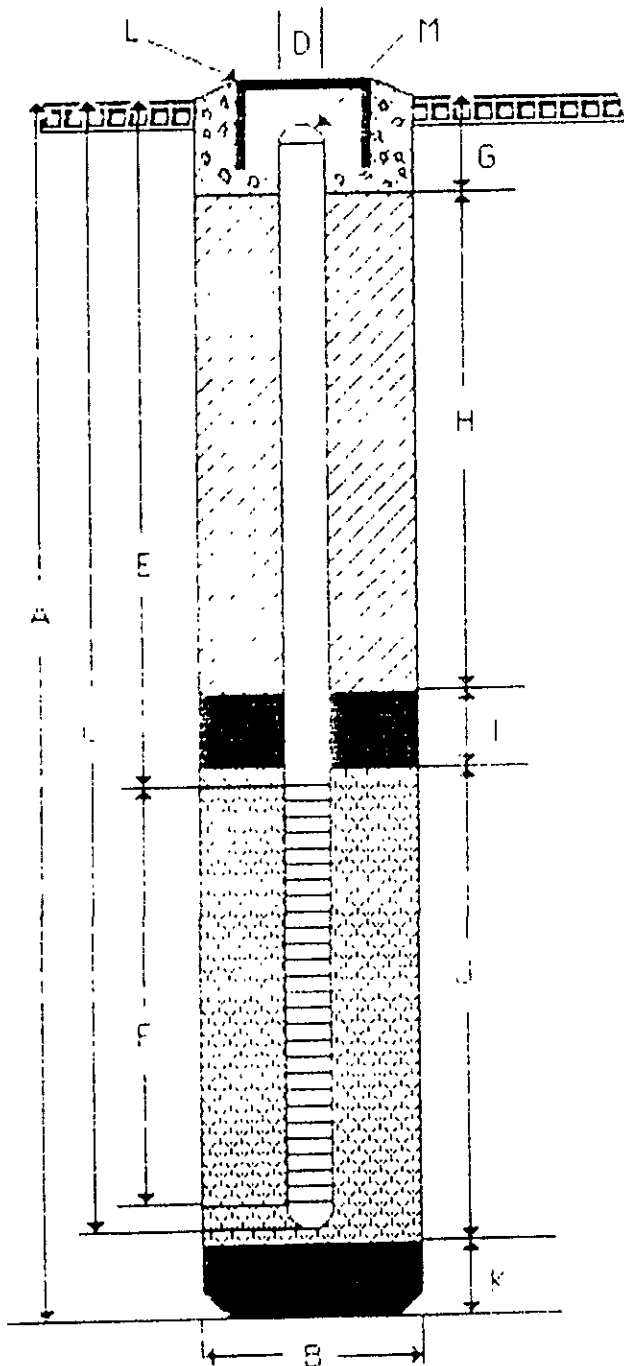

## WELL CONSTRUCTION

A	TOTAL DEPTH	16.8	FT
B	DIAMETER	8.0	IN
	DRILLING METHOD	HOLLOW STEM AUGER	
C	CASING LENGTH	15.8	FT
	MATERIAL	SCH 40 PVC	
D	CASING DIAMETER	20	IN
E	DEPTH TO TOP PERFORATIONS	8.5	FT
F	PERFORATED LENGTH	10.5	FT
	PERFORATED INTERVAL FROM	<del>10.5</del>	
	PERFORATION TYPE	3/16	
	PERFORATION SIZE	0.020	
G	SURFACE SEAL	10	FT
	SEAL MATERIAL	CONCRETE	
H	BACKFILL	4.3	FT
	BACKFILL MATERIAL	NEAT CEMENT	
I	SEAL	10	FT
	SEAL MATERIAL	BENTONITE	
J	GRAVEL PACK	10.5	FT
	PACK MATERIAL	#3 SAND	
K	BOTTOM SEAL		FT
	SEAL MATERIAL	N/A	
L	WELL BOX		
M	LOCKING WELL CAP		

# Blymyer Engineers, Inc.

Exploratory Bore Log

Client DON ELGIE  
 Site 14100 DOOLITTLE AVE  
 SAN LEANDRO, CA

Date 8/22/90  
 Job# 90250  
 Rig H.S.A.

Driller GREGG DRILLING  
 Logged by DELANE FITZPATRICK

Diameter 8"  
 Boring No. 11W-2

Description and Classification			Depth	Sample	Notes
Description and Remarks	Blow Counts	Soil Type			
<p>chalt, gravel, sand subgrade</p> <p>du-black clay, odor, medium plasticity, moderately dense, minor silt, damp</p> <p>ark grey clay, mild odor (no sand), see above, damp</p> <p>ey clay, odor, organic material or degrade gravels, top sample tube empty, damp, some backfill (sand)</p> <p>edium grey plastic clay, minor coarse fraction, e.g., bbbles (1-2mm), moderately dense, no odor</p> <p>thick (approx 1' water bearing clay, grey clay, sticky, stic, wet, coarse pebbles (2-5 mm) degraded, minor silt</p> <p>se, dark grey clay, coarse pebbles 1-2mm (10%), non-stic, no odor, damp, silt minor, no sand</p> <p>t grey clay, plastic, moderately dense, moist, minor silt</p> <p>ndu clay grading to silty clay, wet at 16 &amp; ft</p> <p>own medium sand in clay, plastic, moderately dense, no or, some silt, moist, 1/8 coarse pebbles (2-3mm)</p>	<p>3-5-6</p> <p>5-5-8</p> <p>3-8-17</p>	<p>CL</p> <p>CL</p> <p>CL</p> <p>CL</p> <p>CL</p> <p>CL</p> <p>CL</p> <p>CL</p>	<p>1</p> <p>5</p> <p>15</p> <p>20</p> <p>25</p> <p>30</p>	<p>X</p> <p>X</p> <p>X</p> <p>X</p> <p>X</p>	<p>Initial water level</p>

Mw-2 bor

# BLMYER

ENGINEERS, INC.  
 JOB#: 91012  
 SITE: SAN LEANDRO



LOG OF BORING NO. MW-3  
 CLIENT: DON ELGIE  
 DRILLER: GREGG DRILLING  
 LOGGED BY: H.W. SHORT

DATE: 2-6-91  
 RIG: MOBILE B-53  
 DIAMETER: 8"

DEPTH (FT)	BLOWS/6 IN.	P.I.D. (PPM)	SAMPLE TYPE AND DEPTH	UNIFIED SOIL CLASSIFICATION	EXPLANATION	GRAPHIC LOG	WATER DEPTH
					DESCRIPTION		
0				CONCRETE	0.0-0.4' CONCRETE		
	3-5-6			CL	0.4-4.0' BROWN SANDY CLAY, VERY PLASTIC		
5	7-10-17		SOIL S-1	SC	4.0-5.5' BROWN, CLAYEY SAND, WET, FINE GRAINED, LOW PLASTICITY		4.5'
	6-10-15			CH	5.5-9.2' GRAY CLAY, VERY PLASTIC, SOME DARK ORGANIC MATTER		
10	7-9-17		SOIL S-2	CL	9.2-11.0' BROWN SANDY CLAY, WET		10.5'
				CH	11.0-14.0' GRAY, STIFF, PLASTIC CLAY		
15			SOIL S-3	SM	14.0-22.0' SILTY SAND, BROWN, WET, FINE GRAINED 1/2-3/4' GRAVELS, MICACEOUS		14.0'
20				CH	22.0-24.0' GRAY PLASTIC CLAY, FAT		
25					TOTAL DEPTH 24 FEET		