

line from well #1 to point a is the line of strike of the planar surface of the water table.

distance x = distance from well #3 to point a.

point a is at the same elevation as well #1, but lies along the line from well #2 to well #3.

Finding Point a:

$$\frac{203.26 - 203.16}{204.70 - 203.16} = \frac{0.10}{1.24} = \frac{x}{70.5} \quad \& \quad x = 5.67'$$

Gradient Calculation:

$$\frac{204.40 - 203.26}{28'} = \frac{1.14'}{28'} = 4.07\%$$

N55°E is the direction of the gradient of the water table.

Measurements taken 2/1/91 by NET

FREDRIC C. DIVINE ASSOCIATES

Architects

704 Mission Avenue
SAN RAFAEL, CALIFORNIA 94901

91 MAY 16 AM 11:20

LETTER OF TRANSMITTAL

(415) 457-0220

TO

Scott Sery
Alameda Co. Health

DATE	<i>5/14/91</i>	JOB NO
ATTENTION		
RE	<i>Castro Valley</i>	
	<i>Tract 5100</i>	

WE ARE SENDING YOU Attached Under separate cover via _____ the following items:

- Shop drawings Prints Plans Samples Specifications
 Copy of letter Change order _____

COPIES	DATE	NO.	DESCRIPTION
			<i>soils report.</i>

THESE ARE TRANSMITTED as checked below:

- For approval Approved as submitted Resubmit _____ copies for approval
 For your use Approved as noted Submit _____ copies for distribution
 As requested Returned for corrections Return _____ corrected prints
 For review and comment _____
 FOR BIDS DUE _____ 19 _____ PRINTS RETURNED AFTER LOAN TO US

REMARKS _____

Scott -
Per Fred Divine, John Horn
will have the next quarterly
report with-in 30 days.

COPY TO _____

SIGNED: *Carol Lee*

JCH

JOHN C. HOM & ASSOCIATES

Geotechnical Consultants
 1618 Second Street
 San Rafael, CA 94901

19051 LAKE CHABOT RD (650.1)

JOB _____
 SHEET NO. 1 OF _____
 CALCULATED BY RMF DATE 3/22/91
 CHECKED BY _____ DATE _____
 SCALE _____

MONITORING WELL # (by NET) (As labeled by JCH #A)	Top of casing Elevation	Depth to Water	Elevation of the top of the water column
MW-1 (As labeled by NET) (JCH #A #2)	218.93'	14.45'	204.48'
MW-2 (As labeled by NET) (JCH #A #1)	211.11'	7.96'	203.15'
MW-3 (As labeled by NET) (JCH #A #3)	211.77'	8.74'	203.03'


MEASUREMENTS RECORDED 10/26/90

Monitoring Well # (As labeled by NET) (As labeled by JCH #A)	Top of casing Elevation	Depth to water	Elevation of the top of the water column
MW-1 (JCH #A #2)	218.93'	14.53'	204.40'
MW-2 (JCH #A #1)	211.11'	7.95'	203.26'
MW-3 (JCH #A #3)	211.77'	8.61'	203.16'
MW-4 (JCH #A #4)	215.49'	11.38'	204.11'

MEASUREMENTS RECORDED 2/1/91

DRIVEWAY - SLOPE 20% MAX.


2:1 CUT SLOPE

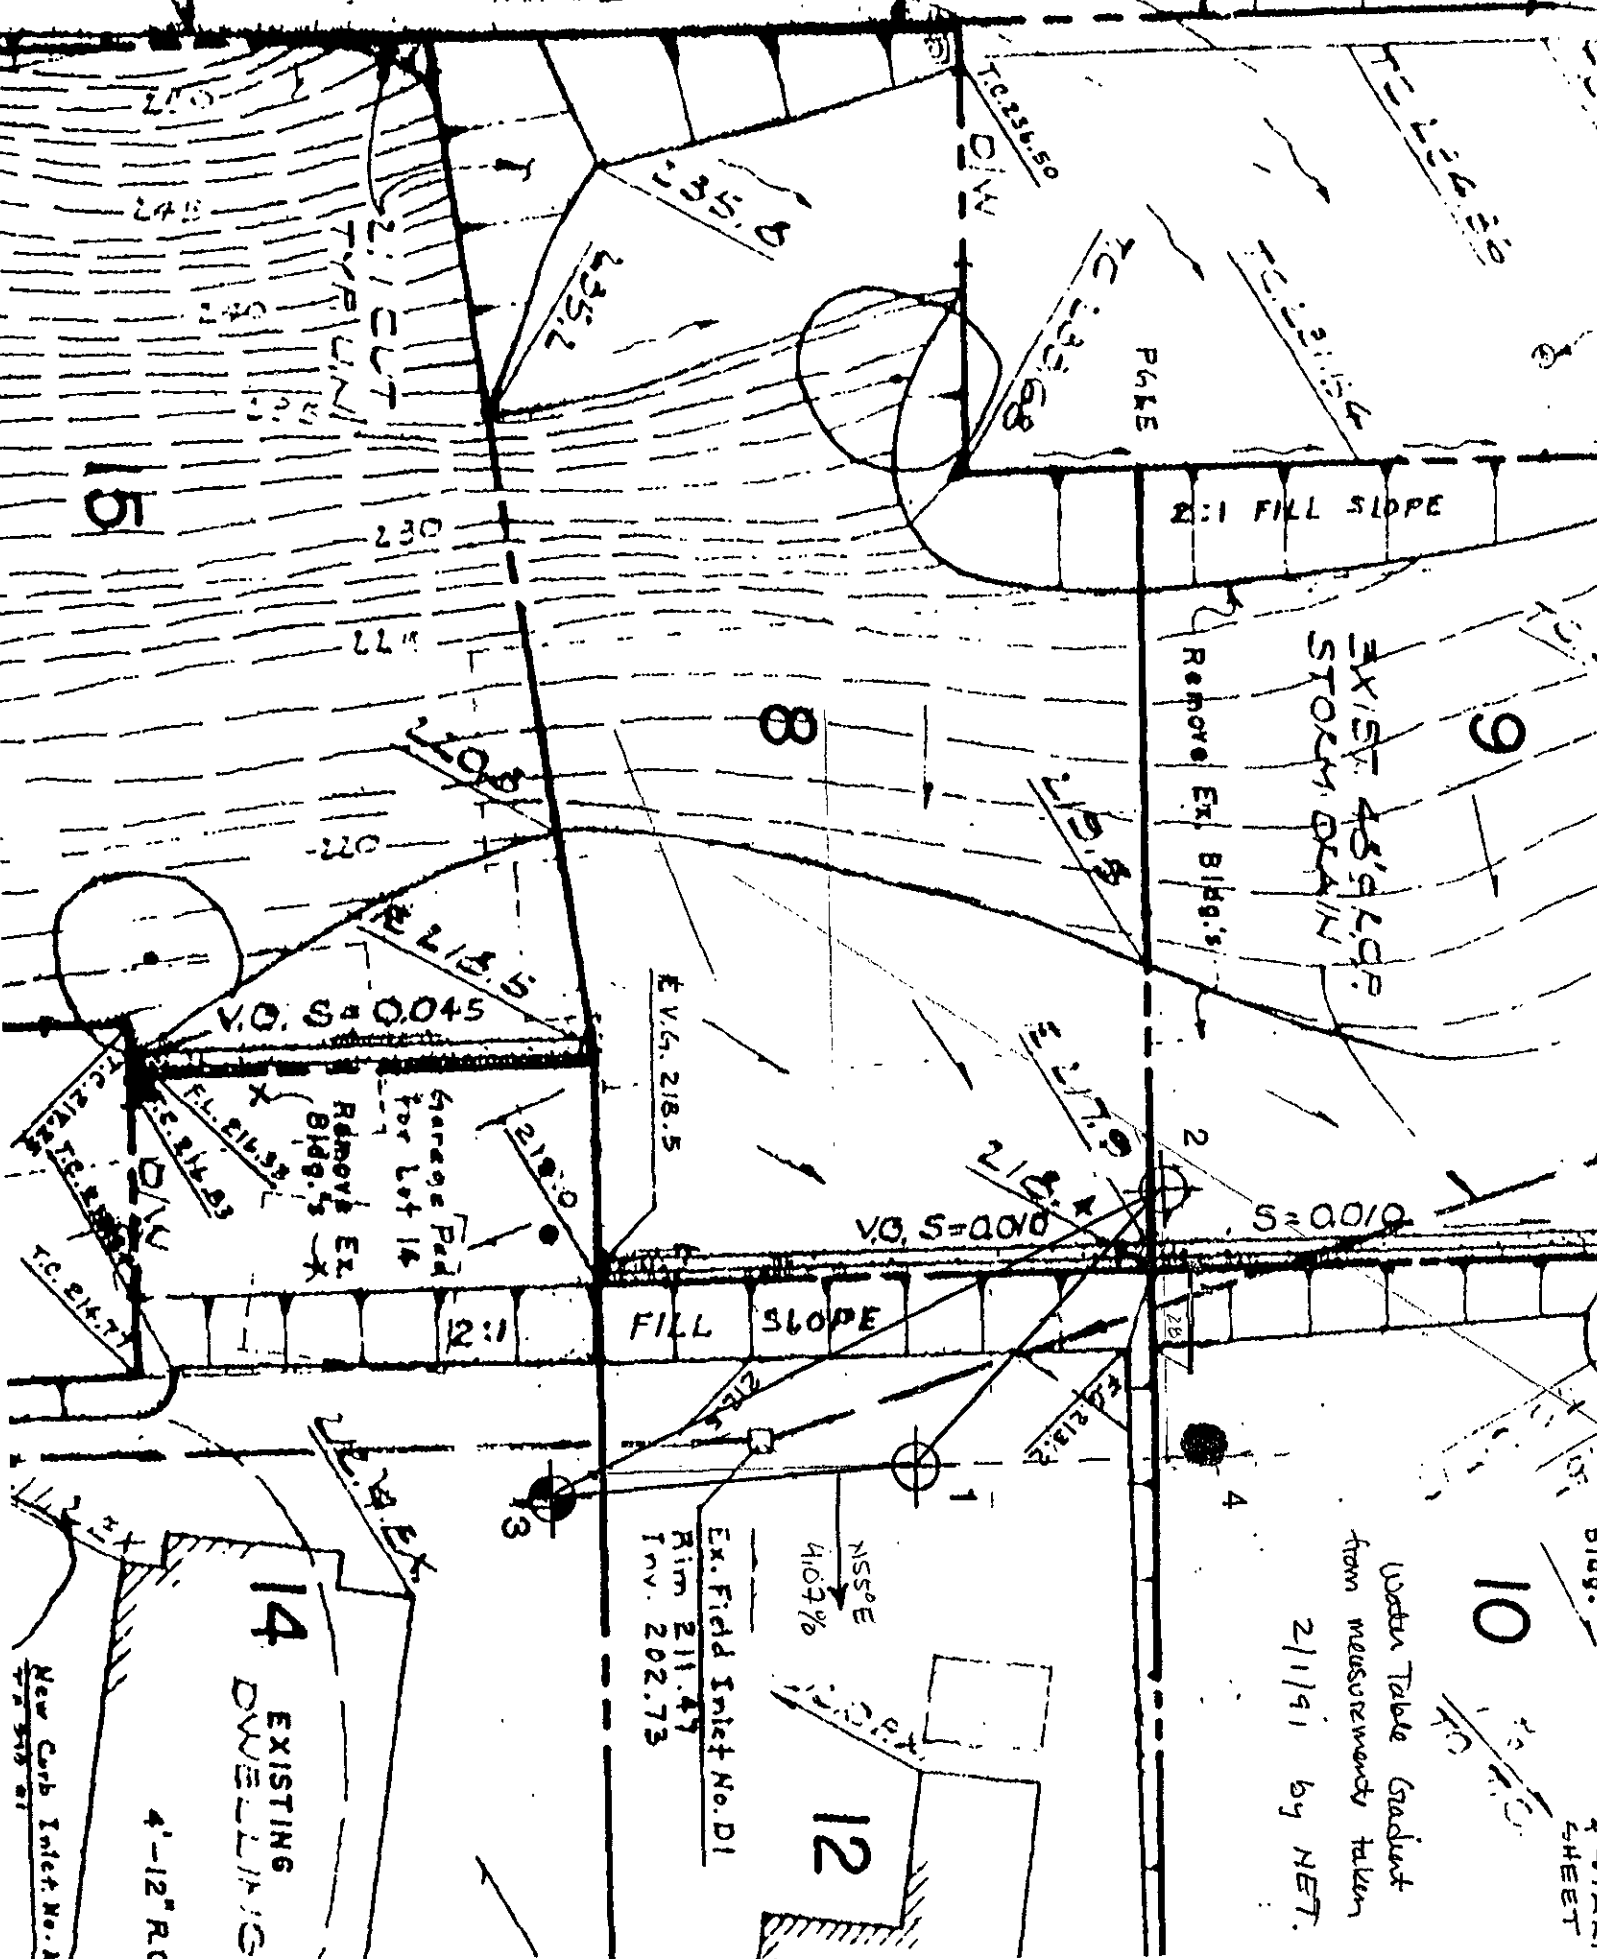

Water Table Gradient from measurements taken 2/1/91 by NET.

STAKI SHEET

Calculation of the gradient of ground water Table based on measurements taken 10/26/90 by NET.

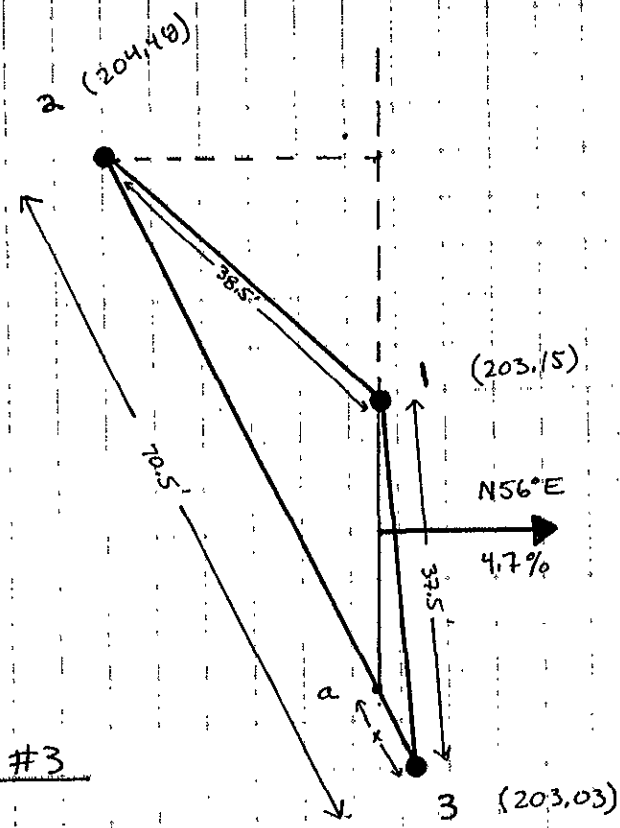

Line from well #1 to point a is the strike of the planar surface of the water table.

distance x = distance from well #3 to point a

point a is at the same elevation as well #1, but along the line from well #2 to well #3

Wells #1, #2, #3

Finding Point a:

$$\frac{203.15 - 203.03}{204.48 - 203.03} = \frac{0.12}{1.45} = \frac{x}{70.5'} \quad x = 5.83'$$


Gradient Calculation:

$$\frac{204.48' - 203.15'}{28.5'} = \frac{1.33'}{28.5'} = 4.67\%$$

N56°E = direction of gradient of water table

DRIVEWAY - SLOPE 20% MAX.

2:1 CUT SLOPE

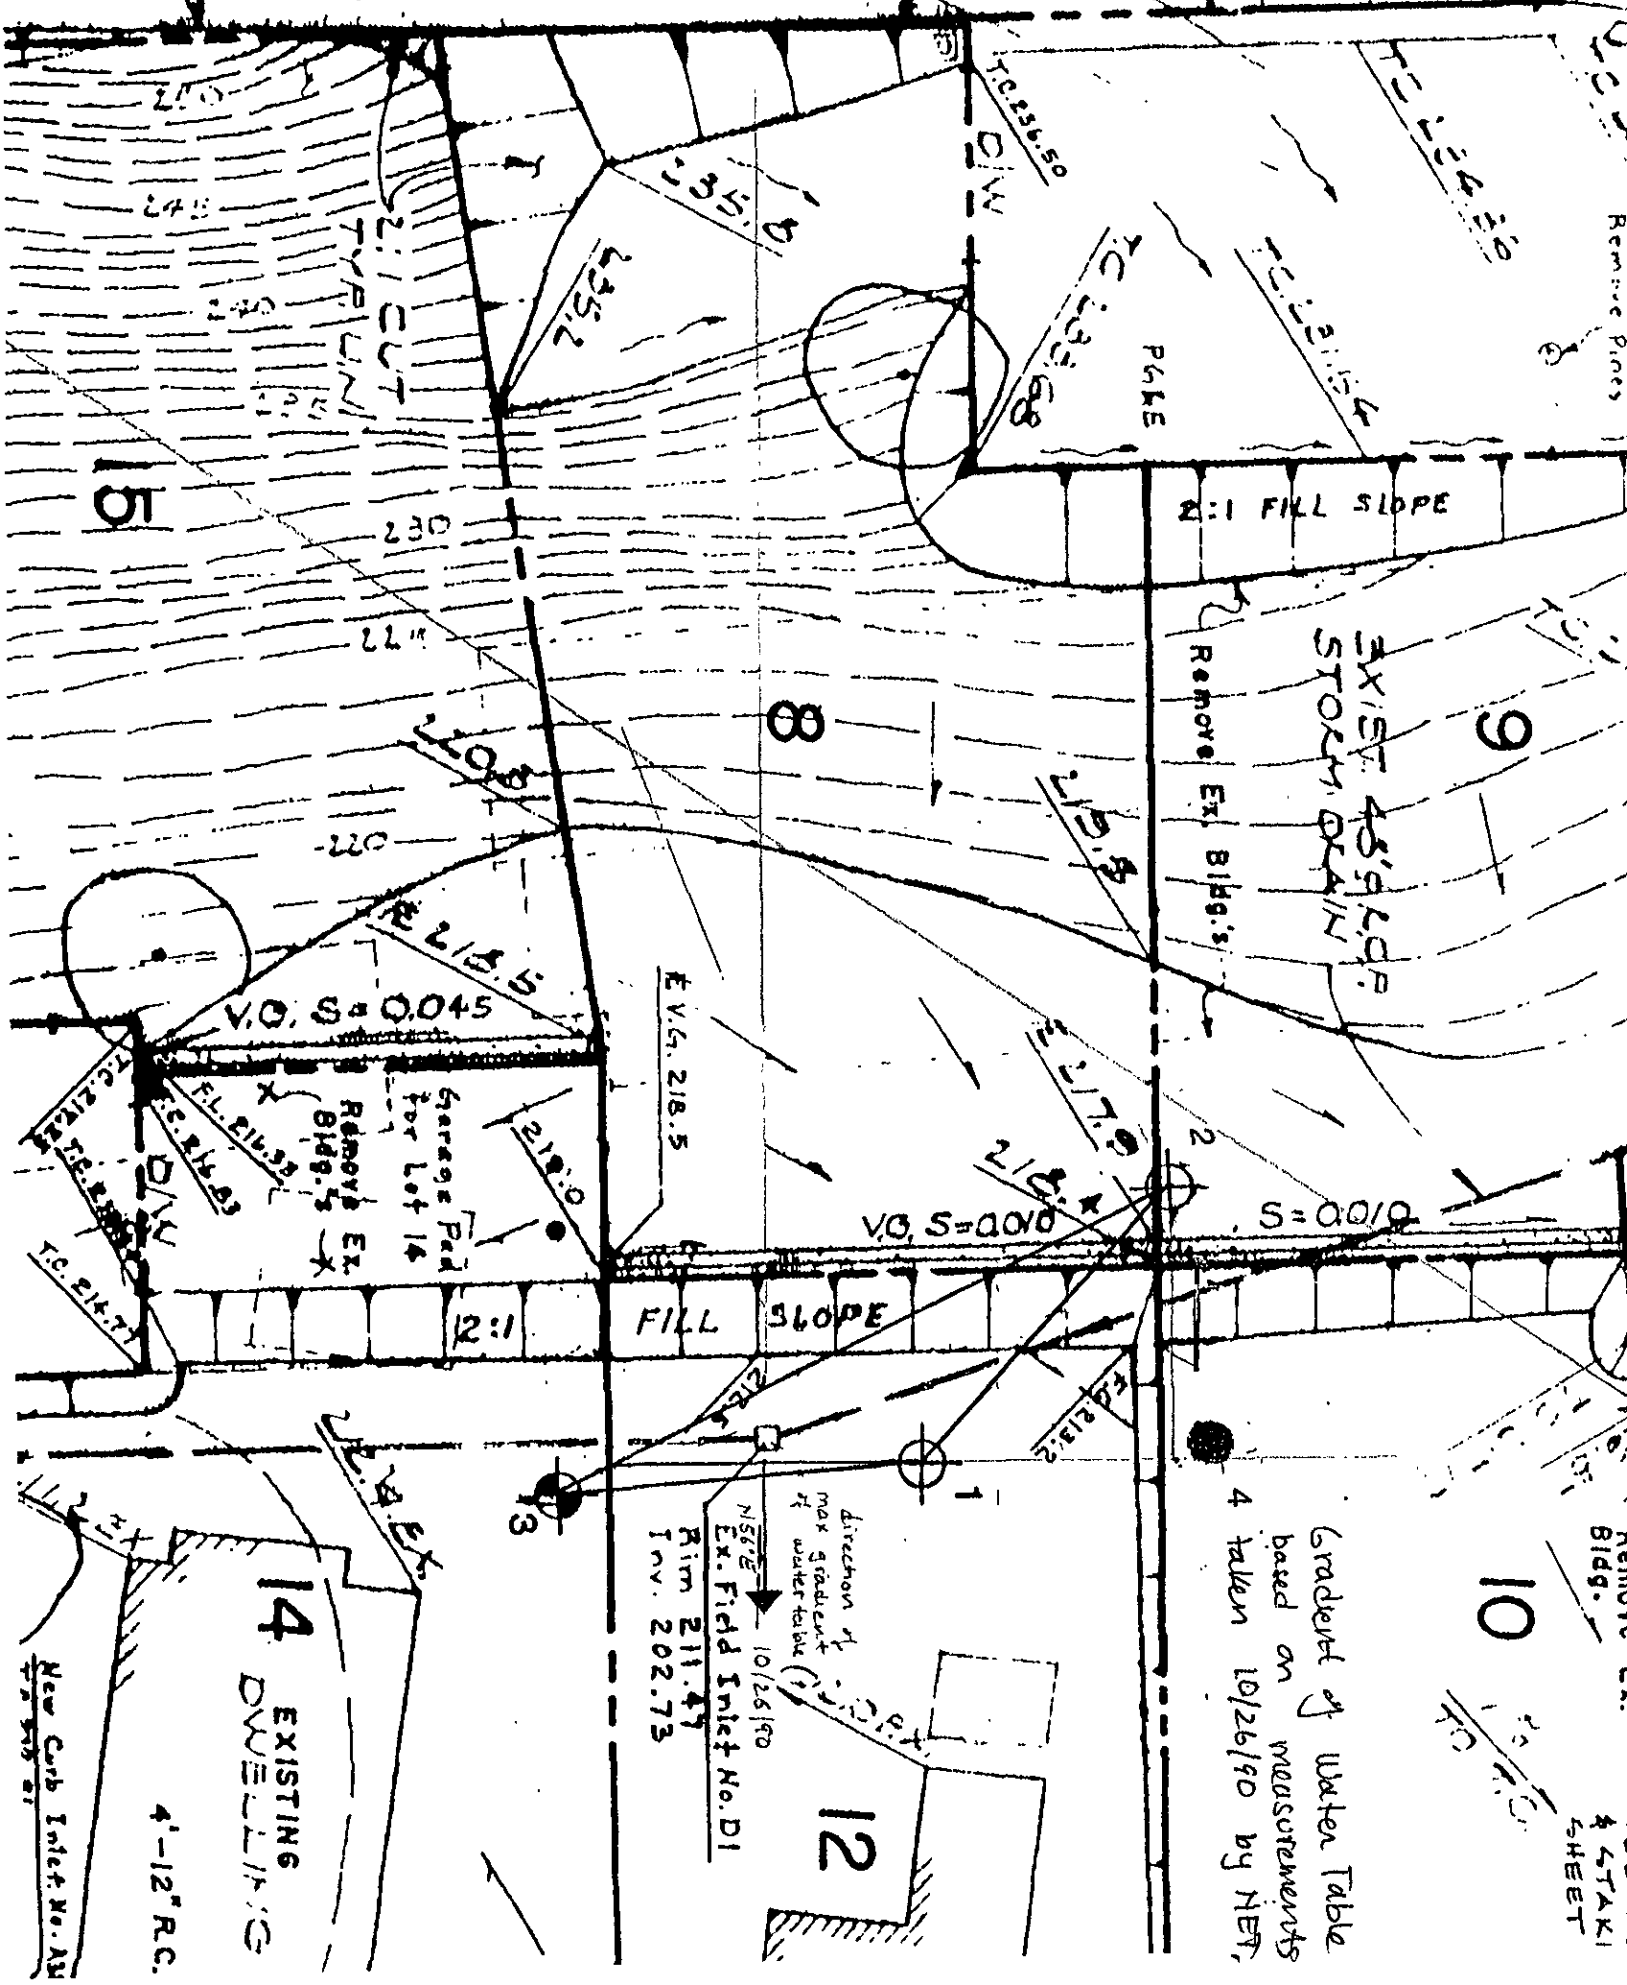

EXIST. 45' R.C.P. STORM DRAIN

S=0.000

2:1 FILL SLOPE

direction of max gradient of water table (10/26/90)
N 56° E 10/26/90
Rim 211.47
Inv. 202.73
EX. Field Inlet No. D1

Gradient of Water Table based on measurements taken 10/26/90 by NBT, 4 taken 10/26/90 by NBT,

10

4 STAKI SHEET

14 EXISTING DWELLING

12

9

8


15

New Carport Inlet No. A1

JCH
JOHN C. HOM & ASSOCIATES

Geotechnical Consultants
 1618 Second Street
 San Rafael, CA 94901

JOB 19051 LAKE CHABOT ROAD (650.1)
 SHEET NO. 4 OF _____
 CALCULATED BY RMF DATE 3/25/91
 CHECKED BY _____ DATE _____
 SCALE _____

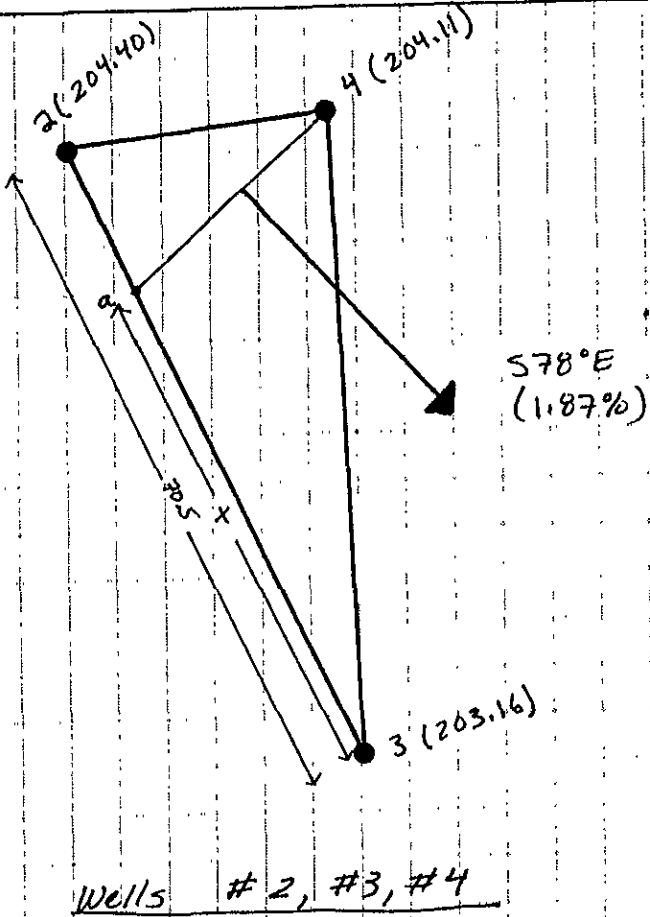

line from well #4 to point a is the line of strike of the planar surface of the water table.

distance x = distance from well # 3 to point x.

point a is at the same elevation as well #4, but along the line from well #2 to well #3.

Finding point a =

$$\frac{204.11 - 203.16}{204.40 - 203.16} = \frac{0.95}{1.24} = \frac{x}{70.5'}$$

$$x = 54.01'$$

Gradient Calculation:

$$\frac{204.40 - 204.11}{15.5'} = \frac{0.29'}{15.5'} = 1.87\%$$


S78°E is the direction of maximum gradient of the water table

Measurements taken 2/1/91 by HET

JCH
JOHN C. HOM & ASSOCIATES

Geotechnical Consultants
 1618 Second Street
 San Rafael, CA 94901

JOB 19051 LAKE CHABOT RD (650.1)
 SHEET NO. 5 OF _____
 CALCULATED BY RMF DATE 3/25/91
 CHECKED BY _____ DATE _____
 SCALE _____

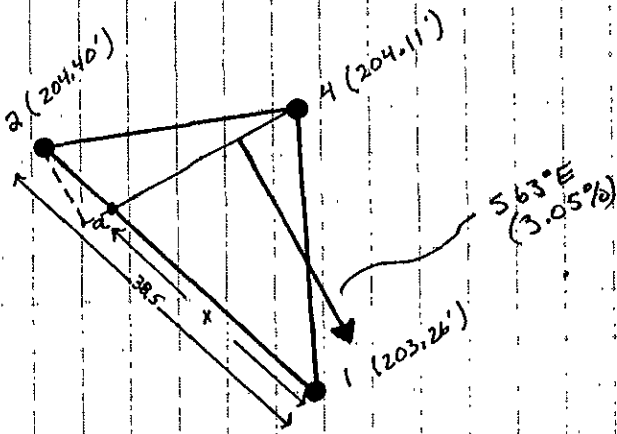

Wells # 1, #2, #4

Finding point a:

$$\frac{204,11 - 203,26}{204,40 - 203,26} = \frac{0,85}{1,14} = \frac{x}{38,5}$$

$$x = 28,7'$$

Calculation of gradient:

$$\frac{204,40 - 204,11}{9,5} = \frac{0,29}{9,5} = 3,05\%$$

563°E is the direction of maximum gradient.

Measurements recorded on 2/1/91 by NET.

line from well #4 to point a is the line of strike of the planar surface of the water table.

distance x = the distance from well #1 to point a.

point a is the same elevation as well #4 but along the line from well #1 to well #2.

