
## **ABBREVIATIONS**

AGGREGATE BASE	LF	LINEAR FEET		
ASPHALT CONCRETE	WM	MONITORING WELL		
AREA DRAIN	OHE	OVERHEAD ELECTRIC		
AGGREGATE SUBBASE	OHT	OVERHEAD TELEPHONE		
BACKFLOW PREVENTER	PAE	PUBLIC ACCESS EASEMENT		
CATCH BASIN	PB	PULL BOX		
CENTERLINE	PG&E	PACIFIC GAS & ELECTRIC		
DIRECT CHECK VALVE	PIV	POST INDICATOR VALVE		
DRIVEWAY	PUE	PUBLIC UTILITY EASEMENT		
ELECTRICAL LINE	PVC	POLYVINYL CHLORIDE PIPE		
ELECTRIC BOX	R	RIDGE LINE		
EDGE OF PAVEMENT	RCP	REINFORCED CONCRETE PIPE		
EXISTING	SD	STORM DRAIN PIPE		
FIRE DEPARTMENT CONNECTION	SS	SANITARY SEWER PIPE		
FINISHED FLOOR	SSCO	SANITARY SEWER CLEANOUT		
FLOWLINE	SSMH	SANITARY SEWER MANHOLE		
FINISHED SURFACE	SW	SIDEWALK		
GAS PIPE	T	TELEPHONE LINE		
GRADE BREAK	TC	TOP OF CURB		
GAS METER	TP	TELEPHONE POLE		
GUARD POST	TS	TRAFFIC SIGNAL		
GRATE	TSB	TRAFFIC SIGNAL BOX		
HANDICAP RAMP	VG	VALLEY GUTTER		
INVERT	W	WATER PIPE		
JOINT POLE	WM	WATER METER		
JOINT TRENCH				
	ASPHALT CONCRETE AREA DRAIN AGGREGATE SUBBASE BACKFLOW PREVENTER CATCH BASIN CENTERLINE DIRECT CHECK VALVE DRIVEWAY ELECTRICAL LINE ELECTRIC BOX EDGE OF PAVEMENT EXISTING FIRE DEPARTMENT CONNECTION FINISHED FLOOR FLOWLINE FINISHED SURFACE GAS PIPE GRADE BREAK GAS METER GUARD POST GRATE HANDICAP RAMP INVERT JOINT POLE	ASPHALT CONCRETE MW AREA DRAIN OHE AGGREGATE SUBBASE OHT BACKFLOW PREVENTER PAE CATCH BASIN PB CENTERLINE PG&E DIRECT CHECK VALVE PIV DRIVEWAY PUE ELECTRICAL LINE PVC ELECTRIC BOX R EDGE OF PAVEMENT RCP EXISTING SD FIRE DEPARTMENT CONNECTION SS FINISHED FLOOR SSCO FLOWLINE SSMH FINISHED SURFACE SW GAS PIPE T GRADE BREAK TC GAS METER TP GUARD POST TS GRATE TSB HANDICAP RAMP VG INVERT WM		

1 11


# SYMBOLS

$\boxtimes$	CONTROLLER CABINET
**	FIRE HYDRANT
- Э	GUY POLE
Ě	HANDICAP SPACE
a G	POWER POLE
$\ddot{\bowtie}$	GAS VALVE
<b>*</b>	BENCHMARK
◬	RAILROAD SPIKE
<b>S</b>	SANITARY SEWER MANHOLE
•	FOUND CITY MONUMENT
<b>©</b>	STORM DRAIN MANHOLE
<del></del>	STREET SIGN
• <del>~`</del> :¢:	STREET LIGHT
$\bowtie$	WATER VALVE
12"	TREE WITH SIZE
凌	TREE REMOVAL
$\overline{\wedge}$	TRANSFORMER
×	BARBED WIRE FENCE
o	CHAIN-LINKED FENCE
<u> </u>	WOOD FENCE
	SAWCUT LINE
	WALL
	SURVEYED PROPERTY LINE
	EASEMENT LINE

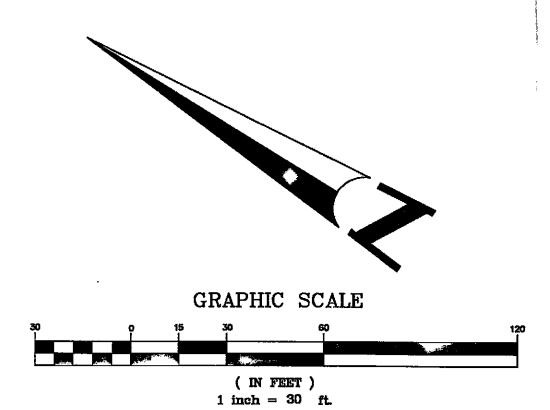

731" E

4" " # mmnnmm\*8/k1 #1

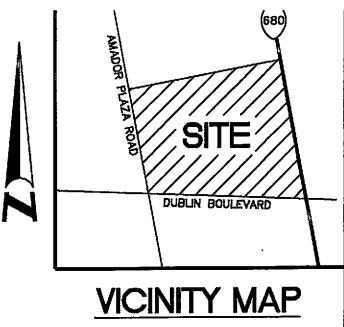

N. T. S.

#### LEGAL DESCRIPTION:

ALL THAT CERTAIN REAL PROPERTY SITUATED IN THE CITY OF DUBLIN, COUNTY OF ALAMEDA, STATE OF CALIFORNIA, DESCRIBED AS FOLLOWS:

PARCEL 3, AS SHOWN ON PARCEL MAP NO. 518, FILED OCTOBER 21, 1969 IN BOOK 61 OF PARCEL MAPS, PAGE 70, ALAMEDA COUNTY RECORDS.

EXCEPTING THEREFROM ALL OIL, GAS, MINERALS AND OTHER HYDROCARBON SUBSTANCES IN AND UNDER, OR THAT MAY BE PRODUCED FROM BELOW A DEPTH OF 500 FEET FROM THE SURFACE OF SAID LAND, WITHOUT RIGHT OF ENTRY UPON THE SURFACE OF SAID LAND FOR THE PURPOSE OF MINING, DRILLING, EXPLORING OR EXTRACTING SUCH OIL, GAS, MINERALS AND OTHER HYDROCARBON SUBSTANCES, OR OTHER OSE OF OR RIGHTS IN OR TO ANY PORTION OF THE SURFACE OF SAID LAND TO A DEPTH OF 500 FEET BELOW THE SURFACE THEREOF, AS RESERVED IN THE DEED FROM VOLC—MC LAIN COMMUNITIES, INC., TO QUALIFIED INVESTMENTS, INC., DATED JUNE 25, 1967, RECORDED JUNE 27, 1967, AS INSTRUMENT NO. AZ/60836, ALAMEDA COUNTY RECORDS.

### EASEMENTS PER CHICAGO TITLE COMPANY PRELIMINARY REPORT. ORDER NO. 6041278-BJS. DATED JULY 3, 2000.

- EXCEPTION # 4: ANY EASEMENT FOR WATER COURSE OVER THAT PORTION OF PREMISES LYING WITHIN THE LINES OF SAN RAMON CREEK AND ANY CHANGES IN THE BOUNDARY LINES OF PREMISES THAT HAVE OCCURRED OR MAY HEREAFTER OCCUR FROM NATURAL CAUSES AND BY IMPERCEPTIBLE DEGREES.

  THE EXACT LOCATION OF SAID EASEMENT IS NOT DEFINED OF RECORD.
- EXCEPTION # 5: WAIVER OF CLAIMS FOR DAMAGES TO SAID PROPERTY BY REASON OF THE LOCATION, CONSTRUCTION, LANDSCAPING OR MAINTENANCE OF THE FREEWAY ADJOINING SAID PROPERTY AS SET FORTH IN THE DEED TO THE COUNTY OF ALAMEDA, RECORDED MAY 3, 1917 IN BOOK 2565 OF DEEDS, PAGE 182, SHOWN HEREON.
- EXCEPTION # 6: EASEMENTS FOR THE INSTALLATION, OPERATION AND MAINTENANCE OF A SANITARY SEWER TRUNK LINE, GRANTED TO PARKS COMMUNITY SERVICE DISTRICT, RECORDED AUGUST 9, 1960, REEL 142, IMAGE 137, SERIES NO. AR-92873, OFFICIAL RECORDS, SHOWN HEREON.
- EXCEPTION # 7: EASEMENT FOR PERMITTING WATER TO FLOW AND DRAIN FROM SAID PROPERTY GRANTED TO COUNTY OF ALAMEDA, A POLITICAL SUBDIVISION OF THE STATE OF CALIFORNIA, RECORDED MAY 26, 1981, REEL 333, IMAGE 625, SERIES NO. AS-64392, OFFICIAL RECORDS.

NOT SHOWN- NO LONGER AFFECTS DESCRIBED PROPERTY.

- EXCEPTION # 8: EASEMENT FOR SANITARY SEWER TRUNK LINE GRANTED TO VALLEY COMMUNITY SERVICES DISTRICT, RECORDED SEPTEMBER 26, 1961, REEL 417, IMAGE 286, SERIES NO. AS-118373, OFFICIAL RECORDS, SHOWN HEREON.
- EXCEPTION # 9: EASEMENT FOR PERMITTING WATER TO FLOW AND DRAIN FROM THE PROPERTY GRANTED TO COUNTY OF ALAMEDA, A POLITICAL SUBDIVISION OF THE STATE OF CALIFORNIA, RECORDED AUGUST 13, 1963, REEL 963, IMAGE 944, SERIES NO. AU-134693, OFFICIAL RECORDS.

  NOT SHOWN- NO LONGER AFFECTS DESCRIBED PROPERTY.
- EXCEPTION # 10: LACK OF ABUTTER'S RIGHTS IN AND TO THE FREEWAY ADJACENT TO THE EASTERLY LINE OF SAID PROPERTY, SAID RIGHTS HAVING BEEN CONDEMNED BY FINAL DECREE OF CONDEMNATION IN SUPERIOR COURT, ALAMEDA COUNTY, CASE NO. 331088, IN FAVOR OF THE STATE OF CALIFORNIA. A CERTIFIED COPY OF SAID DECREE RECORDED MARCH 16, 1964, REEL 1150, IMAGE 357, SERIES NO. AW-42457, OFFICIAL RECORDS, SHOWN HEREON.
- EXCEPTION # 11: EASEMENT FOR AN UNDISCLOSED PURPOSE DESIGNATED AS "20' WIDE E-4" ON THE FILED MAP, SHOWN HEREON.
- EXCEPTION # 12: INGRESS AND EGRESS EASEMENT RESERVED BY QUALIFIED INVESTMENTS, INC., RECORDED FEBRUARY 9, 1970, REEL 2563, IMAGE 64, SERIES NO. 70-14056, OFFICIAL RECORDS, SHOWN HEREON.
- EXCEPTION # 13: EASEMENT FOR PERMITTING WATER TO FLOW AND DRAIN FROM THE EASTERN BOUNDARY LINE RESERVED BY QUALIFIED INVESTMENT, INC., RECORDED FEBRUARY 9, 1970, REEL 2563, IMAGE 64, SERIES NO. 70-12056, OFFICIAL RECORDS, SHOWN HEREON.
- EXCEPTION # 15: STORM DRAINAGE EASEMENT GRANTED TO ALAMEDA COUNTY FLOOD CONTROL AND WATER CONSERVATION DISTRICT, RECORDED NOVEMBER 1, 1985, SERIES NO. 85-235998, OFFICIAL RECORDS, SHOWN HEREON.
- EXCEPTION # 16: EASEMENT FOR RIGHT OF FREEWAY CONDEMNED TO ALAMEDA COUNTY, A POLITICAL SUBDIVISION OF THE STATE OF CALIFORNIA, RECORDED APRIL 28, 1999, SERIES NO. 99168303, OFFICIAL RECORDS, SHOWN HEREON.
- EXCEPTION # 17: TEMPORARY CONSTRUCTION EASEMENT CONDEMNED TO THE COUNTY OF ALAMEDA, A POLITICAL SUBDIVISION OF THE STATE OF CALIFORNIA, RECORDED APRIL 28, 1999, SERIES NO. 99168303, OFFICIAL RECORDS.

NOT SHOWN -SAID EASEMENT TERMINATED JUNE 30, 2000.


DAIE					•
BY					
KEV #	$  \nabla$	$\nabla$	V	V	$\nabla$
IU-US-UU KEV #	1" = 30°	PZ	PMZ	PZ	CML
DAIE	SCALE	DESIGNED:	DRAWN:	CHECKED:	PROJ. MGR: CML
			500 YGNACIO VALLEY ROAD, SUITE 190, WALNUT CREEK, CA	925-943-5225 FAX 925-943-5718	
	1	V			i l
	-	<b>T</b>	_ \	_	


F


LANDSCAPE ARCHITECTURE


SURVEYING

ENGINEERING

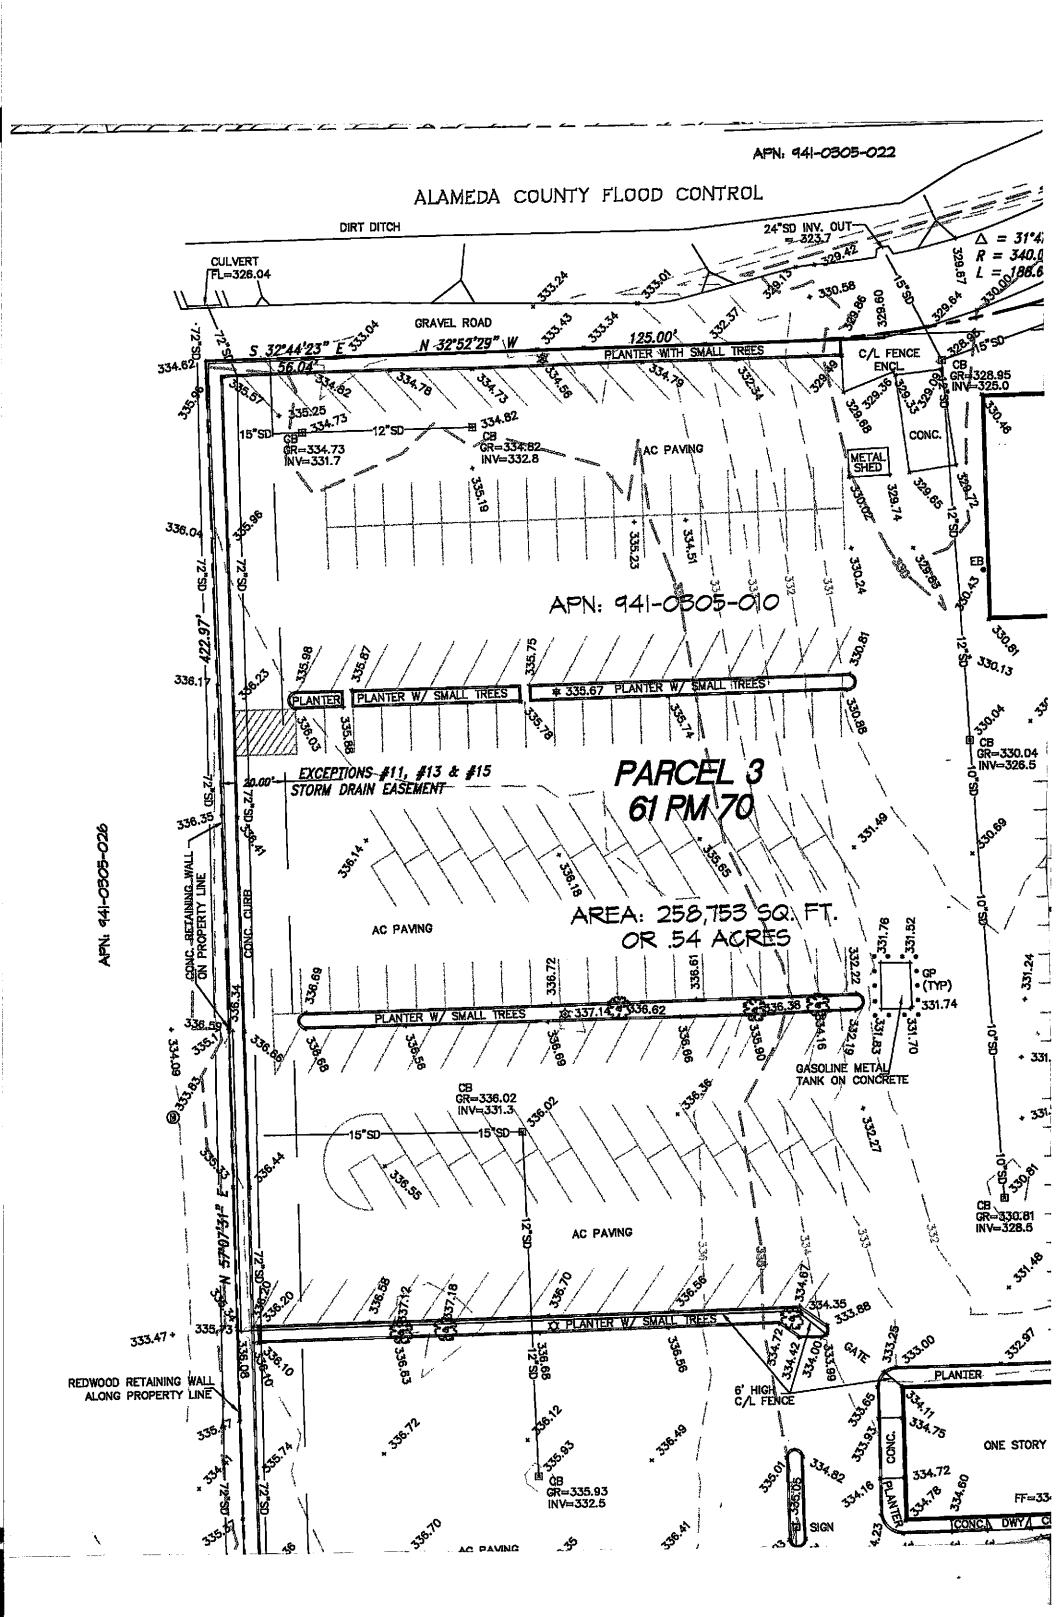

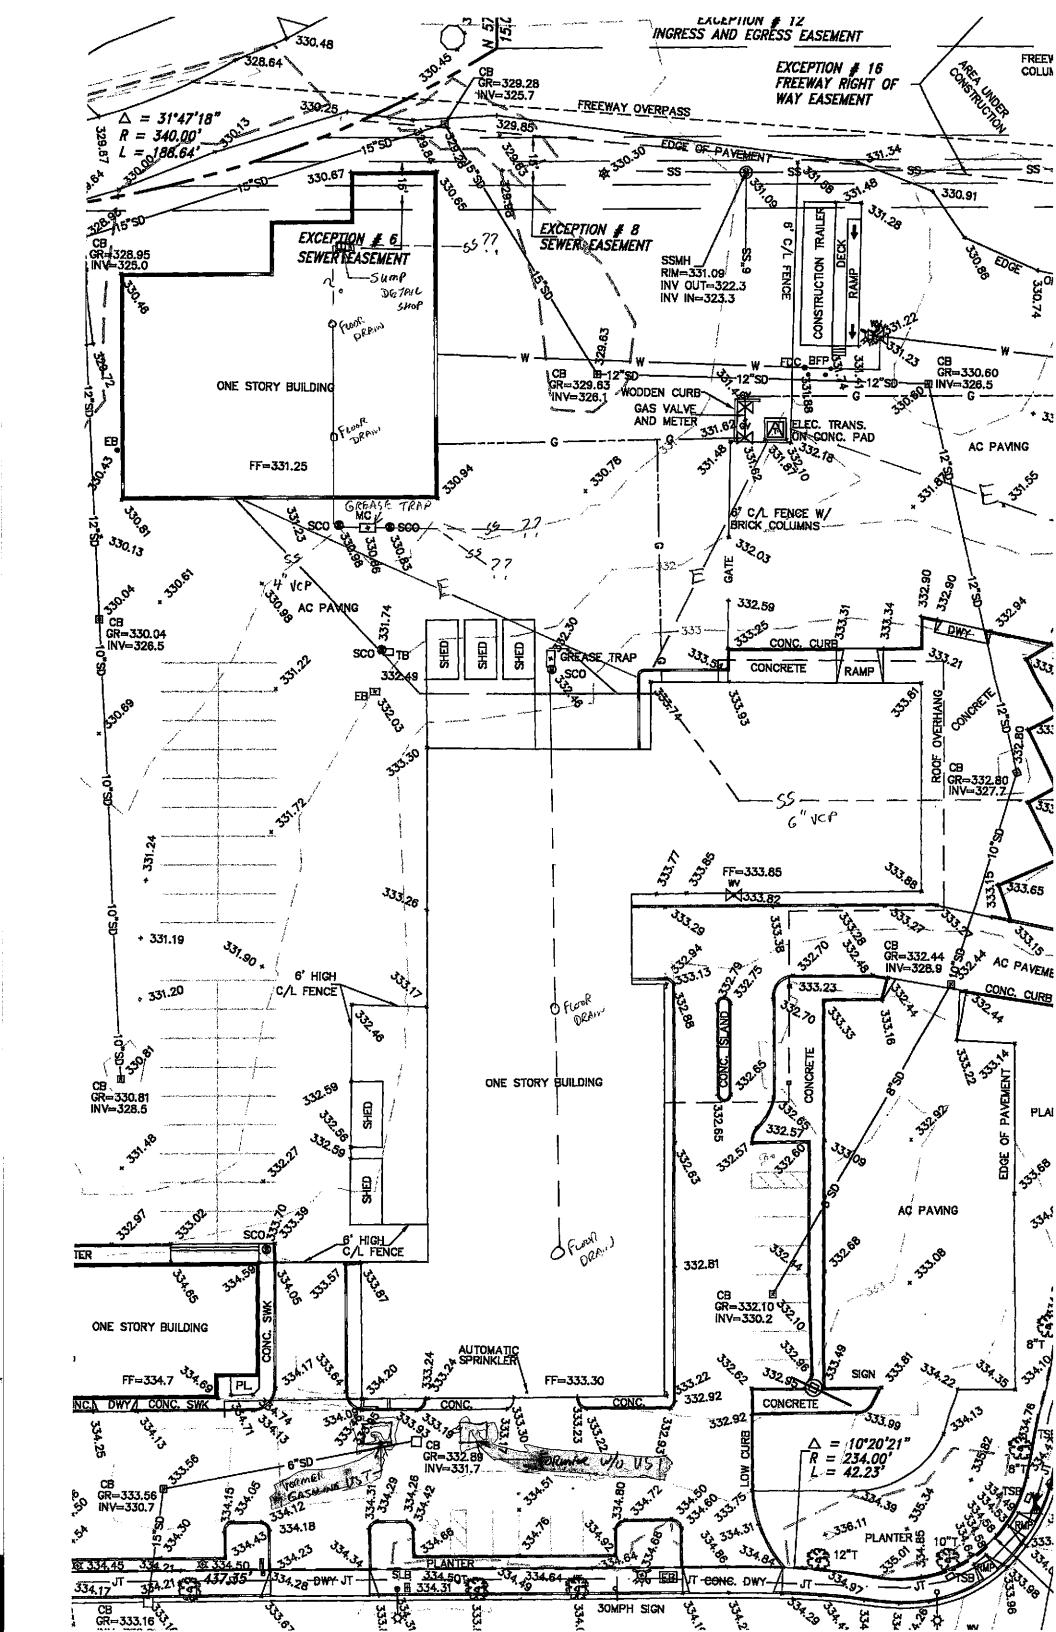

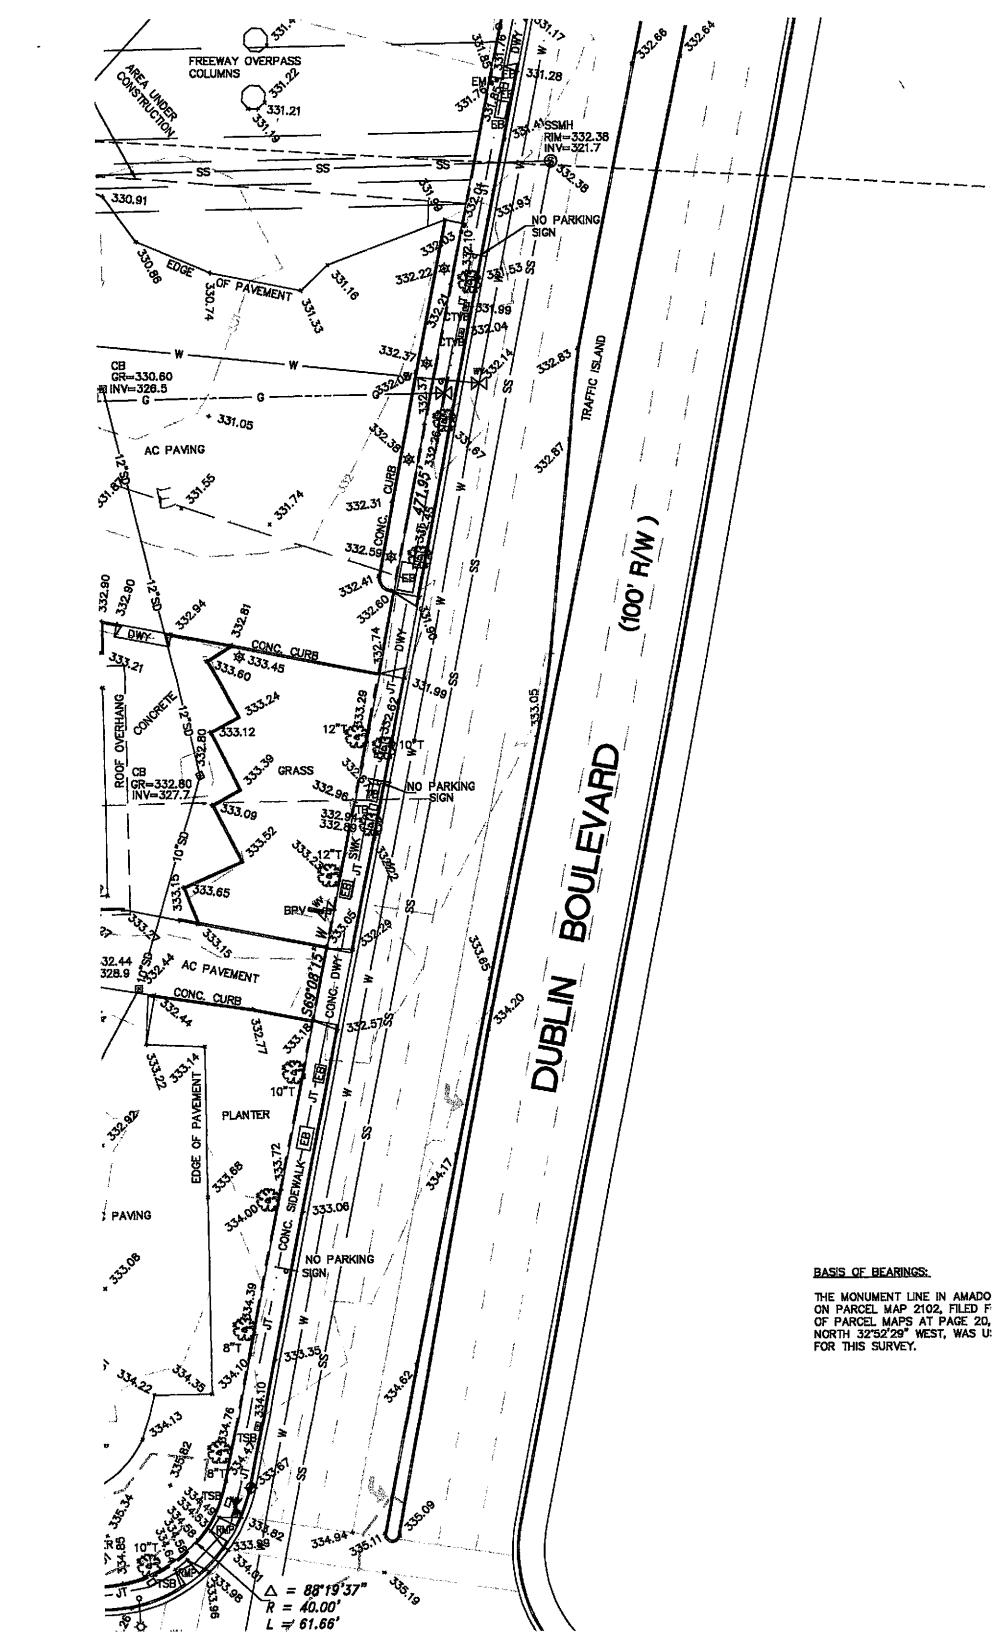

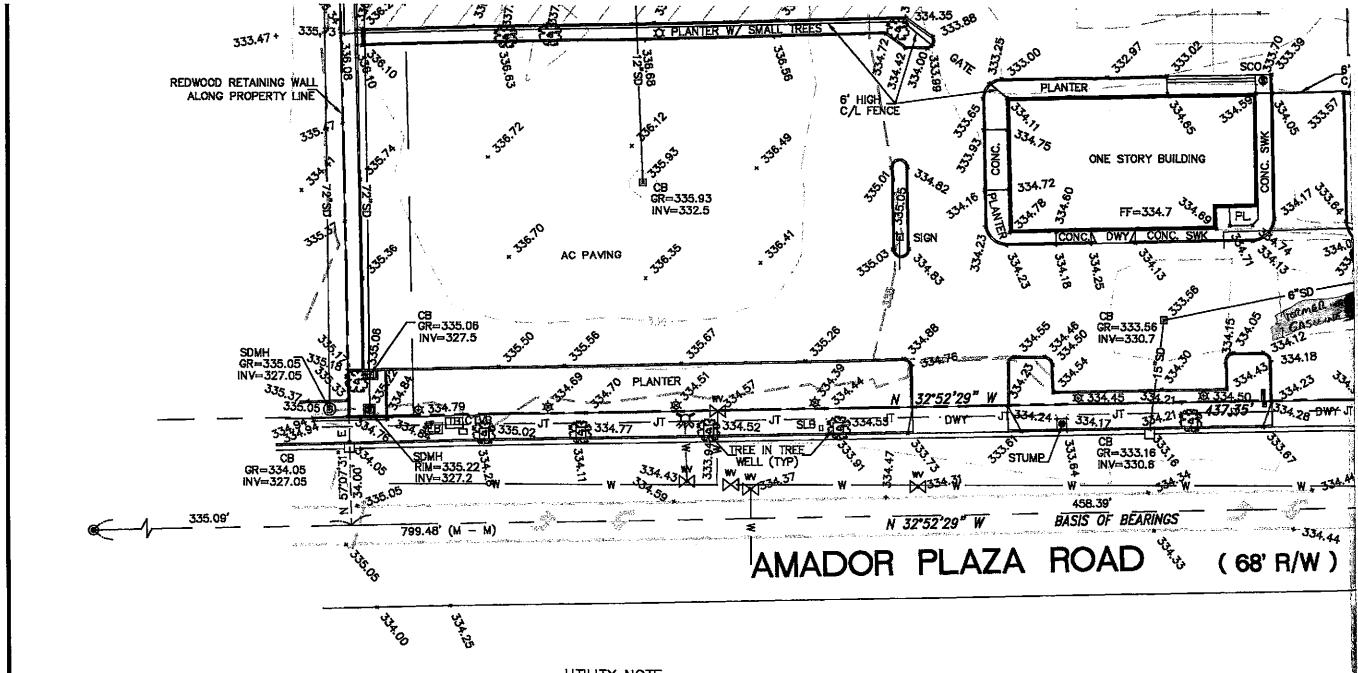

### UTILITY NOTE

THE EXISTENCE AND LOCATION OF ANY UNDERGROUND UTILITIES, PIPES AND/OR STRUCTURES SHOWN ON THIS SURVEY WERE OBTAINED BY A SEARCH OF AVAILABLE RECORDS. TO THE BEST OF OUR KNOWLEDGE THERE ARE NO EXISTING UTILITIES, EXCEPT AS SHOWN ON THIS SURVEY. THE CONTRACTOR SHALL ASCERTAIN THE TRUE LOCATION OF ANY UNDERGROUND UTILITIES AND SHALL BE RESPONSIBLE FOR DAMAGE TO ANY PUBLIC OR PRIVATE UTILITIES, SHOWN OR NOT SHOWN HEREON.