

RECEIVED

9:05 am, Jun 09, 2010

Alameda County
Environmental Health

PERJURY STATEMENT

Subject: Fuel Lake Case No. RO0002981 and Geotracker Global ID T1000000416, Red Hanger Cleaners, 6335-6339 College Ave., Oakland, CA 94618

"I declare, under penalty of perjury, that the information and/or recommendations contained in the attached document or report is true and correct to the best of my knowledge.



Ted Cleveland
Vice President, Operations
EFI Global, Inc.

**Environmental
Resources
Management**

1277 Treat Boulevard
Suite 500
Walnut Creek, CA 94597
(925) 946-0455
(925) 946-9968 (fax)

7 June 2010

Barbara Jakub, P.G.
Hazardous Materials Specialist
Alameda County Environmental Health Services
1131 Harbor Bay Parkway, Suite 250
Alameda, CA 94502



Subject: RO#0002981
Well Survey Report
Red Hanger Kleaners
6239 College Avenue
Oakland, California

Dear Ms. Jakub:

On behalf of EFI Global, Inc. and Mr. Ronald Elvidge, site owner, ERM-West, Inc. (ERM) presents to Alameda County Environmental Health Services (ACEH) this Well Survey Report for the Red Hanger Kleaners site (Site), located at 6239 College Avenue in Oakland, California (Figure 1). In the preparation of this report, the following agencies were contacted to obtain information on wells situated within ¼ mile of the subject property:

- The Alameda County Public Works Agency, Water Resources Section (ACPWA); and
- The California Department of Water Resources, Division of Planning and Local Assistance (DWR).

The results of the ACPWA and DWR well surveys, which included listings greater than ¼-mile from the subject property, are included in Attachment A. In addition to the ACPWA and ACEH well surveys, ERM consulted the online websites for Alameda County Environmental Health Department (<http://ehgis.acgov.org/dehpublic/dehpublic.jsp>) and the Regional Water Quality Control Board (<http://geotracker.waterboards.ca.gov/>).

Based on the information derived from the above sources, ERM has identified the presence of 26 wells within ¼-mile of the subject property


(see attached Figure 1). As seen in the attached Table 1, all of the wells are associated with environmental investigations being conducted at nearby sites. Given the locations of these 26 wells relative to the subject property and the southwesterly groundwater flow direction in the vicinity, it is unlikely that the 26 wells would be 1) potential receptors of groundwater flowing beneath the subject property; or 2) conduits to influence groundwater migration from the subject property.

If you have any questions regarding this report, please feel free to contact either of the undersigned at (925) 946-0455.

Sincerely,



John O. Cavanaugh, P.G.
Principal-in-Charge

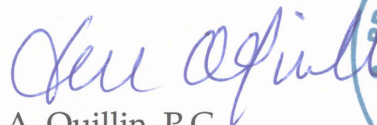

Jill A. Quillin, P.G.
Project Manager



JAQ/ASC/JOC/k1/0099877

cc: Mr. Gary Bates, EFI Global, Inc. (electronic copy)
file
enclosures



Aerial Photo Source: © 2007 Google Earth Pro Ver 5.0.11337.1968



Figure 1
Well Locations within 1/4 Mile of Site
Red Hanger Kleaners
6239 College Avenue
Oakland, California

Table 1
Summary of Water Wells
Located Within 0.25 Miles Radius of
Red Hanger Kleeners
6239 College Avenue
Oakland, CA

Well ID	Section	Location	Well Use	Date Drilled/ Installed	Well Diameter (inches)	Total Well Depth (feet bgs)	Screened interval (feet bgs)	Distance from Site (miles)	
1	13B	6039 College Avenue, Oakland	Monitoring (7)	February-90 (4)	4	25	14.5 - 24.5	0.07	
				August-91 (1)	2	30	13.5 - 28.5		
				September-93 (1)	2	25	10 - 24.5		
				May-06 (1)	4	36	25 - 35		
2		5940 College Avenue, Oakland	Monitoring (2)	December-00	2	21	5 to 20	0.15	
					2	21	5 to 20		
3		5930 College Avenue, Oakland	Monitoring (3)	June-98	2	15	4.75 to 14	0.17	
					2	20	4.75 to 19		
					2	20	4.5 to 19		
4	13C	5929 College Avenue, Oakland	Monitoring (6)		Piezometer (1)	2	20	2.5 to 18	0.16
					July-91 (3)	4	27	7 - 27	
					4	28	8 - 28		
					2	30	10 - 30		
					2	27.5	7 to 27		
					2	30	9 to 29		
5	13B	6230 Claremont Avenue, Oakland	Piezometer (3)	8/1/1997 (temporary, since abandoned)	1	24	-	0.06	
					2	30	10 to 30.5		
6		6201 Claremont Avenue, Oakland	Monitoring (3)	July-00	2	30	10 to 30	0.02	
					2	30	10 to 30		
					2	30	10 to 30		
7	13C	6066 Claremont Avenue, Oakland	Monitoring (1)	August-91	4	28.5	13.5 - 28.5	0.07	
bgs = below ground surface									

Attachment A
ACPWA and DWR Well
Surveys

Confidential

Jill Quillin

From: Hamlin, Vicky [vickyh@acpwa.org]
Sent: Wednesday, May 26, 2010 10:23 AM
To: Jill Quillin; Jakub, Barbara, Env. Health
Cc: Yoo, James
Subject: well search 6239 College Ave Oakland 1S 4W 13 .25 mile radius
Attachments: Legend for Well Search.rtf; well search 6239 College Ave Oakland 1S 4W 13 .25 mile radius.xls

You requested a .25 mile radius search.

I searched in Sections 1S/4W 12 PQR, 1S/4W 13 ABCFG and found results in all but the underlined sections.

In accordance with Section 13752, information obtained from these reports shall be kept confidential and shall not be disseminated, published, or made available for inspection by the public without written authorization from the owner(s) of the well(s). The information shall be used only for the purpose of conducting the study. Copies obtained shall be stamped **CONFIDENTIAL** and shall be kept in a restricted file accessible only to agency staff or the authorized agent.

The information provided is deemed reliable but not guaranteed.

Please let me know if you have further questions.

Victoria Hamlin
ESA
Alameda County Public Works Agency
Water Resources Section
399 Elmhurst Street
Hayward, CA 94544
Ph: 510-670-5443
Fax: 510-782-1939
vickyh@acpwa.org
www.acgov.org/pwa/wells

6/7/2010

<u>Permit</u>	<u>Tr</u>	<u>Section</u>	<u>Address</u>	<u>Longcity</u>	<u>Owner</u>	<u>Update</u>	<u>Xcoord</u>	<u>Ycoord</u>	<u>Matchlevel</u>	<u>Tsrqg</u>	<u>Rec_code</u>	<u>Phone</u>	<u>City</u>	<u>Drilldate</u>	<u>Elevation</u>	<u>Totaldepth</u>	<u>Waterdept</u>	<u>Diameter</u>	<u>Use</u>
	1S/4W	13B 5	6230 Claremont Av	Oakland	Blood Bank of the ACCMA	8/13/1997	1.22E+08	37850065	1	1S/4W 13B	0	0 OAK	4/93	0	24	23	1	PIE	
	1S/4W	13B 6	6230 Claremont Av	Oakland	Blood Bank of the ACCMA	8/13/1997	1.22E+08	37850065	1	1S/4W 13B	0	0 OAK	4/93	0	24	23	1	PIE	
	1S/4W	13B 7	6230 Claremont Av	Oakland	Blood Bank of the ACCMA	8/13/1997	1.22E+08	37850065	1	1S/4W 13B	0	0 OAK	4/93	0	24	0	1	PIE	
	1S/4W	13B	6039 College Ave	Oakland	Shell Oil Company	3/29/1991	1.22E+08	37848491	0	1S/4W 13B	1566	0 OAK	9/90	0	0	0	8	DES	
	1S/4W	13B 1	6039 College Ave	Oakland	Shell Oil Company	3/29/1991	1.22E+08	37848491	0	1S/4W 13B	1567	0 OAK	7/90	0	0	8	0	BOR*	
	1S/4W	13B 2	6039 College Ave	Oakland	Shell Oil Company	3/29/1991	1.22E+08	37848491	0	1S/4W 13B	1568	0 OAK	1/90	0	0	0	10	BOR*	
	1S/4W	13B 3	6039 College Ave	Oakland	Shell Oil Company	3/29/1991	1.22E+08	37848491	0	1S/4W 13B	1569	0 OAK	1/90	196	25	0	4	MON	
	1S/4W	13B 4	6039 College Ave	Oakland	Shell Oil Company	3/29/1991	1.22E+08	37848491	0	1S/4W 13B	1570	0 OAK	1/90	194	25	0	4	MON	
93507	1S/4W	13C 7	5929 College Av	Oakland	Dreyer's Grand Ice Cream	11/3/1997	1.22E+08	37847691	1	1S/4W 13C	0	0 OAK	Sep-93	185	28	13	2	MON	
93507	1S/4W	13C 8	5929 College Av	Oakland	Dreyer's Grand Ice Cream	11/3/1997	1.22E+08	37847691	1	1S/4W 13C	0	0 OAK	Sep-93	185	30	0	2	MON	
93507	1S/4W	13C 9	5929 College Av	Oakland	Dreyer's Grand Ice Cream	11/3/1997	1.22E+08	37847691	1	1S/4W 13C	0	0 OAK	9/93	188	30	0	2	MON	
	1S/4W	13C 4	5929 College Ave	Oakland	Dryer's Ice Cream MW@	8/13/1992	1.22E+08	37846972	1	1S/4W 13C	7605	0 OAK	7/91	0	28	15	4	MON	
	1S/4W	13C 3	5929 College Ave	Oakland	Dryer's Ice Cream MW1	8/13/1992	1.22E+08	37846972	1	1S/4W 13C	7604	0 OAK	7/91	0	30	18	2	MON	
	1S/4W	13C 5	5929 College Ave	Oakland	Dryer's Ice Cream MW3	8/13/1992	1.22E+08	37846972	1	1S/4W 13C	7606	0 OAK	7/91	0	27	14	4	MON	
	1S/4W	13C 1	62 & HILLEGASS	Oakland	PG&E	7/31/1984	1.22E+08	37849421	8	1S/4W 13C	2304	0 OAK	7/75	0	81	0	0	DES	
	1S/4W	13C 2	6066 Claremont Ave	Oakland	Shell Oil Co	8/3/1992	1.22E+08	37848489	1	1S/4W 13C	7546	0 OAK	8/91	0	32	17	4	MON	
92481	1S/4W	13C10	6039 College Av	Oakland	Shell Oil Company	3/12/1998	1.22E+08	37848488	1	1S/4W 13C	0	0 OAK	9/93	0	25	14	2	MON	
	1S/4W	13C 6	6039 College Ave	Oakland	Shell Service Station	8/19/1997	1.22E+08	37848491	1	1S/4W 13C	0	0 OAK	9/93	193	25	15	2	MON	
	1S/4W	13G10	5800 College Av	Oakland	Chevron Products Co	9/11/1997	1.22E+08	37846330	1	1S/4W 13G	0	0 OAK	7/96	0	30	22	2	MON	
	1S/4W	13G 8	5800 College Avenue	Oakland	Chevron USA	1/11/1991	1.22E+08	37846330	0	1S/4W 13G	914	0 OAK	7/90	0	48	0	2	MON	
	1S/4W	13G 1	5800 COLLEGE AVE	Berkeley	CHEVRON USA	6/28/1989	1.22E+08	37846330	8	1S/4W 13G	2313	0 BER	Jul-89	0	0	0	0	DES	
	1S/4W	13G 2	5800 COLLEGE AVE	Berkeley	CHEVRON USA	6/28/1989	1.22E+08	37846330	8	1S/4W 13G	2314	0 BER	Jul-89	0	0	0	0	DES	
	1S/4W	13G 3	5800 COLLEGE AVE	Berkeley	CHEVRON USA	6/28/1989	1.22E+08	37846330	8	1S/4W 13G	2315	0 BER	Jul-89	0	0	0	0	DES	
	1S/4W	13G 4	5800 COLLEGE AVE	Berkeley	CHEVRON USA	6/28/1989	1.22E+08	37846330	8	1S/4W 13G	2316	0 BER	Jul-89	0	0	0	0	DES	
	1S/4W	13G 5	5800 COLLEGE AVE	Berkeley	CHEVRON USA	6/28/1989	1.22E+08	37846330	8	1S/4W 13G	2317	0 BER	Jul-89	0	0	0	0	DES	
	1S/4W	13G 9	5800 College Avenue	Oakland	Chevron, USA	1/11/1991	1.22E+08	37846330	0	1S/4W 13G	915	0 OAK	8/90	179	28	16	2	MON	
	1S/4W	13G 6	5800 College Avenue	Oakland	Chevron, USA, Inc.	5/30/1990	1.22E+08	37846330	0	1S/4W 13G	60	0 OAK	Dec-89	0	17	10	4	MON	
	1S/4W	13G 7	5800 College Avenue	Oakland	Chevron, USA, Inc.	5/30/1990	1.22E+08	37846330	0	1S/4W 13G	61	0 OAK	Dec-89	0	17	10	4	MON	
	1S/4W	13G 6	5776 MILES AVE	Oakland	CITY OF OAKLAND	1/22/1990	1.22E+08	37845872	0	1S/4W 13G	6536	0 OAK	Apr-89	100	28	18	0	PIE	
	1S/4W	13G 7	5776 MILES AVE	Oakland	CITY OF OAKLAND	1/22/1990	1.22E+08	37845872	0	1S/4W 13G	6537	0 OAK	Apr-89	101	28	23	0	PIE	
	1S/4W	13G 8	5776 MILES AVE	Oakland	CITY OF OAKLAND	1/22/1990	1.22E+08	37845872	0	1S/4W 13G	6538	0 OAK	Apr-89	99	33	18	2	MON	
	1S/4W	13G 1					0	0	9	1S/4W 13G	6813	0	Dec-88	0	32	15	4	MON	
	1S/4W	13G 2					0	0	9	1S/4W 13G	6814	0	Dec-88	0	32	15	4	MON	
	1S/4W	13G 3					0	0	9	1S/4W 13G	6815	0	Dec-88	0	33	15	4	MON	
	1S/4W	13G 4					0	0	9	1S/4W 13G	6816	0	Dec-88	0	32	23	4	MON	
	1S/4W	13G 5					0	0	9	1S/4W 13G	6817	0	Dec-88	0	29	23	4	MON	

Well Legend

DOM=Domestic well

IRR=Irrigation well

MUN= Municipal well

IND=Industrial well

CAT=Cathodic well

DES=well destroyed (through permit)

ABN=Abandoned and not being used (but has not been destroyed through permit process)

TES=Test well

BOR= Geotechnical investigation

MON= Monitoring well

EXT=Extraction/ Vapor wells

PIE=Piezometers

REC=Recovery well (extraction/ vapor)

? = Unknown or no information found or given

CONFIDENTIAL

STATE OF CALIFORNIA DWR
WELL COMPLETION REPORT
(WELL LOGS)

REMOVED

CONFIDENTIAL

STATE OF CALIFORNIA DWR
WELL COMPLETION REPORT
(WELL LOGS)

REMOVED

15/4W 12H2

285082



ELECTRIC LOG

FILING NO _____

COMPANY LYNDORFF & SCALMIDRINI

WELL CLAIMONT RESORT & TENNIS CLUB

FIELD _____

STATE CALIFORNIA COUNTY ALAMEDA

LOCATION: REAR PARKING LOT OTHER SERVICES _____

SEC _____ TWP _____ AGE _____

Permanent Datum: GL, Elev. _____

Log Measured From GL, _____ Ft. Above Perm. Datum

Drilling Measured From GL

Elev.: K.B. _____ D.F. _____ G.L. _____

Date	12-18-90				
Run No.	ONE				
Depth—Driller	200'				
Depth—Logger	200'				
Btm. Log Inter.	199'				
Top Log Inter.	5'				
Casing—Driller	N/A @		@	@	@
Casing—Logger	N/A				
Bit Size	6 1/4"				
Type Fluid in Hole	BENTONITE				
Dens.	Visc.	8.9 52			
pH	Fluid Loss	- - ml	ml	ml	ml
Source of Sample	FLOWLINE				
R _m @ Meas. Temp.	10 @ 77 °F	@	*F	@	*F
R _{ac} @ Meas. Temp.	10 @ 75 °F	@	*F	@	*F
R _{ac} @ Meas. Temp.	N/A @ *F	@	*F	@	*F
Source: R _m R _{ac}	M				
R _m @ BHT	N/A @ *F	@	*F	@	*F
Time Since Circ.	0 HR				
Max. Rec. Temp.	N/A °F				
Equip. Location	L11 SAC				
Recorded By	D. LOCKERGE				
Witnessed By	M. GORDON RBATISTA				

This Heading and Log Conform To API RP 31



REMARKS

Date Sample No.	Depth—Driller	Type Fluid in Hole	Dens.	Visc.	ph	Fluid Loss	Source of Sample	Equipment Data				Scale Changes						
								R _m @ Meas. Temp.	R _{ac} @ Meas. Temp.	Source: R _m R _{ac}	R _m @ BHT	R _{ac} @ BHT	R _{ac} @ BHT	Type Log	Depth	Scale Up Hole	Scale Down Hole	
								*F	*F	*F								
								@	@	@								
								@	@	@								
Changes in Mud Type or Additional Samples

SPONTANEOUS POTENTIAL millivolts	Depths	RESISTIVITY ohms. m ² /m	RESISTIVITY ohms. m ² /m
			RESISTANCE Detail Curve
5 + - 5	0	SHORT NORMAL 16 Inch	100
			LONG NORMAL 64 Inch
	0		100


15/4W 1242
340582

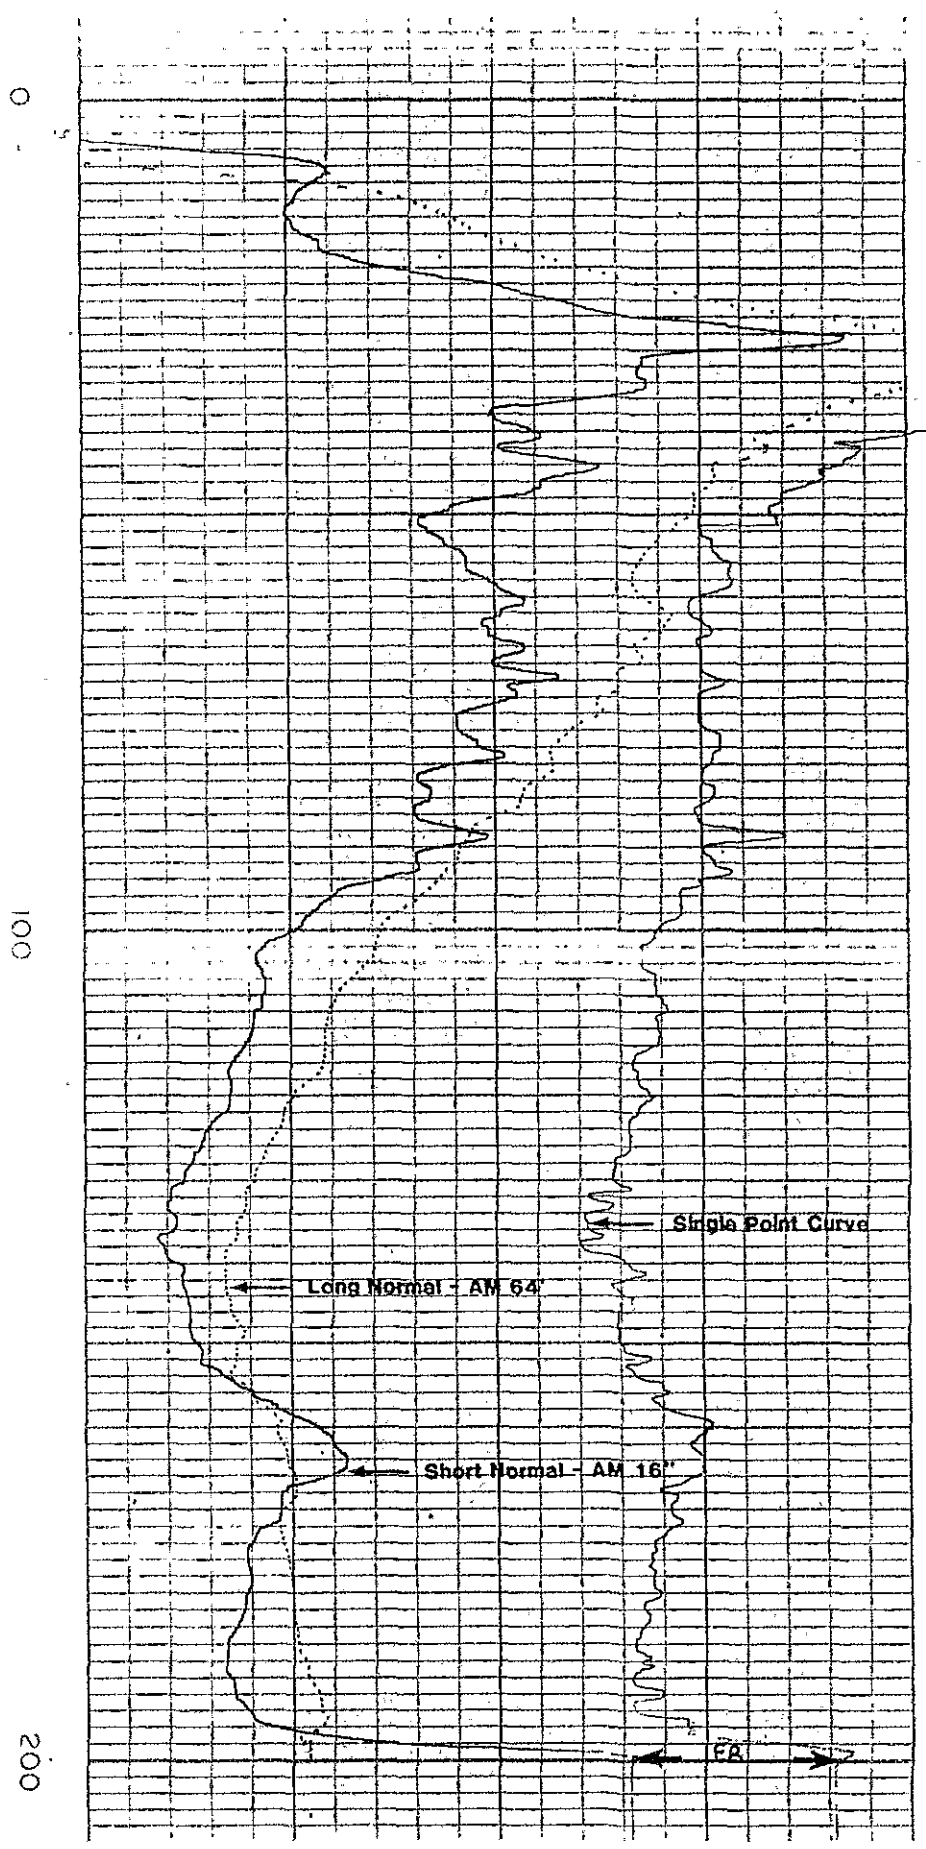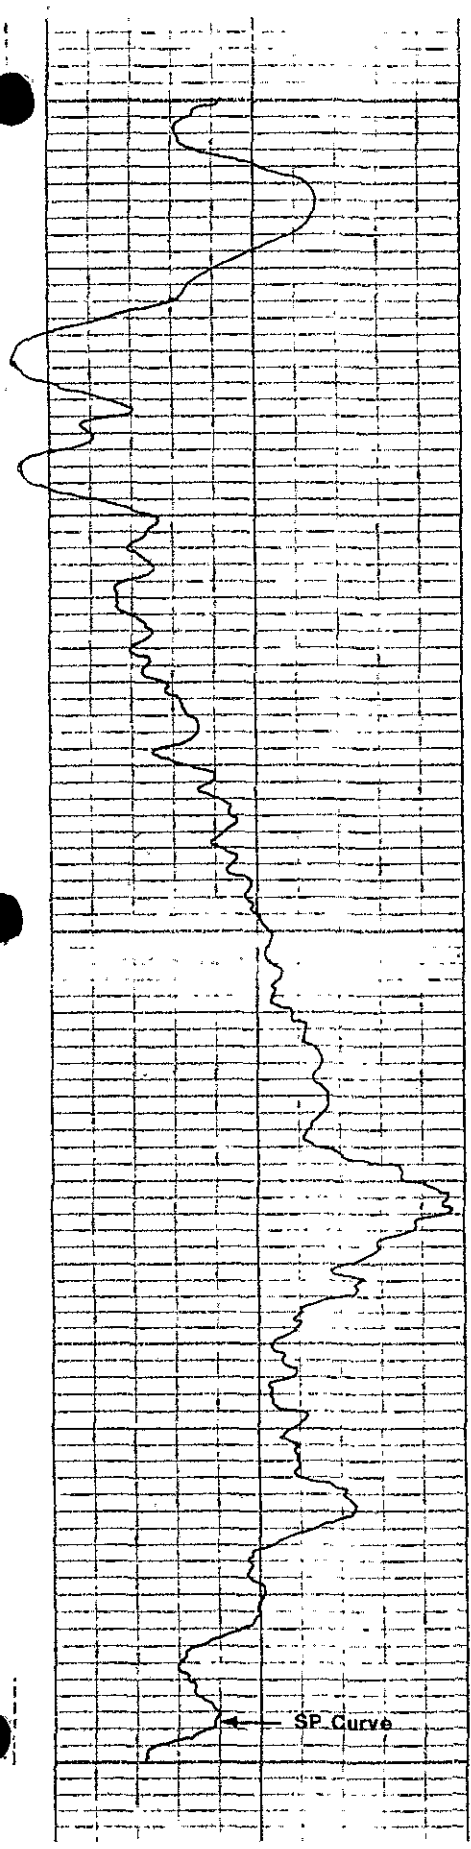

CONFIDENTIAL

STATE OF CALIFORNIA DWR
WELL COMPLETION REPORT
(WELL LOGS)

REMOVED

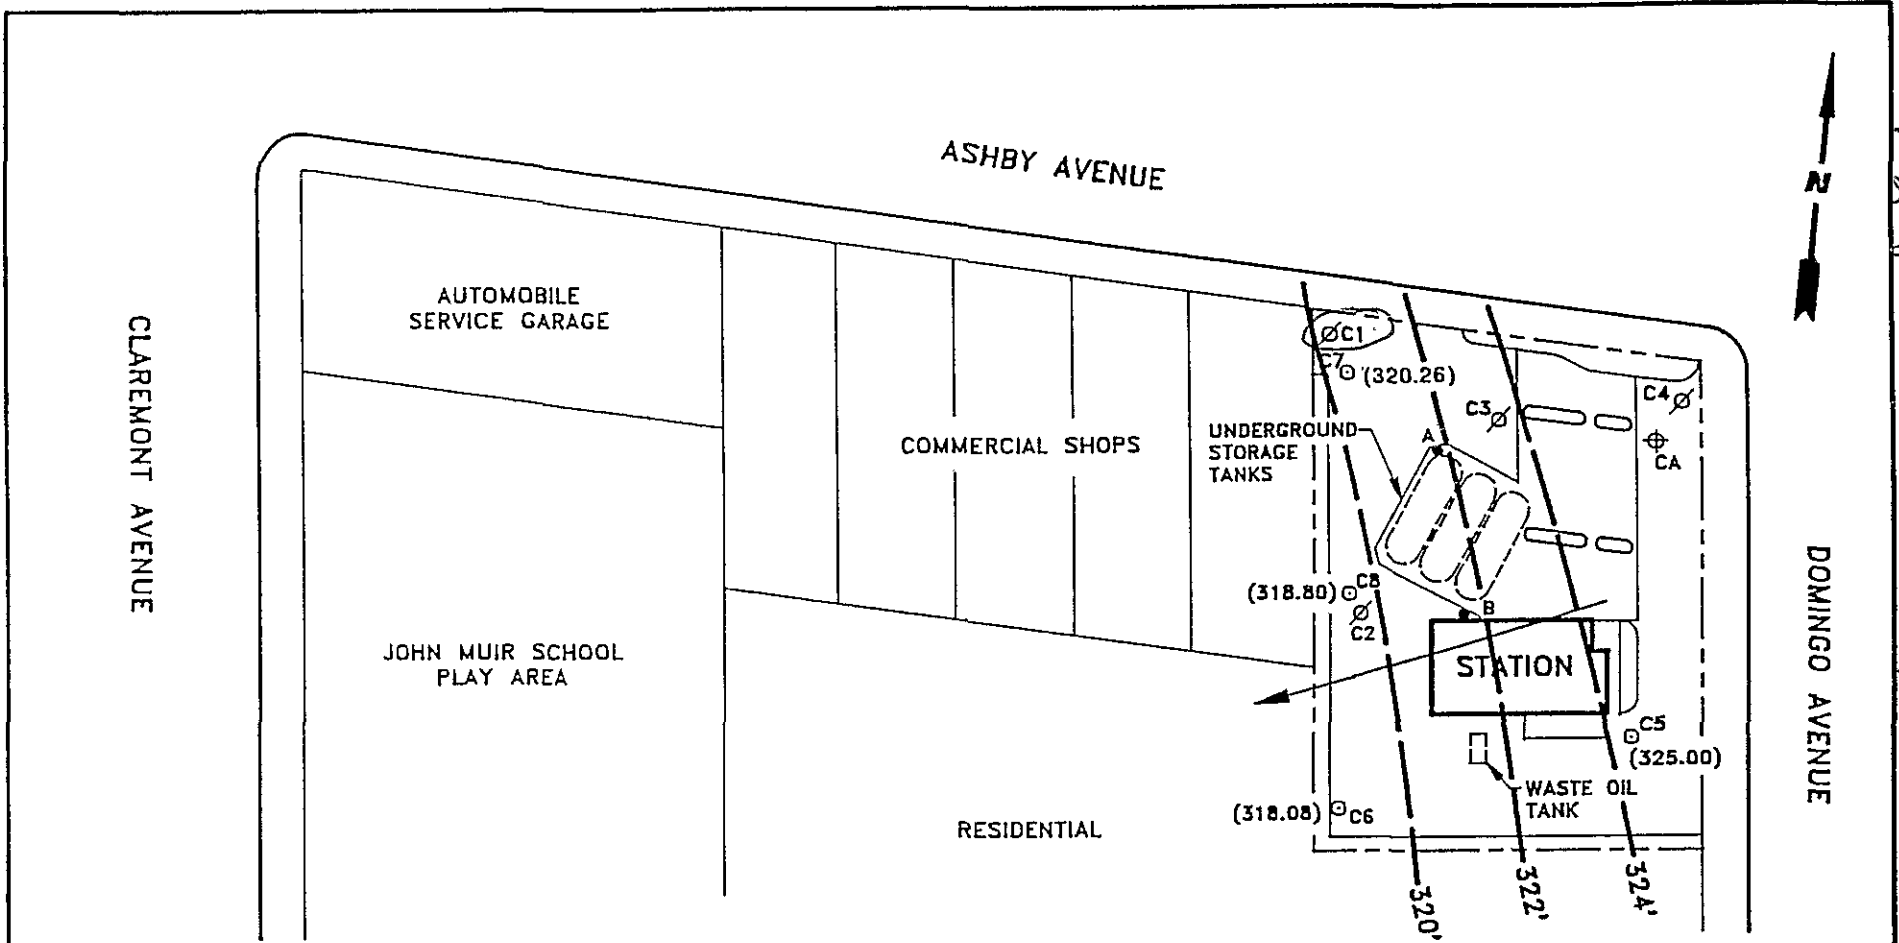

P. 2 of 2

403113

LEGEND

- MONITORING WELL
- TANK PIT MONITORING WELL
- ⊗ ABANDONED MONITORING WELL
- ⊕ SOIL BORING
- () POTENTIOMETRIC SURFACE ELEVATION
- POTENTIOMETRIC SURFACE CONTOUR
- ➔ GROUNDWATER FLOW DIRECTION



GROUNDWATER TECHNOLOGY
 4057 PORT CHICAGO HWY
 CONCORD, CA 94520
 (510) 671-2387


**POTENTIOMETRIC SURFACE MAP
 (12/4/92)**

CLIENT: CHEVRON U.S.A. PRODUCTS CO. SERVICE STATION No. 9-0289			LOCATION: 3048 ASHBY AVENUE BERKELEY, CALIFORNIA		REV. NO.: 0	DATE: 1/14/93
PM <i>JAW</i>	PE/RG <i>DRK</i>	DESIGNED TW	DETAILED ML	ACAD FILE: PSMD492/SP193	PROJECT NO.: 020203082	FIGURE: 3

CONFIDENTIAL


STATE OF CALIFORNIA DWR
WELL COMPLETION REPORT
(WELL LOGS)

REMOVED

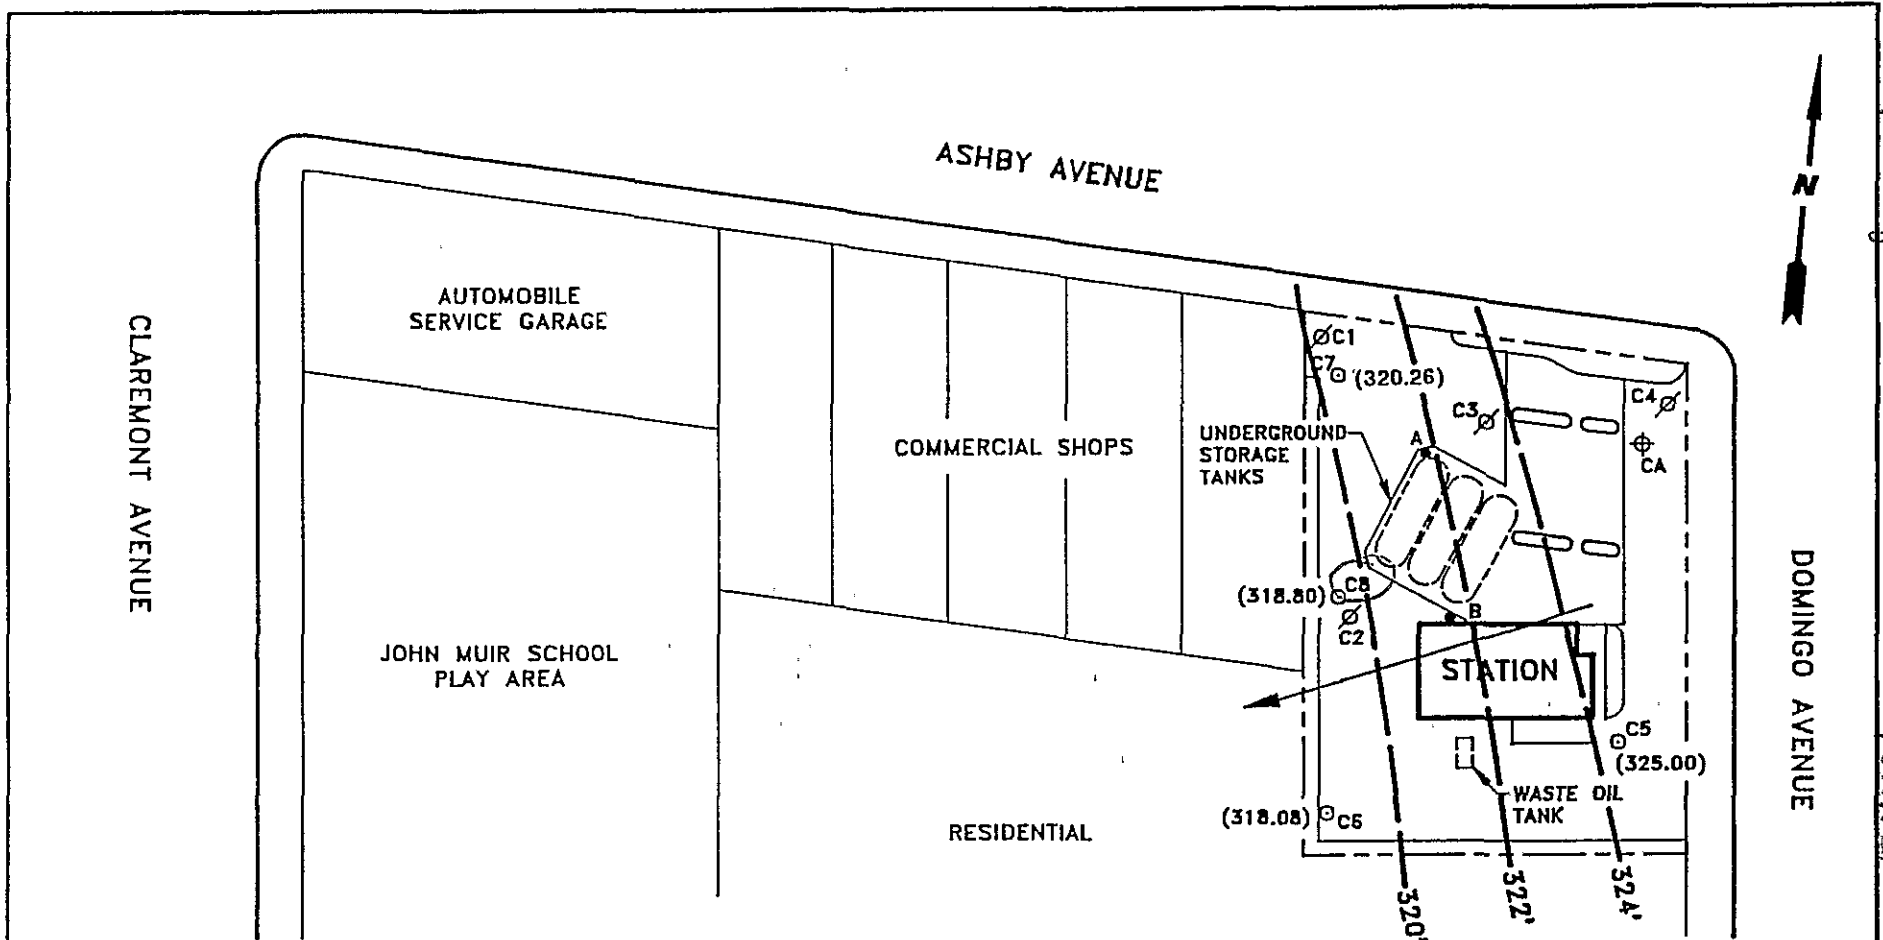

LEGEND

- MONITORING WELL
- TANK PIT MONITORING WELL
- ⊗ ABANDONED MONITORING WELL
- ⊕ SOIL BORING
- () POTENTIOMETRIC SURFACE ELEVATION
- POTENTIOMETRIC SURFACE CONTOUR
- GROUNDWATER FLOW DIRECTION

 GROUNDWATER TECHNOLOGY				4057 PORT CHICAGO HWY CONCORD, CA 94520 (510) 671-2387		POTENTIOMETRIC SURFACE MAP (12/4/92)			
CLIENT: CHEVRON U.S.A. PRODUCTS CO. SERVICE STATION No. 9-0289				LOCATION: 3048 ASHBY AVENUE BERKELEY, CALIFORNIA		REV. NO.: 0	DATE: 1/14/93		
PM <i>JAW</i>	PE/RG <i>DRK</i>	DESIGNED TW	DETAILED ML	ACAD FILE: PSMD492/SP193		PROJECT NO.: 020203082		FIGURE: 3	

P 2 2 4

4-03112

1S/14W 12H14

p. 2 of 4

403112

1S/4W 12H4

Drilling Log



GROUNDWATER
TECHNOLOGY

Monitoring Well C8


Project CHV/3048 Ashby Ave. Owner Chevron U.S.A. Products Co.
 Location Berkeley, CA Project No. 020203082 Date drilled 11/12/92
 Surface Elev. 338.99 ft. Total Hole Depth 34.5 ft. Diameter 8.5 inches
 Top of Casing 338.55 ft. Water Level Initial 22 ft. Static 12/04/92 19.75 ft.
 Screen: Dia 4 in. Length 20 ft. Type/Size 0.020 in.
 Casing: Dia 4 in. Length 14 ft. Type SCH 40 PVC
 Filter Pack Material #3 sand Rig/Core Type Mobile B-53/Split Spoon
 Drilling Company Kvihaug Well Drilling Method Hollow Stem Auger Permit # 92S-039
 Driller Mike Crocker Log By Chip Hurley
 Checked By David Kleesattel License No. RG# 5136 *D. Kleesattel*

See Site Map
For Boring Location

COMMENTS:

On 11-12-92 drill rig refusal was encountered at 22-feet. Drilling was continued on 11-16-92.

The total depth of the well was set at approximately 34-feet below grade.

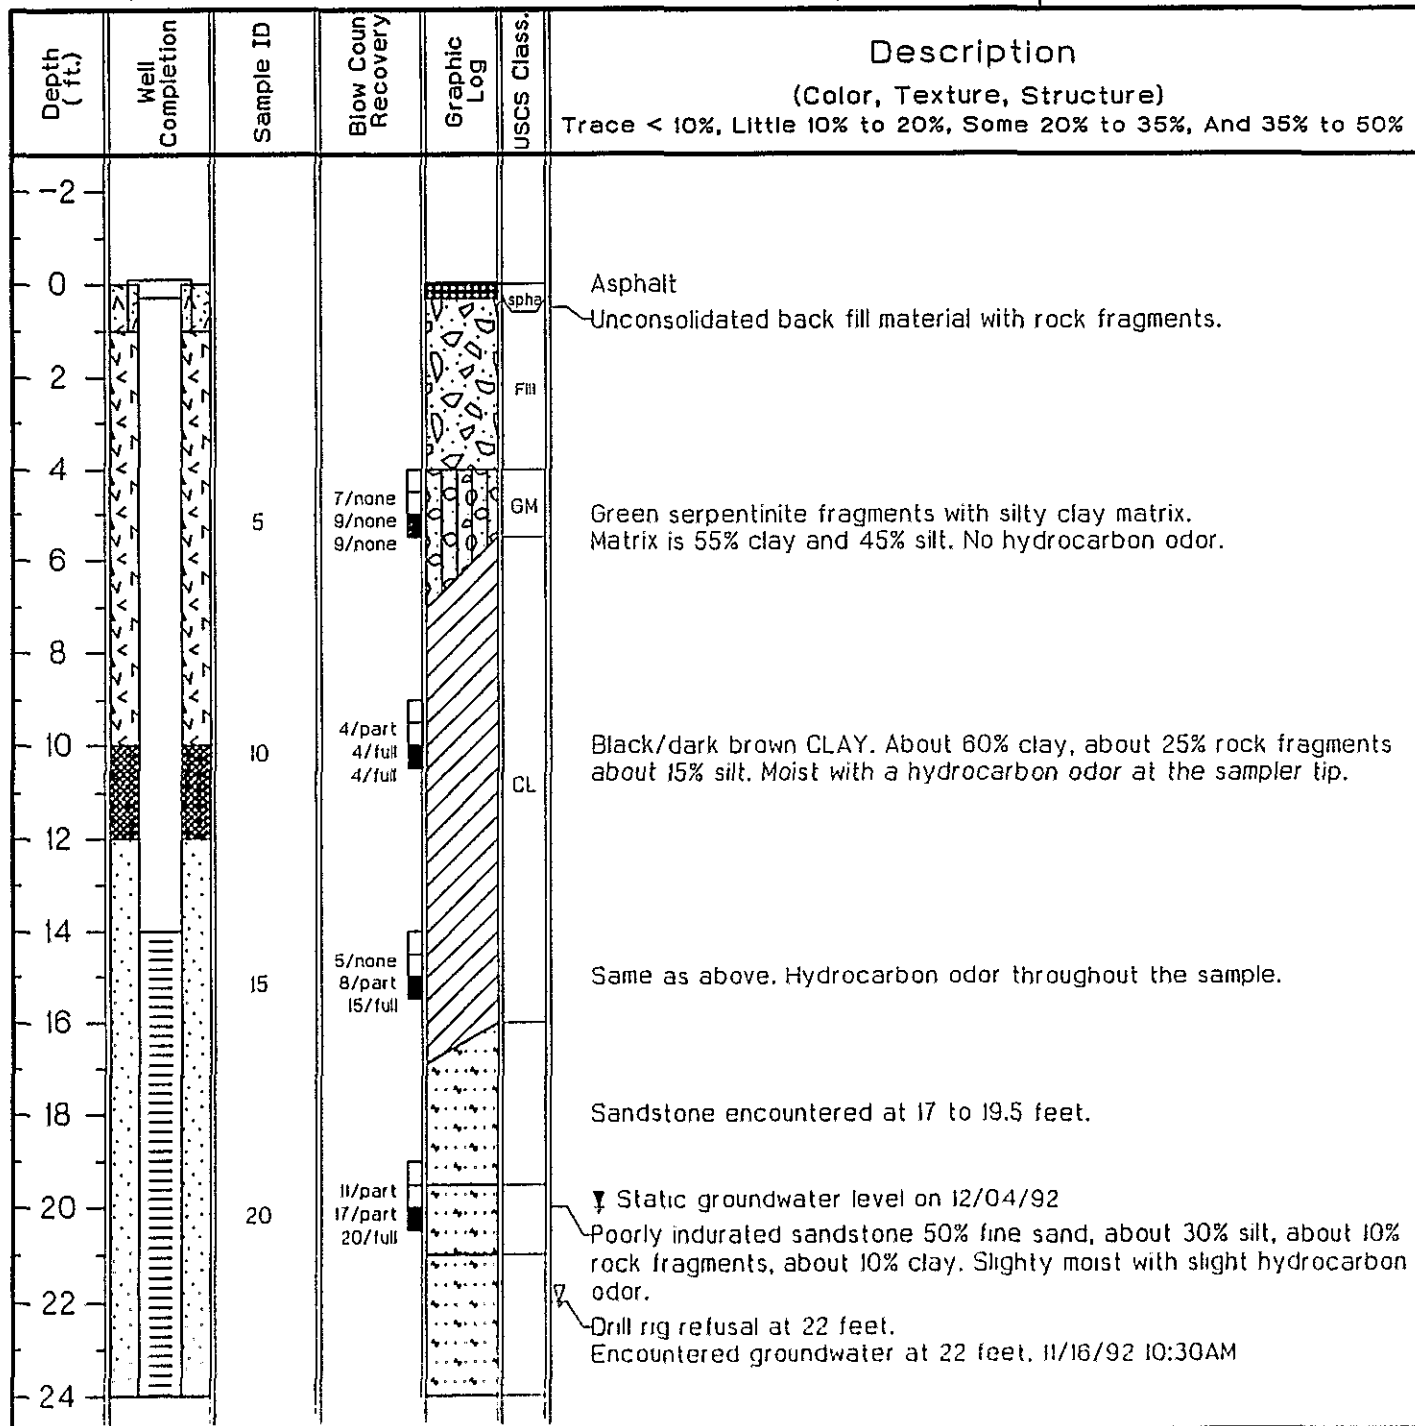



GROUNDWATER
TECHNOLOGY

Monitoring Well C8

Project CHV/3048 Ashby Ave. Owner Chevron U.S.A. Products Co.
Location Berkeley, CA Project No. 020203082 Date drilled 11/12/92

Depth (ft.)	Well Completion	Sample ID	Blow Count & Recovery	Graphic Log	USCS Class.	Description (Color, Texture, Structure) Trace < 10%, Little 10% to 20%, Some 20% to 35%, And 35% to 50%
24		25	/none 50/none 50/none			SANDSTONE. No hydrocarbon odor.
26		27	/none 50/none 50/part			Drill rig refusal at 27 feet.
28						
30						
32						SANDSTONE. No hydrocarbon odor. Drill rig refusal at 34 feet. Set the well at 34 feet below grade.
34		34	/none 50/none 50/none			End of boring at 34.5 feet. Installed groundwater monitoring well.
36						
38						
40						
42						
44						
46						
48						
50						
52						
54						
56						

CONFIDENTIAL


STATE OF CALIFORNIA DWR
WELL COMPLETION REPORT
(WELL LOGS)

REMOVED

CONFIDENTIAL

STATE OF CALIFORNIA DWR
WELL COMPLETION REPORT
(WELL LOGS)

REMOVED

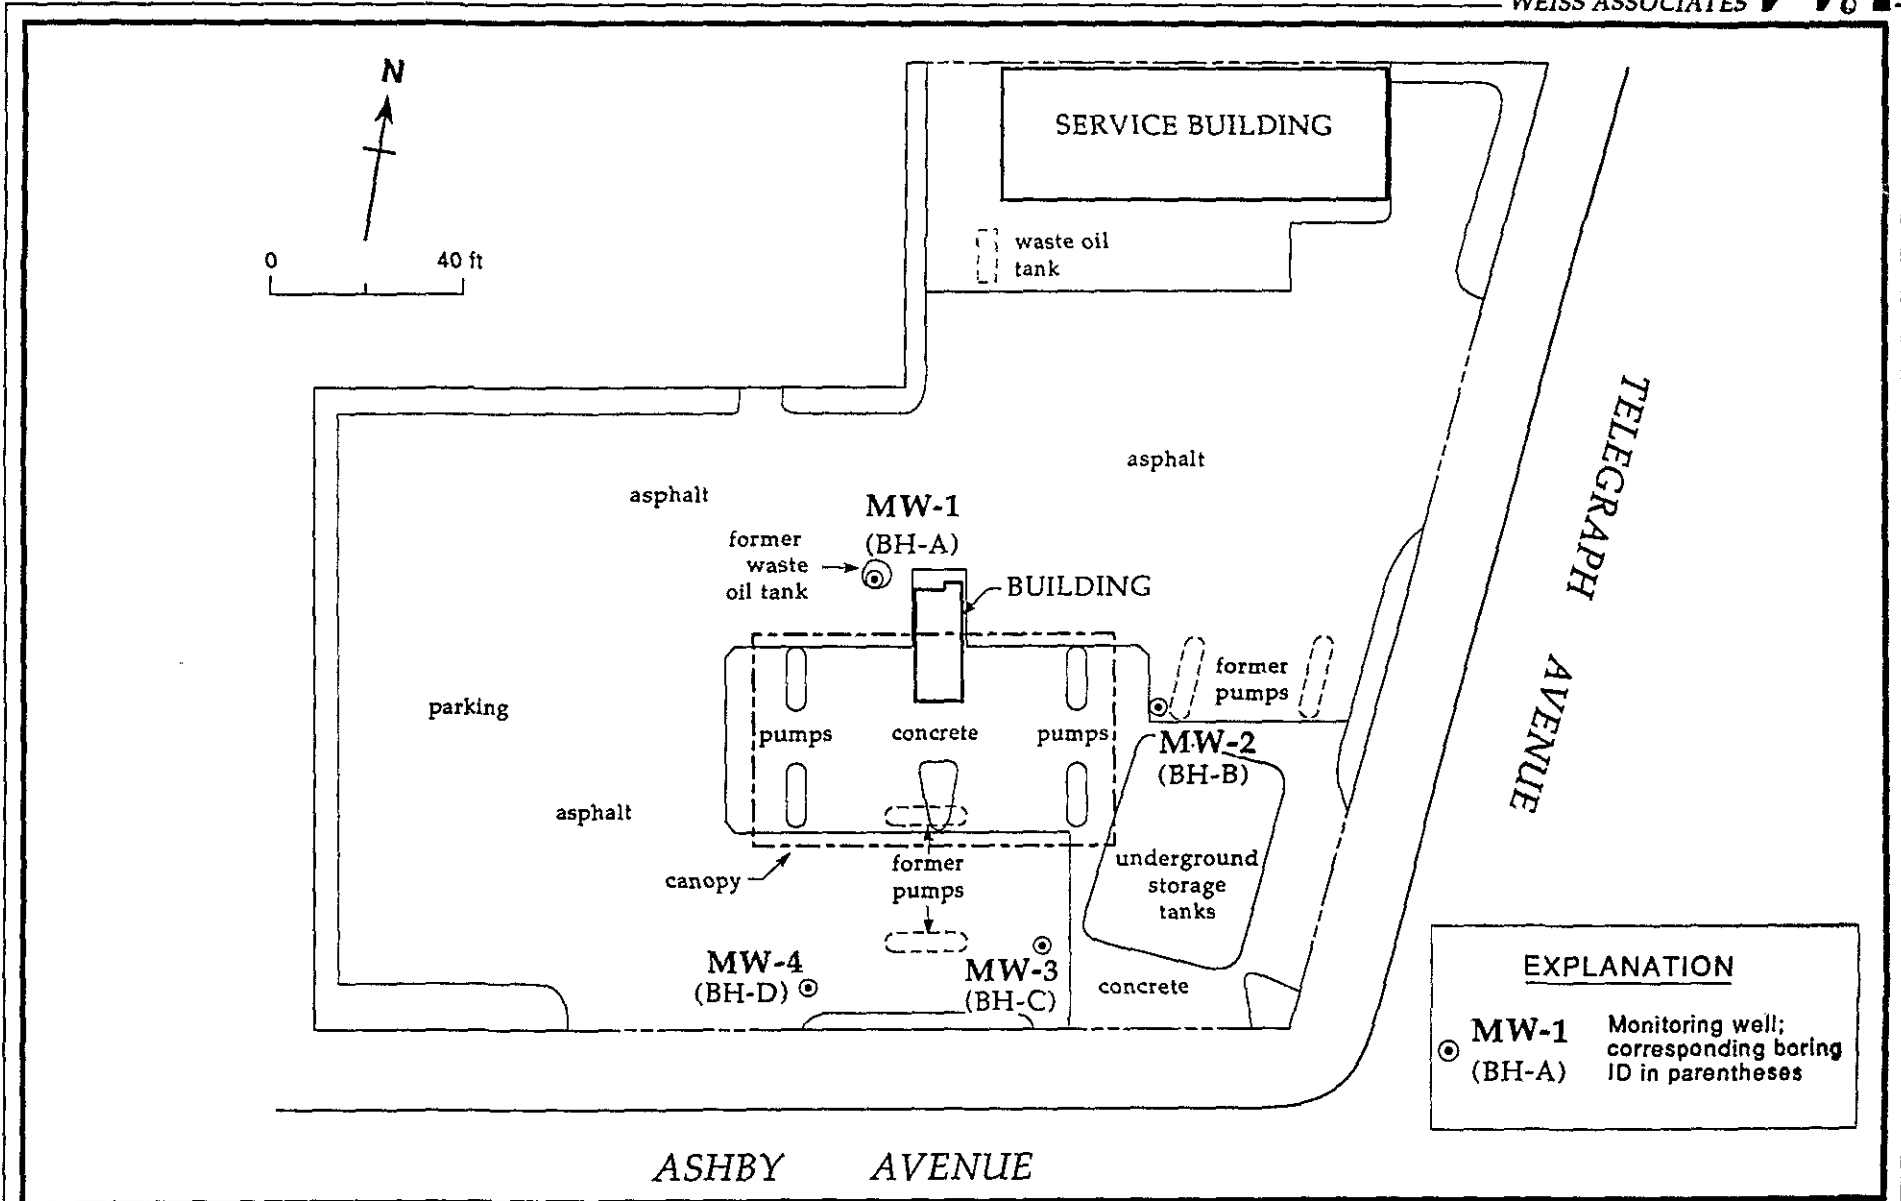

EXPLANATION	
⊙	MW-1 (BH-A)
	Monitoring well; corresponding boring ID in parentheses

Figure 4. Monitoring Well Locations - Chevron Service Station #90972, Berkeley, California

179096A-D
 15/4/01-12M1-4

Add
Inv



179096A

WEISS ASSOCIATES



WELL MW-1 (BH-A)

IS/4W 12M1

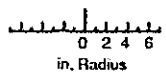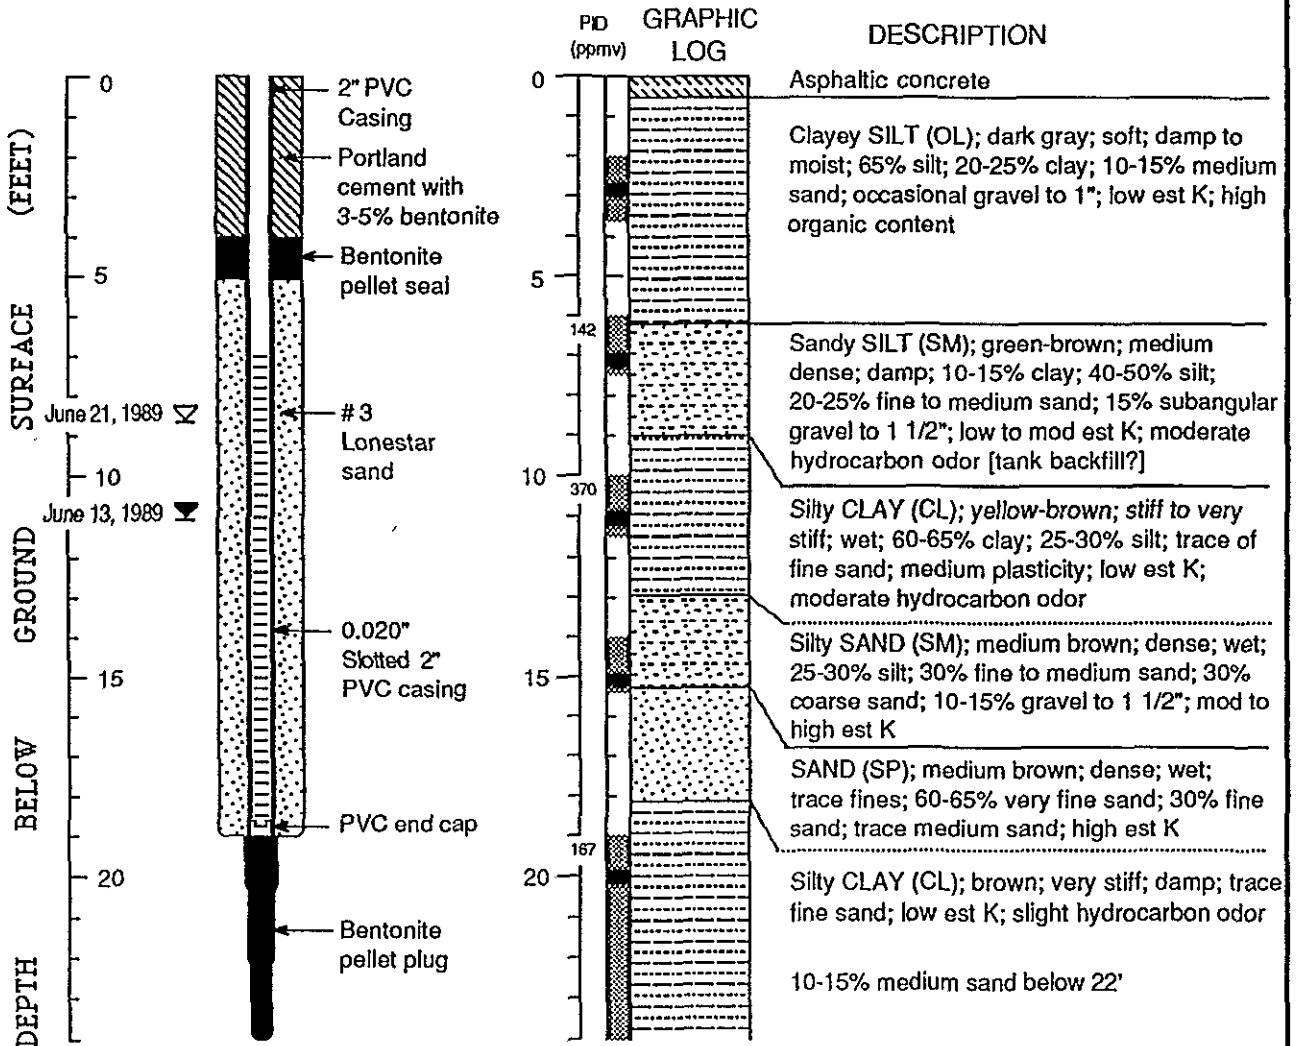

EXPLANATION

- | | |
|--|---|
| <ul style="list-style-type: none"> ▼ Water level during drilling (date) ◄ Water level (date) ----- Contact (dotted where approx.) - - - - - Uncertain contact ▨ Location of recovered drive sample ■ Location of drive sample sealed for chemical analysis ⊗ Cutting sample K = Estimated hydraulic conductivity | <ul style="list-style-type: none"> Logged by: Jim Carmody Supervisor: Richard Weiss; EG 1112 Drilling Company: Bay Area Exploration Driller: Rick Carr Drilling Method: Hollow stem auger Date Drilled: June 13, 1989 Well Head Completion: Locking stovepipe inside concrete vault Type of sampler: Split barrel (1.4", 2.0", 2.5" ID) |
|--|---|


Well Construction and Boring Log - Well MW-1 (BH-A) Chevron Service Station #90972 Berkeley, California

Add
Inv








1790968

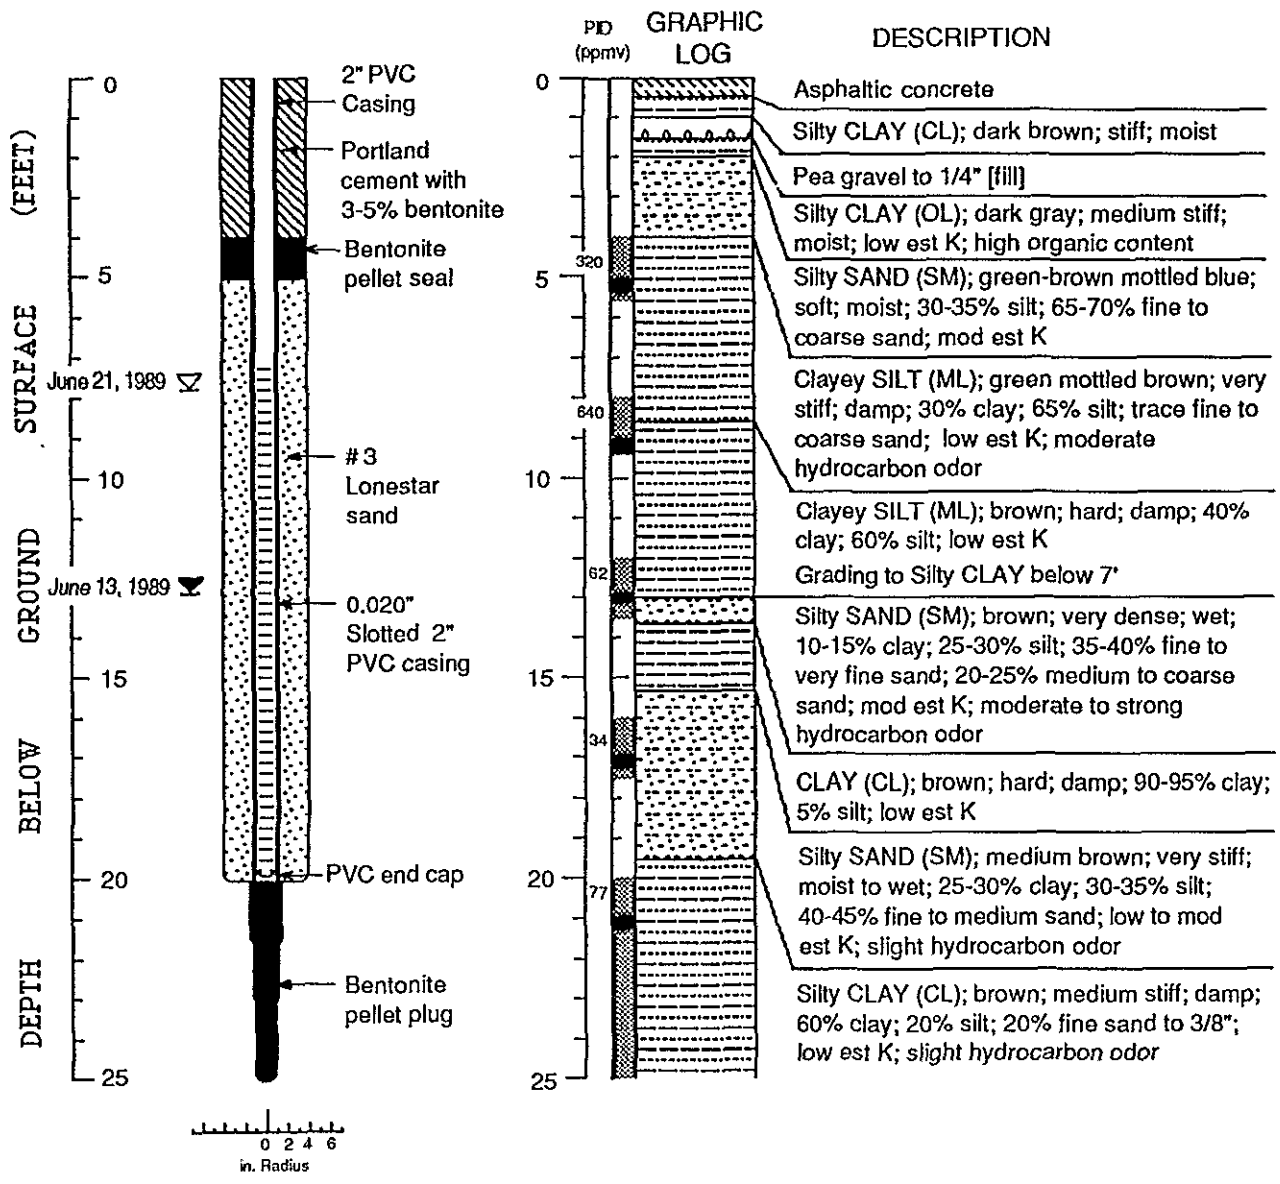WELL MW-2 (BH-B)

IS/W 12M2

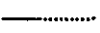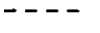

EXPLANATION


- | | | |
|---|---|---|
|  | Water level during drilling (date) | Logged by: Jim Carnody |
|  | Water level (date) | Supervisor: Richard Weiss; EG 1112 |
|  | Contact (dotted where approx.) | Drilling Company: Bay Area Exploration |
|  | Uncertain contact | Driller: Rick Carr |
|  | Location of recovered drive sample | Drilling Method: Hollow stem auger |
|  | Location of drive sample sealed for chemical analysis | Date Drilled: June 13, 1989 |
|  | Cutting sample | Well Head Completion: Locking stovepipe inside concrete vault |
| K = | Estimated hydraulic conductivity | Type of sampler: Split barrel (1.4", 2.0", 2.5" ID) |

Well Construction and Boring Log - Well MW-2 (BH-B) Chevron Service Station #90972 Berkeley, California

Add ✓
Inv ✓

WELL MW-3 (BH-C)

15/4612M3

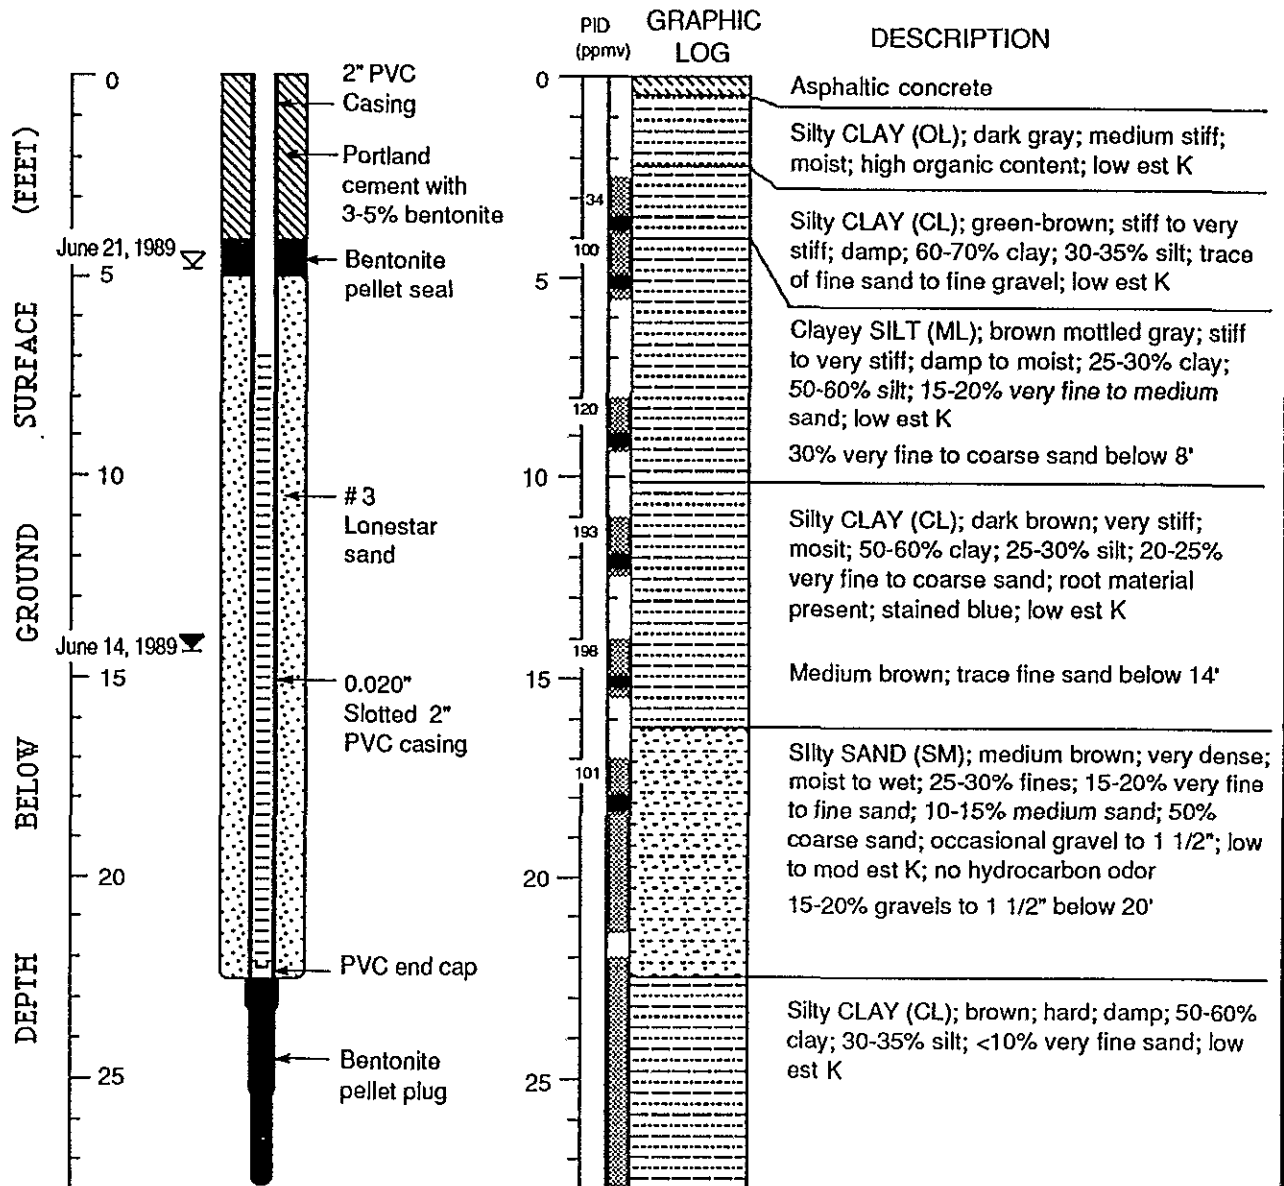


EXPLANATION	
▽	Water level during drilling (date)
▽	Water level (date)
.....	Contact (dotted where approx.)
---	Uncertain contact
▨	Location of recovered drive sample
■	Location of drive sample sealed for chemical analysis
⊗	Cutting sample
K	= Estimated hydraulic conductivity








Logged by: Jim Carmody
 Supervisor: Richard Weiss; EG 1112
 Drilling Company: Bay Area Exploration
 Driller: Rick Carr
 Drilling Method: Hollow stem auger
 Date Drilled: June 14, 1989
 Well Head Completion: Locking stovepipe inside concrete vault
 Type of sampler: Split barrel (1.4", 2.0", 2.5" ID)

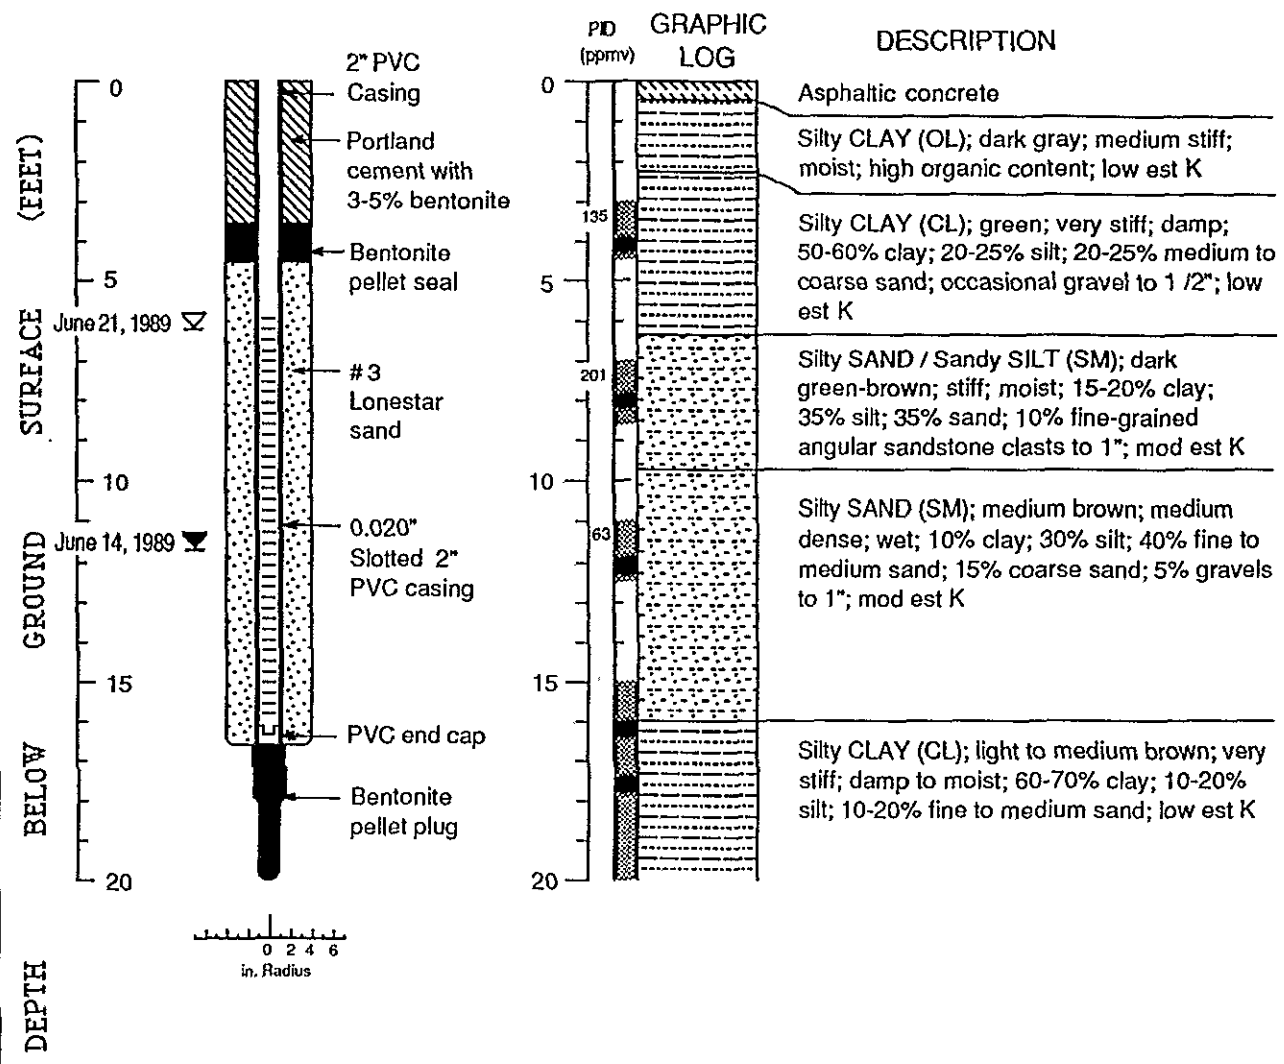Add ✓
Incl ✓

WELL MW-4 (BH-D) 1S/4W/2M4

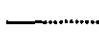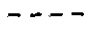

EXPLANATION

- | | | |
|---|---|---|
|  | Water level during drilling (date) | Logged by: Jim Carmody |
|  | Water level (date) | Supervisor: Richard Weiss; EG 1112 |
|  | Contact (dotted where approx.) | Drilling Company: Bay Area Exploration |
|  | Uncertain contact | Driller: Rick Carr |
|  | Location of recovered drive sample | Drilling Method: Hollow stem auger |
|  | Location of drive sample sealed for chemical analysis | Date Drilled: June 14, 1989 |
|  | Cutting sample | Well Head Completion: Locking stovepipe inside concrete vault |
| K = | Estimated hydraulic conductivity | Type of sampler: Split barrel (1.4", 2.0", 2.5" ID) |

Well Construction and Boring Log - Well MW-4 (BH-D) Chevron Service Station #90972 Berkeley, California

CONFIDENTIAL

STATE OF CALIFORNIA DWR
WELL COMPLETION REPORT
(WELL LOGS)

REMOVED



---TELEGRAPH---

125'

100'



NOTES - T-A = 10,000 gal gas
 T-B = 5,000 gal gas
 T-C = 5,000 gal gas
 T-D = 550 waste oil
 S = Soil sample result
 GW = Groundwater sample result
 Sample results are motor fuel hydrocarbons (EPA5020/8015) in ppm.

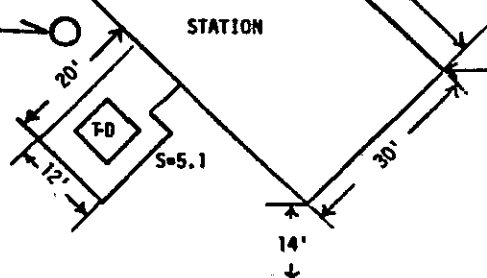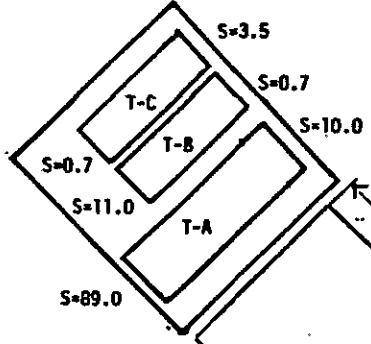

approximate location of monitoring well

52'

---ALCATRAZ---



6392 Telegraph Ave., Oakland, California

SCALE:	APPROVED BY:	DRAWN BY:
DATE:		REVISED:

AQUA SCIENCE ENG.

Figure 1, not to scale

DRAWING NUMBER

01-4221E
 015/04/2011

01-422Z
01504W RW1

WATER WELL DRILLERS REPORT

Owner: Glivens and Zweben
6407 Fairmont Ave.
El Cerrito, CA 94530

Constructed: 7-26-88

County: Alameda Permit No: ACFC 88346

Equipment: Rotary (Geospace 1200) Gravel Pack: Yes/#3 Aquarlum Sand
From: 8 ft. to 24 ft.

Casing: 2" PVC Perforations: 0.010"
From: to 29 ft. From: 9 ft. 24 ft.

Well Seal: Yes/neat Portland cement surface to 7 ft., bentonite 7 ft.
to 8 ft. bentonite from 24 ft. to 29 ft.

Water Levels

Depth of First Water: .
Depth After Well Completion:

Sampling: Soils by Calif. Split Spoon, 5 ft. and 10 ft.

Chemical Analysis: Yes, GC/FID of two soil samples and one water sample
(results negative)

Well Use: monitoring Pump Tests: No

01-4223

PROJECT: GIVENS AND ZWEBEN, OAKLAND

Add ✓
Inv ✓

LOG OF BOREHOLE S/4W 12N

depth ft.	SOILS DESCRIPTION	BOREHOLE DETAILS	Hammer Blow Count	REMARKS
0				
1	Black Silty Clay, Slightly Moist, Medium Plasticity (CL)	Steel Cover		
2				
3				
4	Brown to Light Brown Silty Clay, Minor Quantity of Fine Gravel (CL)	Cement		
5			10	Soil Sample
6			12	
7			13	
8	Brown to Light Brown Silty Clay, Minor Quantity of Fine to Medium Gravel Increasing Moisture Content (CL)	Bentonite		
9				
10				
11				
12				
13	Fine to Medium Gravel Mixed With Sand, Some Silty Clay (GC)			
14				
15				
16				
17				






**AQUA
SCIENCE
ENGINEERS**

Water Table

No. 3 Monterey Sand

Date: 7-26-88

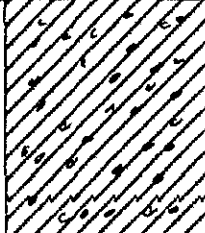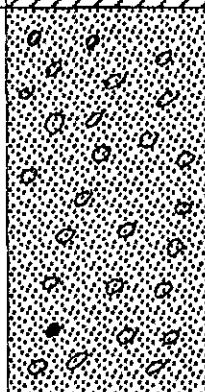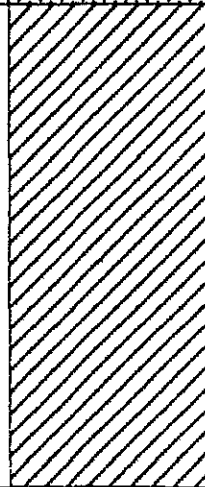Logged By: Bruce Berman

depth ft.	SOILS DESCRIPTION	BOREHOLE DETAILS	Hammer Blow Count	REMARKS
18 19	Fine to Medium Gravel Mixed With Sand, Some Silty Clay (GC)			
20 21 22 23	Coarse Gravel (GP)		20	
24 25 26 27	Light Brown to Yellow Silty Clay Moist, Stiff, Some Coars Sand and Gravel (CH)		25	
29 30 31 32 33 34 35	B.O.H. AQUA SCIENCE ENGINEERS	 Bentonite 	30	

USA LOCATION REQUEST FORM

CA: 800-842-2444

REQUEST # 110343

NV: 800-227-2600

DATE CALLED IN: 7-21-88

ADDRESS OR DESCRIPTION WHERE YOU WILL BE DIGGING:

6392 Telegraph Ave., Oakland
abandoned gas station

CITY: Oakland

NEAREST CROSS STREET: Alcatraz

NATURE OF WORK: exploratory drilling & soil
sampling

WHO IS THE WORK BEING DONE FOR? Shell Givens

STARTING DATE: 7-25-88 TIME: 8:00 am

YOUR NAME: Bruce Berman

YOUR COMPANY'S NAME: Aqua Science Engineers

AREA CODE AND TELEPHONE NUMBER WHERE YOU CAN BE REACHED?

(415) 268-9391


COUNTY WHERE WORK IS BEING DONE: Alameda

WORK PERMIT, CITY OR COUNTY? None Required NUMBER:

FOREMAN OF THE JOB Bruce Berman


TWO WORKING DAYS NOTICE IS REQUIRED ON ALL LOCATION REQUESTS. EACH LOCATION IS ACTIVE FOR 14 CALENDAR DAYS FROM THE DATE IT IS CALLED IN.

6

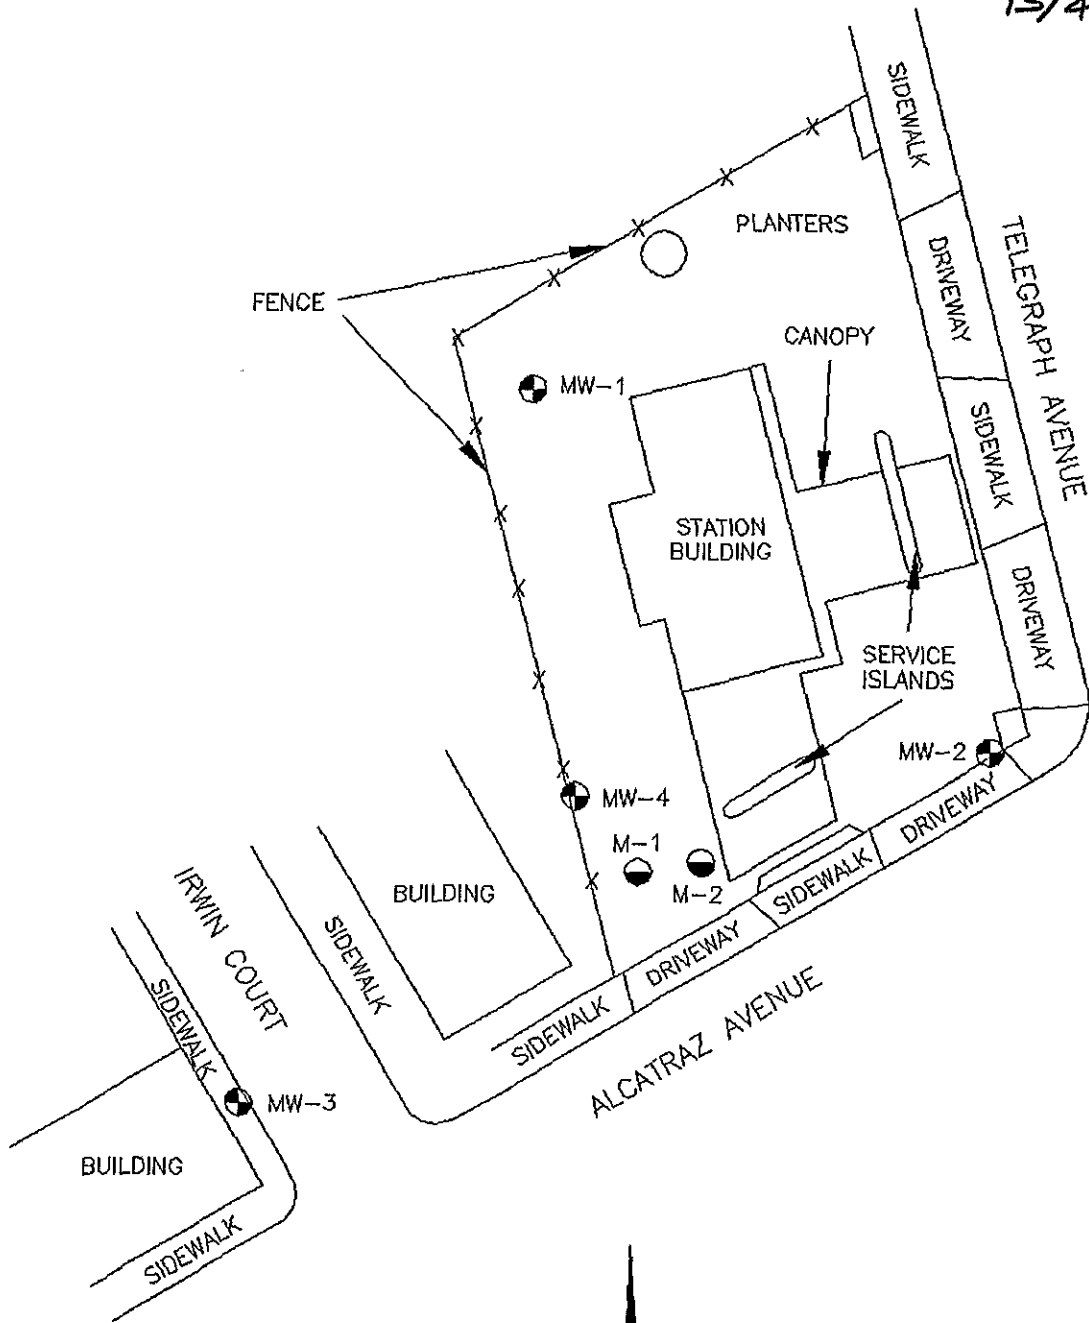

- MW-4 ● = Monitoring well installed by Applied GeoSystems (July 1989)
- M-2 ● = Tank pit monitoring well installed by Applied GeoSystems (1988)

Source: Surveyed by Ron Archer
Civil Engineer, Inc.

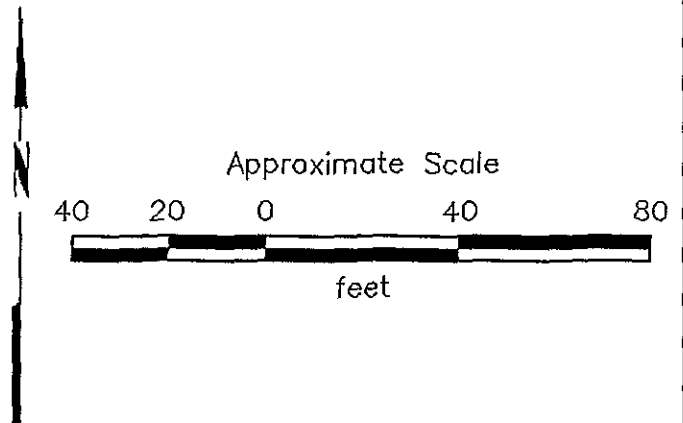

PROJECT NO. 18039-3

GENERALIZED SITE PLAN
ARCO Station No. 374
6407 Telegraph Avenue
Oakland, California

PLATE
P - 2

01-2175

In-Add/15/4W 12N2

Total depth of boring: 28-1/2 feet Diameter of boring: 11 inches Date drilled: 7-6-89

Saving diameter: 4 inches Length: 27 feet Slot size: 0.020-inch

Screen diameter: 4 inches Length: 20 feet Material type: Sch 40 PVC

Drilling Company: Kvilhaug Drilling Company, Inc. Driller: Rod and Leroy

Method Used: Hollow-Stem Auger Field Geologist: Becky and Keith

Signature of Registered Professional: _____

Registration No.: _____ State: CA

Depth	Sample No.	Blows	P.I.D.	USCS Code	Description	Well Const.
0					Asphalt.	
2				CL	Silty clay, dark brown, slightly damp, medium plasticity, very stiff, rootlets, minor iron staining.	
4	S-3.5	4 12 18				
8	S-8.5	3 5 12			Sandy clay, grading to clay with gravel, some mottling, slight plasticity, stiff.	
14	S-13.5	15 18 20			Slightly green, hard.	
18	S-18.5	8 10 12			Silty clay, some sand and gravel, light brown, moist, medium plasticity, very stiff.	
20						

(Section continues downward)



PROJECT NO. 18039-3

LOG OF BORING B-1/MW-1

ARCO Station No. 374
6407 Telegraph Avenue
Oakland, California

PLATE

P - 4

Depth	Sample No.	BLOWS	P.I.D.	USCS Code	Description	Well Const.
				CL	Silty clay, some sand and gravel, light brown, moist, medium plasticity, stiff.	[Well Const. Diagram]
-22	S-23	3 5 7			Trace gravel.	
-24						
-26						
-28	S-28	3 5 7				
Total Depth = 28-1/2 feet.						
-30						
-32						
-34						
-36						
-38						
-40						
-42						
-44						
-46						
-48						
-50						



PROJECT NO. 18039-3

LOG OF BORING B-1/MW-1

ARCO Station No. 374
6407 Telegraph Avenue
Oakland, California

PLATE

P - 5

01-2177 Inu Add 15/4W 12N3

Total depth of boring: 28-1/2 feet Diameter of boring: 11 inches Date drilled: 7-6-89

Casing diameter: 4 inches Length: 27 feet Slot size: 0.020-inch

Screen diameter: 4 inches Length: 20 feet Material type: Sch 40 PVC

Drilling Company: Kvilhaug Drilling Company, Inc. Driller: Rod and Leroy

Method Used: Hollow-Stem Auger Field Geologist: Becky and Keith

Signature of Registered Professional: _____

Registration No.: _____ State: CA

Depth	Sample No.	Blows	P.I.D.	USCS Code	Description	Well Const.
0				CL	Sandy clay, dark brown, damp, slight plasticity, very stiff.	
2		6				
4	S-3.5	10 12				
6						
8	S-8.5	7 20 25			Silty clay, with some gravel, light brown, damp, hard.	
10						
12						
14	S-13.5	5 7 15			Very stiff.	
16						
18	S-18.5	7 20 25			Silty clay with gravel, brown, moist, hard.	
20						

(Section continues downward)



PROJECT NO. 18039-3

LOG OF BORING B-2/MW-2
 ARCO Station No. 374
 6407 Telegraph Avenue
 Oakland, California

PLATE

P - 6

Depth	Sample No.	BLOWS	P.I.D.	USCS Code	Description	Wall Const.
-22	S-23	.3		CL	Silty clay with gravel, brown, moist, hard.	
		5				
-24		12				
-26						
-28	S-28	.10			Silty clay with sand, medium brown, slightly damp, slight plasticity, hard.	
		20				
		25				
-30	Total Depth = 28-1/2 feet.					
-32						
-34						
-36						
-38						
-40						
-42						
-44						
-46						
-48						
-50						



PROJECT NO. 18039-3

LOG OF BORING B-2/MW-2

PLATE

ARCO Station No. 374
6407 Telegraph Avenue
Oakland, California

P - 7

01-2170

Inu Addl SCHW 12N 4

Total depth of boring: 28-1/2 feet Diameter of boring: 11 inches Date drilled: 7-7-89

Casing diameter: 4 inches Length: 27 feet Slot size: 0.020-inch

Screen diameter: 4 inches Length: 20 feet Material type: Sch 40 PVC

Drilling Company: Kvilhaug Drilling Company, Inc. Driller: Rod and Leroy

Method Used: Hollow-Stem Auger Field Geologist: Becky and Keith

Signature of Registered Professional: _____

Registration No.: _____ State: CA

Depth	Sample No.	Blows	P.I.D.	USCS Code	Description	Well Const.
0					Concrete (4 inches) over baserock (6 inches).	
2				CL	Silty clay, with sand and some gravel, medium brown, damp, slight plasticity, stiff, rootlets.	
3		3				
4	S-3.5	10				
8					Damp.	
8	S-8.5	8				
12						
14	S-13.5	10			Some mottling, moist.	
18						
18	S-18.5	12			Silty clay, minor gravel, light to medium brown, damp, medium plasticity, stiff.	
20						

(Section continues downward)



PROJECT NO. 18039-3

LOG OF BORING B-3/MW-3

ARCO Station No. 374
6407 Telegraph Avenue
Oakland, California

PLATE

P - 8

Depth	Sample No.	BLOWS	P.I.D.	USCS Code	Description	Well Const.
-22	S-23.5	.6		CL	Silty clay, minor gravel, light to medium brown, damp, medium plasticity, stiff. Very stiff.	
-24		8				
-24		12				
-26						
-28	S-28.5	.5			Silty clay with sand, slight plasticity, very stiff.	
-28		10				
-28		12				
-30					Total Depth = 28-1/2 feet.	
-32						
-34						
-36						
-38						
-40						
-42						
-44						
-46						
-48						
-50						



LOG OF BORING B-3/MW-3

PLATE

ARCO Station No. 374
6407 Telegraph Avenue
Oakland, California

P - 9

PROJECT NO. 18039-3

01-217V

Inn Add 15/4W 12N5

Total depth of boring: 27-1/2 feet Diameter of boring: 11 inches Date drilled: 7-7-89

Casing diameter: 4 inches Length: 27 feet Slot size: 0.020-inch

Screen diameter: 4 inches Length: 20 feet Material type: Sch 40 PVC

Drilling Company: Kvilhaug Drilling Company, Inc. Driller: Rod and Leroy

Method Used: Hollow-Stem Auger Field Geologist: Becky and Keith

Signature of Registered Professional: _____

Registration No.: _____ State: CA

Depth	Sample No.	Blows	P.I.D.	USCS Code	Description	Well Const.
0				CL	Silty clay, some sand and fine-grained gravel, very dark brown, slightly damp, slight plasticity, stiff.	
2		2				
3.5		3				
4		8				
6						
8		3				
8.5		4				
10		10				
12		4				
14	S-13.5	10		GM	Sandy gravel, some silt, medium brown, very moist, medium dense.	
15		25				
16						
18		15				
18.5	S-18.5	15				
20		20			Wet, dense.	

(Section continues downward)



PROJECT NO. 18039-3

LOG OF BORING B-4/MW-4

ARCO Station No. 374
6407 Telegraph Avenue
Oakland, California

PLATE

P - 10

Depth	Sample No.	BLOWS	P.I.D.	USCS Code	Description	Well Const.
				GM	Sandy gravel, some silt, medium brown, very moist, medium dense.	
-22		.6		CL	Silty clay, some sand and gravel, very stiff.	
-24	S-23.5	12 15				
-26		.7 20			Grades more gravelly.	
-28	S-27	20			Total Depth = 27-1/2 feet.	
-30						
-32						
-34						
-36						
-38						
-40						
-42						
-44						
-46						
-48						
-50						



PROJECT NO. 18039-3

LOG OF BORING B-4/MW-4 PLATE
 ARCO Station No. 374
 6407 Telegraph Avenue
 Oakland, California
 P. - 11

CONFIDENTIAL

STATE OF CALIFORNIA DWR
WELL COMPLETION REPORT
(WELL LOGS)

REMOVED

CONFIDENTIAL


STATE OF CALIFORNIA DWR
WELL COMPLETION REPORT
(WELL LOGS)

REMOVED

CONFIDENTIAL

**STATE OF CALIFORNIA DWR
WELL COMPLETION REPORT
(WELL LOGS)**

REMOVED

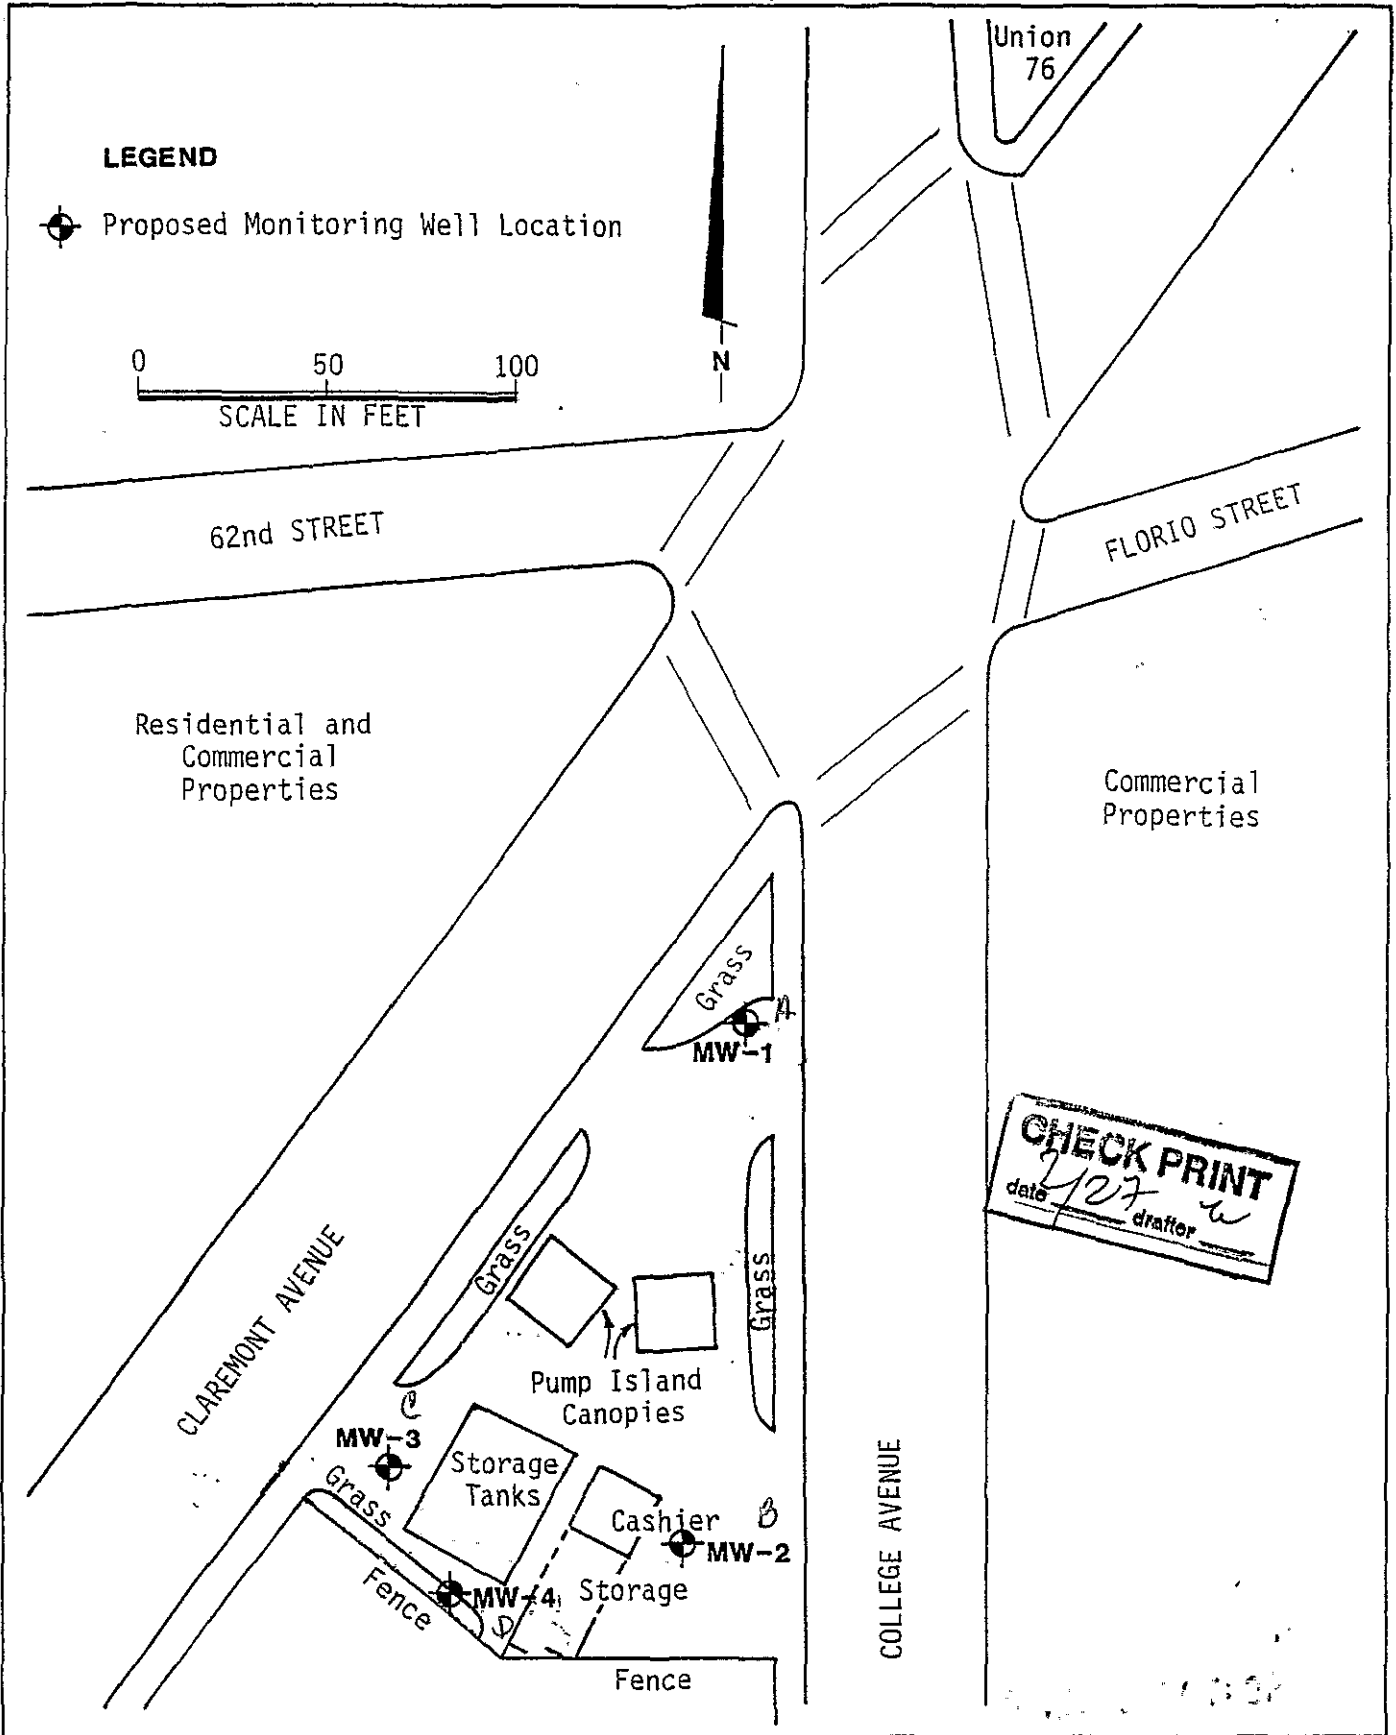

CHECK PRINT
 date 2/27
 drafter w



Harding Lawson Associates
 Engineering and Environmental Services


Monitoring Well Locations
 Shell Service Station
 6039 College Avenue
 Oakland, California

PLATE
4

DRAWN KH	JOB NUMBER 4022,233.03	APPROVED	DATE 11/89	REVISED DATE
-------------	---------------------------	----------	---------------	--------------

Top of PVC Casing
Elevation 195.89

12" EMCO WHEATON A-721 MANHOLE
WITH WATERPROOF COVER

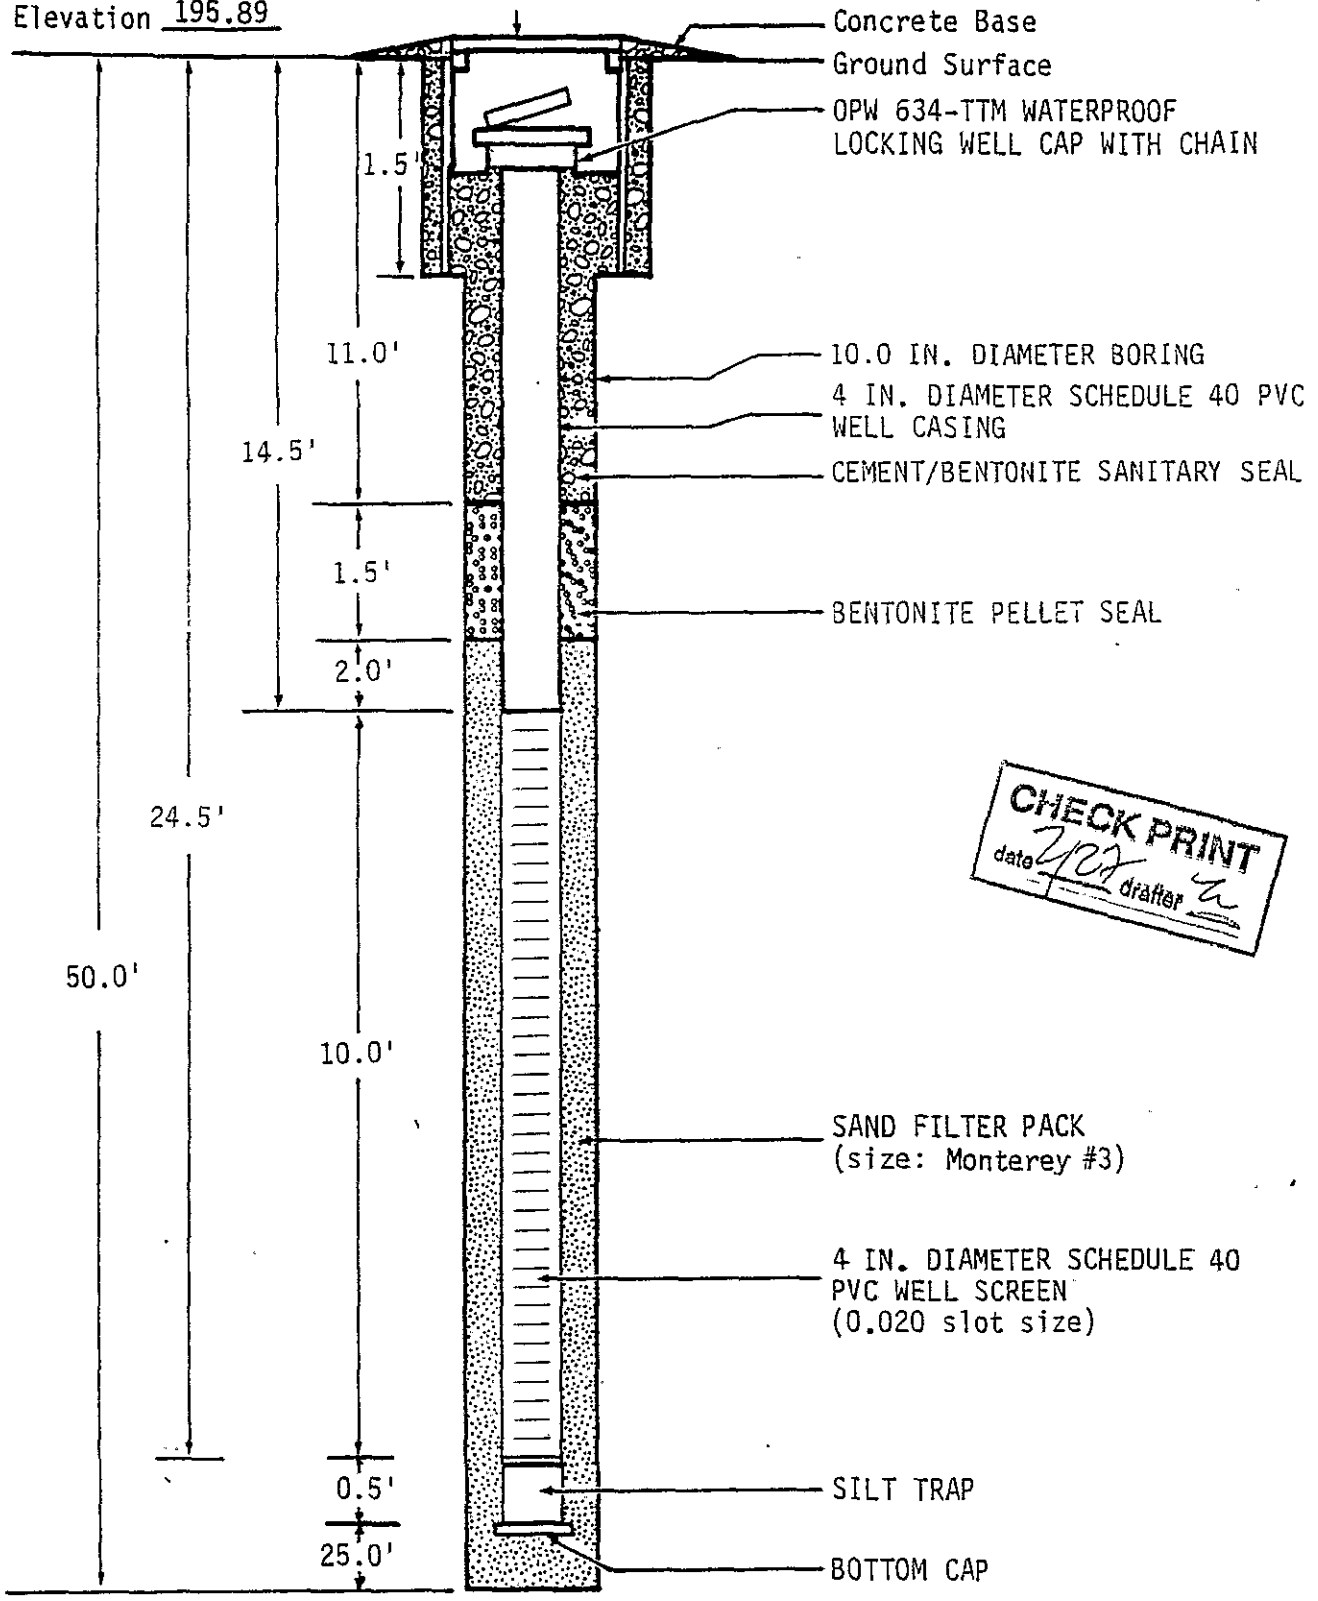

CHECK PRINT
 date 2/90 drafter [Signature]

NOT TO SCALE



Harding Lawson Associates
Engineers and Geoscientists

Well Completion Diagram MW-1
Shell Service Station
6039 College Avenue
Oakland, California

PLATE

DRAWN YC	JOB NUMBER 4022,233.03	APPROVED	DATE 2/90	REVISED	DATE
-------------	---------------------------	----------	--------------	---------	------

Blows/ foot	Photo Ionization Detector (ppm)	Well Screen Interval	Gasoline Odor	Depth (ft)	Sample	(Continuation of Log)
29	0		None	40		MOTTLED BROWN-GRAY SILT (ML), medium dense, moist
32	0		None			BROWN SILTY SAND WITH GRAVEL (SM), dense, saturated, gravel ≤.5 inch, some clay
42	0		None	45		BROWN LEAN CLAY WITH GRAVEL (CL), hard, moist, gravel ≤.5 inch
48	0					MOTTLED BROWN-ORANGE SILT (ML), medium dense, moist, some gravel decreasing towards bottom
15	0			50		Same, mottled gray-brown, partial cementation
31	0					
				55		
				60		
				65		
				70		
				75		
				80		

CHECK PRINT
date 3/14 drafter a



Harding Lawson Associates
Engineers, Geologists
& Geophysicists

Log of Boring B-1, MW-1
Shell Service Station
6039 College Avenue
Oakland, California

PLATE

DRAWN
YC


JOB NUMBER
4022,233.03

APPROVED

DATE
2/90


REVISED

DATE

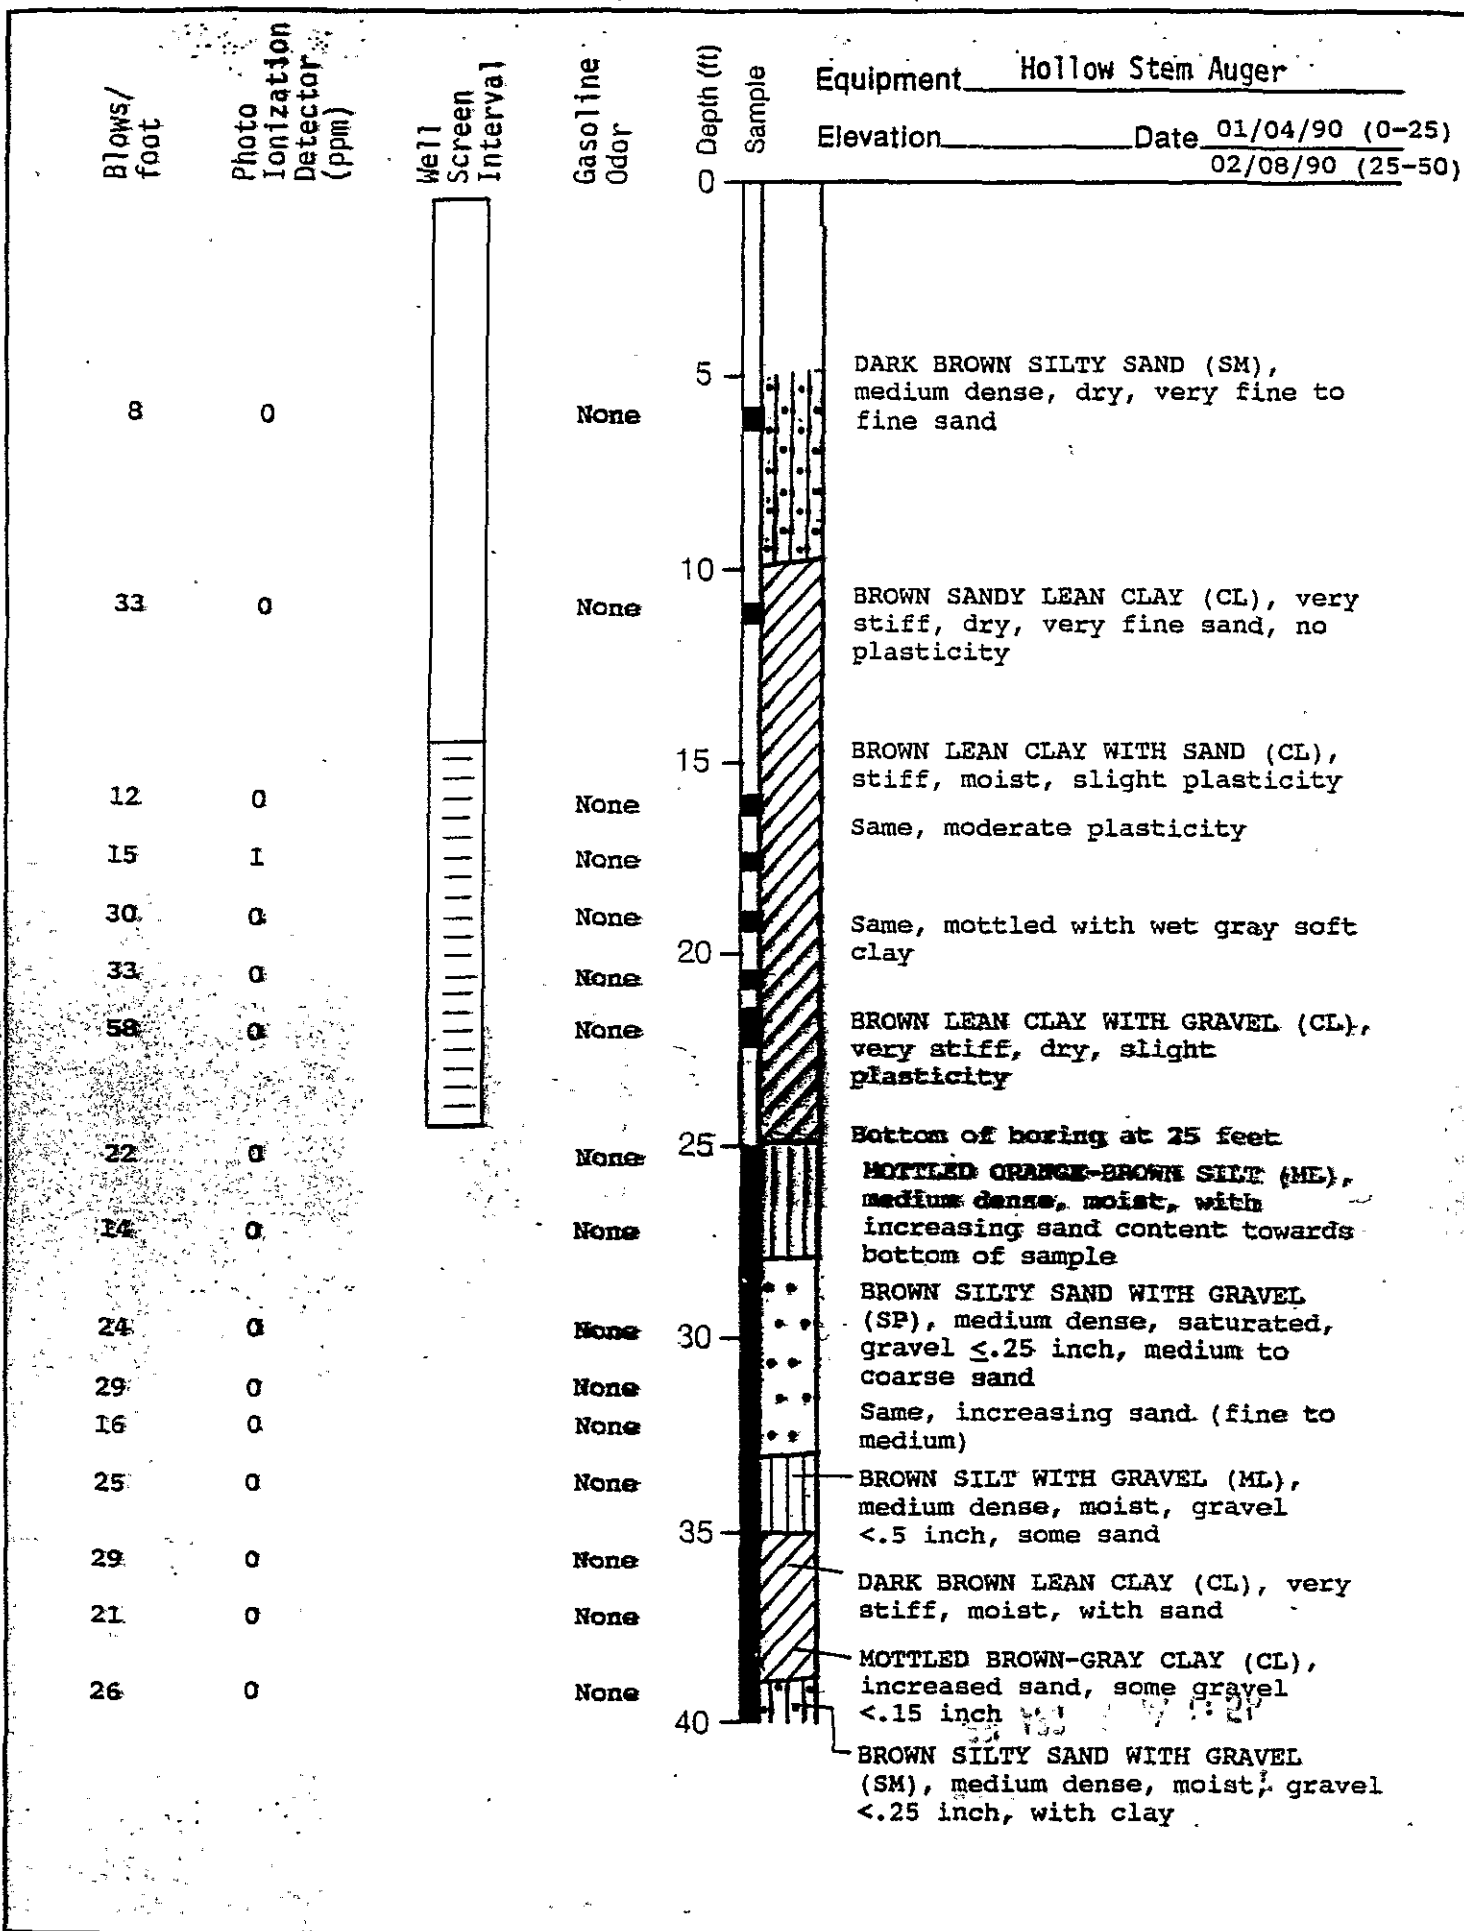

Top of PVC Casing
Elevation 194.27

12" EMCO WHEATON A-721 MANHOLE
WITH WATERPROOF COVER

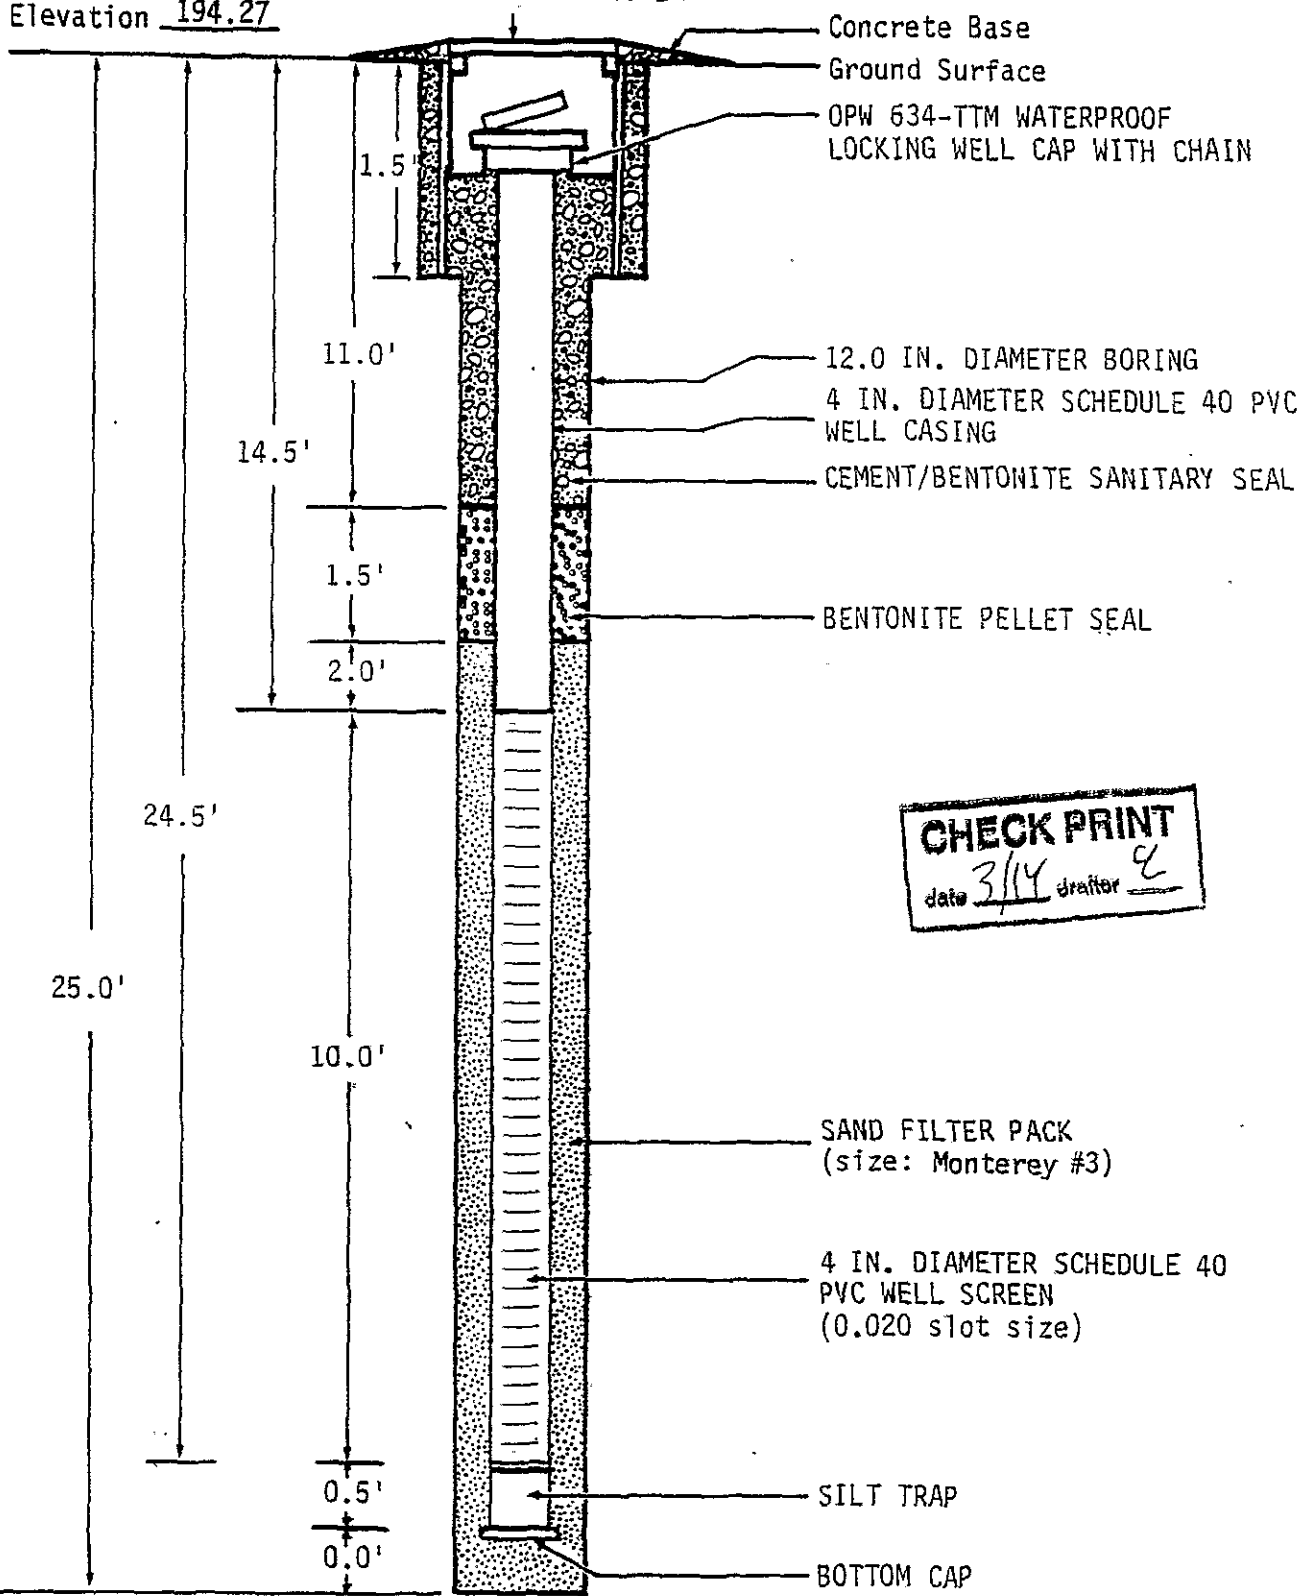

CHECK PRINT
 date 3/14 drafter [Signature]

NOT TO SCALE



Harding Lawson Associates
Engineers and Geoscientists

Well Completion Diagram MW-2

Shell Service Station
6039 College Avenue
Oakland, California

PLATE

DRAWN
YC

JOB NUMBER
4022,233.03


APPROVED

DATE
2/90

REVISED

DATE

34 24010 1914W 13B2

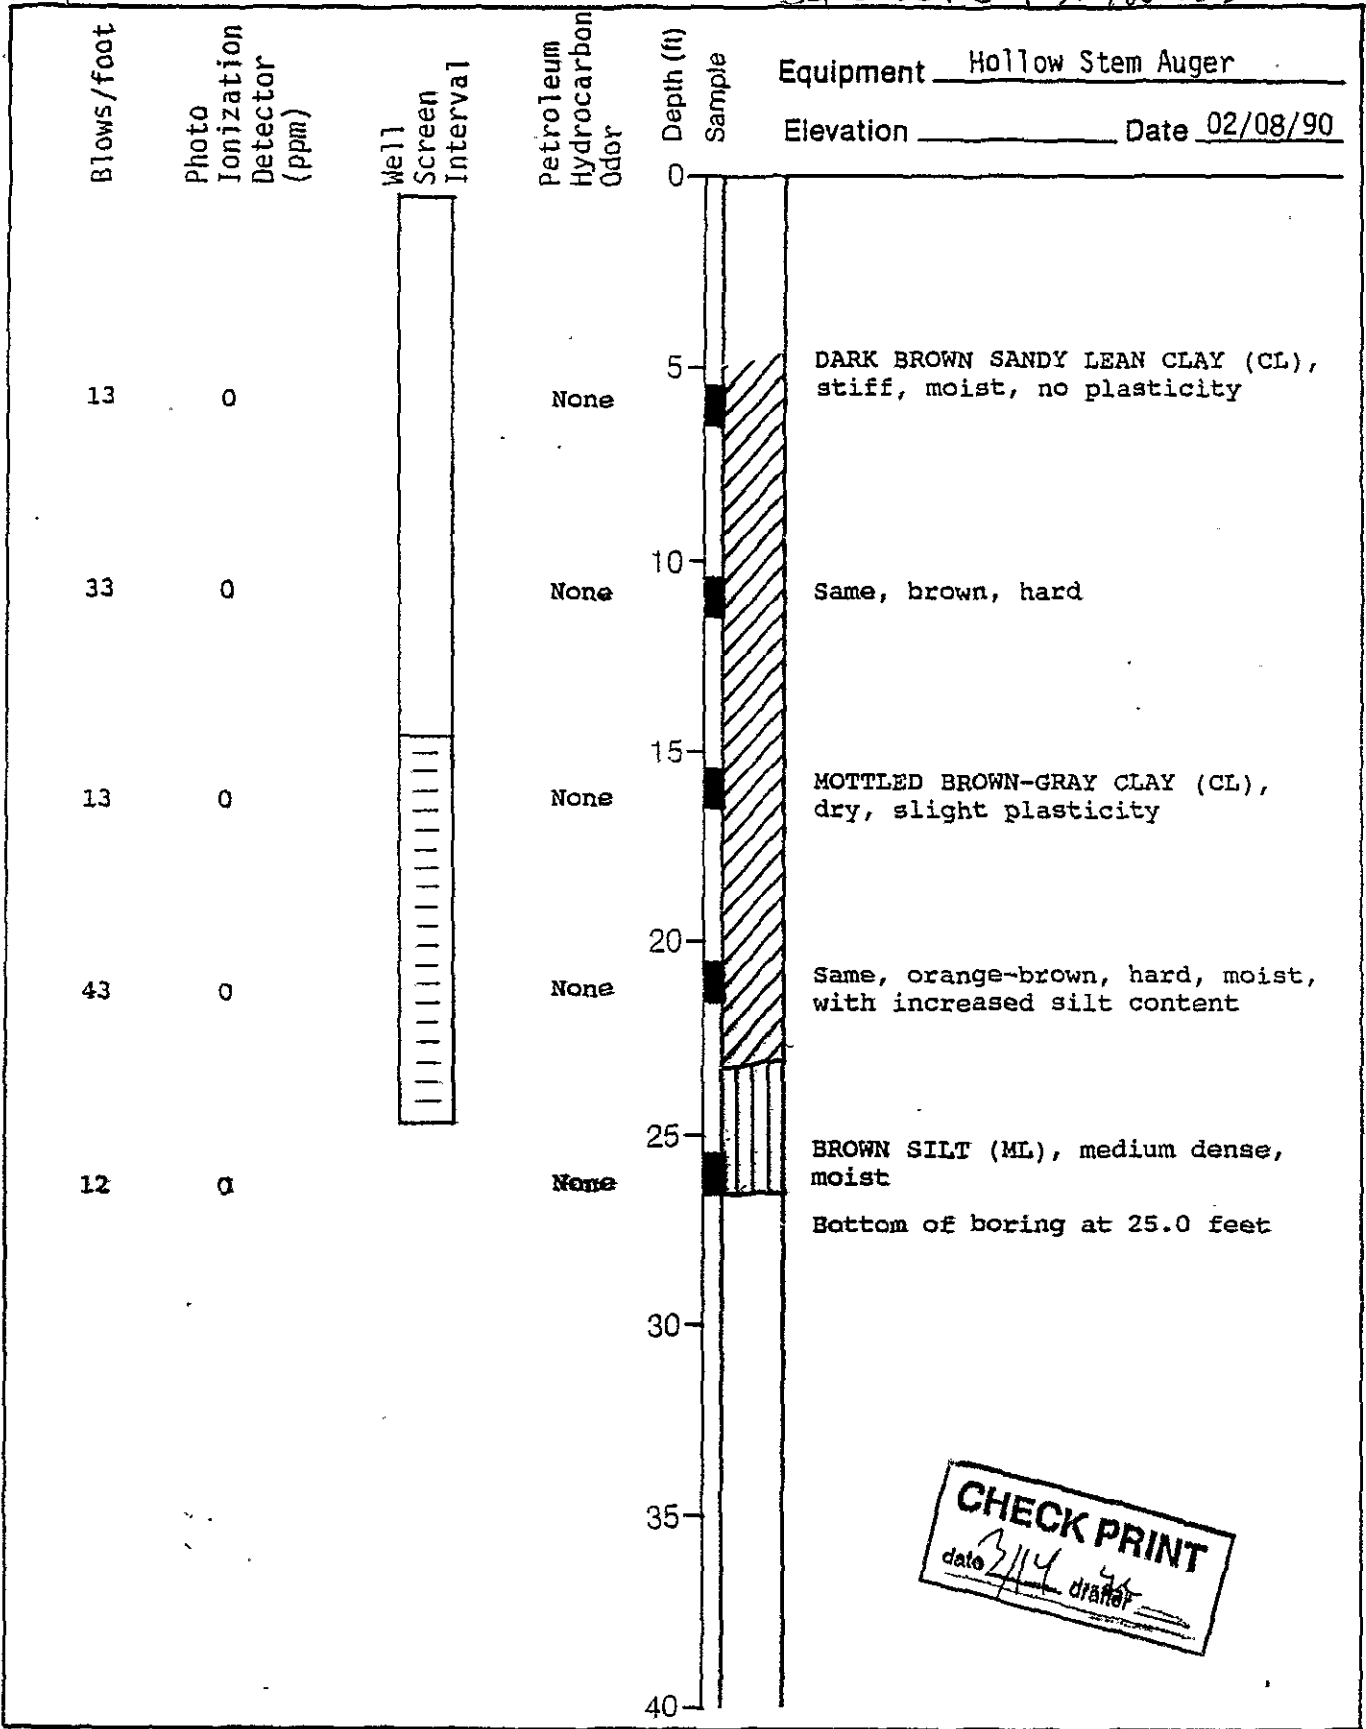

CHECK PRINT
 date 2/14/90 drafter [signature]


Harding Lawson Associates
 Engineers and Geoscientists

Log of Boring MW-2
 Shell Service Station
 6039 College Avenue
 Oakland, California

PLATE

Top of PVC Casing
Elevation 192.52

12" EMCO WHEATON A-721 MANHOLE
WITH WATERPROOF COVER

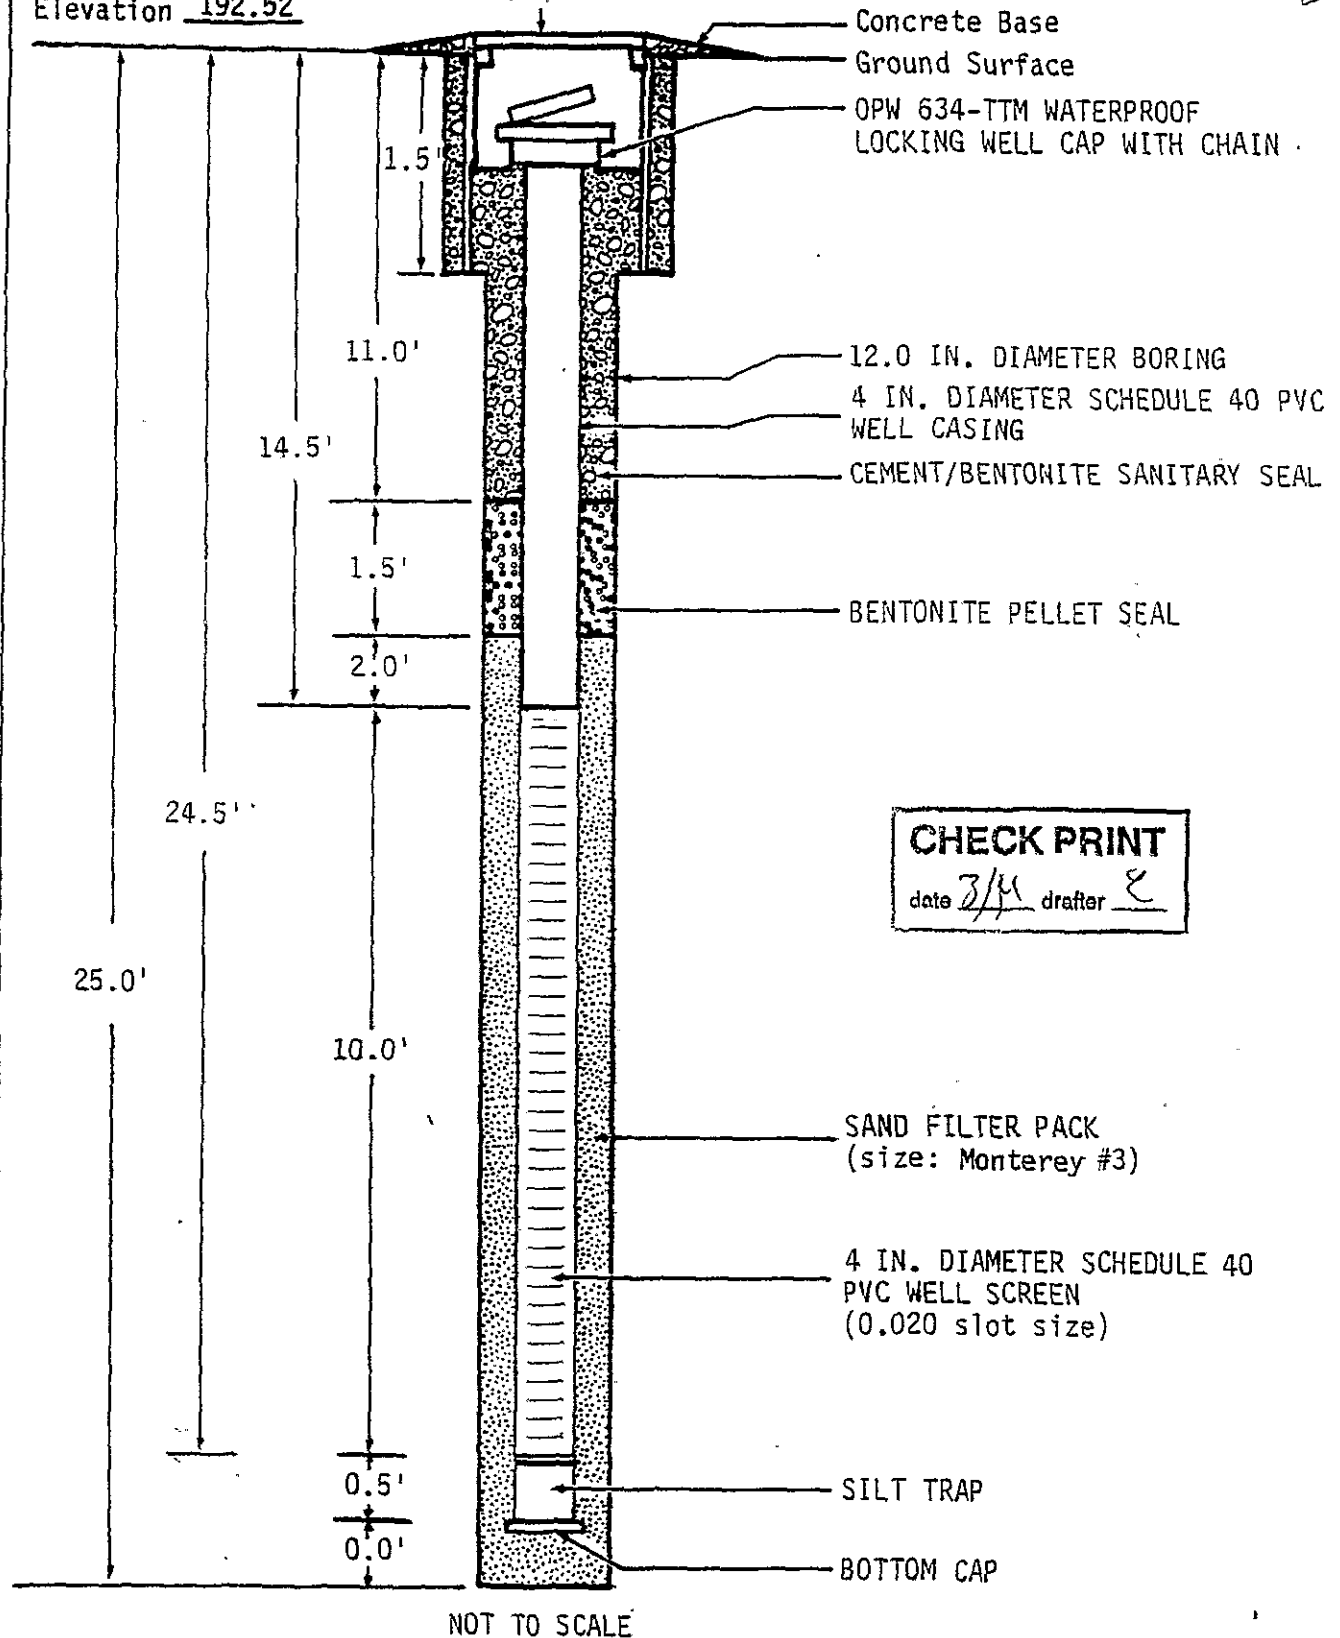

CHECK PRINT
 date 3/91 drafter E


NOT TO SCALE

HLA **Harding Lawson Associates**
 Engineers and Geoscientists

Well Completion Diagram MW-3
 Shell Service Station
 6039 College Avenue
 Oakland, California

PLATE

DRAWN YC	JOB NUMBER 4022,233.03	APPROVED	DATE 2/90	REVISED	DATE
-------------	---------------------------	----------	--------------	---------	------

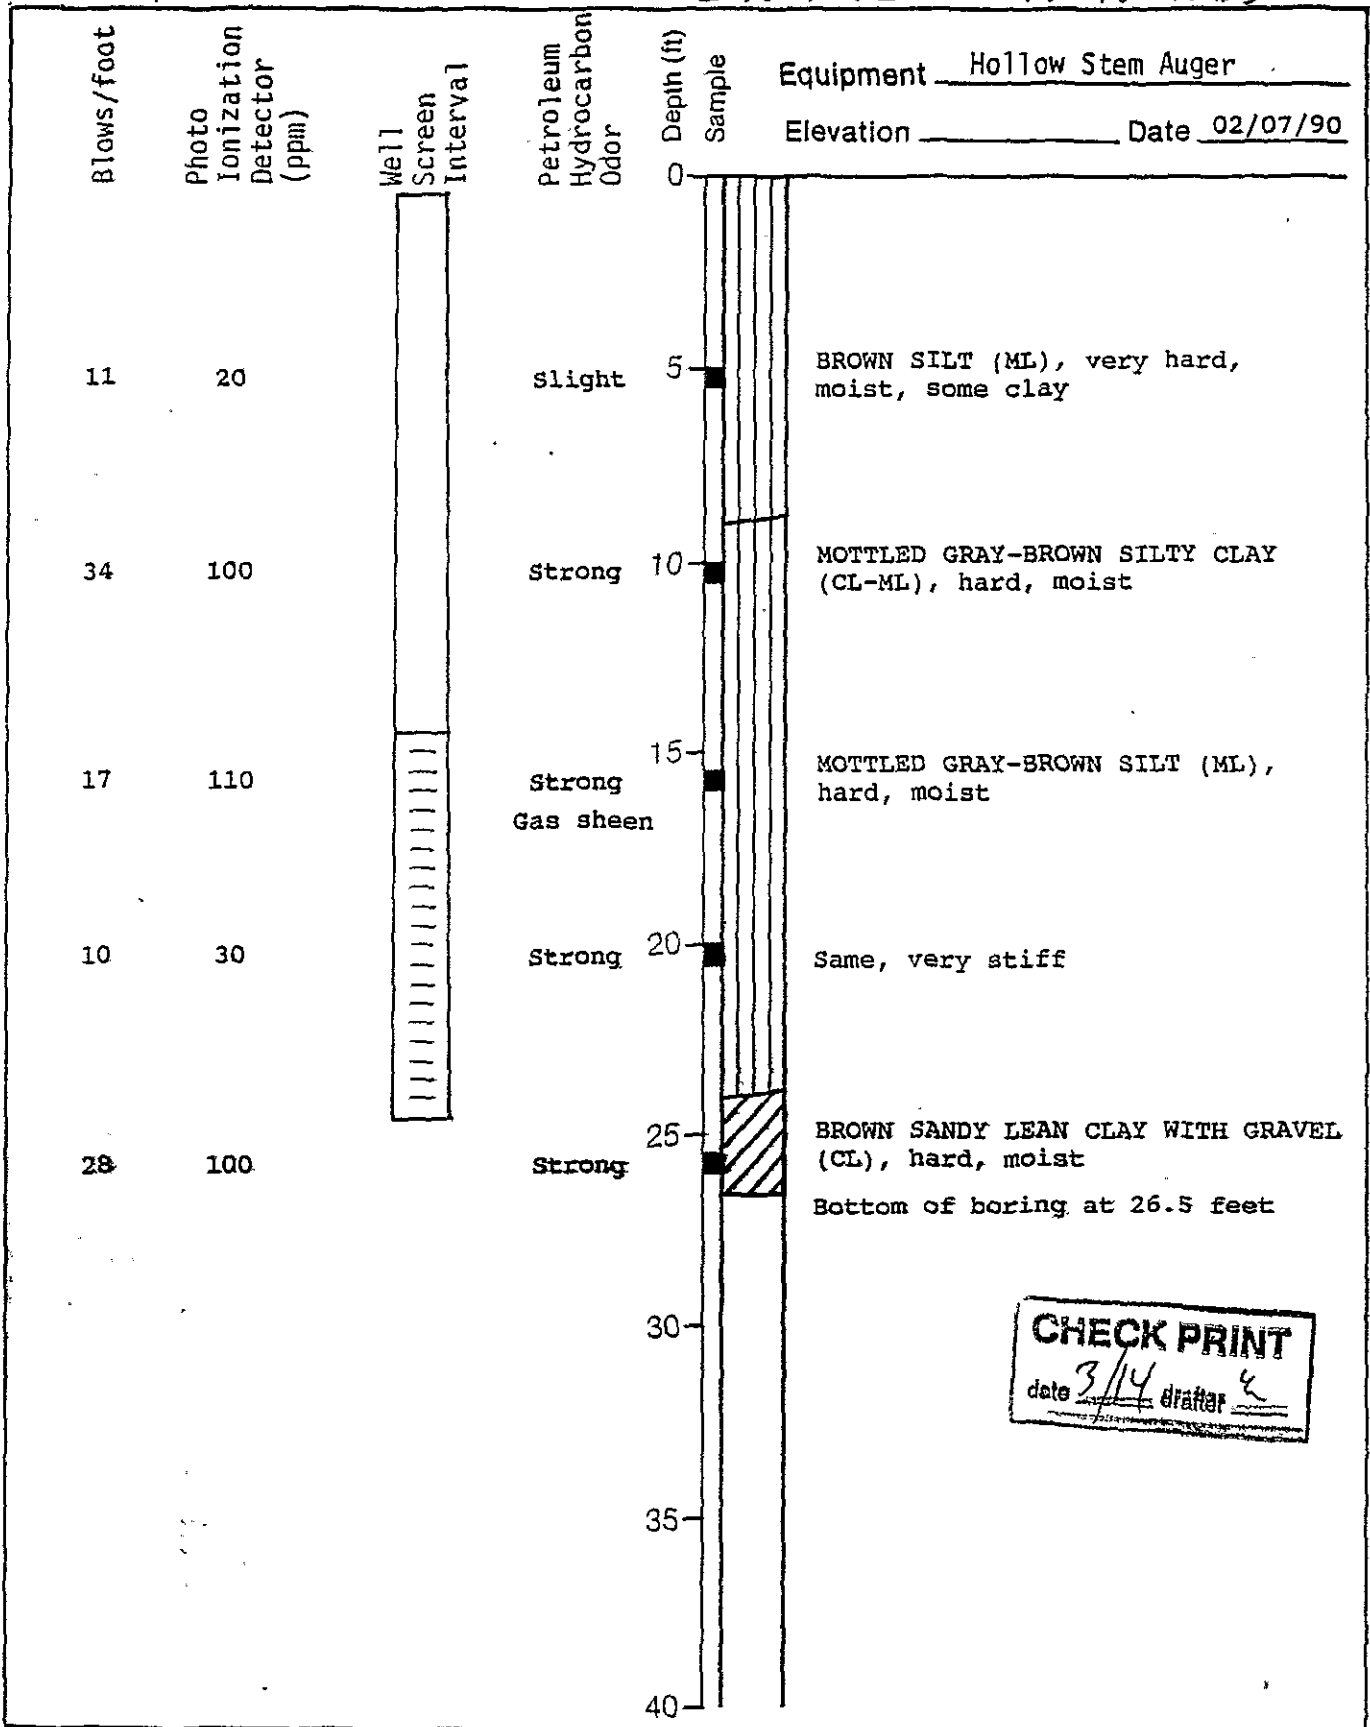

CHECK PRINT
 date 3/14 drafter [Signature]

Harding Lawson Associates
 Engineers and Geoscientists


Log of Boring MW-3
 Shell Service Station
 6039 College Avenue
 Oakland, California

PLATE

15/4W 13B4

Top of PVC Casing
Elevation 193.37

12" EMCO WHEATON A-721 MANHOLE
WITH WATERPROOF COVER

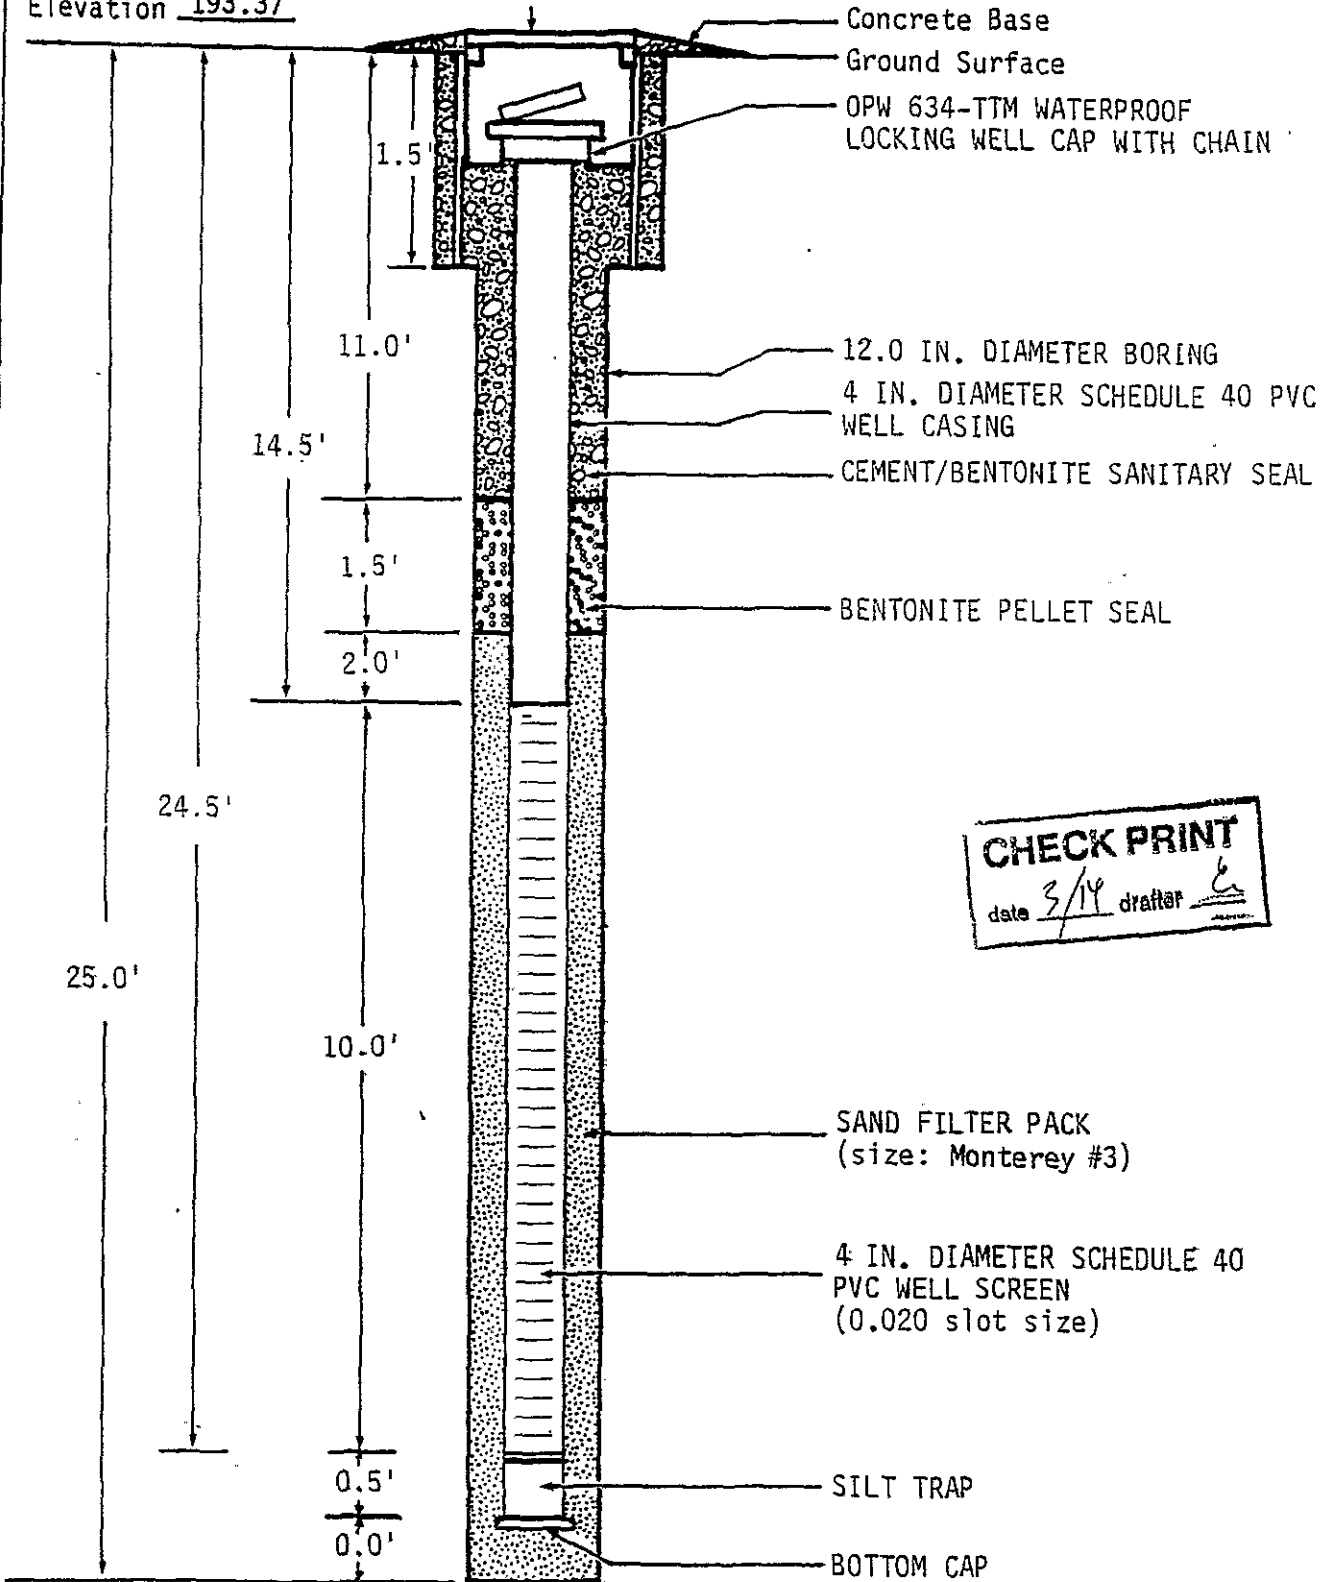

CHECK PRINT
 date 3/14 drafter *[Signature]*

NOT TO SCALE

PLATE



Harding Lawson Associates
Engineers and Geoscientists

Well Completion Diagram MW-4.
Shell Service Station
6039 College Avenue
Oakland, California

DRAWN
YC


JOB NUMBER
4022,233.03

APPROVED

DATE
2/90

REVISED

DATE

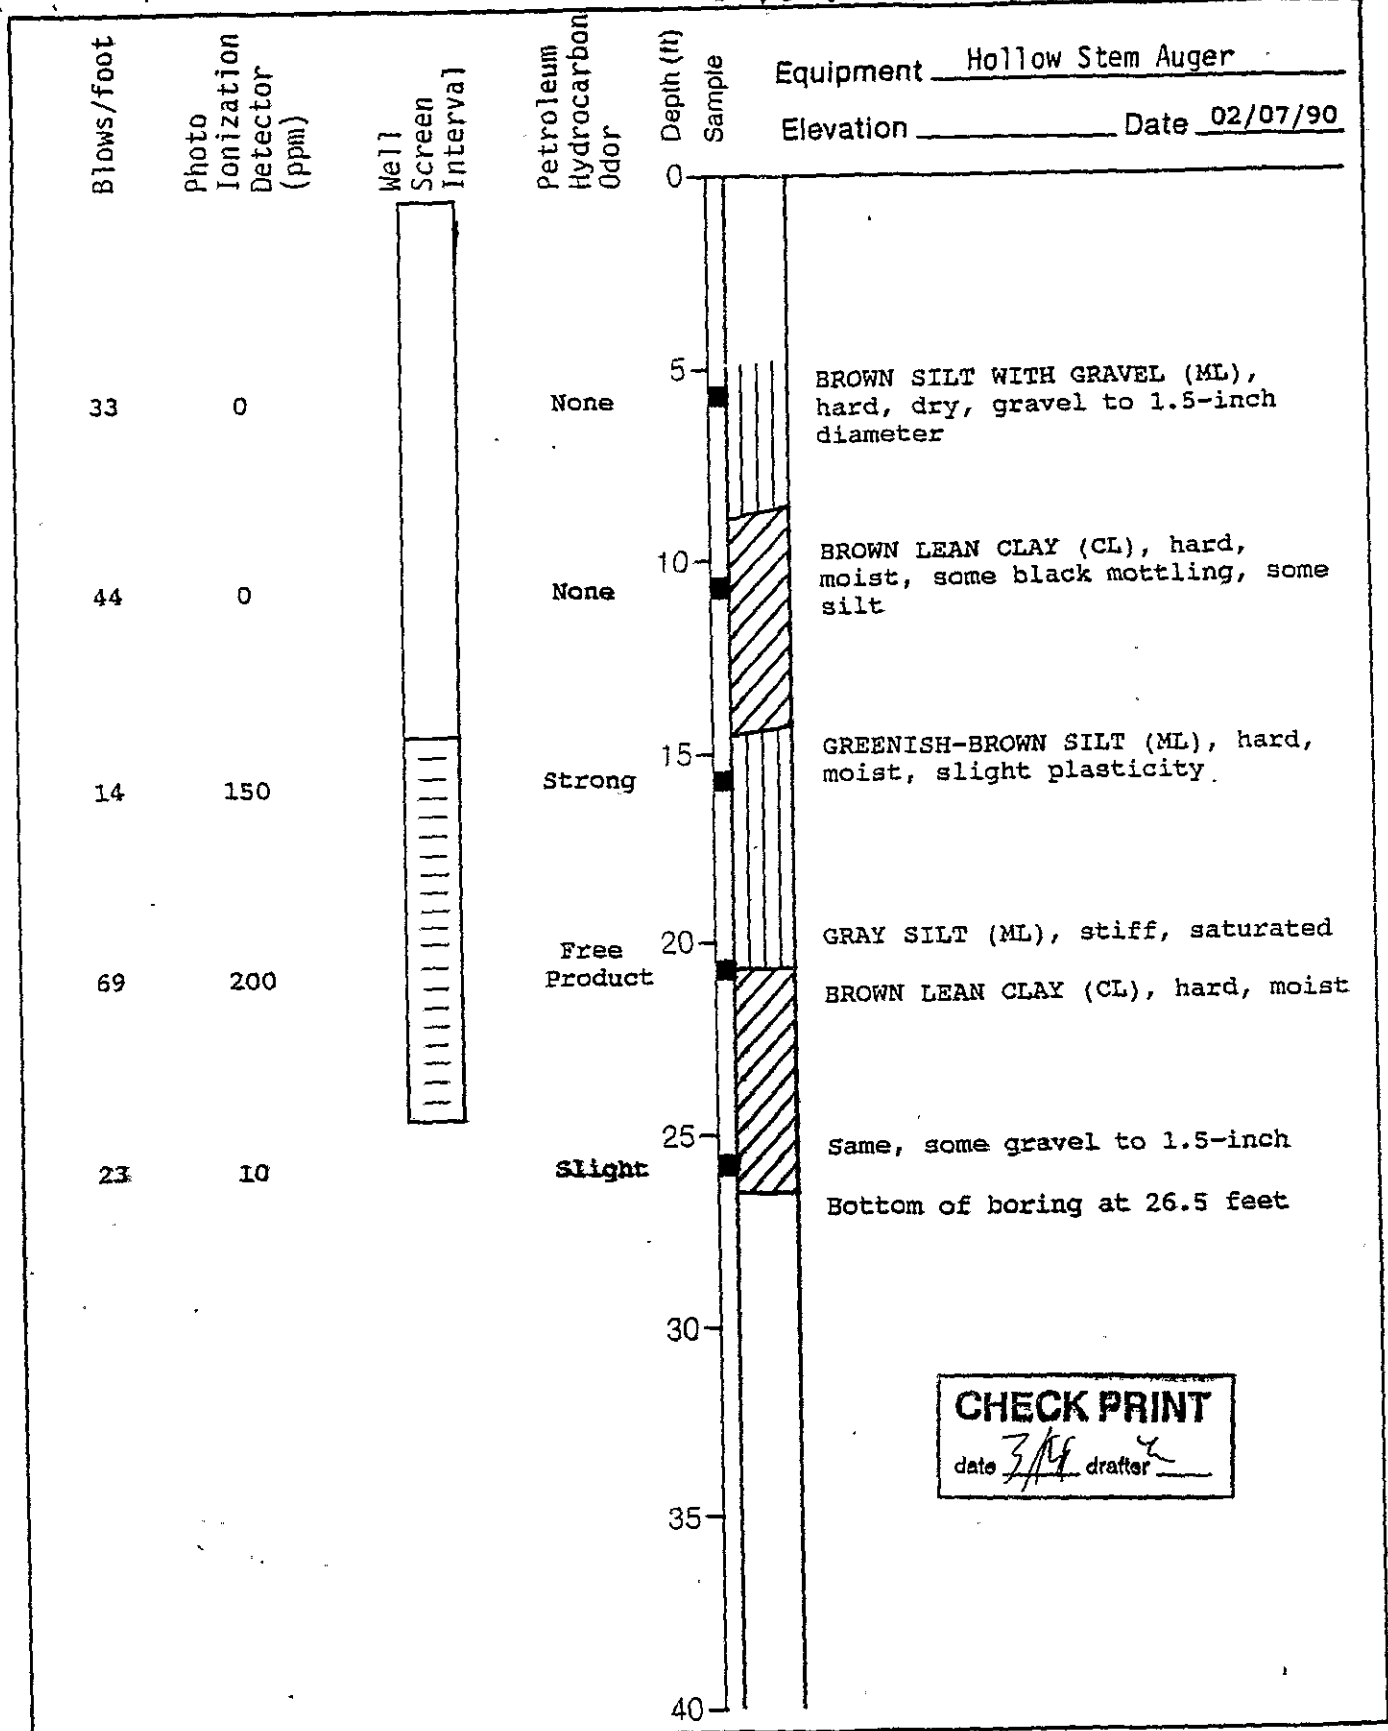

CHECK PRINT
 date 3/19 drafter [Signature]

Harding Lawson Associates
 Engineers and Geoscientists


Log of Boring MW-4
 Shell Service Station
 6039 College Avenue
 Oakland, California

PLATE

342401E-I 15/4W 13B

LEGEND

☒ Proposed Boring Location

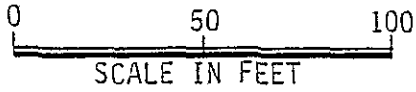

Union
76

62nd STREET

FLORIO STREET

Residential and
Commercial
Properties

Commercial
Properties

CLAREMONT AVENUE

COLLEGE AVENUE

CHECK PRINT
 date 1/27 drafter u

B-1 (AW-1)

B-2

B-5

B-4

B-3

Storage
Tanks

Pump Island
Canopies

Cashier

Storage

Fence

Fence



Harding Lawson Associates
 Engineering and
 Environmental Services

Soil Boring Locations
 Shell Service Station
 6039 College Avenue
 Oakland, California

PLATE

3

DRAWN KH JOB NUMBER 4022,233,03

APPROVED

DATE 11/89

REVISED DATE

34201E

15/KW13B

Laboratory Tests	Blows/foot	Photo Ionization Detector (ppm)	Petroleum Hydrocarbon Odor	Depth (ft)	Equipment
					Hollow Stem Auger
				Sample	Elevation _____ Date 01/05/90
				0	
	21	0	None	5	No recovery, brown loose sandy material and asphalt in bottom of split barrel
	35	3.4	Slight	10	BROWN-GRAY MOTTLED SANDY LEAN CLAY (CL), medium dense, moist, fine to coarse sand
	16	6.3	Slight	15	GRAY SANDY SILT (ML), medium dense, moist, very fine sand
	9	720	Strong	18	GREEN-GRAY MOTTLED SANDY SILT (ML), dense, wet, very fine sand
Perm MA	28	134	Strong	20	BROWN-GRAY MOTTLED SILT WITH SAND (ML), dense, dry, very fine sand
	48	4.0	Slight	22	BROWN-GRAY SAND AND GRAVEL WITH SILT (GM), dense, moist, fine to medium gravel ~25%
		140	Strong	23	
Perm MA	20	0.5	None	24	BROWN SILTY SAND WITH GRAVEL (SP), medium dense, saturated at 22.5 to 23 feet, gravel absent at 23.5 feet
				25	
				30	
				35	
				40	


Bottom of boring at 24 feet

CHECK PRINT
 date 7/14 drafter [signature]

Harding Lawson Associates
 Engineers and Geoscientists

Log of Boring B-2
 Shell Service Station
 6039 College Avenue
 Oakland, California

PLATE

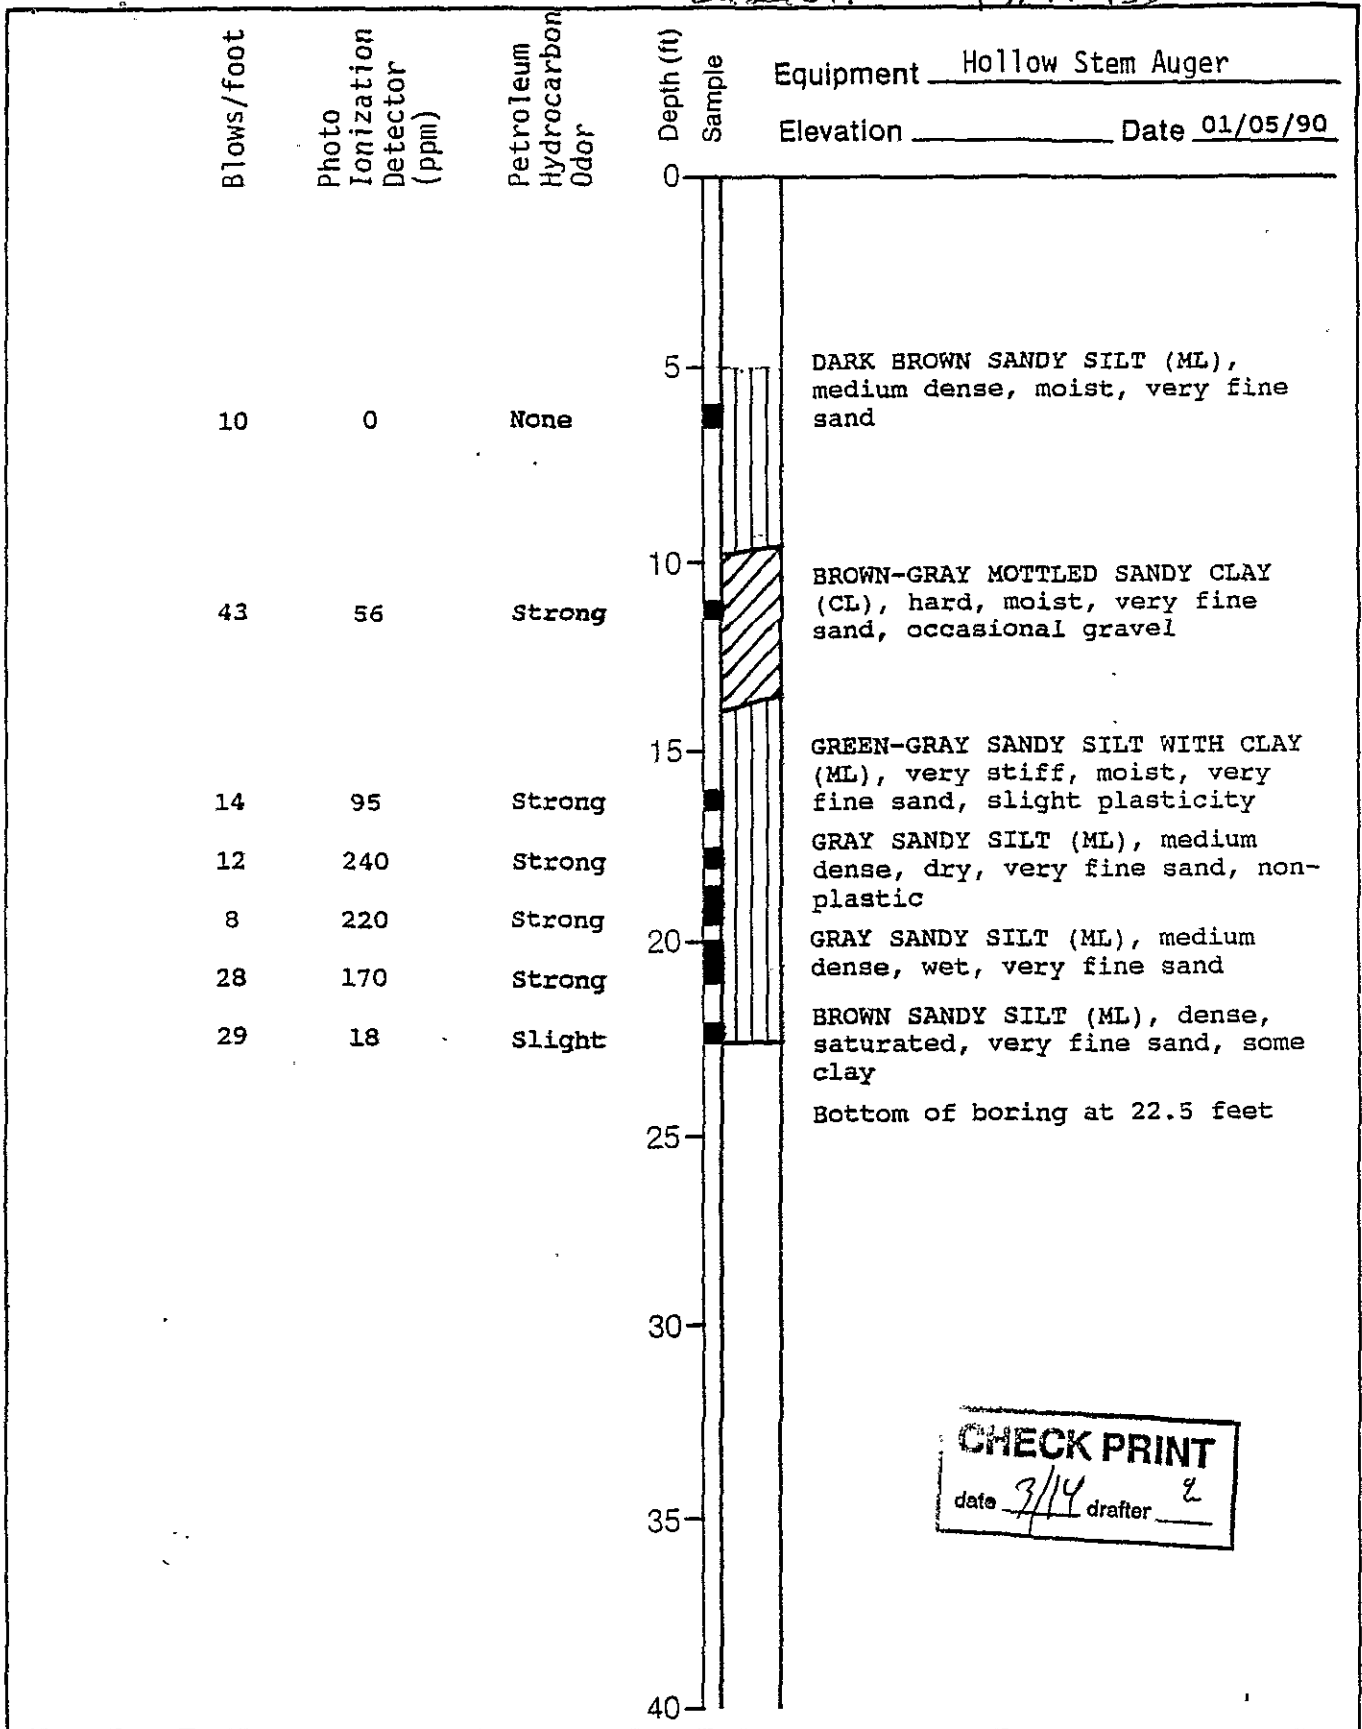

CHECK PRINT
 date 3/14 drafter Z



Harding Lawson Associates
 Engineers and Geoscientists

Log of Boring B-3
 Shell Service Station
 6039 College Avenue
 Oakland, California

PLATE

DRAWN
 YC


JOB NUMBER
 4022,233.03

APPROVED

DATE
 2/90

REVISED

DATE

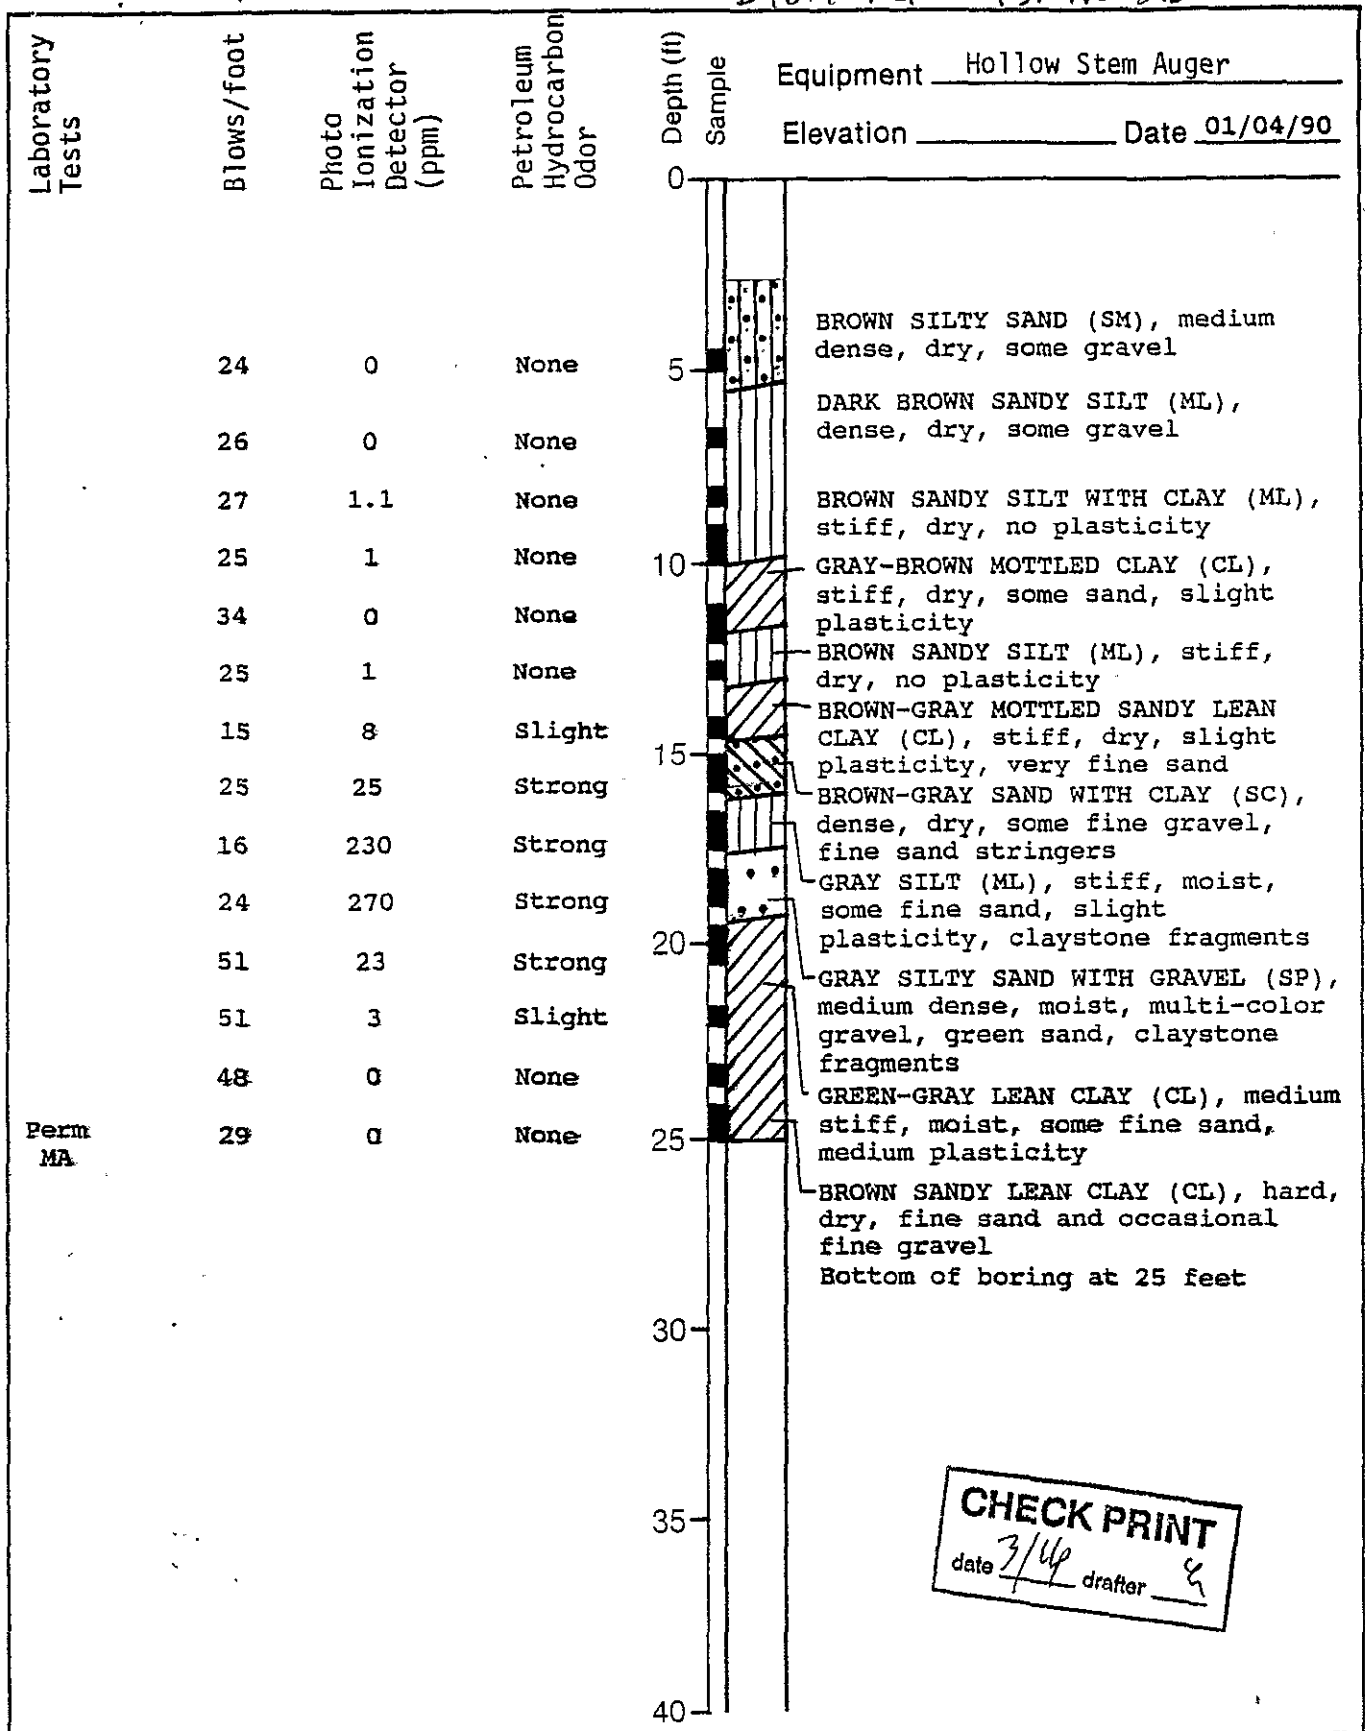


CHECK PRINT
 date 3/4/90 drafter [signature]

Harding Lawson Associates
 Engineers and Geoscientists

Log of Boring B-4
 Shell Service Station
 6039 College Avenue
 Oakland, California

PLATE

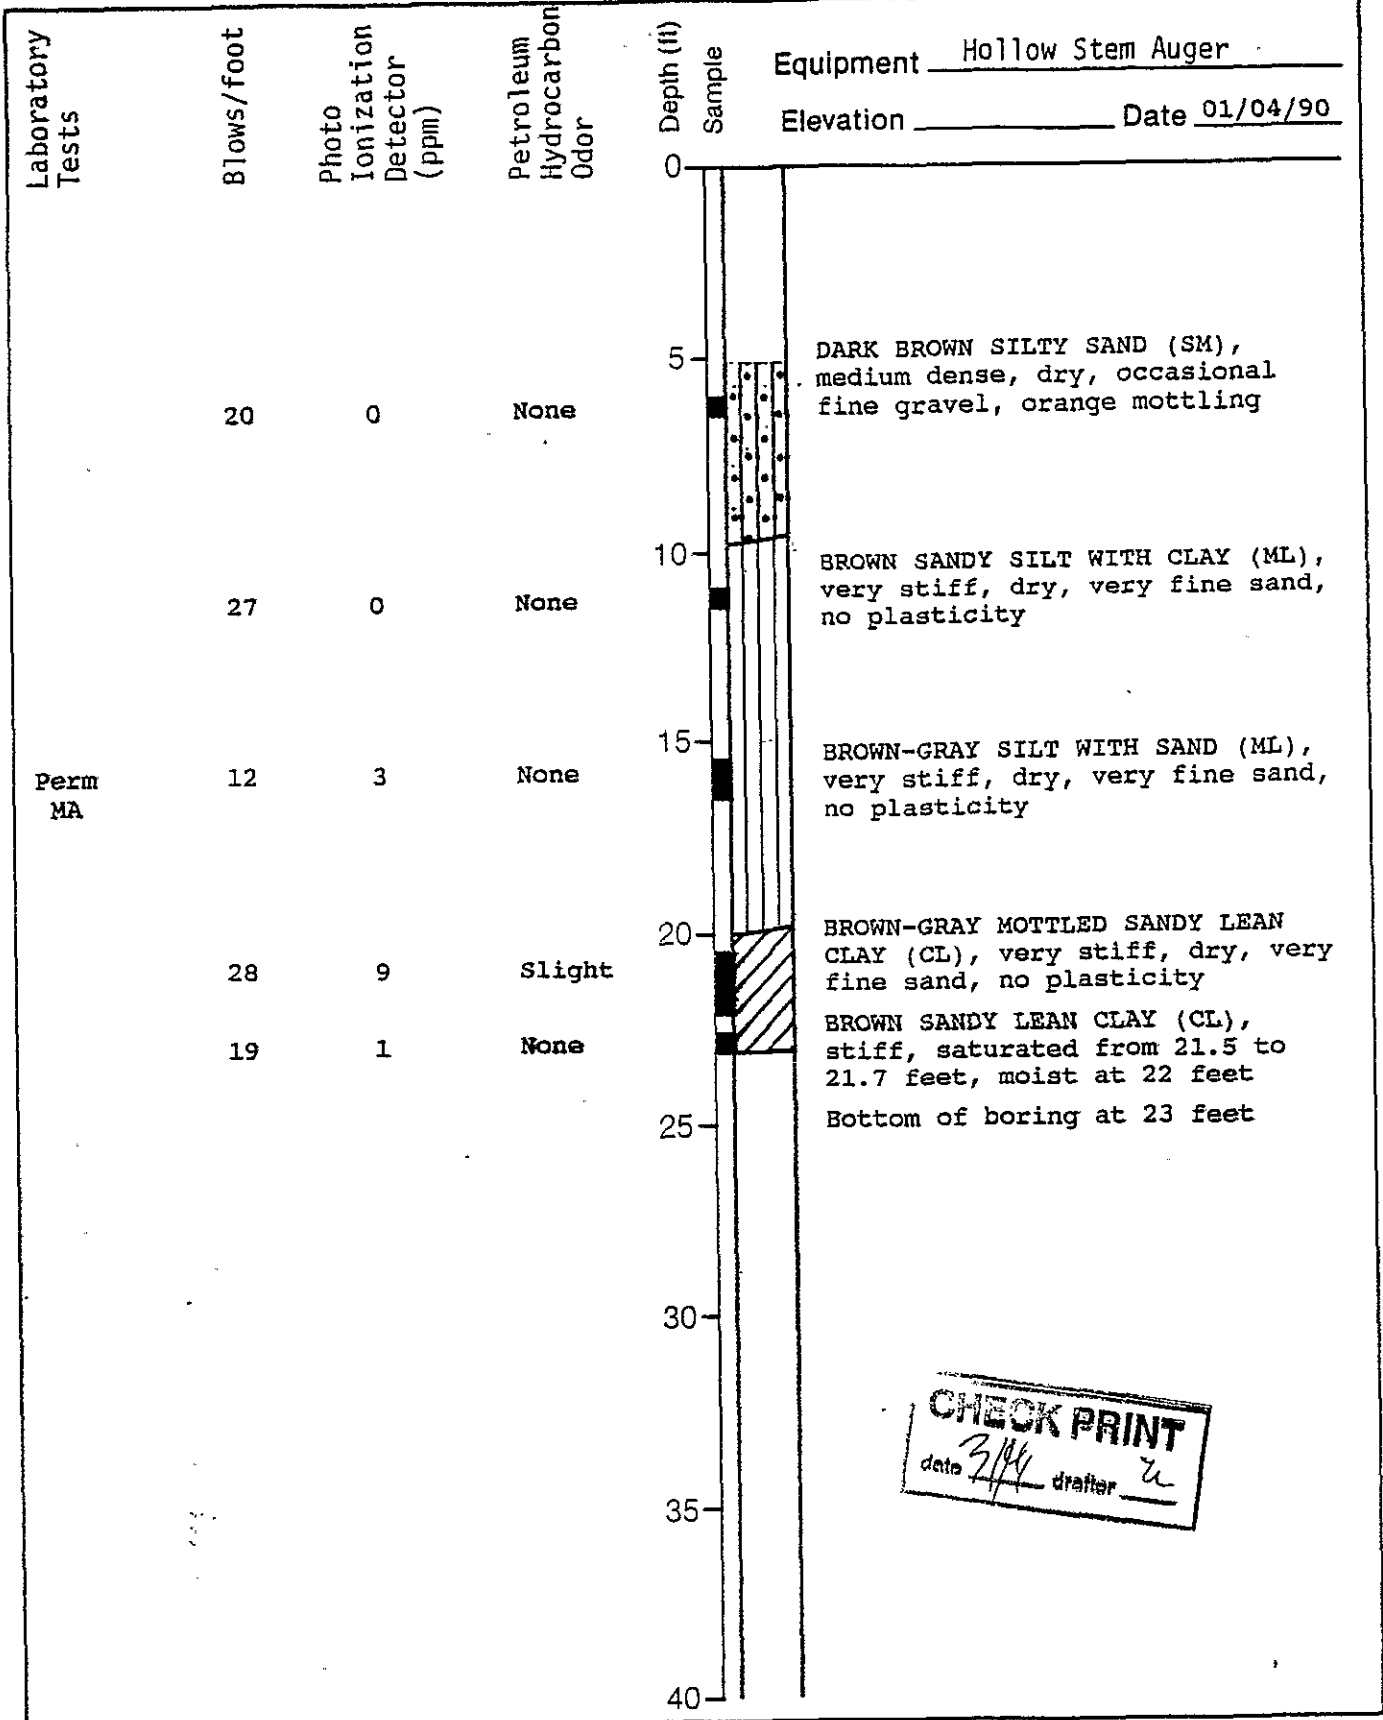

CHECK PRINT
 date 3/94 drafter z



Harding Lawson Associates
 Engineers and Geoscientists

Log of Boring B-5
 Shell Service Station
 6039 College Avenue
 Oakland, California

PLATE

Laboratory Tests	Blows/foot	Photo Ionization Detector (ppm)	Petroleum Hydrocarbon Odor	Depth (ft)	Sample	Equipment
						Hollow Stem Auger
						Elevation _____ Date 01/05/90
	13	0	None	0 - 5		DARK BROWN SANDY SILT (SM-ML), medium dense, moist, sand >50% 5 to 5.5 feet, root material, fine to medium sand
	35	0	None	5 - 10		BROWN-GRAY MOTTLED SANDY CLAY (CL), very stiff, dry, occasional gravel, fine to medium sand
	16	130	Strong	10 - 15		GREEN-GRAY SANDY SILT WITH CLAY (ML), stiff, moist, very fine sand, slight plasticity
Perm MA	12	119	Strong	15 - 19		GRAY SILT (ML), medium dense, moist, some very fine sand <12%
	9	140	Strong	19 - 20		GREEN-GRAY SILT WITH CLAY (ML), stiff, saturated, slight plasticity
Perm MA	12		No recovery	20 - 22.5		BROWN LEAN CLAY WITH SAND (CL), hard, dry, with gray mottling, very fine sand
	33	6	Slight	22.5 - 25		Bottom of boring at 22.5 feet

CHECK PRINT
 date 3/14 drafter z

Harding Lawson Associates
 Engineers and Geoscientists

Log of Boring B-6
 Shell Service Station
 6039 College Avenue
 Oakland, California

PLATE

CONFIDENTIAL

STATE OF CALIFORNIA DWR
WELL COMPLETION REPORT
(WELL LOGS)

REMOVED

01-5053
15/42-130 3

AQUA TERRA TECHNOLOGIES INC.

Log of Exploratory Boring

Project: Dryers Ice Cream Job No.: 9126

Location: 5929 College Avenue, Oakland, CA Date: 07/16/91

Boring No.: MW1 Driller: Gregg Drilling Page 1 of 2

Logged by: Bruce Berman Proj. Mgr. Terry Carter Reviewed by: _____

Penetration 0.5 Feet	Depth (feet)	U.S.C.S. Soil Class.	Field Description		
	0				
	1	Fill	0'-1' Redwood chip-bark and soil backfill (planter)		
	2	CL	1'-8' Silty clay; black (10YR 2/1); stiff; slightly damp. Gradational color change to very dark grayish brown (10YR 3/2), minor component of very fine sand beginning at 5'.		
	3				
	4				
	5				
	6				
	7				
	8			CL	8'-18' Sandy clay; dark yellowish brown (10YR 4/4); 10% to 20% very fine sand; stiff to very stiff; slightly damp. Gradational increase in fine sand content and moisture content; minor iron staining and micro pores beginning at ≈ 15'.
	9				
7,9,14	10		10' Sample		
	11				
	12				
	13				
	14				
5,17,12	15			15' Sample	
	16				
	17				

AQUA TERRA TECHNOLOGIES INC.

Field Drilling and Sampling Log

Job No: 9126


Page 2 of 2

Penetration (0.5 Ft)	Depth (feet)	U.S.C.S. Soil Class.	MW1 Field Description	
	—	CL		
	18	GC- CL	18'-30' Sandy-gravelly clay to clayey sand; 20% very fine sand, 10% medium to coarse sand, 20% fine to medium gravel (semi-round sandstone to 1/2-inch diameter); thin lenses of clean gravel (< 6-inches) diminish with depth.	18' First water
	19			
6,16,22	20			
	21			
	22			
	23			
	24			
	25			
	26			
	27			
	28			
	29			
	30		B.O.H. @ 30'.	
	31			
	32			
	33			
	34			
	35			
	36			
	37			
	38			
	39			

01-5058
13/4W-13C3

MW1

Well Designation:

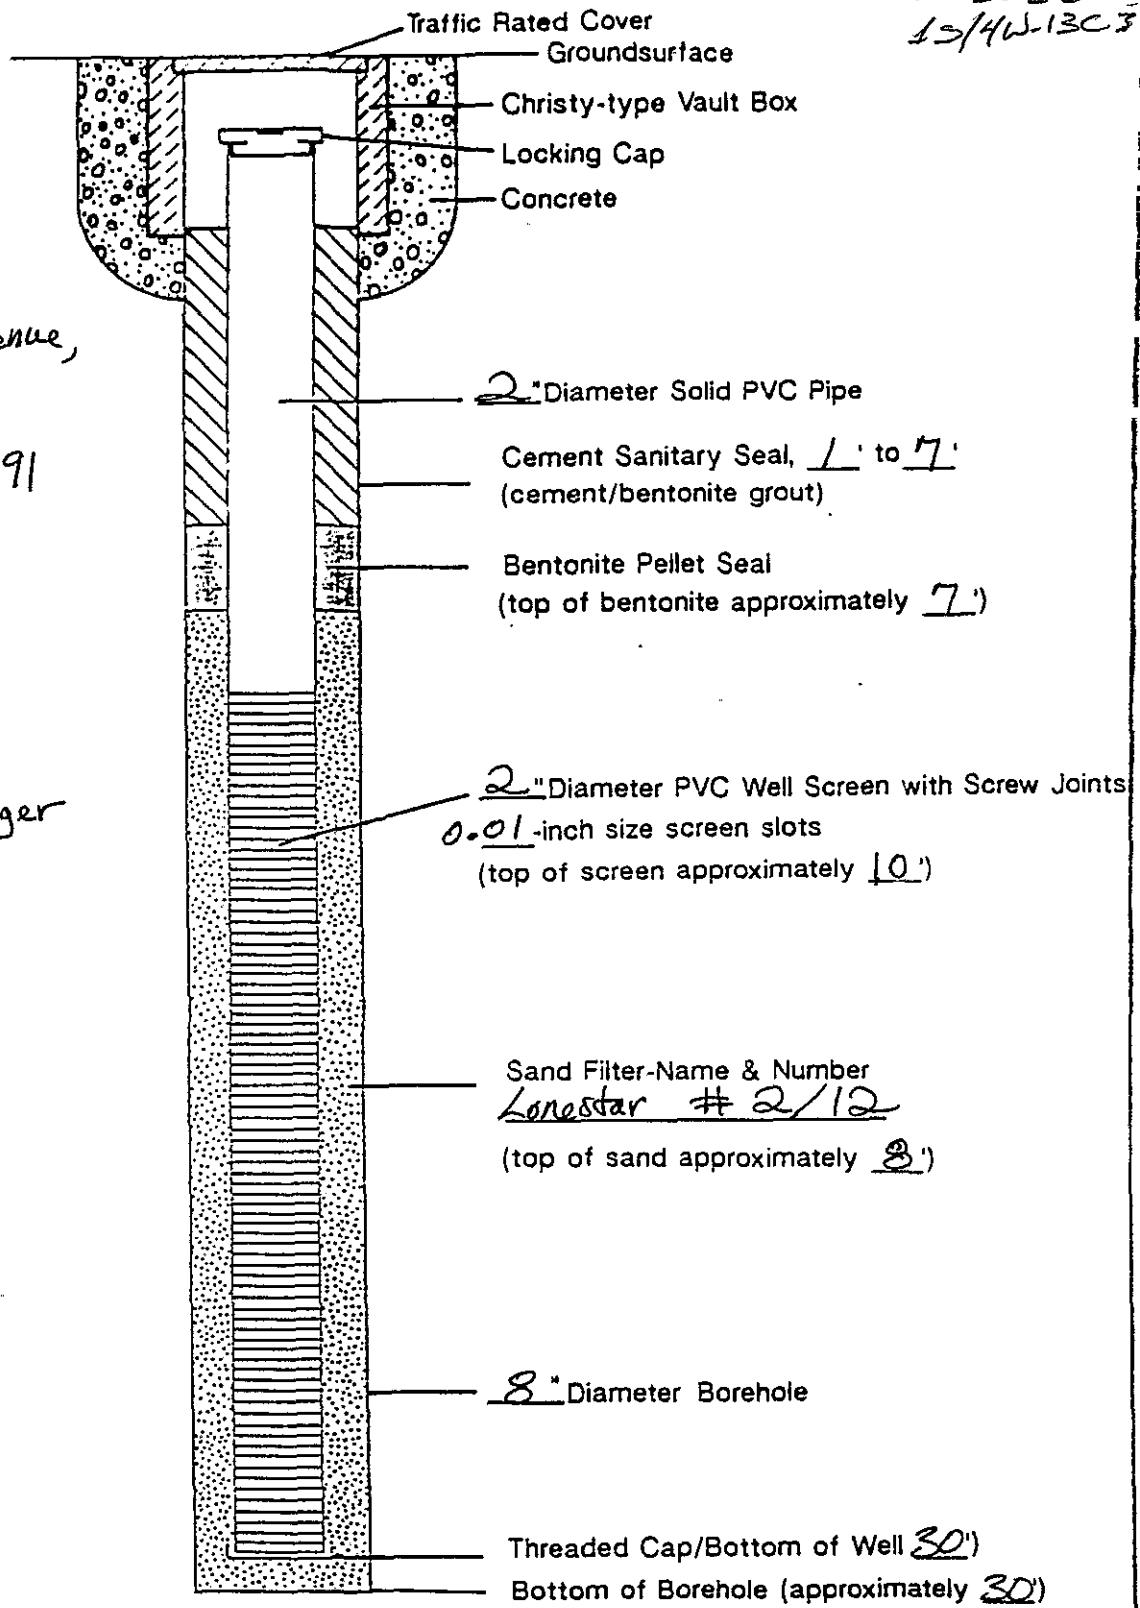

Site Location:
5929 College Avenue,
Oakland, CA.

Date Installed: 7-16-91

Drilling Company:
Gregg Drilling

Driller: Chris

Drilling Method:
Hollow-stem auger

Logged By: BB

Notes:

Not to Scale

**Groundwater Monitoring Well
Construction Details**

ATT

Aqua Terra Technologies
Consulting Engineers
& Scientists

Dryers Ice Cream


JOB NUMBER

DATE

9126

~~PLATE~~

MW1

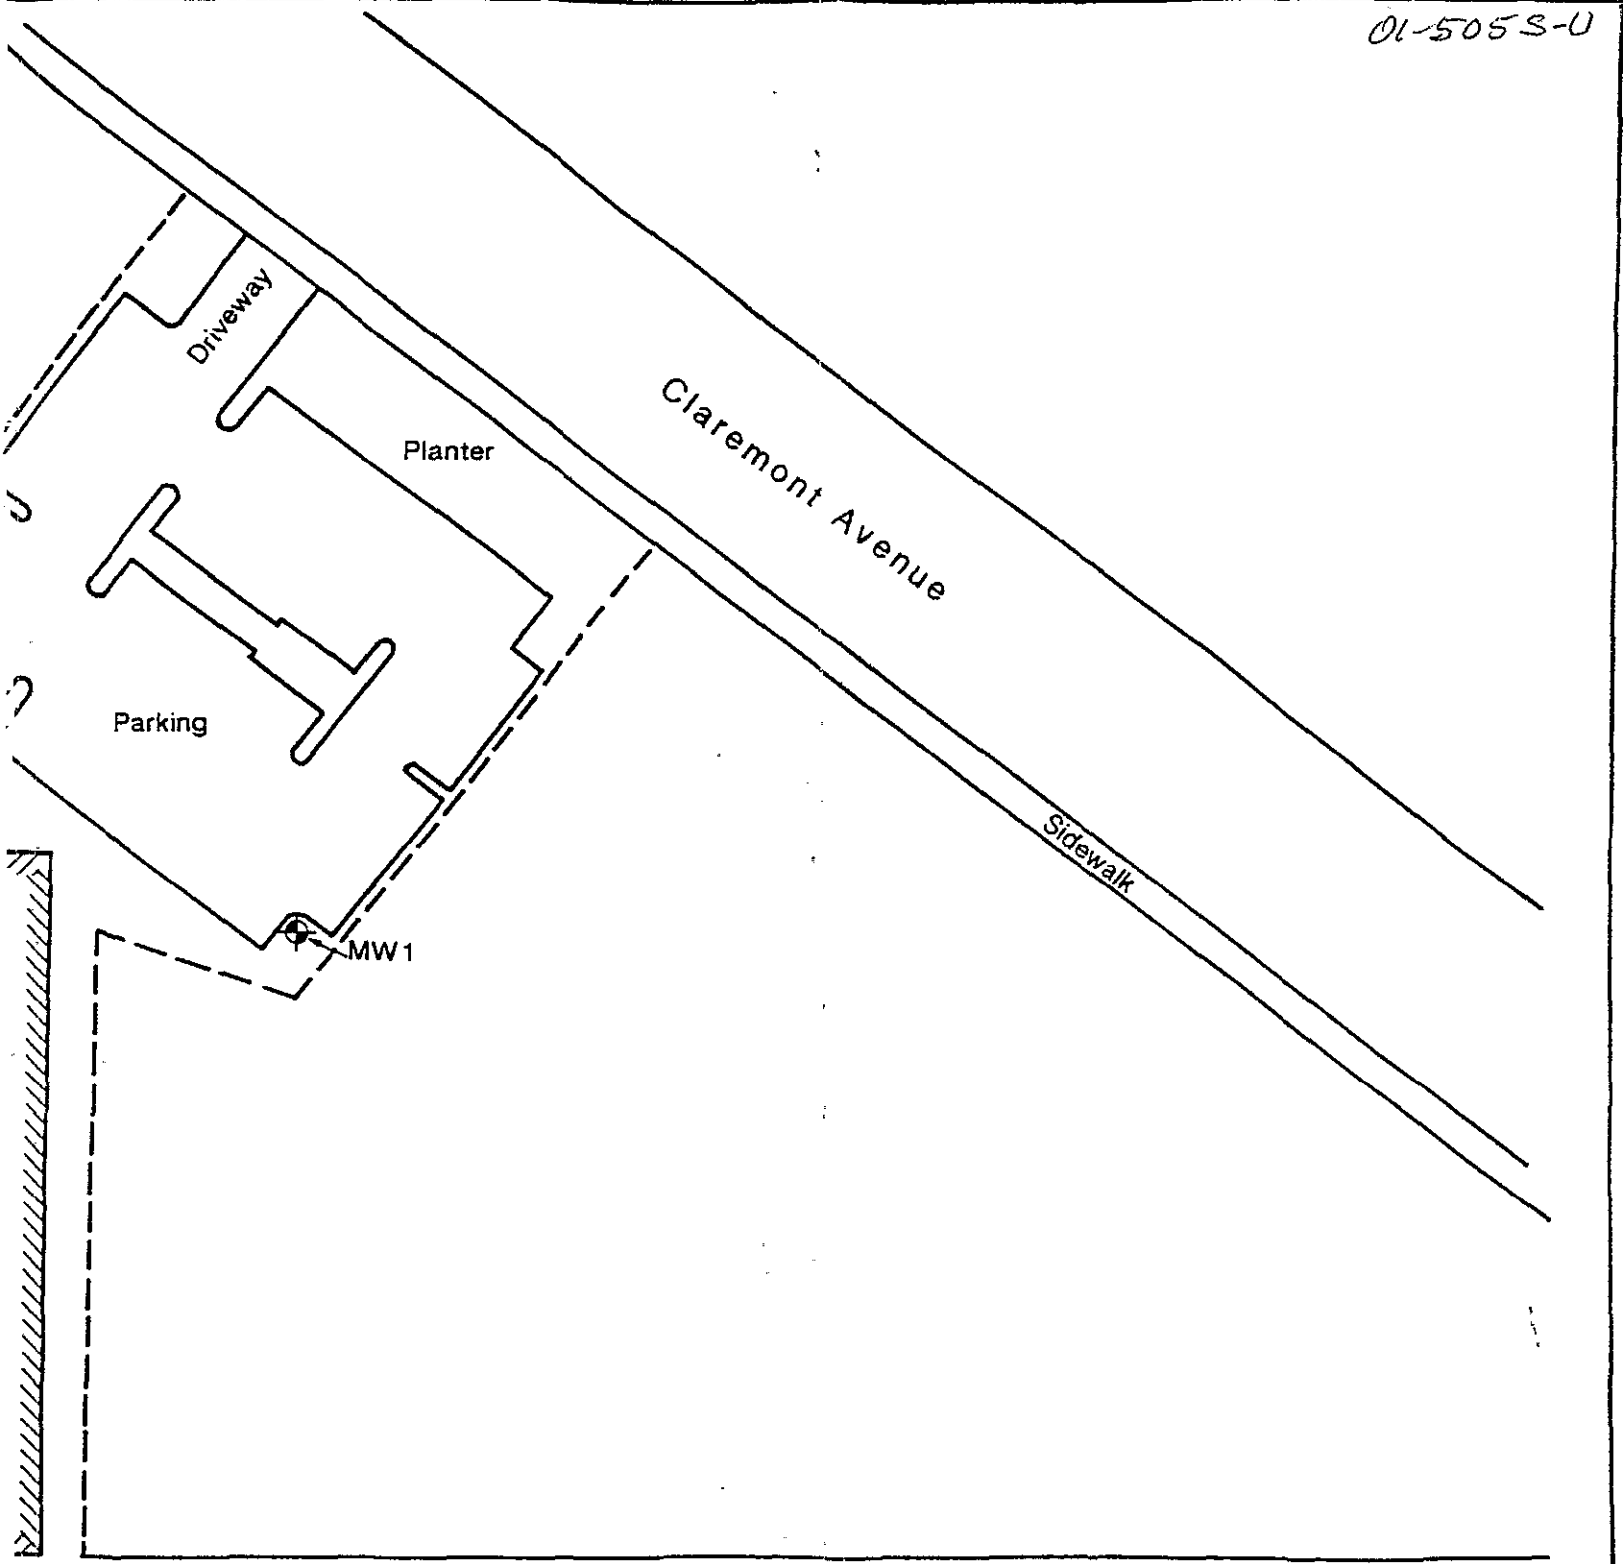

Sidewalk

ge Avenue

Site Map

ATT Aqua Terra Technologies
 Consulting Engineers
 & Scientists


Dreyer's Grand Ice Cream, Inc.		PLATE 2
JOB NUMBER 9126	DATE 9/91	

LEGEND

--- Property Boundary

/// Building

⊕ Groundwater Monitoring Well

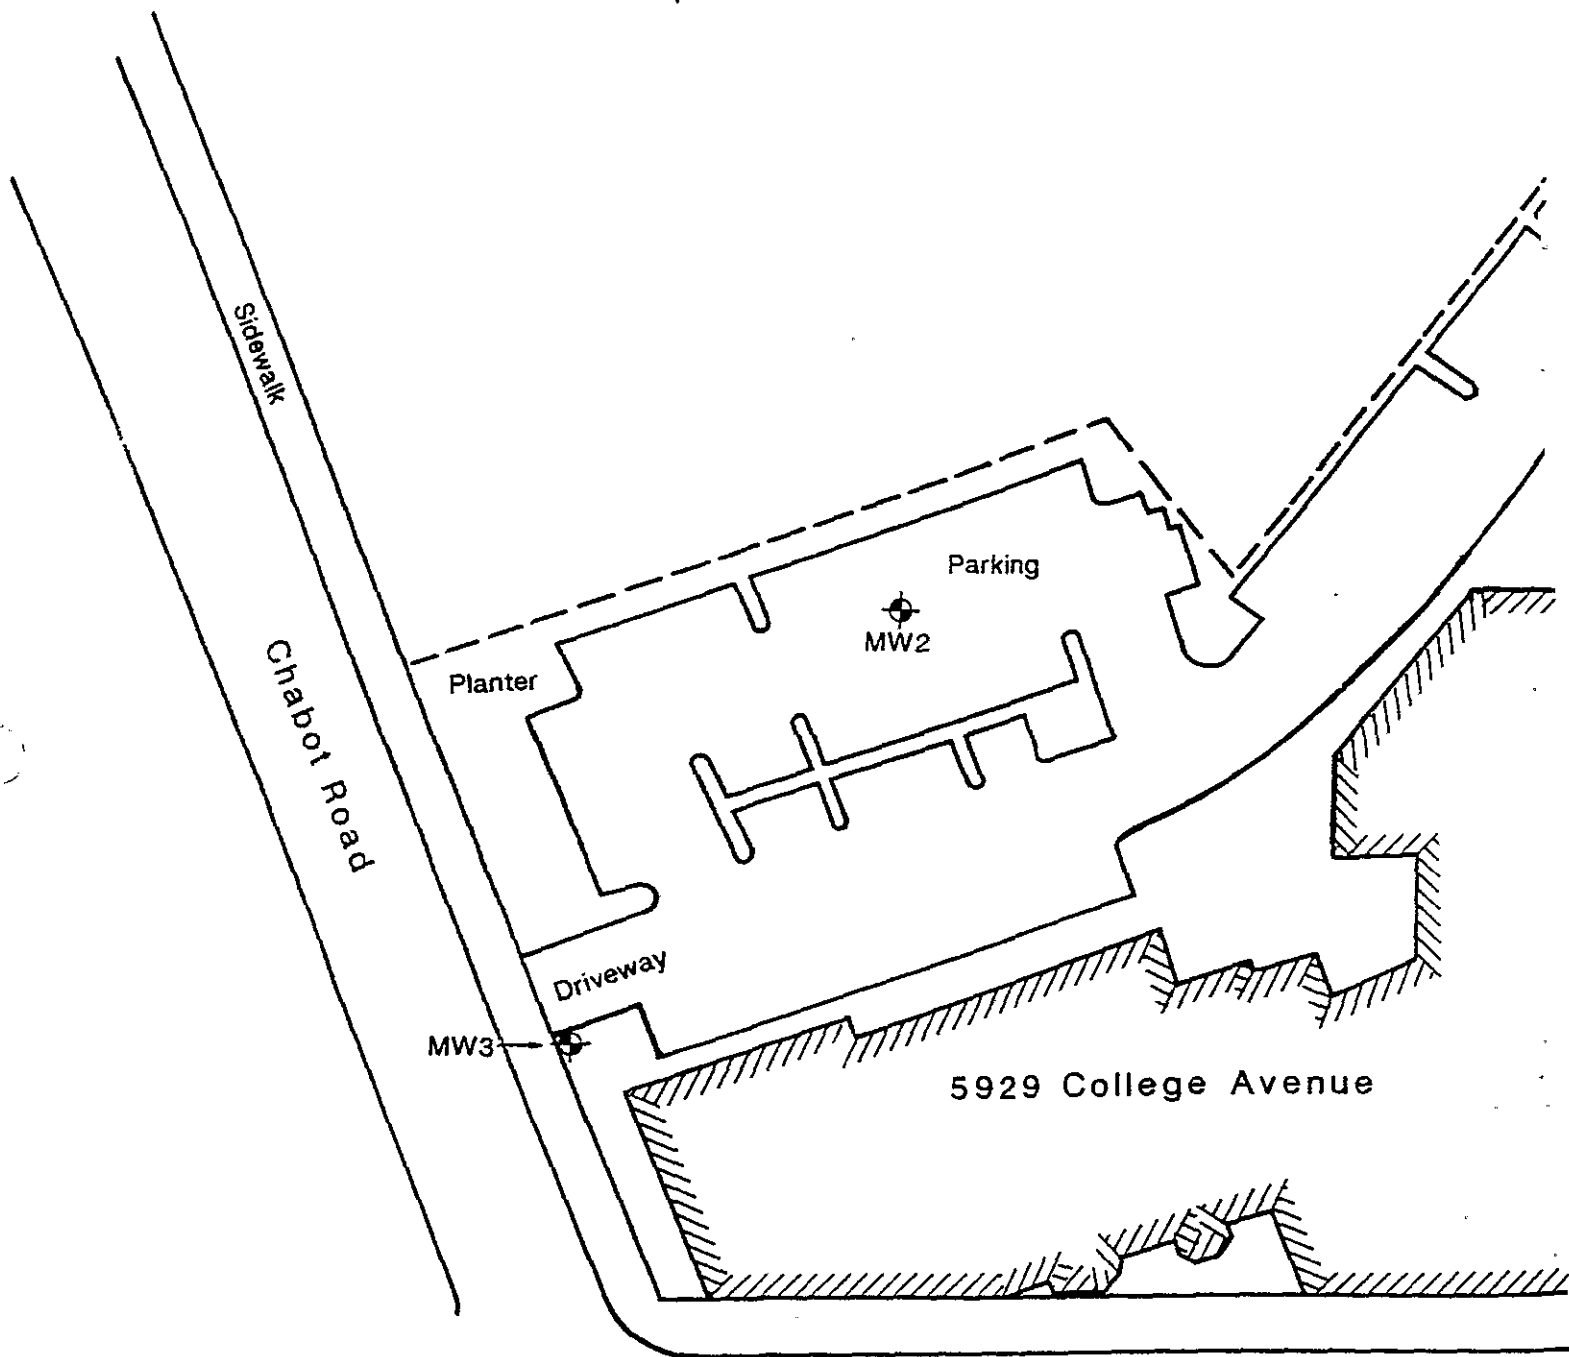

0 50 feet

SCALE

Lic# C57-485165
phone 510-934-4884

Colle

01-505T
LS/4W-1364

AQUA TERRA TECHNOLOGIES INC.

Log of Exploratory Boring

Project: Dryers Ice Cream Job No.: 9126

Location: 5929 College Avenue, Oakland, CA Date: 07/17/91

Boring No.: MW2 Driller: Gregg Drilling Page 1 of 2

Logged by: Bruce Berman Proj. Mgr. Terry Carter Reviewed by: _____

Penetration 0.5 Feet	Depth (feet)	U.S.C.S. Soil Class.	Field Description		
	0				
	1	Asphalt, baserock	0'-1.5' Asphalt and gravel base-rock		
	2	CL	1.5-10' Silty clay; very dark grayish brown (10YR 3/2); stiff; medium plasticity; slightly damp to damp. Gradational color change to dark brown (10YR 4/3).		
	3				
	4				
	5				
	6				
	7				
	8				
	9				
6, 10, 12	10		CL	10'-28' Sandy clay; dark brown (10YR 4/3); 10% to 20% very fine to fine sand; stiff; damp to moist; minor rust staining; minor blue-green aged hydrocarbon discoloring. Gradational increase in fine sand content and moisture content.	10' Sample, hydrocarbon odor
	11				
	12				
	13				
	14				
4, 9, 12	15				15' First water, 15' sample slipped
	16				
	17				

Field Drilling and Sampling Log

Job No: 9126

Page 2 of 2

Penetration 0.5 Feet	Depth (feet)	U.S.C.S. Soil Class.	MW2 Field Description			
	18	CL		out of sampler, saturated, not recovered. Hydrocarbon odor in water dripping from sampler. Hydrocarbon odor in drill cuttings below 15'.		
	19					
	20					
	21					
	22					
	23					
	24					
	25					
	26					
	27					
	28				B.O.H. @ 28'.	
	29					
	30					
	31					
	32					
	33					
	34					
	35					
	36					
	37					
	38					
	39					

M.W2
Well Designation:

13/42-13C4
01-505T

Site Location:
5929 College Avenue,
Oakland, CA.

Date Installed: 7-17-91

Drilling Company:
Gregg Drilling


Driller: Chris

Drilling Method:
Hollow-stem auger

Logged By: BB

Notes:

Pilot hole drilled
with 6-inch auger
to 15 feet, overdrilled
with 10-inch auger

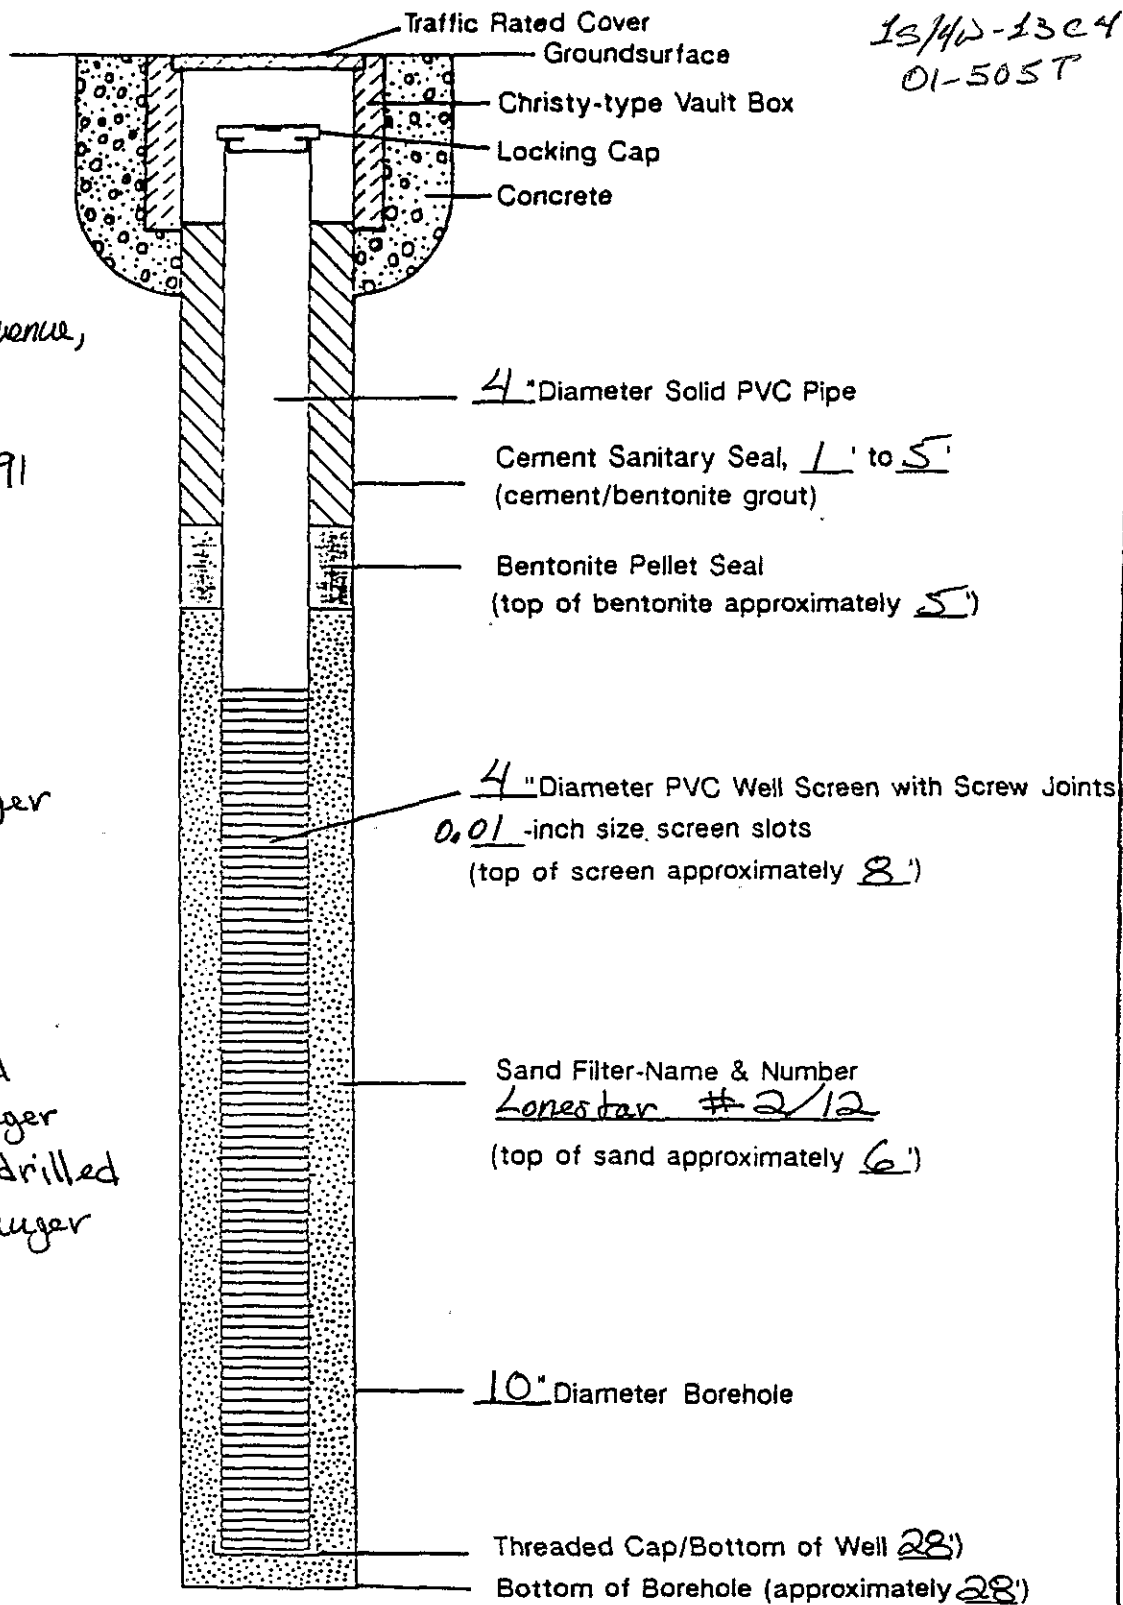

Not to Scale

Groundwater Monitoring Well
Construction Details

ATT

Aqua Terra Technologies
Consulting Engineers
& Scientists

Dryers Ice Cream

PLATE

JOB NUMBER

DATE

9126

MW2

01-505U
15/4W 13C5

AQUA TERRA TECHNOLOGIES INC.

Log of Exploratory Boring

Project: Dryers Ice Cream Job No.: 9126

Location: 5929 College Avenue, Oakland, CA Date: 07/18/91

Boring No.: MW3 Driller: Gregg Drilling Page 1 of 2

Logged by: Bruce Berman Proj. Mgr. Terry Carter Reviewed by: _____

Penetration 0.5 Feet	Depth (feet)	U.S.C.S. Soil Class.	Field Description	
	0	Fill	0'-1.5- Soil fill materials (planter area) 1.5'-27' Sandy clay; black (10YR 2/1); 10% to 20% very fine sand; moist.	
	1			
	2	CL- Fill?	5'; lens of fine sand; dark yellow- ish brown (10YR 4/4); 3-inches thick; damp. Soil just above and below sand lens has minor blue-green aged hydro- carbon discoloring. Gradational increase in moisture and fine sand content with increased depth. Major blue-green aged hydrocarbon discoloring below 10'.	3' Hydro- carbon odor in drill cuttings
	3			
	4			
2, 2, 4	5			
	6			
	7			
	8			
	9			
4, 4, 5	10			
	11			
	12			
	13			
	14			
3, 5, 10	15			
	16			
			15'; wood chips in good condition, not decomposed (brought up in sampler).	14' First water, strong hydrocarbon odor in water drip-

Field Drilling and Sampling Log

Job No: 9126

Page 2 of 2

Penetration 0.5 Feet	Depth (feet)	U.S.C.S. Soil Class.	MW3 Field Description		
-	-				
-	17		17'; Drillers observation; augers encountered stiffer material similar to drilling conditions in native material in the other two boreholes. (possibly in tank excavation backfilled with excavated soil to 17', native material below 17'?).	ping from end of drill rod, sheen	
-	18				
-	19				15' Incomplete sample recovery, saturated soil, sample not restrained
-	20				
-	21				
-	22	CL			
-	23				
-	24				Strong hydrocarbon odor, sheen on drill cuttings and auger below 15'
-	25				
-	26				
-	27		B.O.H. @ 27'		
-	28				
-	29				
-	30				
-	31				
-	32				
-	33				
-	34				
-	35				
-	36				
-	37				
-	38				

M.W.3

Well Designation:

IS/MW-1325
015050

Site Location:

5929 College Avenue,
Oakland, CA.

Date Installed: 7-18-91

Drilling Company:

Gregg Drilling

Driller: Chris


Drilling Method:

Hollow-stem auger

Logged By: BB

Notes:

Pilot hole drilled
with 6-inch auger
to 15-feet, over drilled
with 10-inch auger.

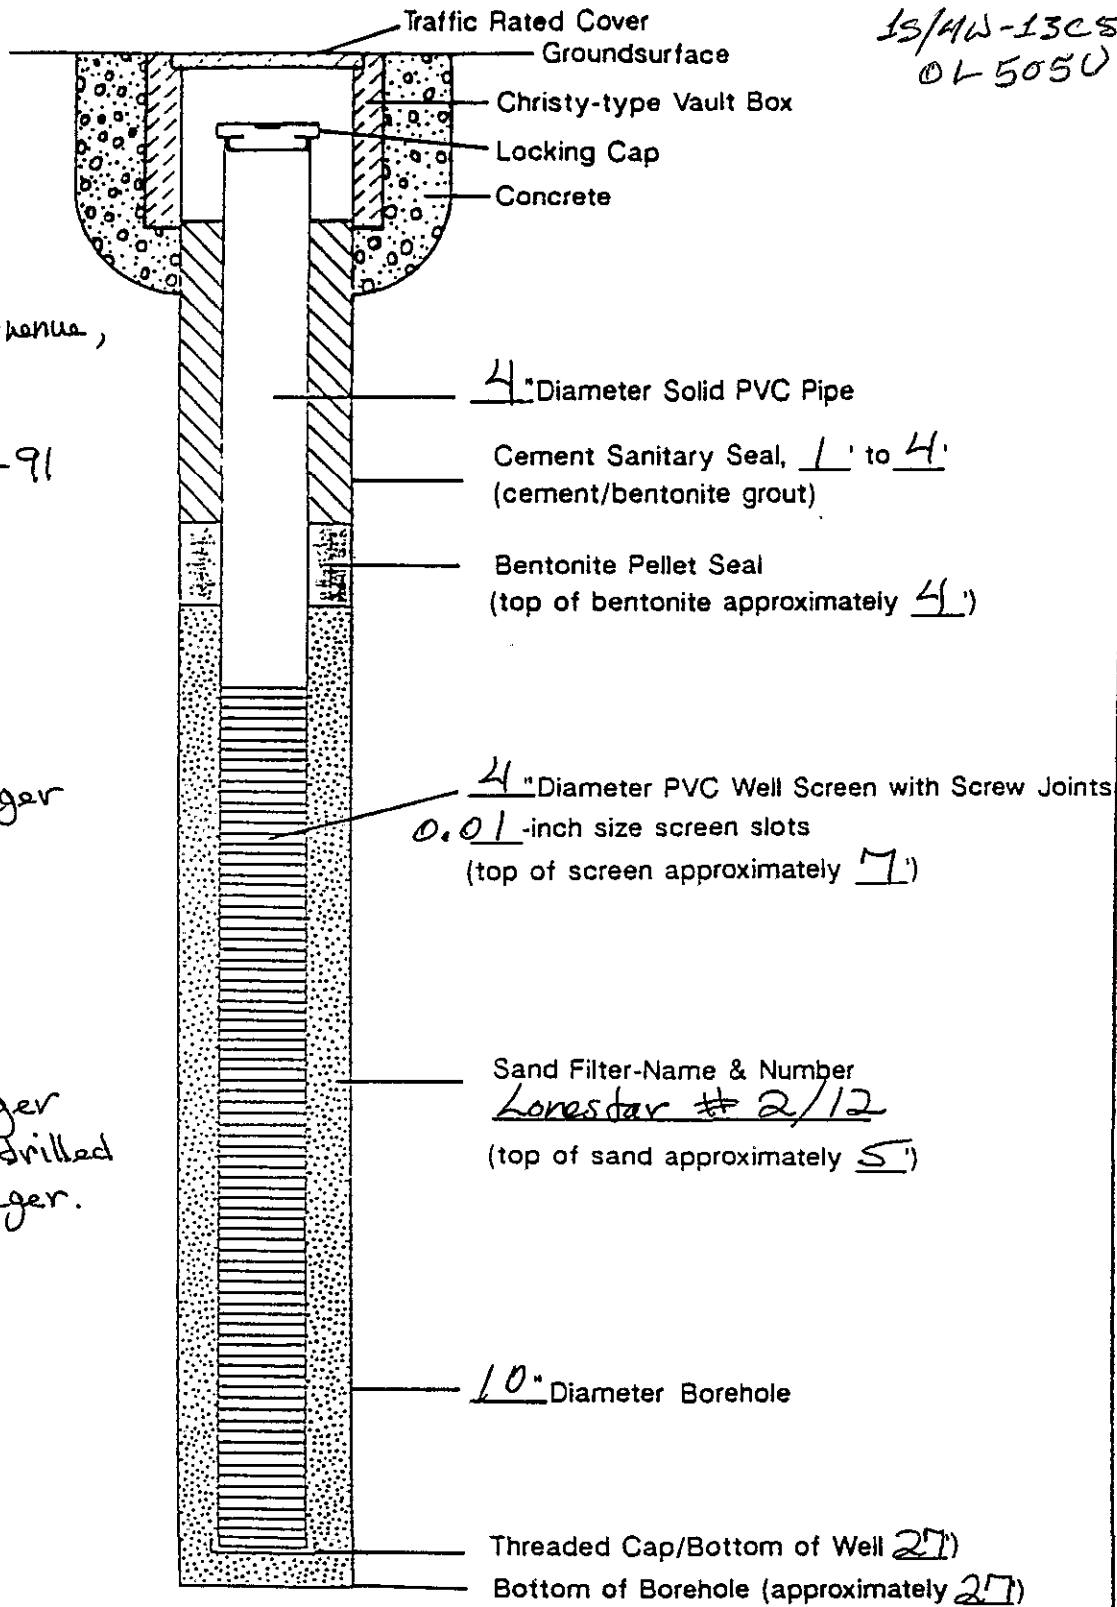

Not to Scale

**Groundwater Monitoring Well
Construction Details**

ATT

Aqua Terra Technologies
Consulting Engineers
& Scientists

Dryers Ice Cream

JOB NUMBER

DATE

9126

PLATE

MW3

CONFIDENTIAL

STATE OF CALIFORNIA DWR
WELL COMPLETION REPORT
(WELL LOGS)

REMOVED

CONFIDENTIAL

STATE OF CALIFORNIA DWR
WELL COMPLETION REPORT
(WELL LOGS)

REMOVED

CONFIDENTIAL

**STATE OF CALIFORNIA DWR
WELL COMPLETION REPORT
(WELL LOGS)**

REMOVED

CONFIDENTIAL

STATE OF CALIFORNIA DWR
WELL COMPLETION REPORT
(WELL LOGS)

REMOVED

CONFIDENTIAL

STATE OF CALIFORNIA DWR
WELL COMPLETION REPORT
(WELL LOGS)

REMOVED


CONFIDENTIAL

STATE OF CALIFORNIA DWR
WELL COMPLETION REPORT
(WELL LOGS)

REMOVED


INV ✓ AD ✓ ~~217~~ A, B, C 179203 Permit No. 86305 Plot/Copy

15/HW13D5-7

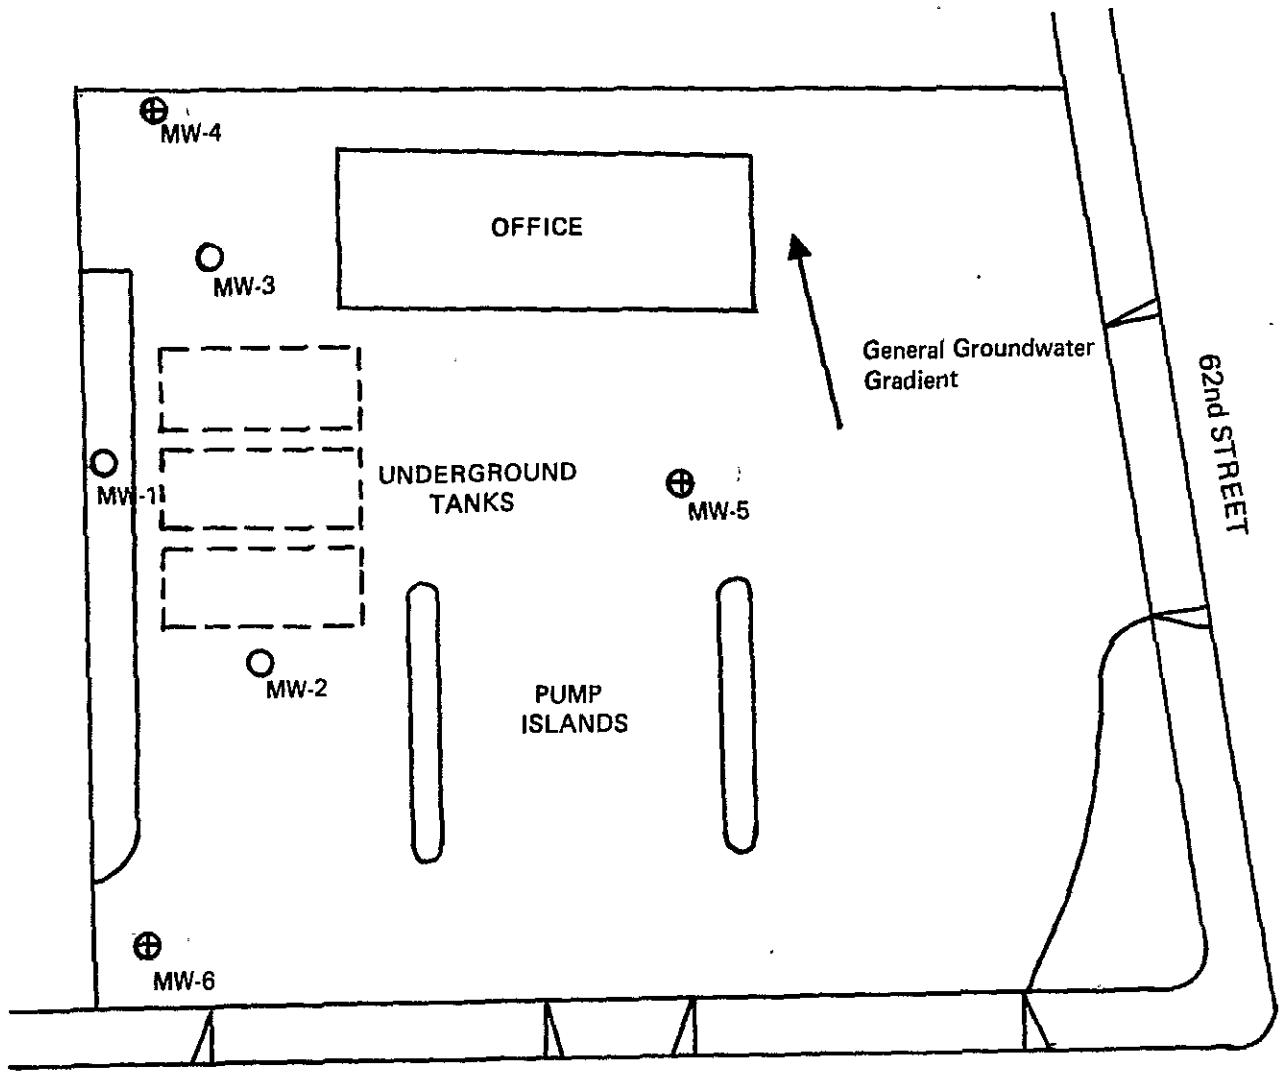

LEGEND

- MW-1 GT Monitoring Wells
- ⊕ MW-4 WCC Monitoring Wells

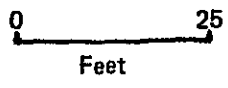

THRIFTY OIL
6125 TELEGRAPH AVE.
OAKLAND, CA.

Figure 1. MONITORING WELL LOCATIONS

DRILLER: K. VILHAUG WELL DRILLING, CONCORD

#P6305

INV ✓
AD ✓

179203A ~~of 217A~~
1S/4W13D5

Project No.: 90390A
Date: 11-13-86

Elevation.

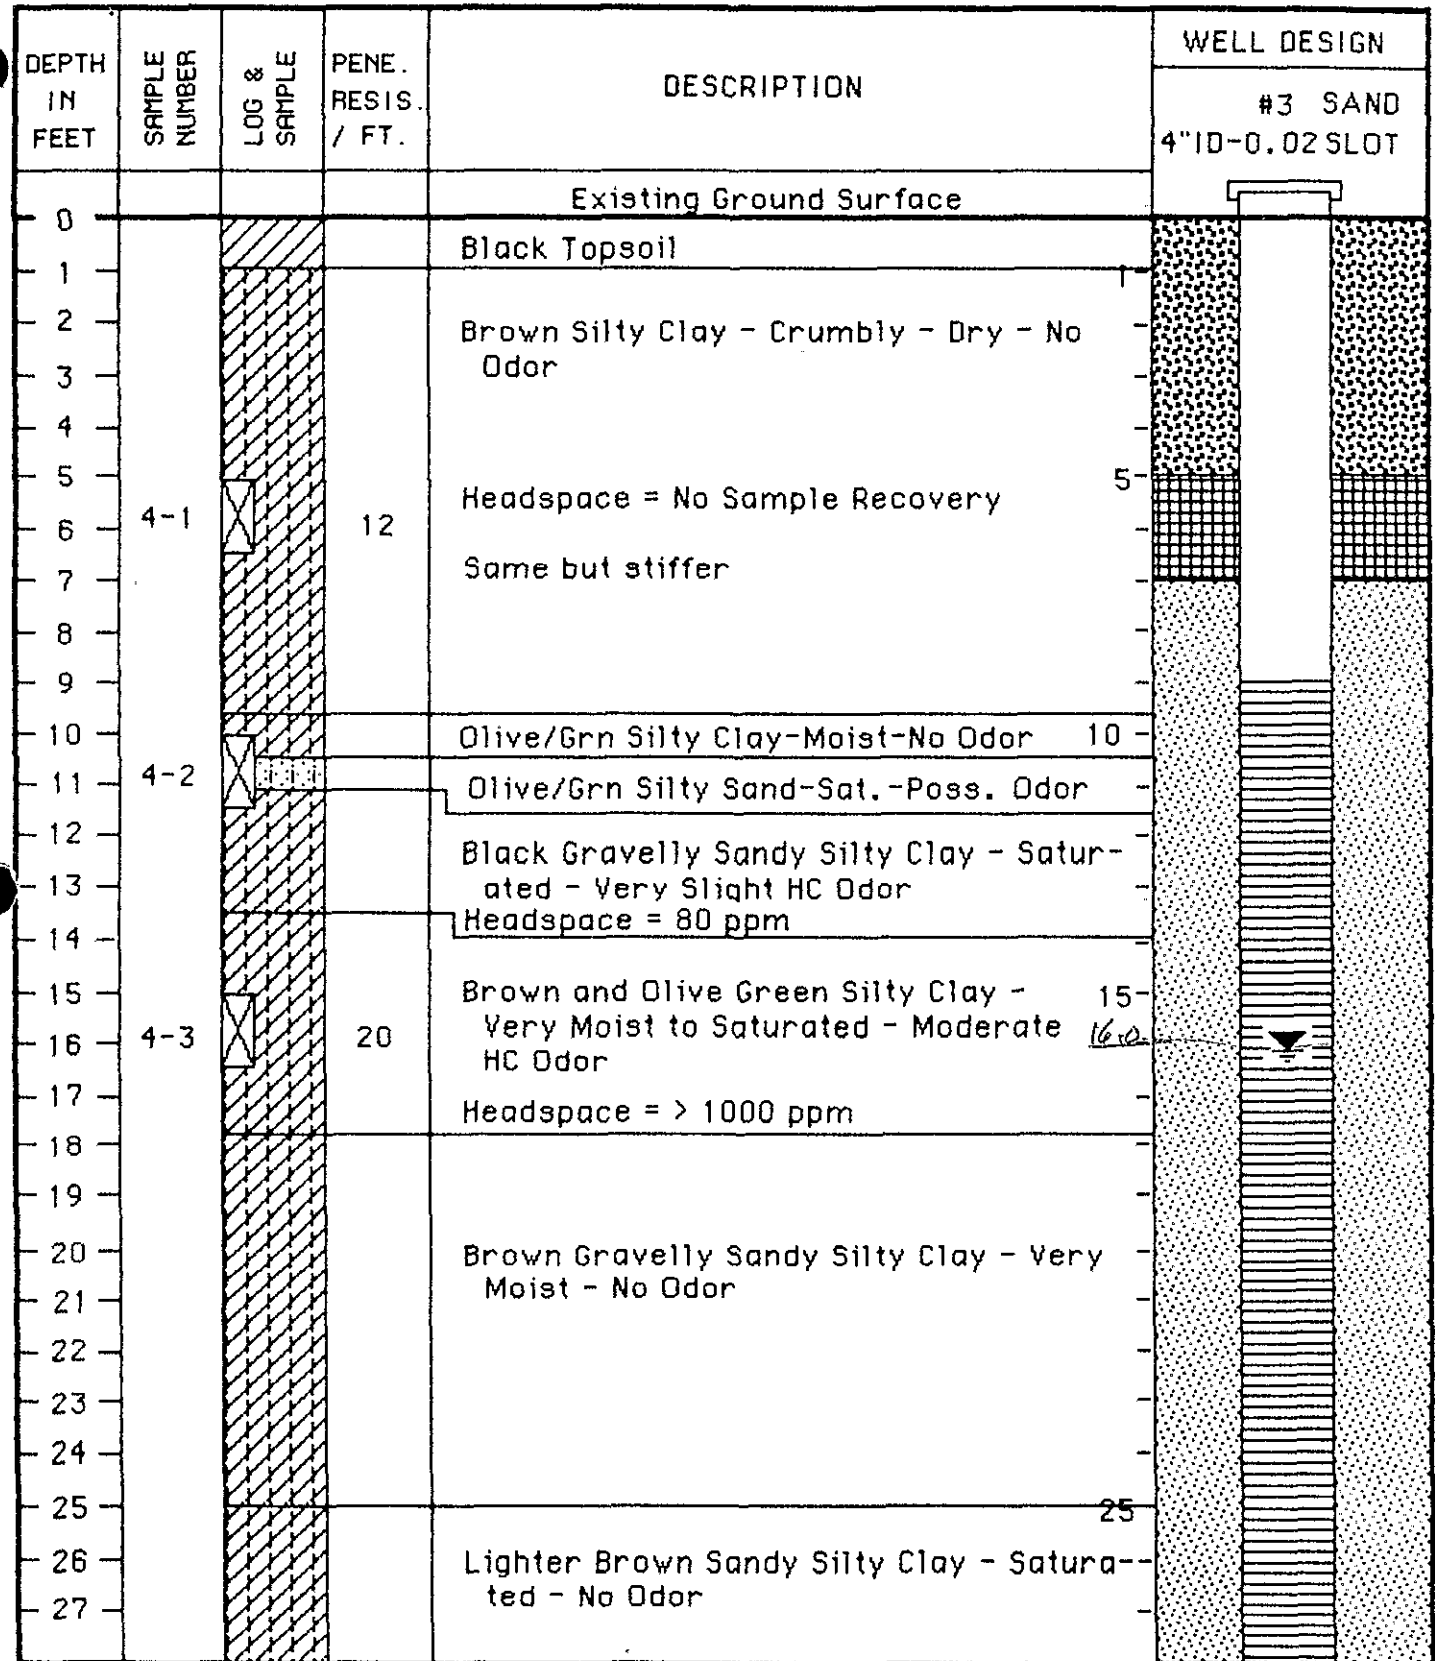


Figure 3A - Test Boring Log No. 1
- Monitoring Well No. MW-4

Woodward-Clyde Consultants

#P6305

179203A
15/4W13D5

Project No.: 90390A

Date: 11-13-86

Elevation.



DEPTH IN FEET	SAMPLE NUMBER	LOG & SAMPLE	PENE. RESIS. / FT.	DESCRIPTION	WELL DESIGN		
					#3	SAND	4"ID-0.02 SLOT
				28 Feet Below Existing Ground Surface			
28							
29				Light Brown Sandy Silty Clay - Saturated - No Odor			
30				Bottom of Boring at 30 ft.			
31							
32							
Figure 3B - Test Boring Log No. 1
- Monitoring Well No. MW-4

#96305

INV ✓
AD ✓

179203B ~~01-217B~~
15/4W13D6

Project No.: 90390A

Date: 11-13-86

Elevation.

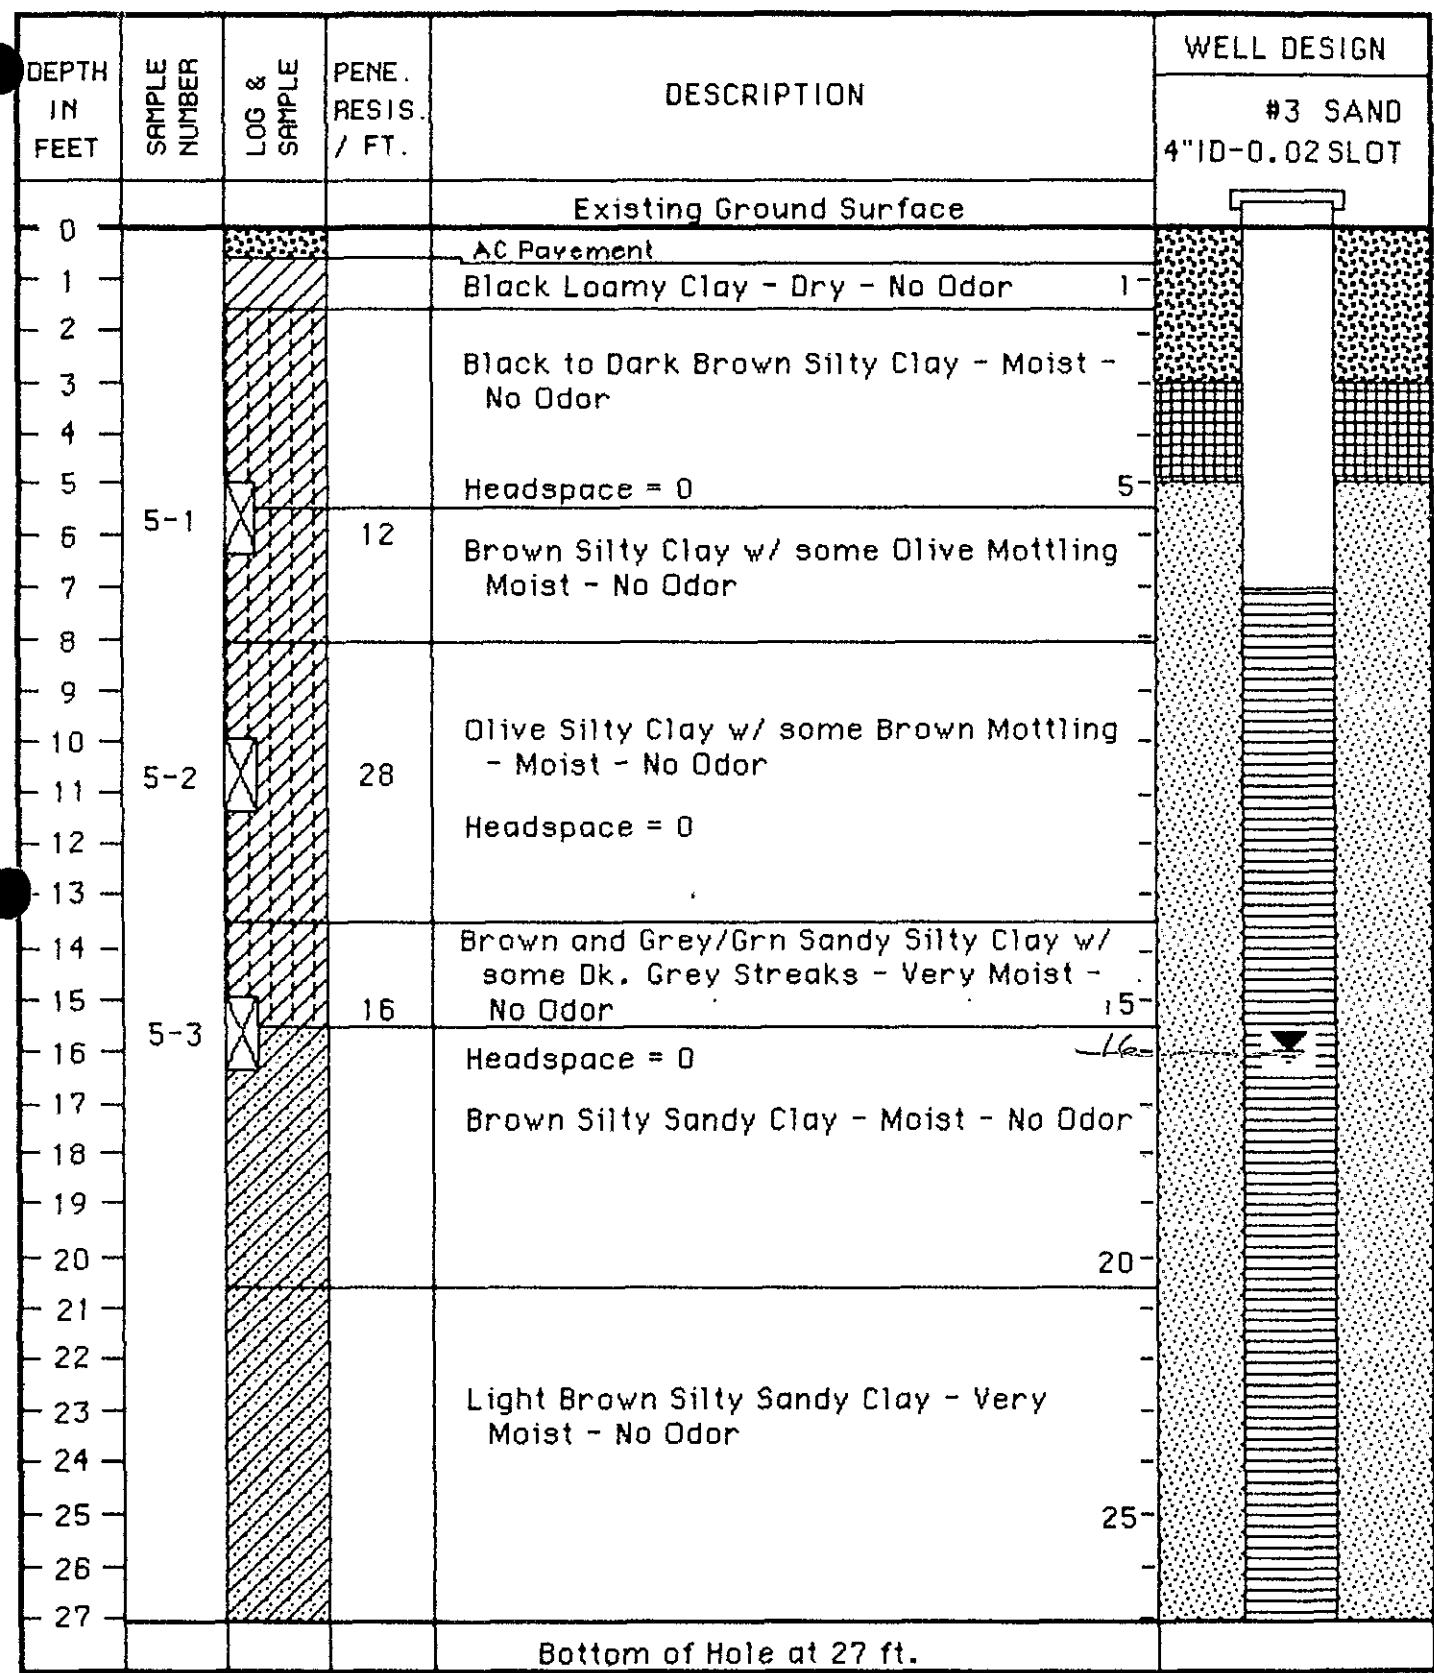


Figure 4 - Test Boring Log No. 2
- Monitoring Well No. MW-5

Woodward-Clyde Consultants

Project No.: 90390A

Date: 11-13-86

INV ✓
AD ✓

1792030 01-2170
15/4W13D7

Elevation.

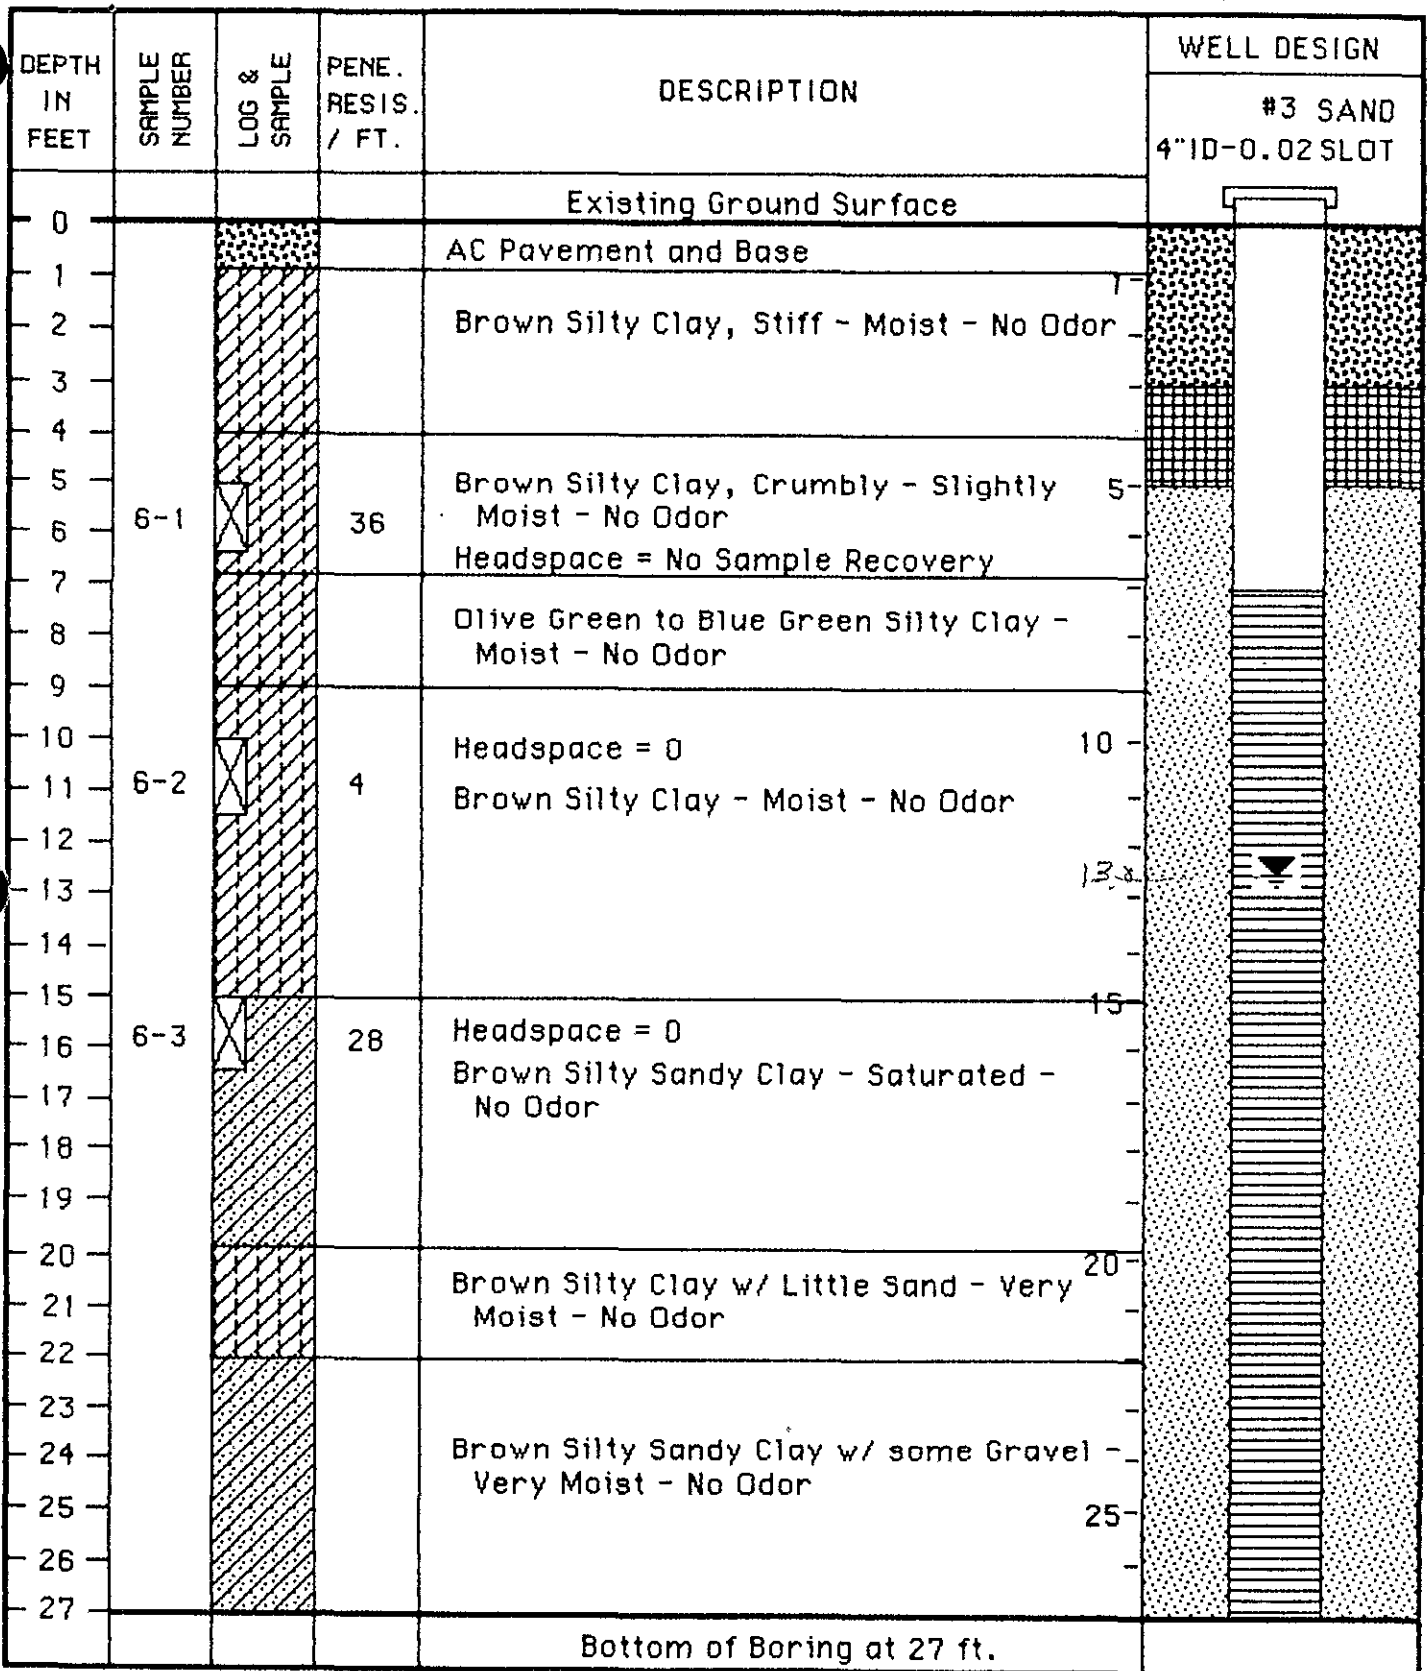


Figure 5 - Test Boring Log No. 3
- Monitoring Well No. MW-6


Woodward-Clyde Consultants

CONFIDENTIAL

STATE OF CALIFORNIA DWR
WELL COMPLETION REPORT
(WELL LOGS)

REMOVED

201222
15/4W 13D8

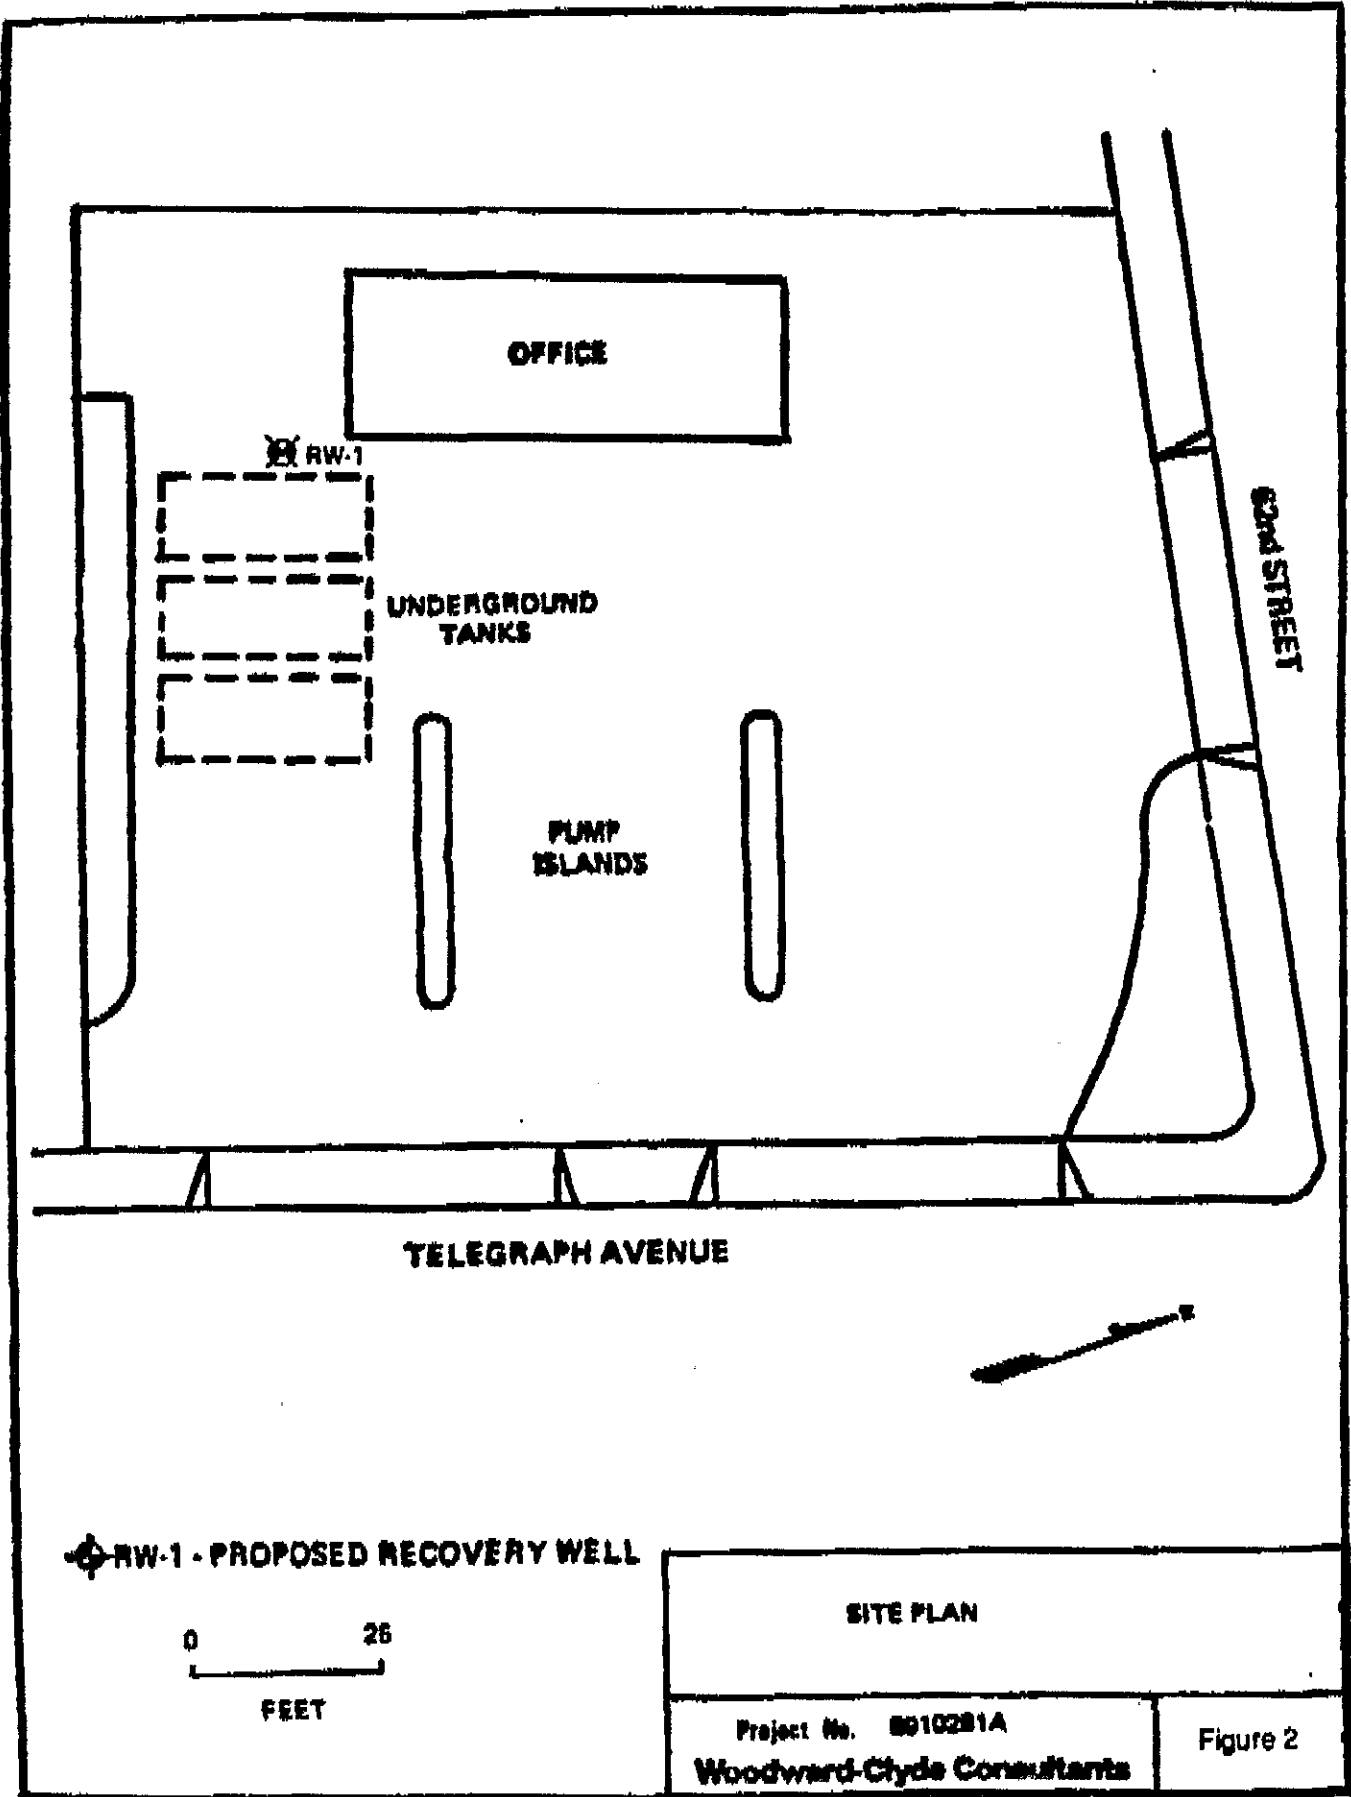

SITE PLAN

Project No. 0010281A
Woodward-Clyde Consultants

Figure 2

CONFIDENTIAL

STATE OF CALIFORNIA DWR
WELL COMPLETION REPORT
(WELL LOGS)

REMOVED


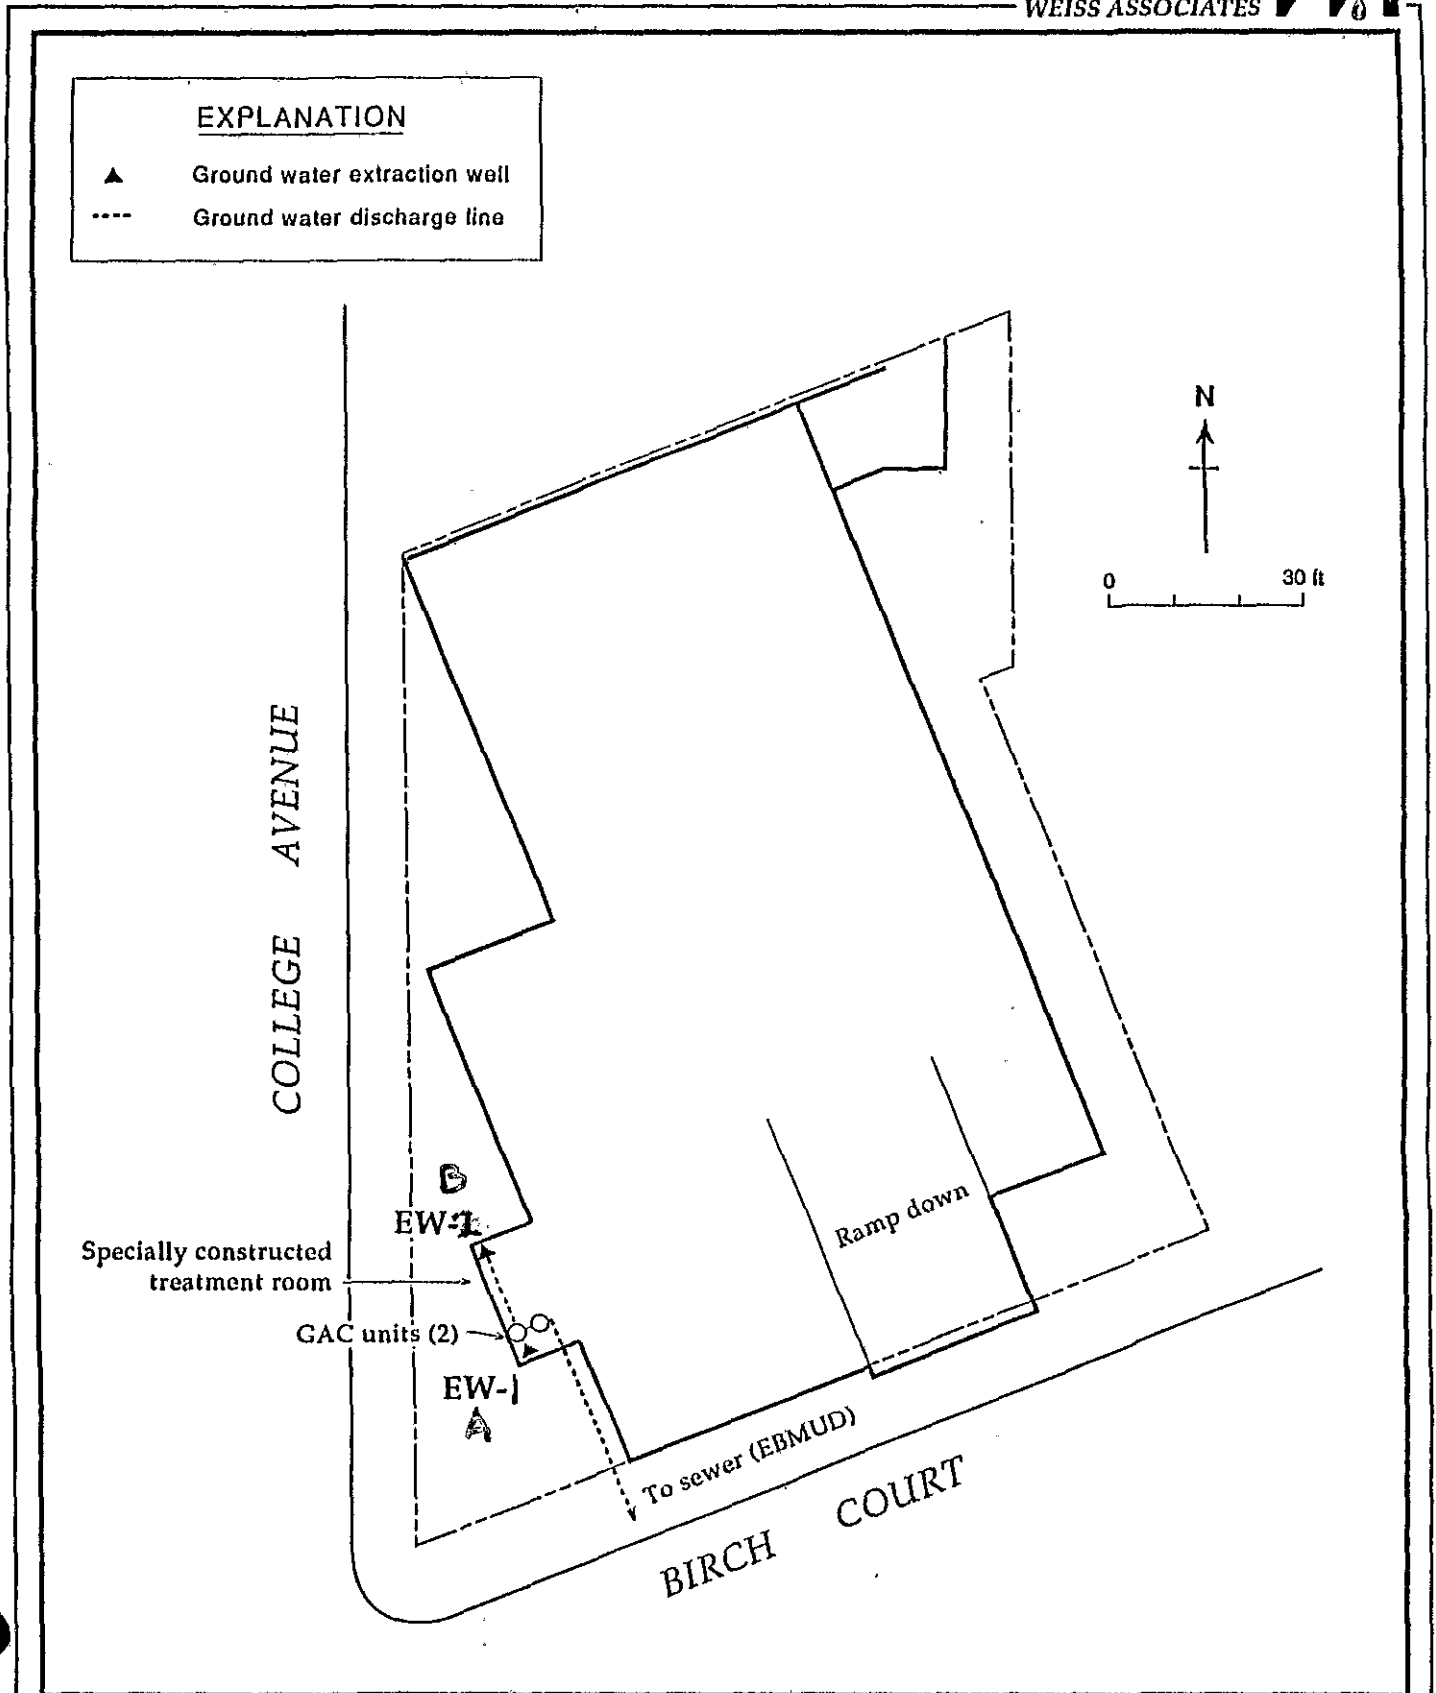


Figure 5. Proposed Ground Water Remediation System - Former Chevron Service Station #92258, 5800 College Avenue, Oakland, California

WELL EW-1

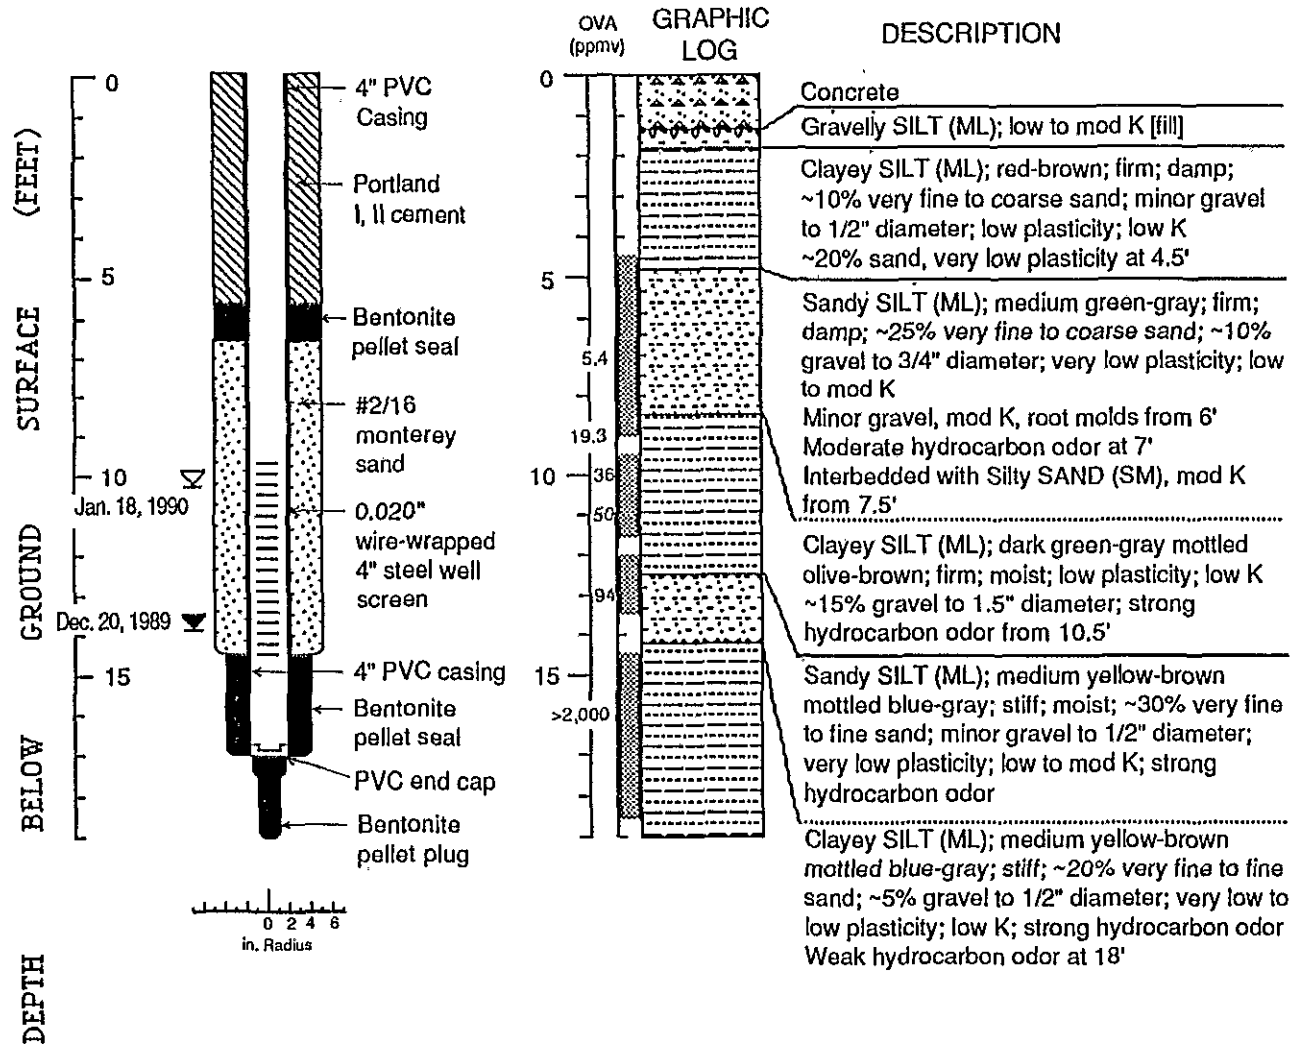

EXPLANATION

- Water level during drilling (date)
- Water level (date)
- Contact (dotted where approx.)
- Uncertain contact
- Location of recovered drive sample
- Location of drive sample sealed for chemical analysis
- Cutting sample
- K** = Estimated hydraulic conductivity

Logged by: John Duey
 Supervisor: Richard Weiss; EG 1112
 Drilling Company: Allen Drilling
 Driller: Guy Lyons
 Drilling Method: Hollow stem auger
 Dates Drilled: Dec. 20, 21, 1989
 Well Head Completion: Concrete vault
 Type of sampler: Split Barrel (1.5", 2", 2.5" ID)

CONFIDENTIAL

STATE OF CALIFORNIA DWR
WELL COMPLETION REPORT
(WELL LOGS)

REMOVED



EXPLANATION	
▲	Ground water extraction well
----	Ground water discharge line

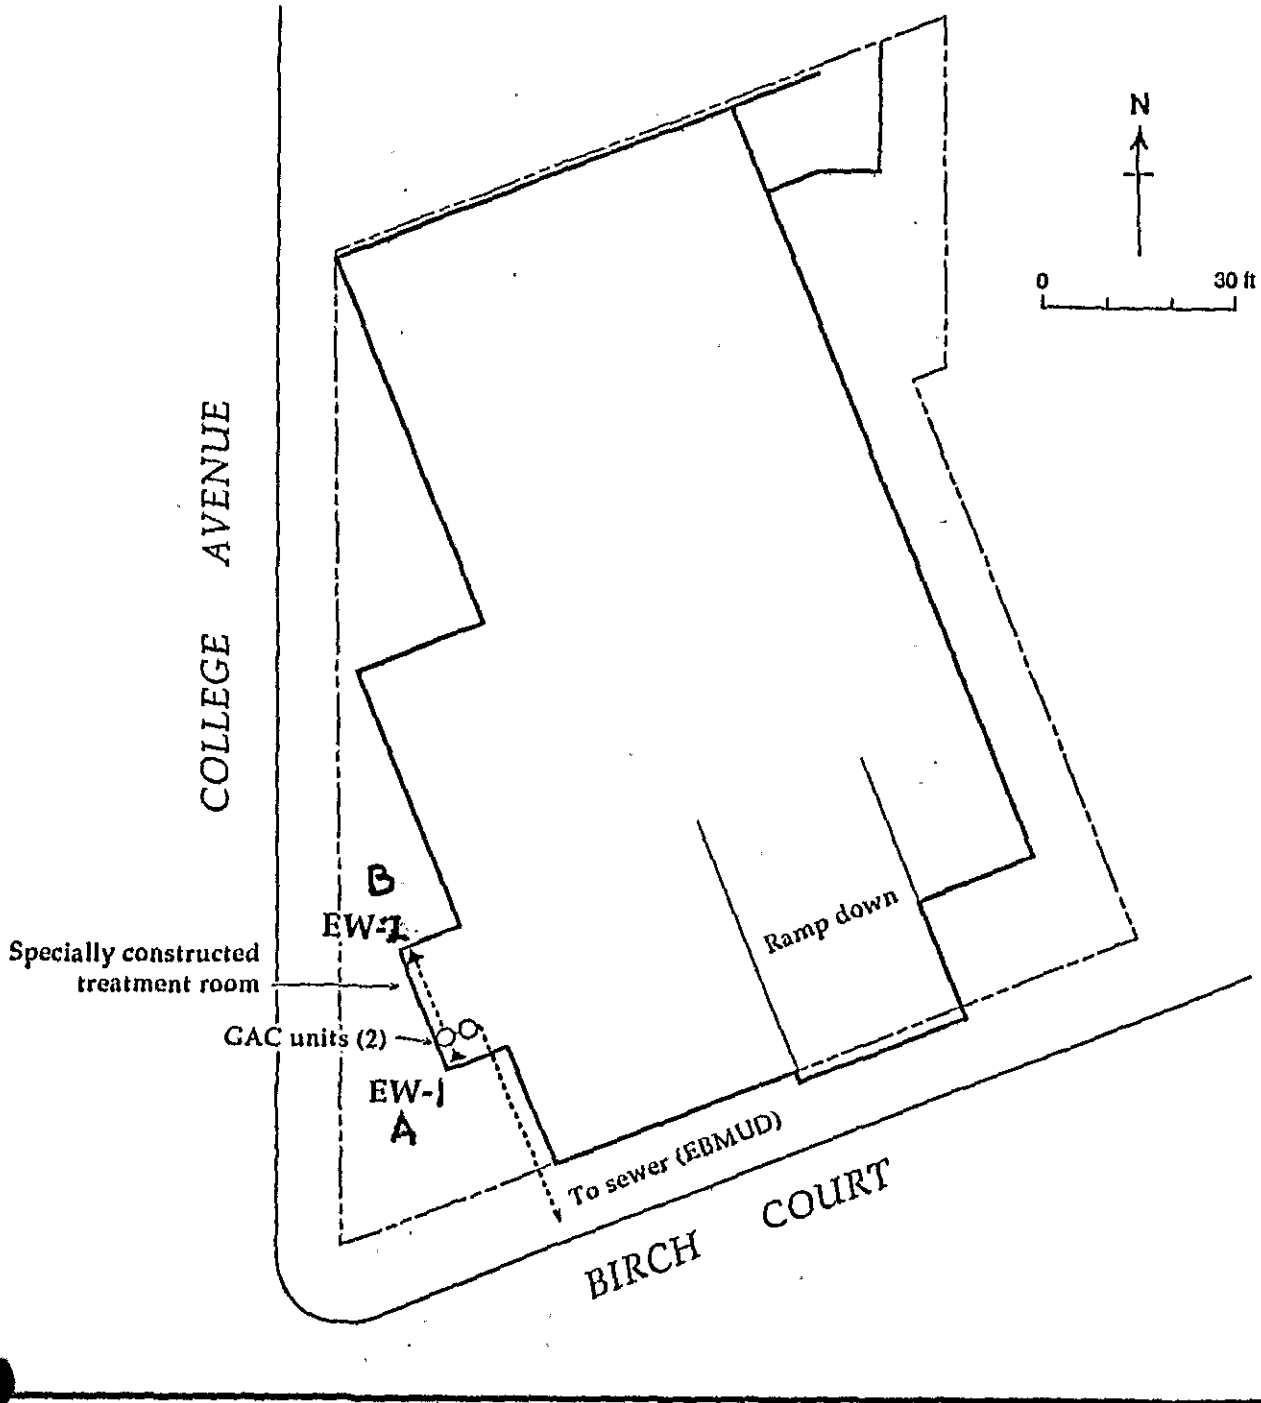



Figure 5. Proposed Ground Water Remediation System - Former Chevron Service Station #92258, 5800 College Avenue, Oakland, California

15/4W 1307

325102B WA

WEISS ASSOCIATES

WELL EW-2

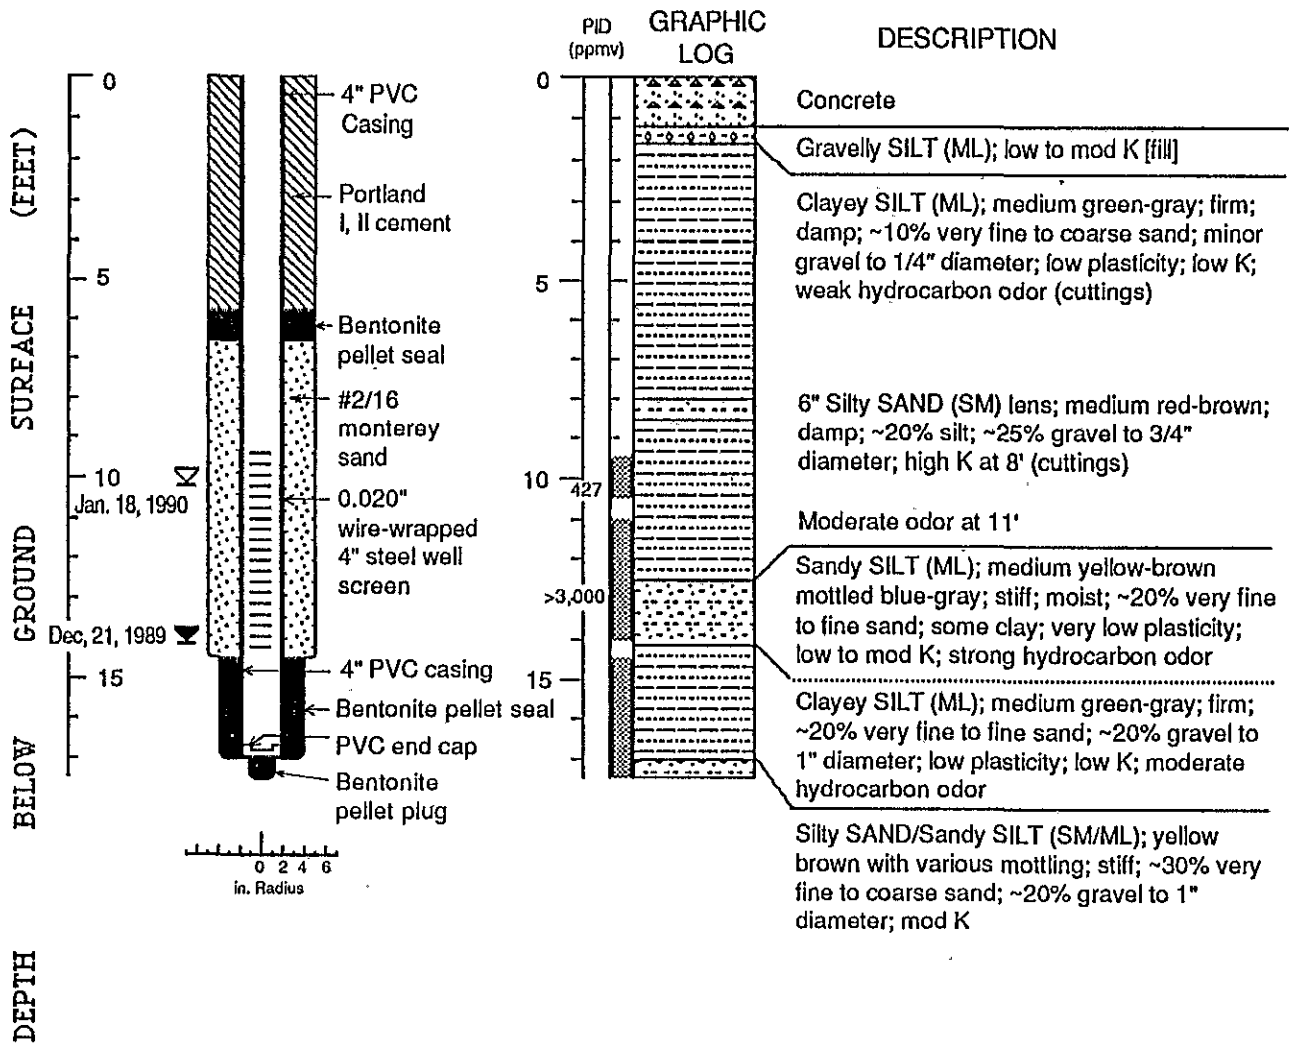

EXPLANATION

- ▼ Water level during drilling (date)
- ▽ Water level (date)
- Contact (dotted where approx.)
- - - - - Uncertain contact
- ▨ Location of recovered drive sample
- Location of drive sample sealed for chemical analysis
- ⊗ Cutting sample
- K = Estimated hydraulic conductivity

Logged by: John Duey
 Supervisor: Richard Weiss; EG 1112
 Drilling Company: Allen Drilling
 Driller: Guy Lyons
 Drilling Method: Hollow stem auger
 Dates Drilled: Dec. 20, 21, 1989
 Well Head Completion: Concrete vault
 Type of sampler: Split Barrel (1.5", 2.0", 2.5" ID)

Well Construction and Boring Log - Well EW-2

Chevron Service Station #92258, Oakland, CA

CONFIDENTIAL

STATE OF CALIFORNIA DWR
WELL COMPLETION REPORT
(WELL LOGS)

REMOVED

CONFIDENTIAL

STATE OF CALIFORNIA DWR
WELL COMPLETION REPORT
(WELL LOGS)

REMOVED

CONFIDENTIAL

**STATE OF CALIFORNIA DWR
WELL COMPLETION REPORT
(WELL LOGS)**

REMOVED

CONFIDENTIAL

STATE OF CALIFORNIA DWR
WELL COMPLETION REPORT
(WELL LOGS)

REMOVED

CONFIDENTIAL

STATE OF CALIFORNIA DWR
WELL COMPLETION REPORT
(WELL LOGS)

REMOVED


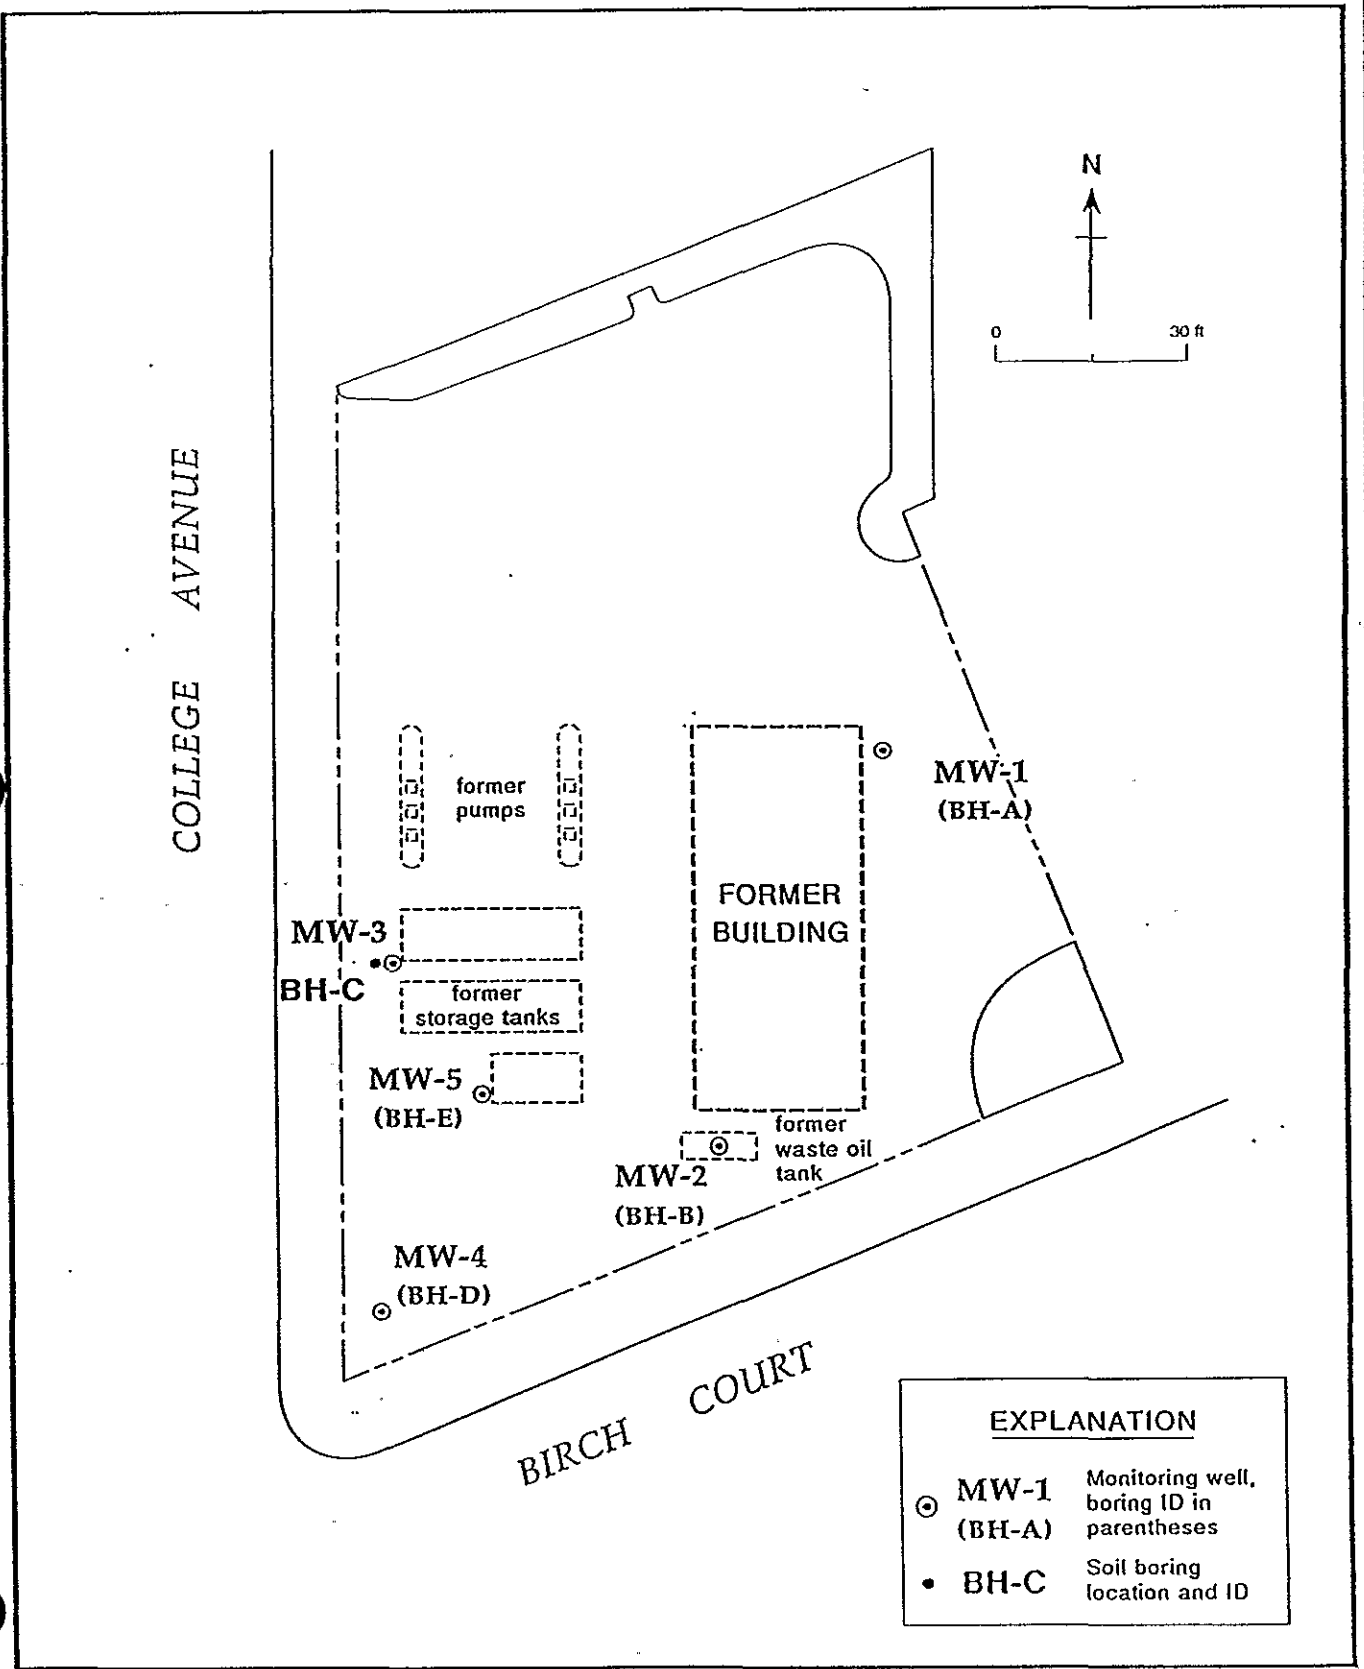


Figure 2. Monitoring Well and Soil Boring Locations - Chevron Service Station #92258, Oakland, California

CONFIDENTIAL

STATE OF CALIFORNIA DWR
WELL COMPLETION REPORT
(WELL LOGS)

REMOVED

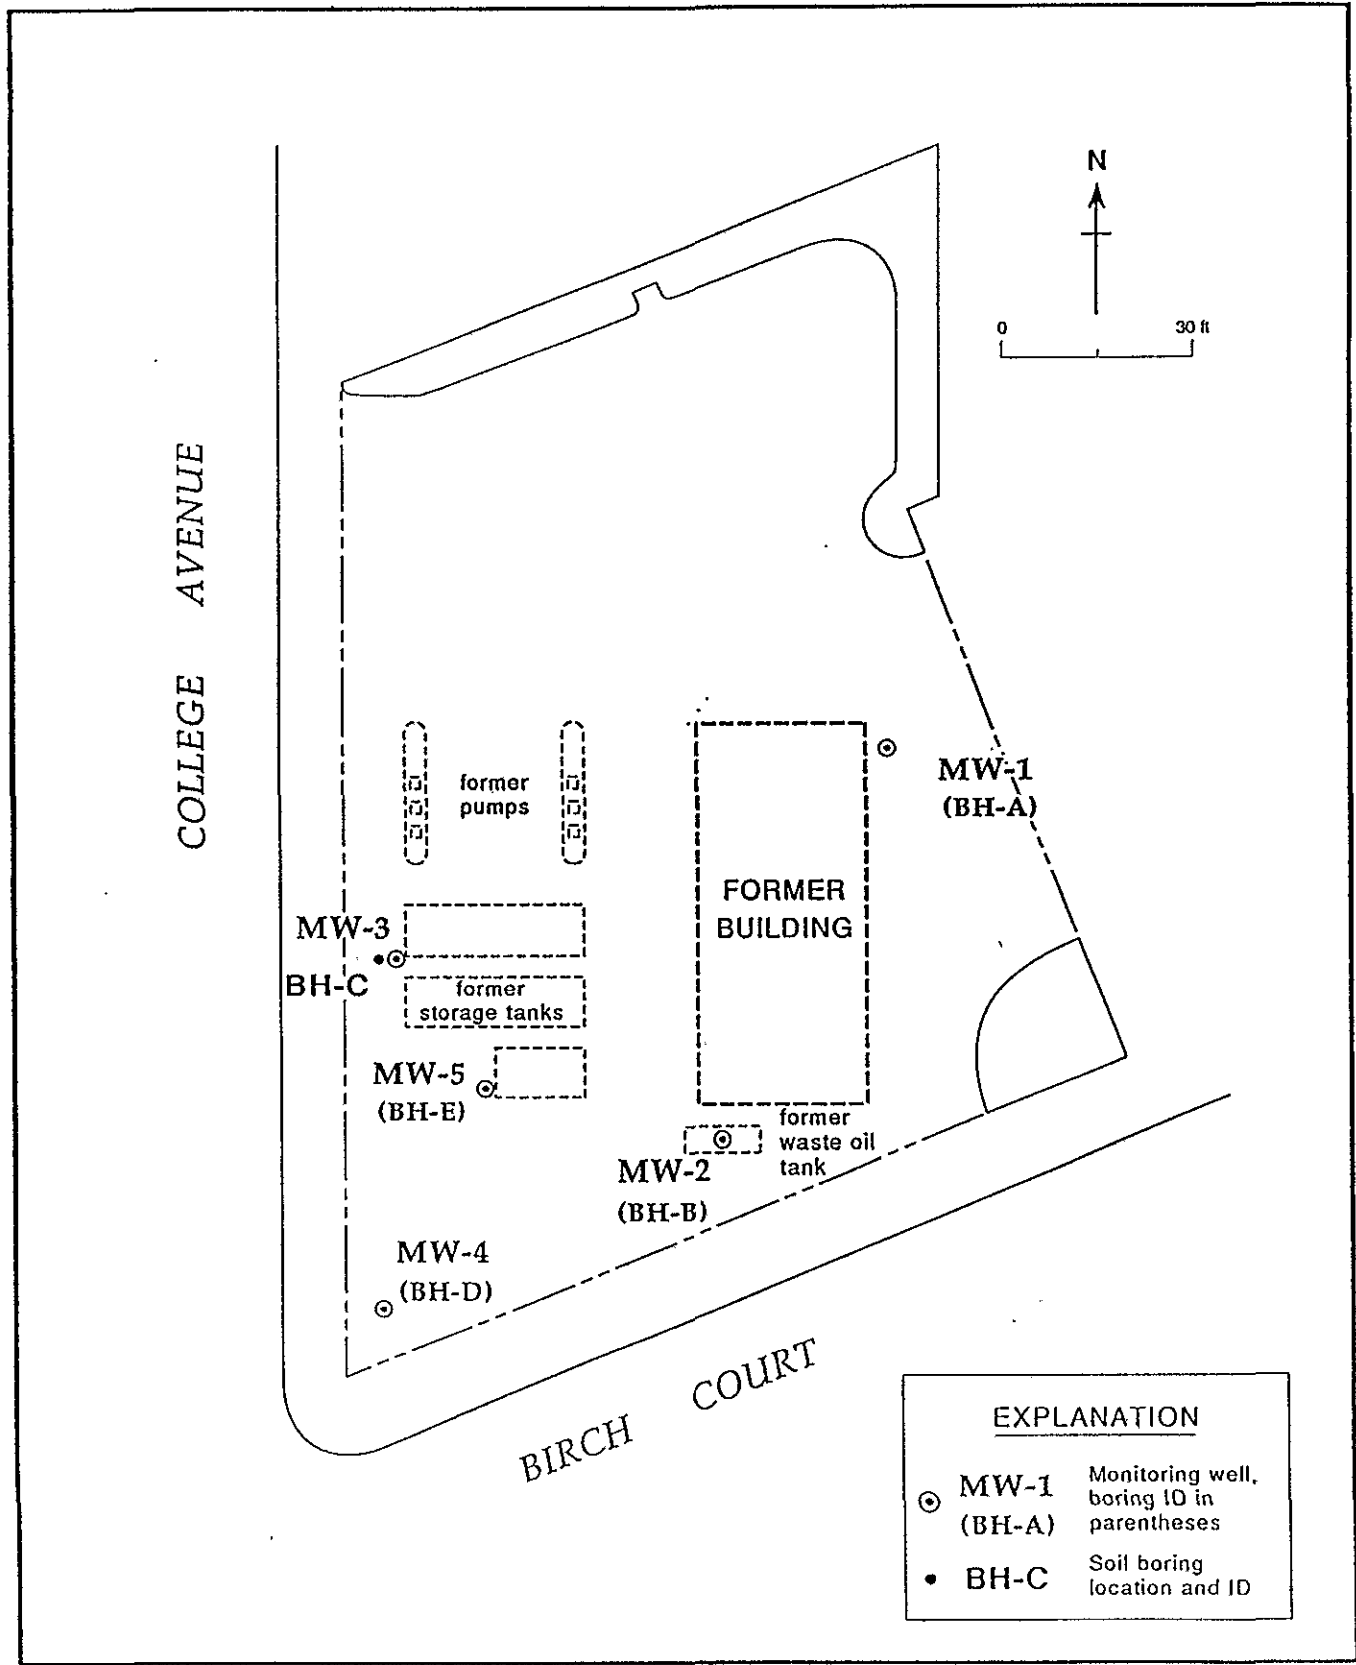

EXPLANATION	
⊙	MW-1 (BH-A) Monitoring well, boring ID in parentheses
•	BH-C Soil boring location and ID

Figure 2. Monitoring Well and Soil Boring Locations - Chevron Service Station #92258, Oakland, California

Add ✓
In ✓


136-1

1S/4W 13G-1

WEISS ASSOCIATES



WELL MW-1 (BH-A)

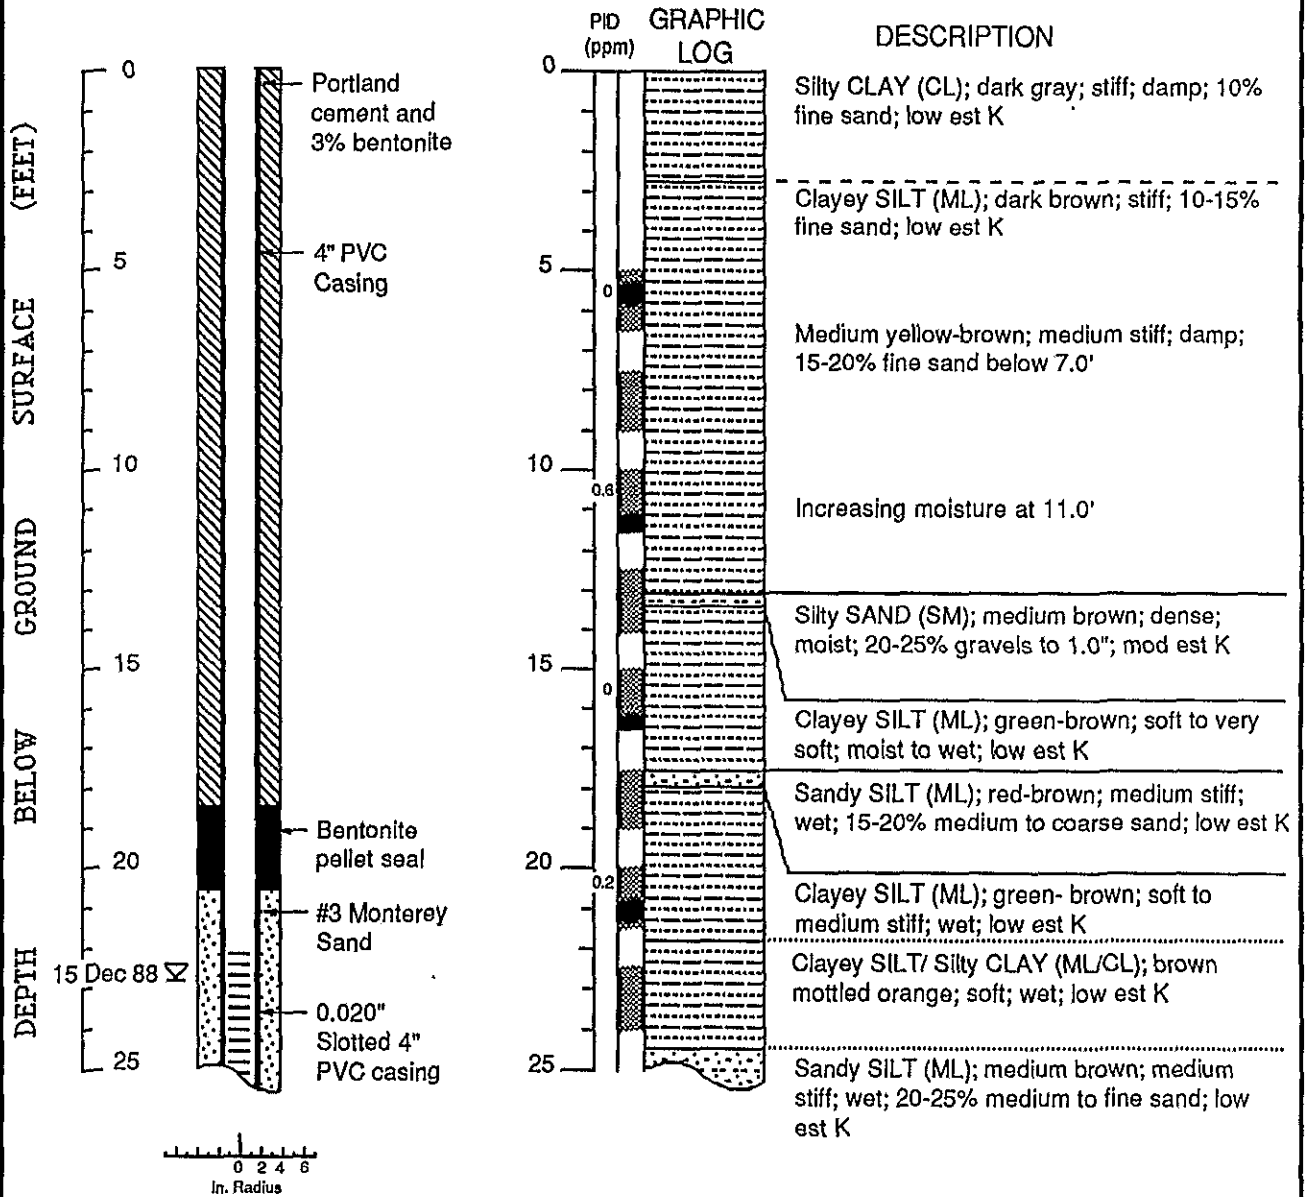

EXPLANATION


- Water level during drilling (date)
- Water level (date)
- Contact (dotted where approx.)
- Uncertain contact
- Location of recovered drive sample
- Location of drive sample sealed for chemical analysis
- Cutting sample
- K** = Estimated permeability (hydraulic conductivity)

Logged by: Jim Carmody
 Supervisor: Richard Weiss; EG 1112
 Drilling Company: Datum Exploration, Pittsburg, CA
 Driller: Jim Condrey
 Drilling Method: CME-75
 Dates Drilled: 6 December 1988
 Well Head Completion: Locking Stovepipe
 Type of sampler: Split barrel (1.4, 2.0, 2.5" ID)

Well Construction and Boring Log - Well MW-1 (BH-A)

Chevron Service Station #92258
Oakland, California

WELL MW-1 (BH-A) (cont.)

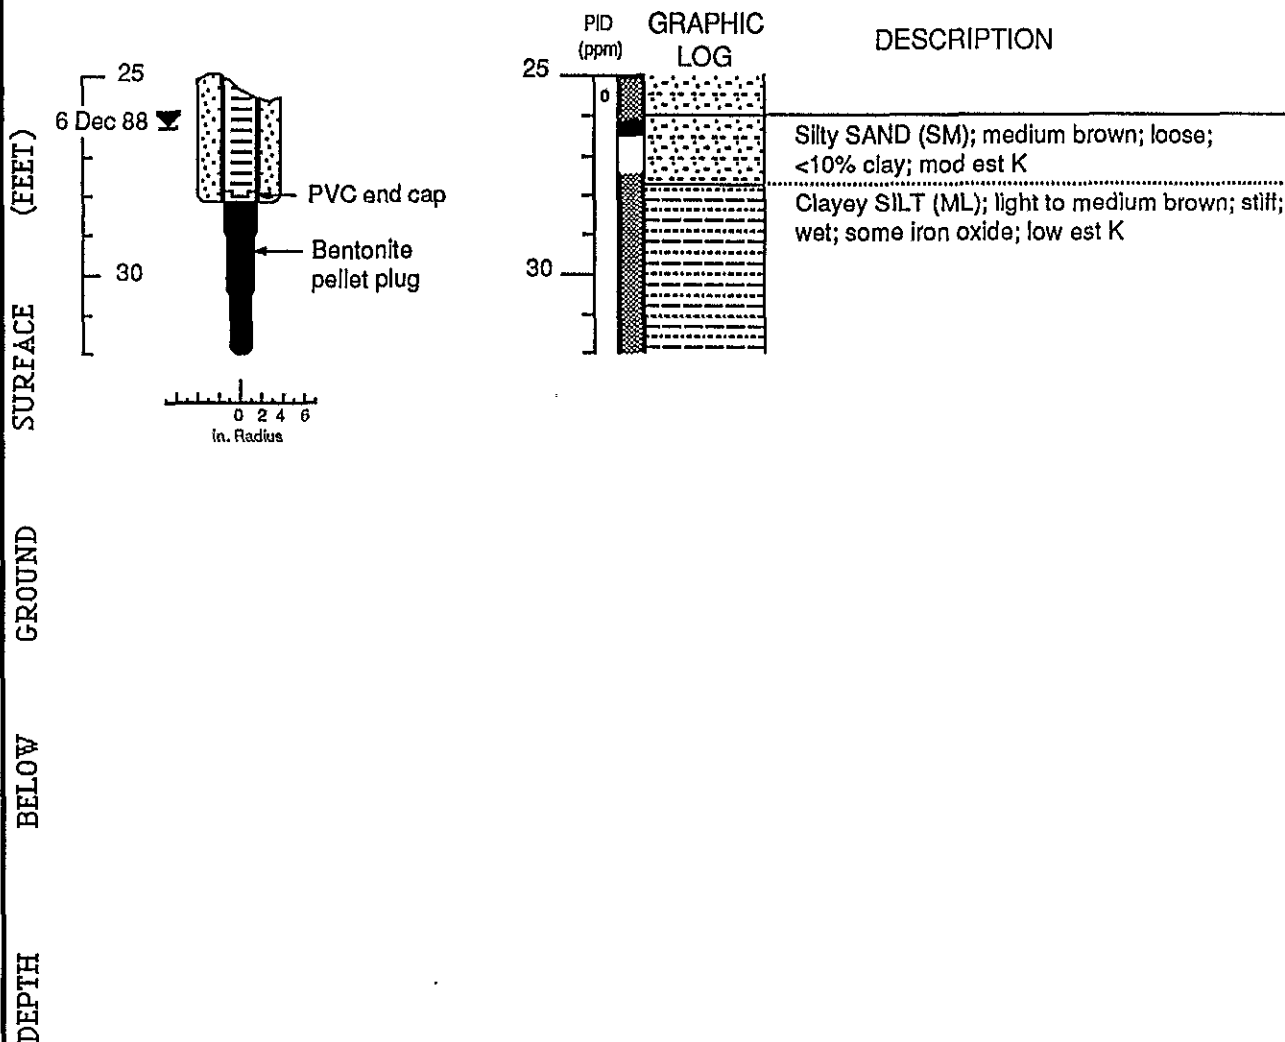


Well Construction and Boring Log - Well MW-1(BH-A)




 


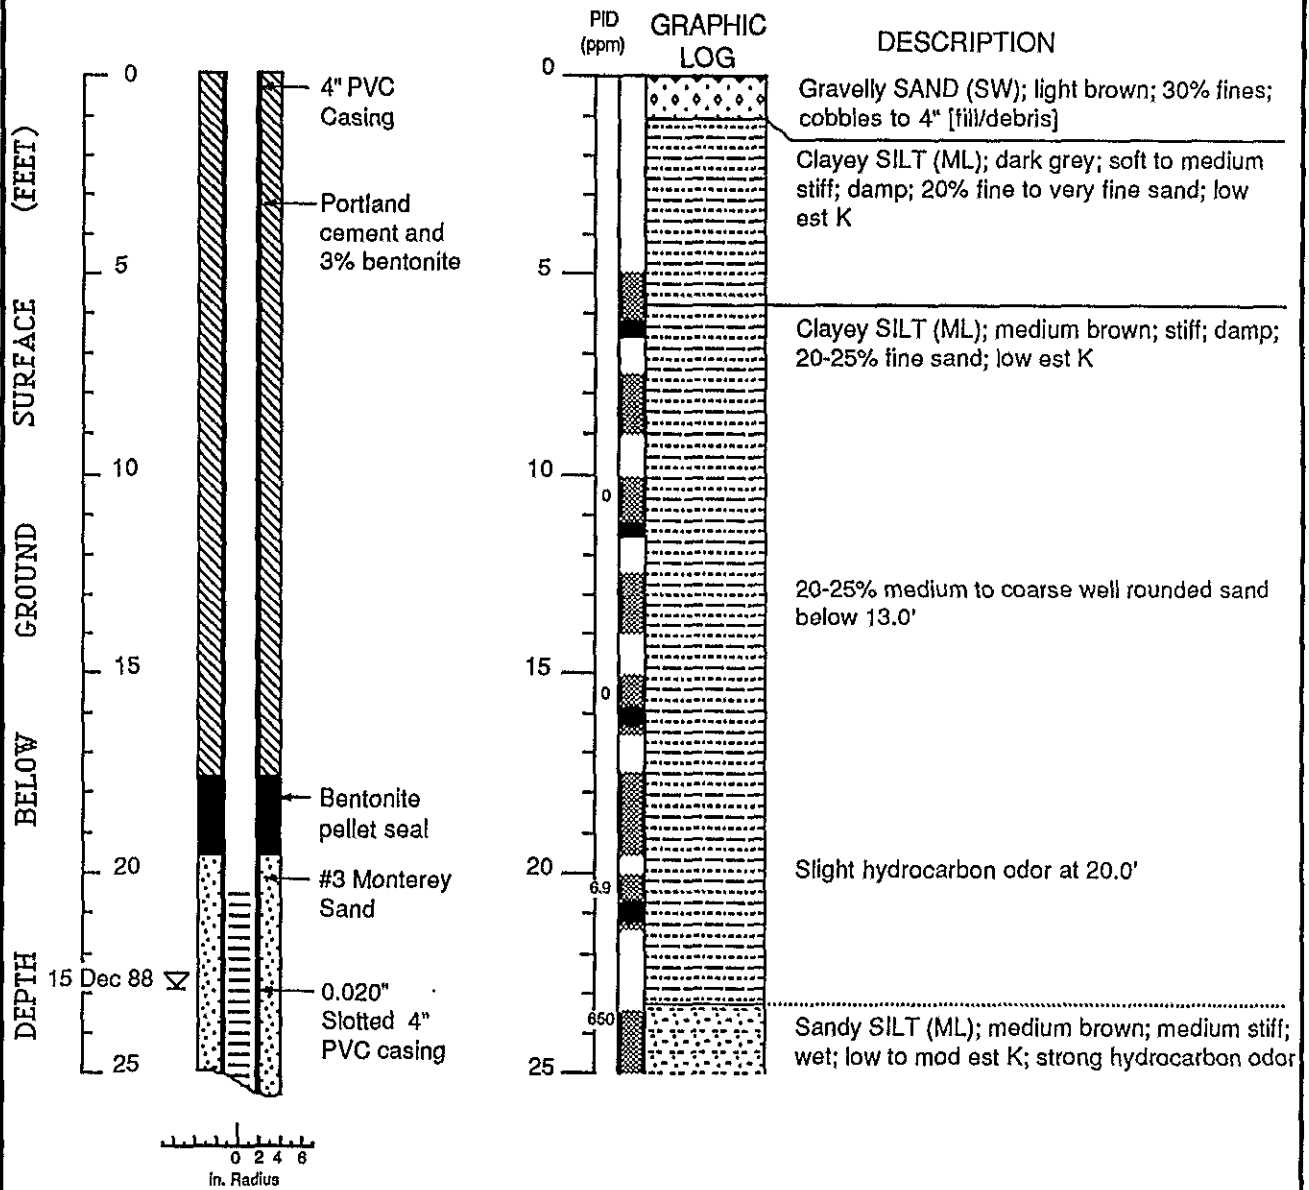

Chevron Service Station #92258
Oakland, California

Add
Iron

WELL MW-2 (BH-B)




EXPLANATION

-  Water level during drilling (date)
 -  Water level (date)
 -  Contact (dotted where approx.)
 -  Uncertain contact
 -  Location of recovered drive sample
 -  Location of drive sample sealed for chemical analysis
 -  Cutting sample
 -  K = Estimated permeability (hydraulic conductivity)
- Logged by: Jim Carmody
 - Supervisor: Richard Weiss; EG 1112
 - Drilling Company: Datum Exploration, Pittsburg, CA
 - Driller: Jim Condrey
 - Drilling Method: CME-75
 - Dates Drilled: 6 December 1988
 - Well Head Completion: Locking Stovepipe
 - Type of sampler: Split barrel (1.4, 2.0, 2.5" ID)

Well Construction and Boring Log - Well MW-2 (BH-B) Chevron Service Station #92258
Oakland, California



WELL MW-2 (BH-B) (cont.)

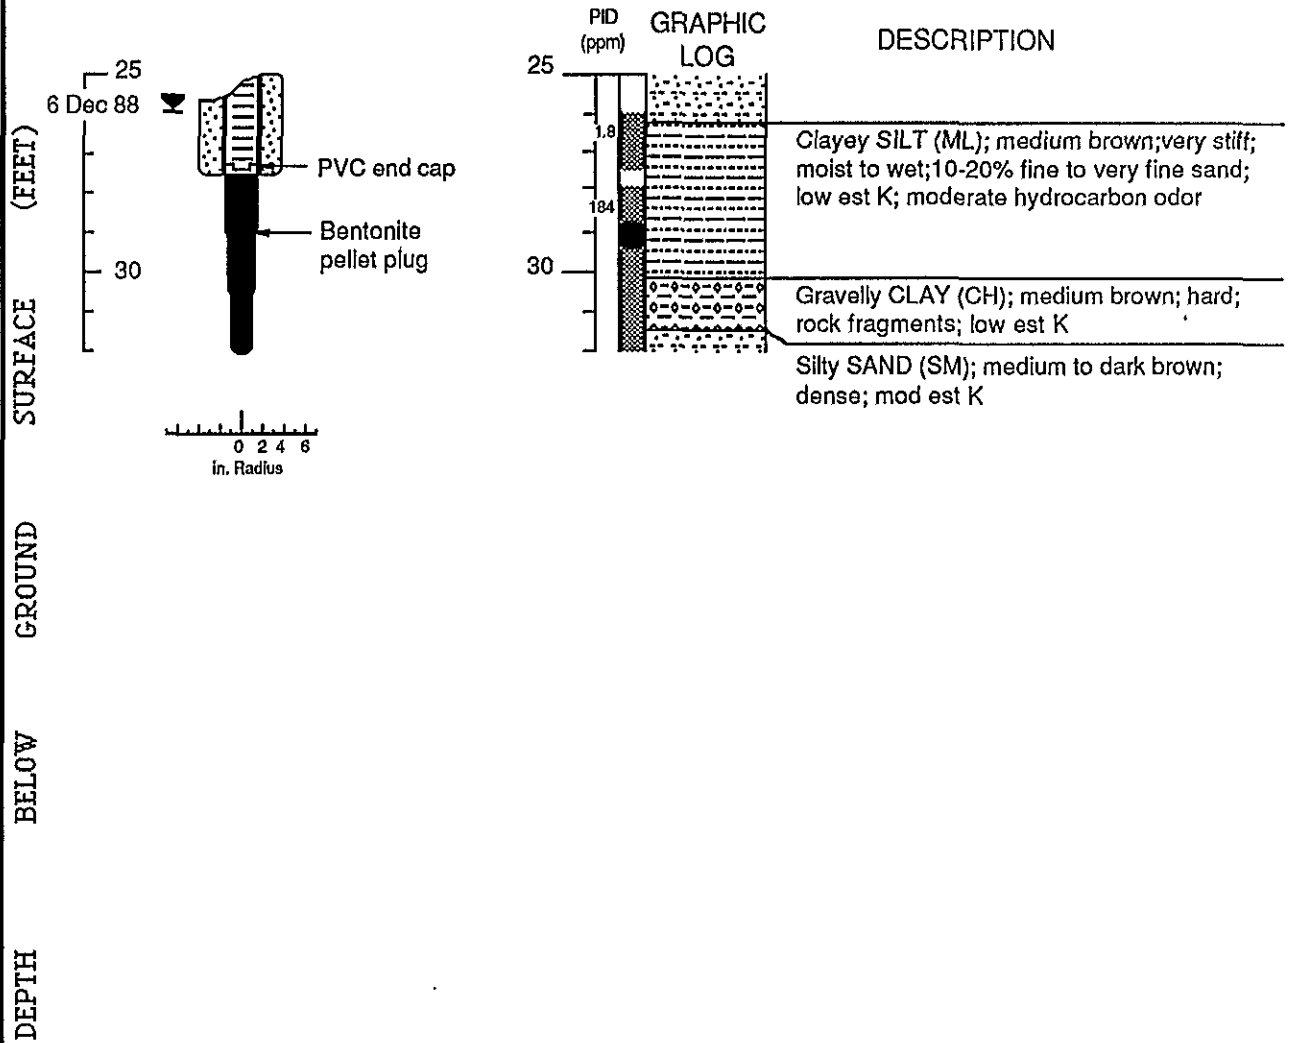

Well Construction and Boring Log - Well MW-2 (BH-B)

Chevron Service Station #92258
Oakland, California

179045C


Add
In

1363 154W 13G3

WEISS ASSOCIATES



WELL MW-3 (BH-C)

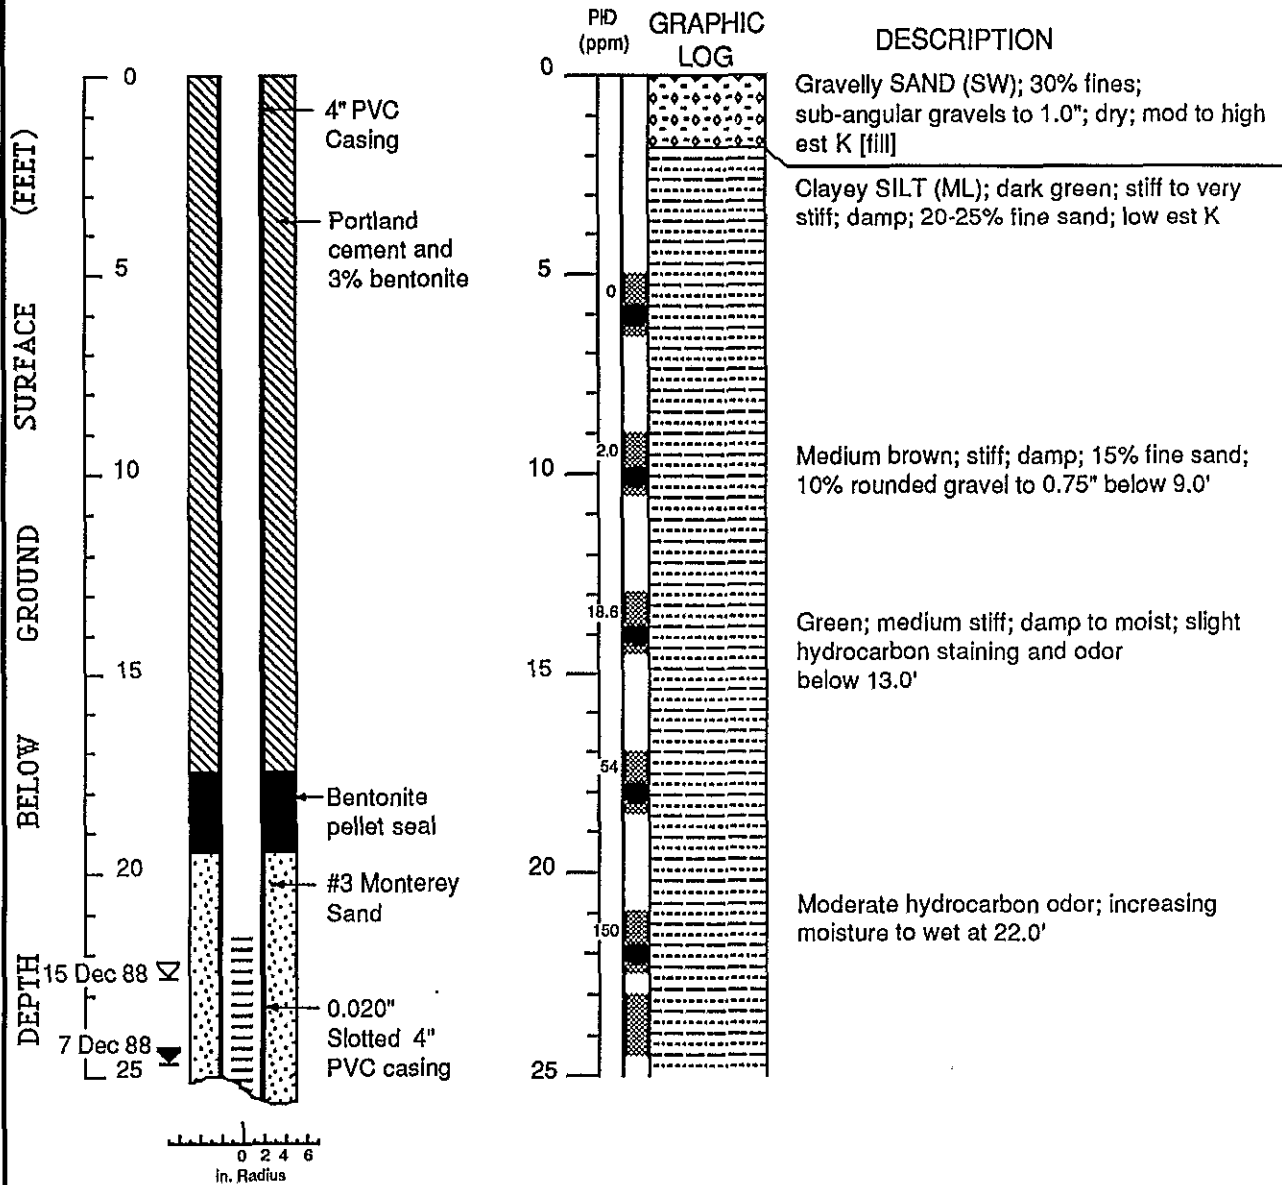


EXPLANATION

- Water level during drilling (date)
 - Water level (date)
 - Contact (dotted where approx.)
 - Uncertain contact
 - Location of recovered drive sample
 - Location of drive sample sealed for chemical analysis
 - Cutting sample
 - K = Estimated permeability (hydraulic conductivity)
- Logged by: Jim Carmody
 Supervisor: Richard Weiss; EG 1112
 Drilling Company: Datum Exploration, Pittsburg, CA
 Driller: Jim Condrey
 Drilling Method: CME-75
 Dates Drilled: 7 December 88
 Well Head Completion: Locking Stovepipe
 Type of sampler: Split barrel (1.4, 2.0, 2.5" ID)

Well Construction and Boring Log - Well MW-3 (BH-C) Chevron Service Station #92258 Oakland, California


WELL MW-3 (BH-C) (cont.)

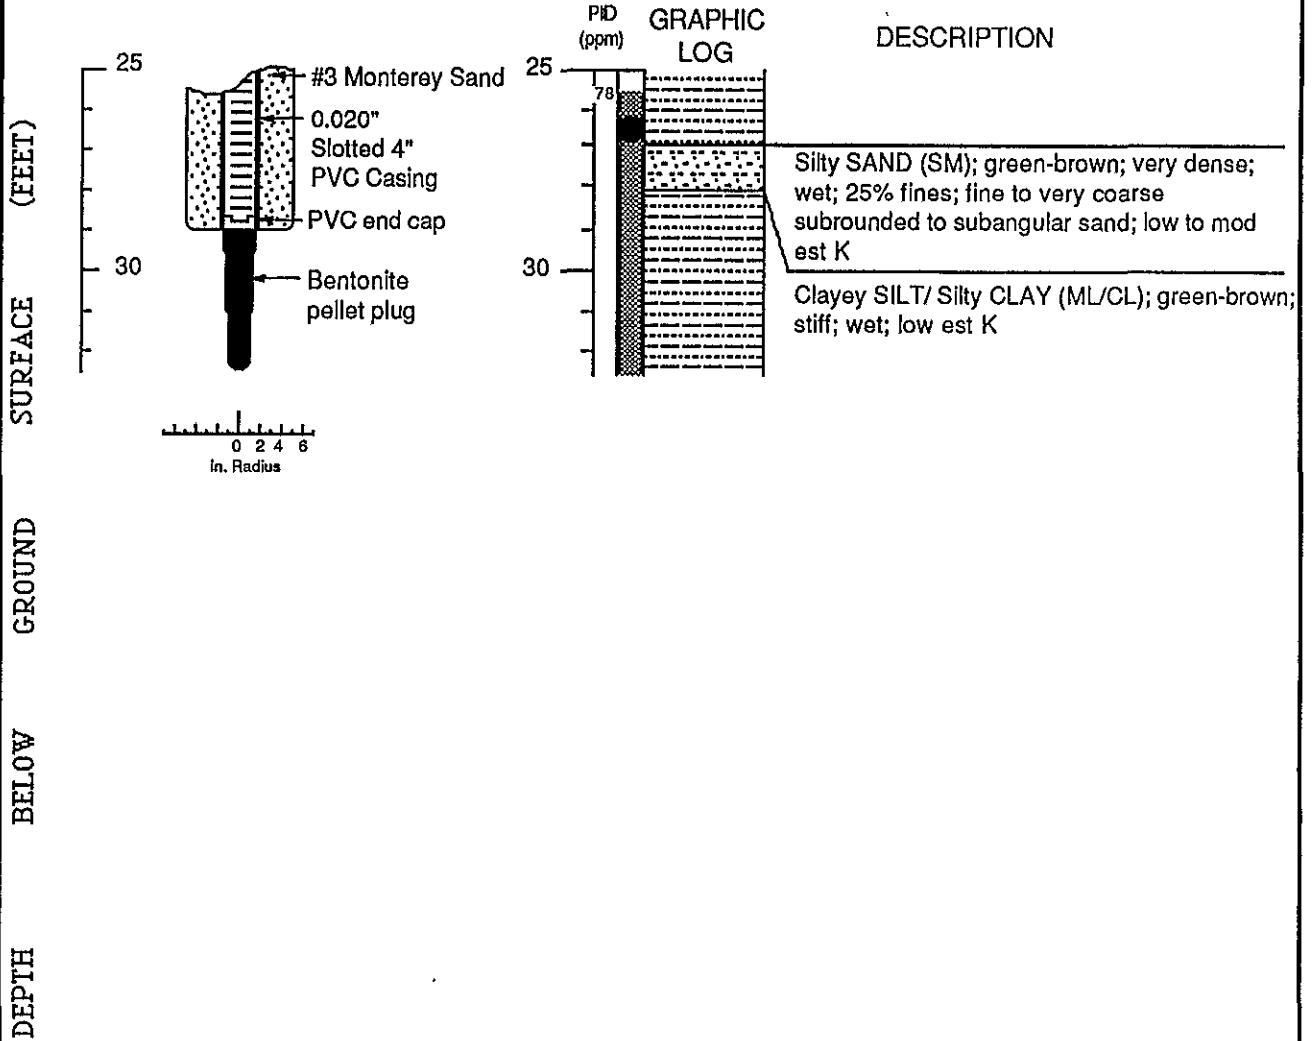







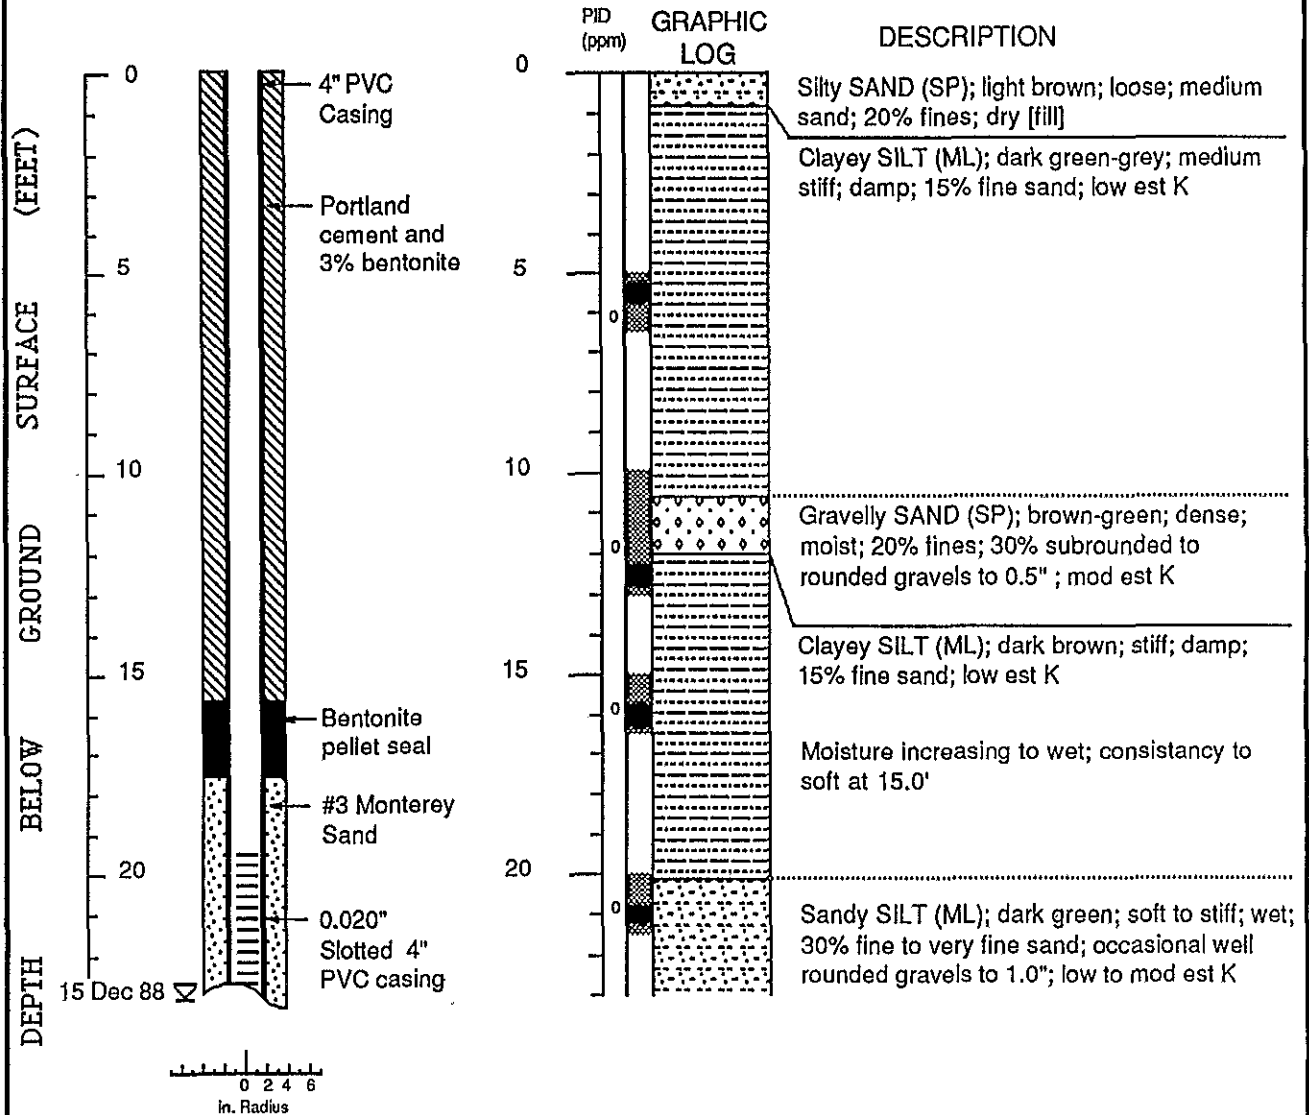

Add ✓
Inv ✓

1364 154W 13G-4

WELL MW-4 (BH-D)




EXPLANATION

-  Water level during drilling (date)
-  Water level (date)
-  Contact (dotted where approx.)
-  Uncertain contact
-  Location of recovered drive sample
-  Location of drive sample sealed for chemical analysis
-  Cutting sample
-  K = Estimated permeability (hydraulic conductivity)
- Logged by: Jim Carmody
- Supervisor: Richard Weiss; EG 1112
- Drilling Company: Datum Exploration, Pittsburg, CA
- Driller: Jim Condrey
- Drilling Method: CME-75
- Dates Drilled: 8 December 1988
- Well Head Completion: Locking Stovepipe
- Type of sampler: Split barrel (1.4, 2.0, 2.5" ID)

Well Construction and Boring Log - Well MW-4 (BH-D) Chevron Service Station #92258
Oakland, California

WELL MW-4/BH-D (cont.)

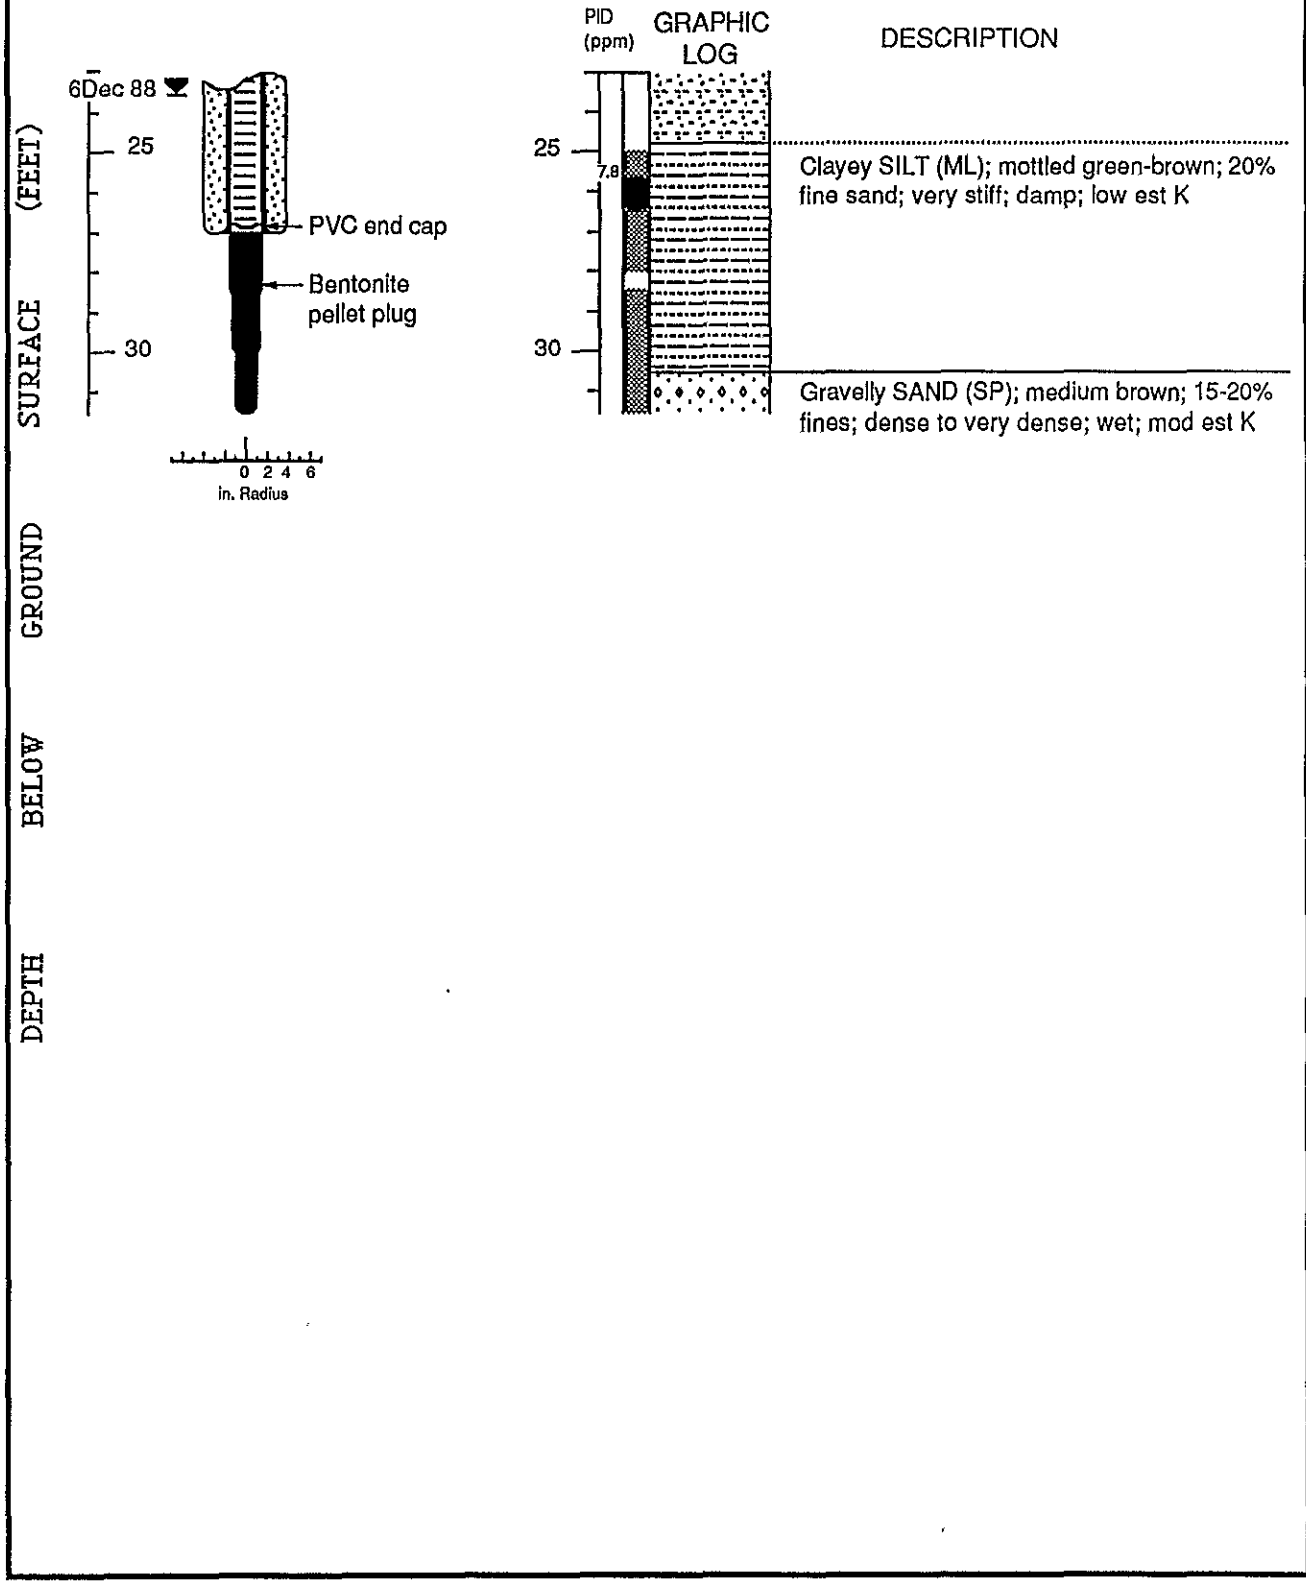

Well Construction and Boring Log - Well MW-4 (BH-D)


Chevron Service Station #92258
Oakland, California

Add
Inv

1365 15/4W 1365



WELL MW-5 (BH-E)

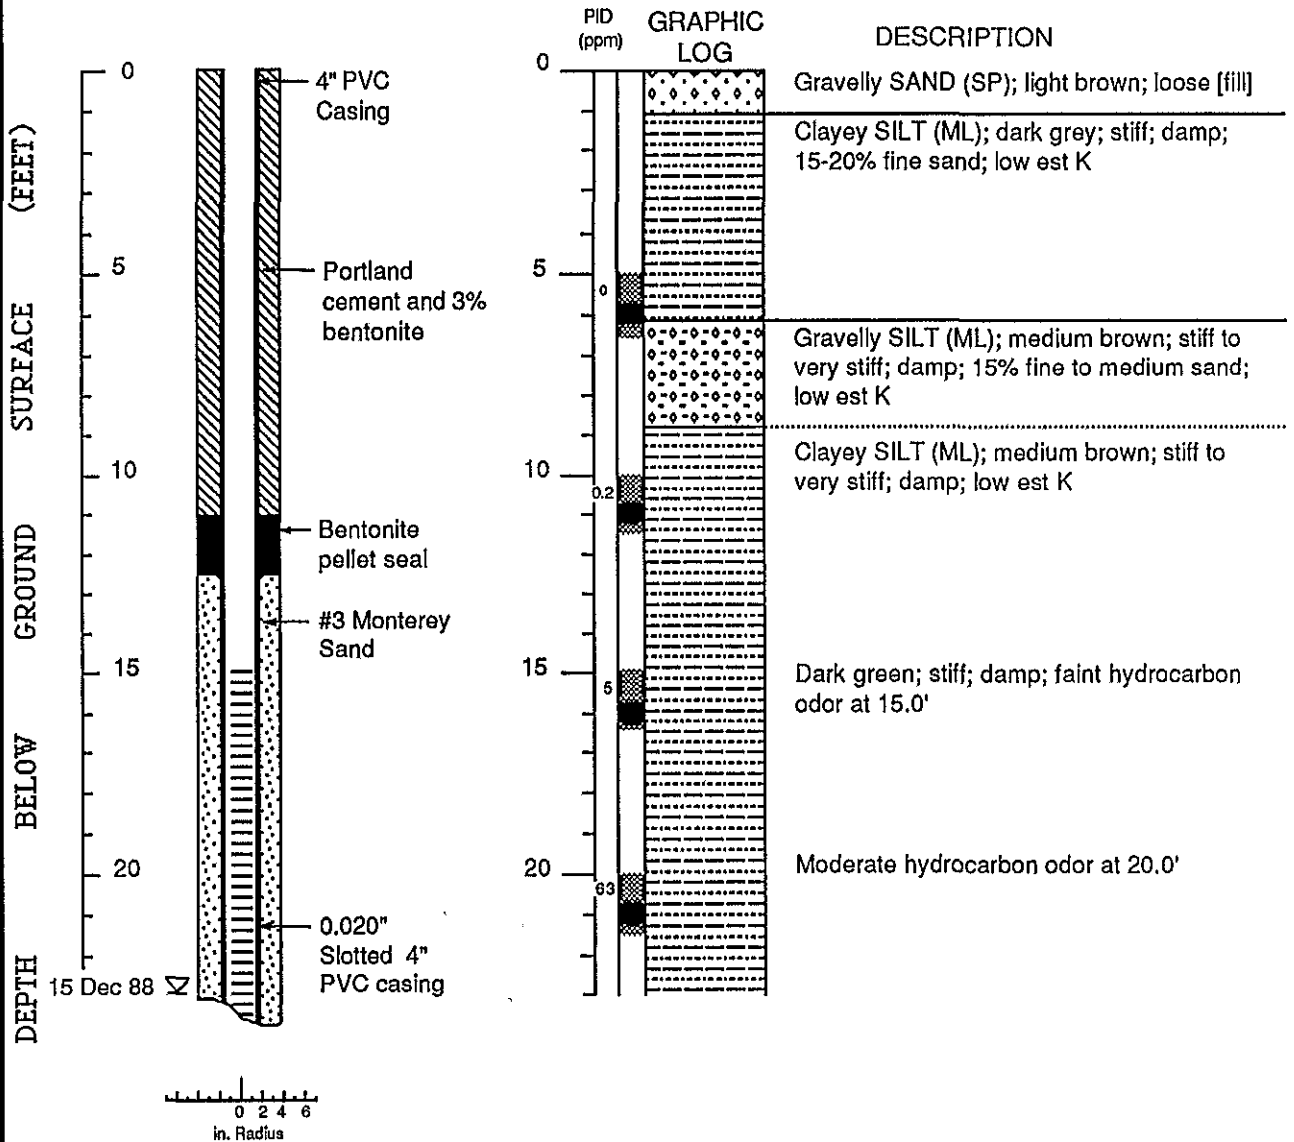

EXPLANATION

- ▼ Water level during drilling (date)
- ▽ Water level (date)
- Contact (dotted where approx.)
- - - - - Uncertain contact
- ▣ Location of recovered drive sample
- Location of drive sample sealed for chemical analysis
- ⊗ Cutting sample
- K = Estimated permeability (hydraulic conductivity)


Logged by: Jim Carmody
 Supervisor: Richard Weiss; EG 1112
 Drilling Company: Datum Exploration, Pittsburg, CA
 Driller: Jim Condrey
 Drilling Method: CME-75
 Dates Drilled: 8 December 1988
 Well Head Completion: Locking Stovepipe
 Type of sampler: Split barrel (1.4, 2.0, 2.5" ID)

Well Construction and Boring Log - Well MW-5 (BH-E)

Chevron Service Station #92258
Oakland, California



WELL MW-5 (BH-E) (cont.)

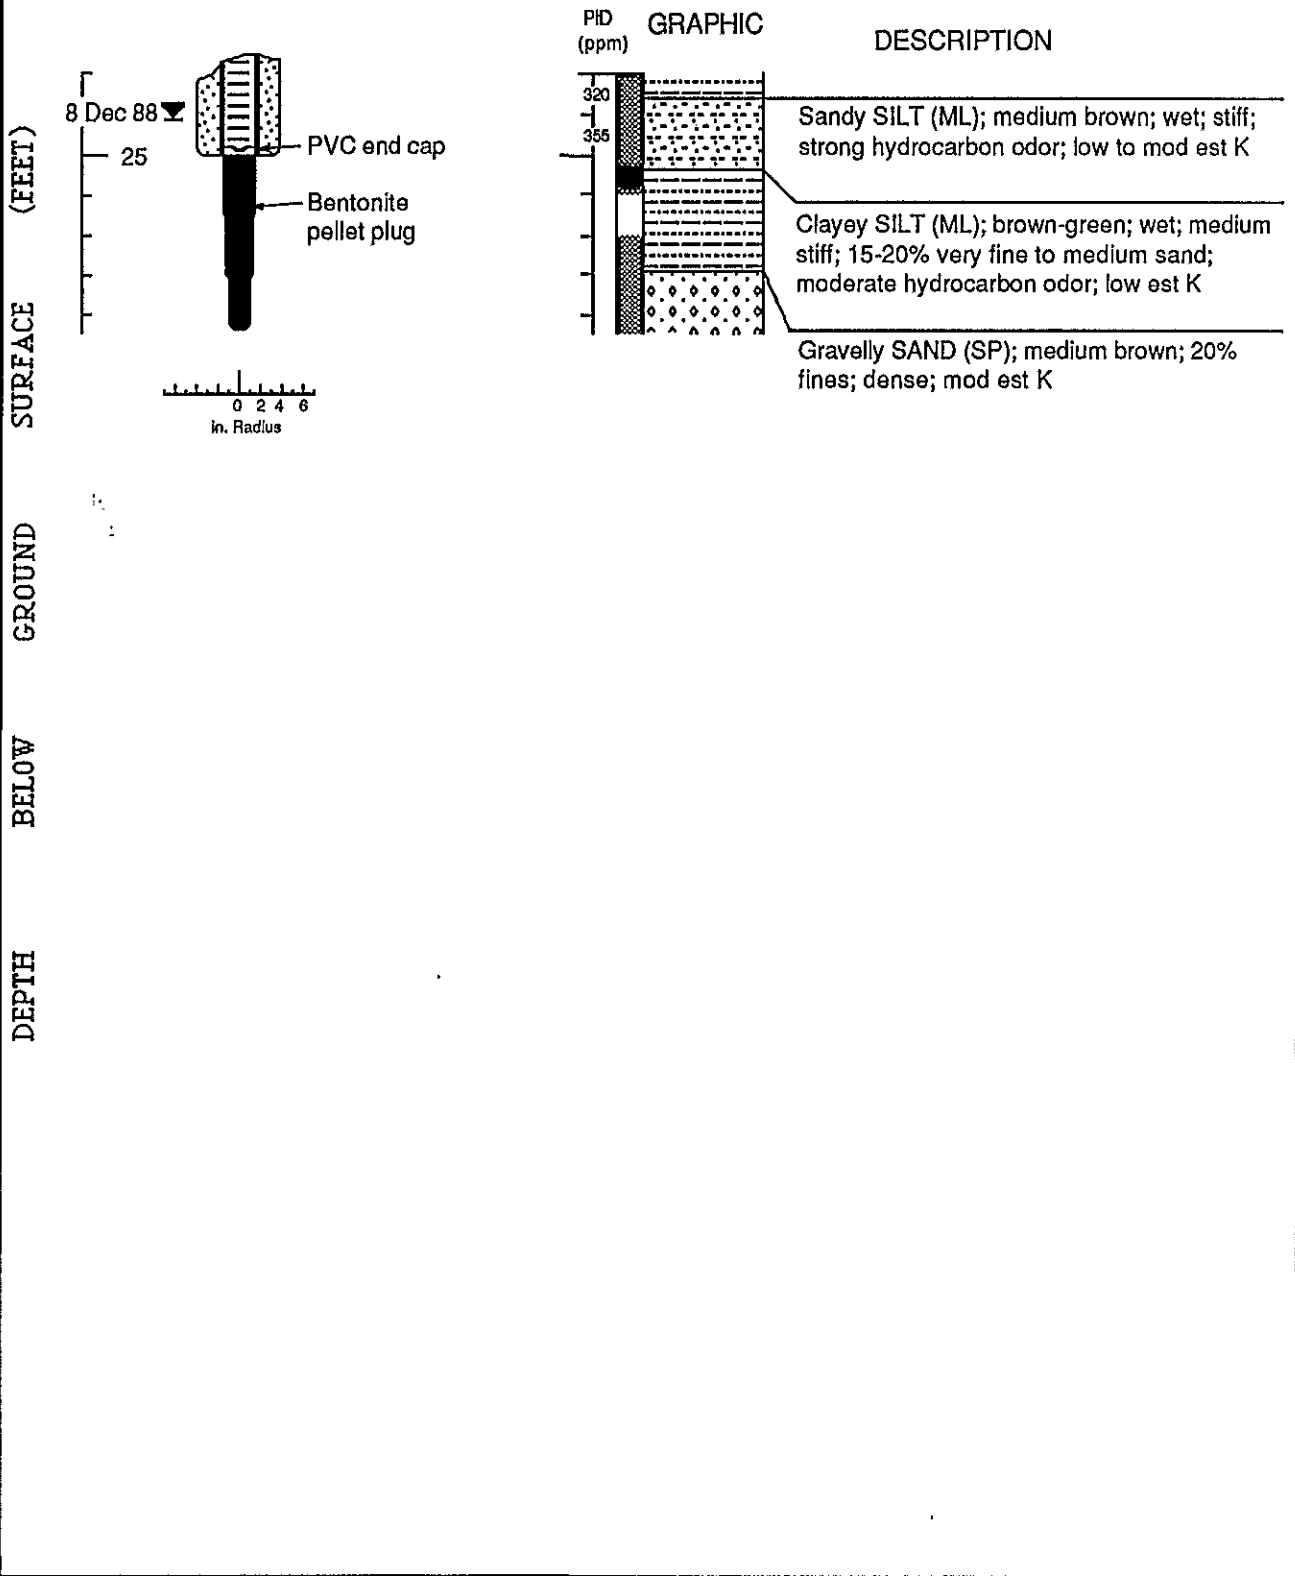

Well Construction and Boring Log - Well MW-5 (BH-E)


Chevron Service Station #92258
Oakland, California

LOG OF TEST BORING 1

EQUIPMENT 7" Hollow Stem Auger

DATE DRILLED 4/21/89

ELEVATION TOC: 100.18'*

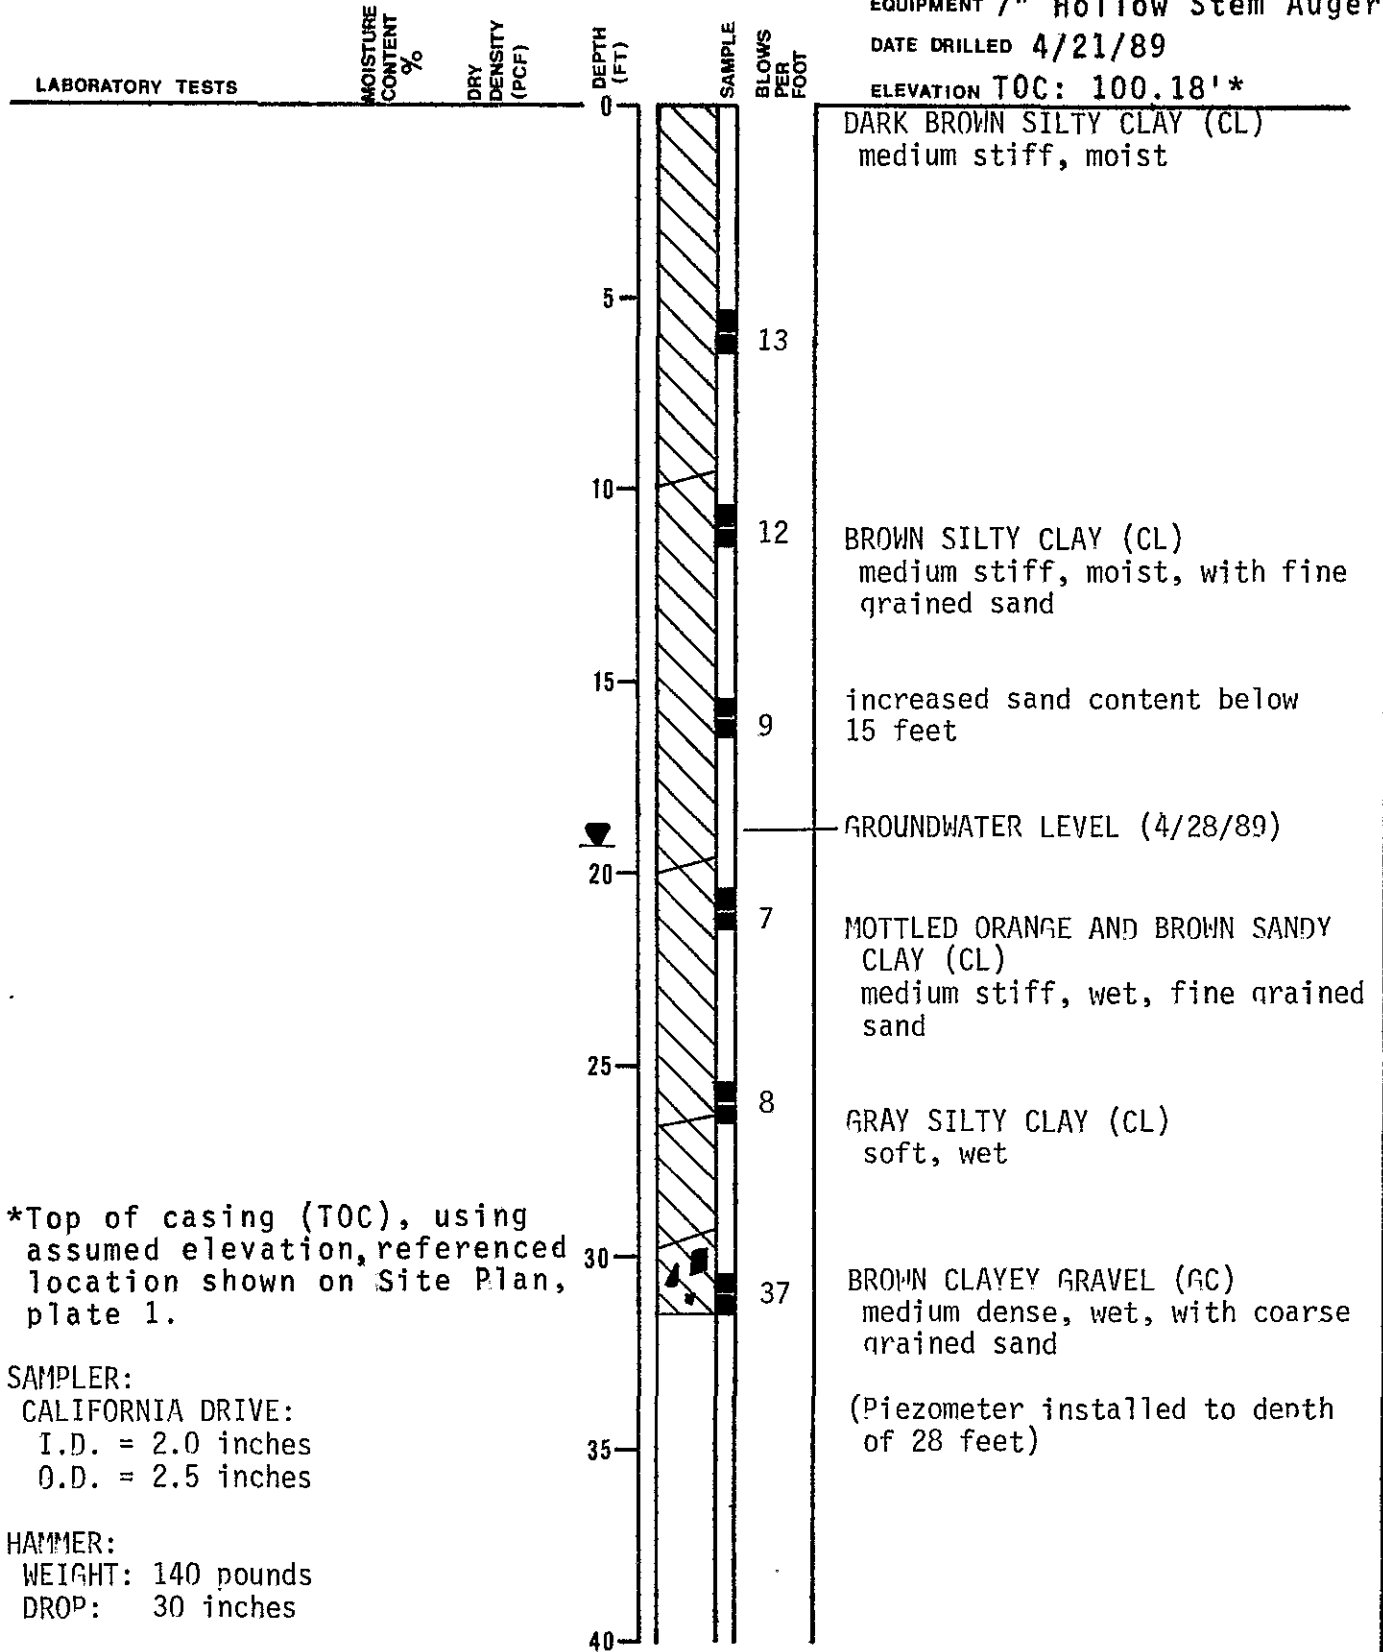

*Top of casing (TOC), using assumed elevation, referenced location shown on Site Plan, plate 1.

SAMPLER:
CALIFORNIA DRIVE:
I.D. = 2.0 inches
O.D. = 2.5 inches

HAMMER:
WEIGHT: 140 pounds
DROP: 30 inches

Subsurface Consultants

FIRE STATION 19 - OAKLAND, CA

JOB NUMBER
272.010

DATE
5/4/89

APPROVED
William L. Hinkle


PLATE

2

01-434N Inv/Addr 15/4LW 13G-7

LOG OF TEST BORING 2

EQUIPMENT 7" Hollow Stem Auger
 DATE DRILLED 4/21/89
 ELEVATION TOC: 100.86'

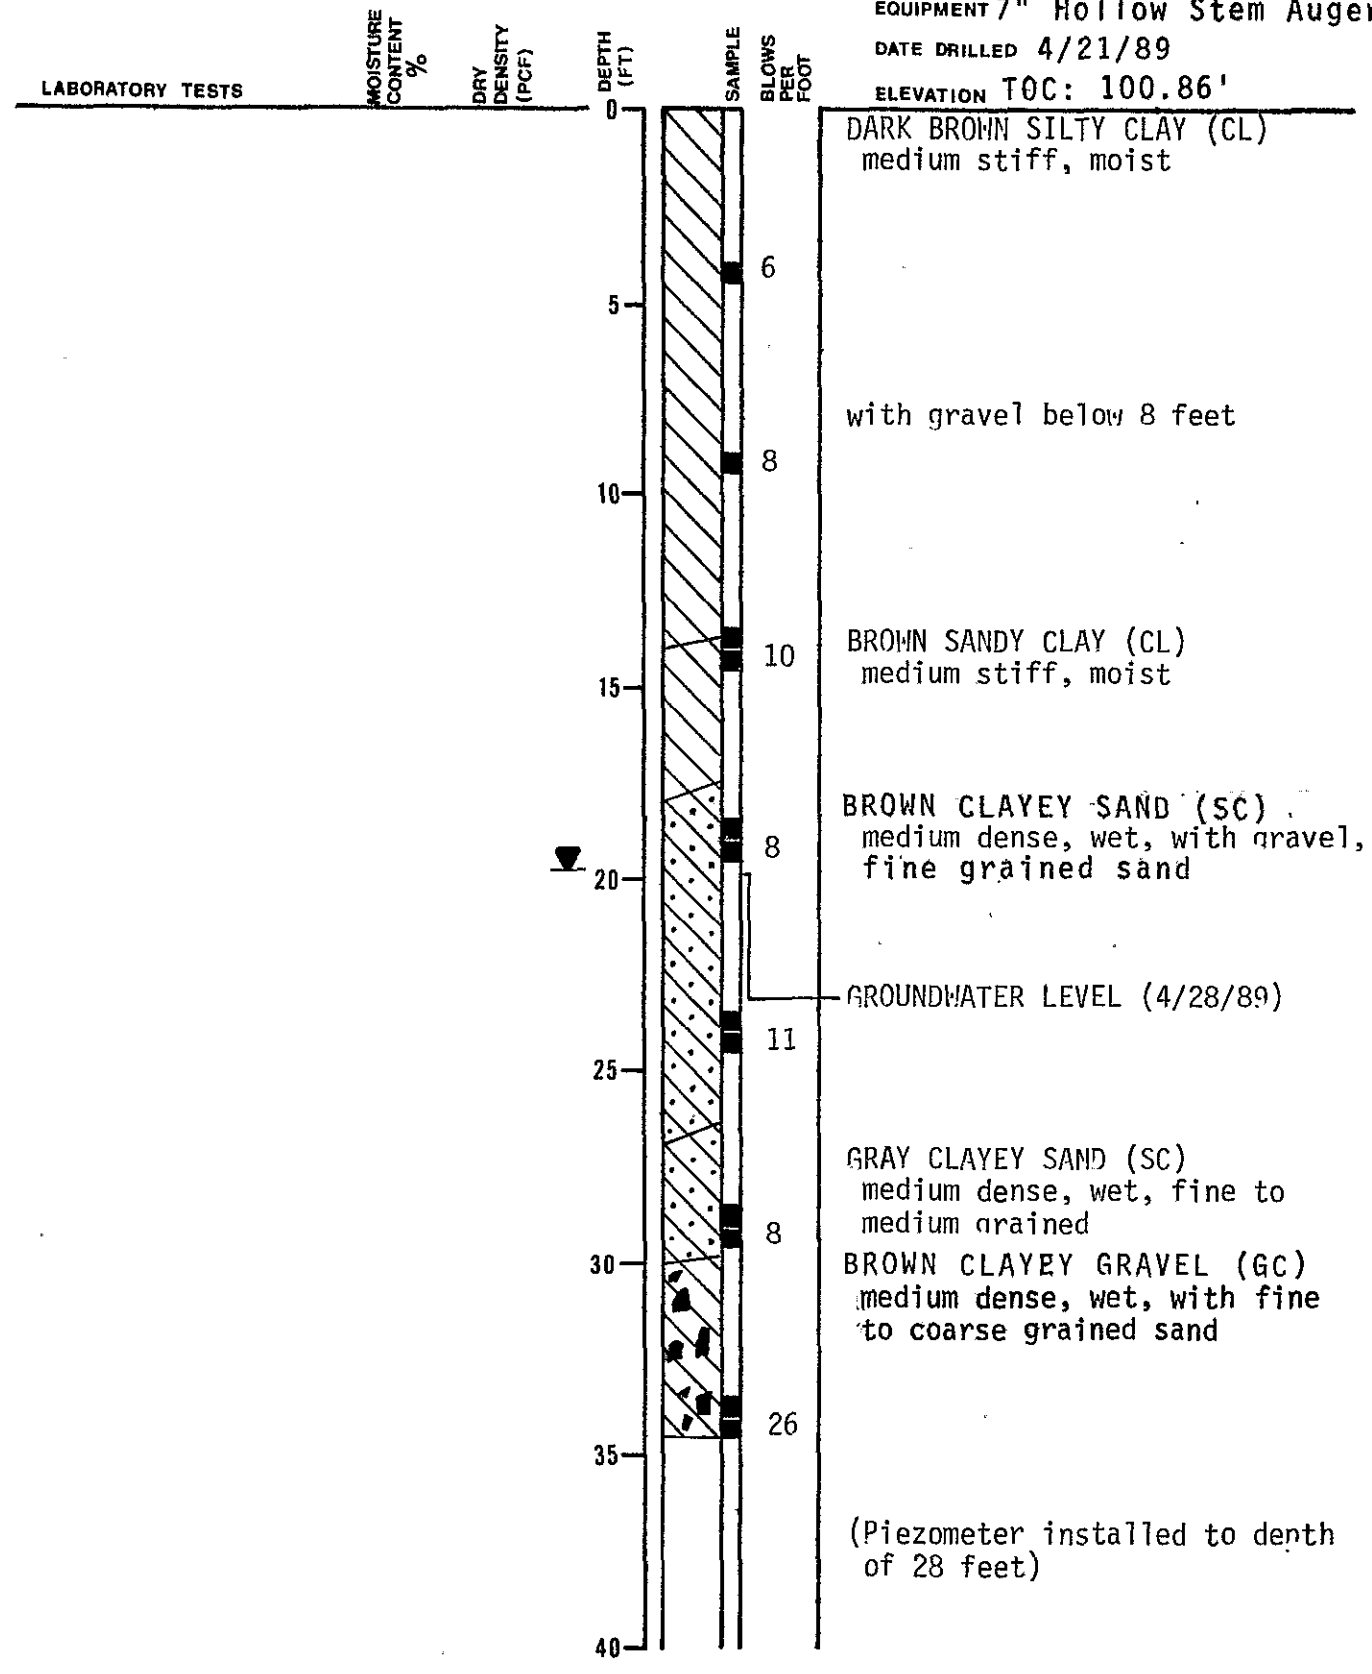


Subsurface Consultants

FIRE STATION 19 - OAKLAND, CA
 JOB NUMBER 272.010
 DATE 5/4/89
 APPROVED *[Signature]*

PLATE
3

LOG OF TEST BORING 3

EQUIPMENT 7" Hollow Stem Auger
 DATE DRILLED 4/21/89
 ELEVATION TOC: 99.03'

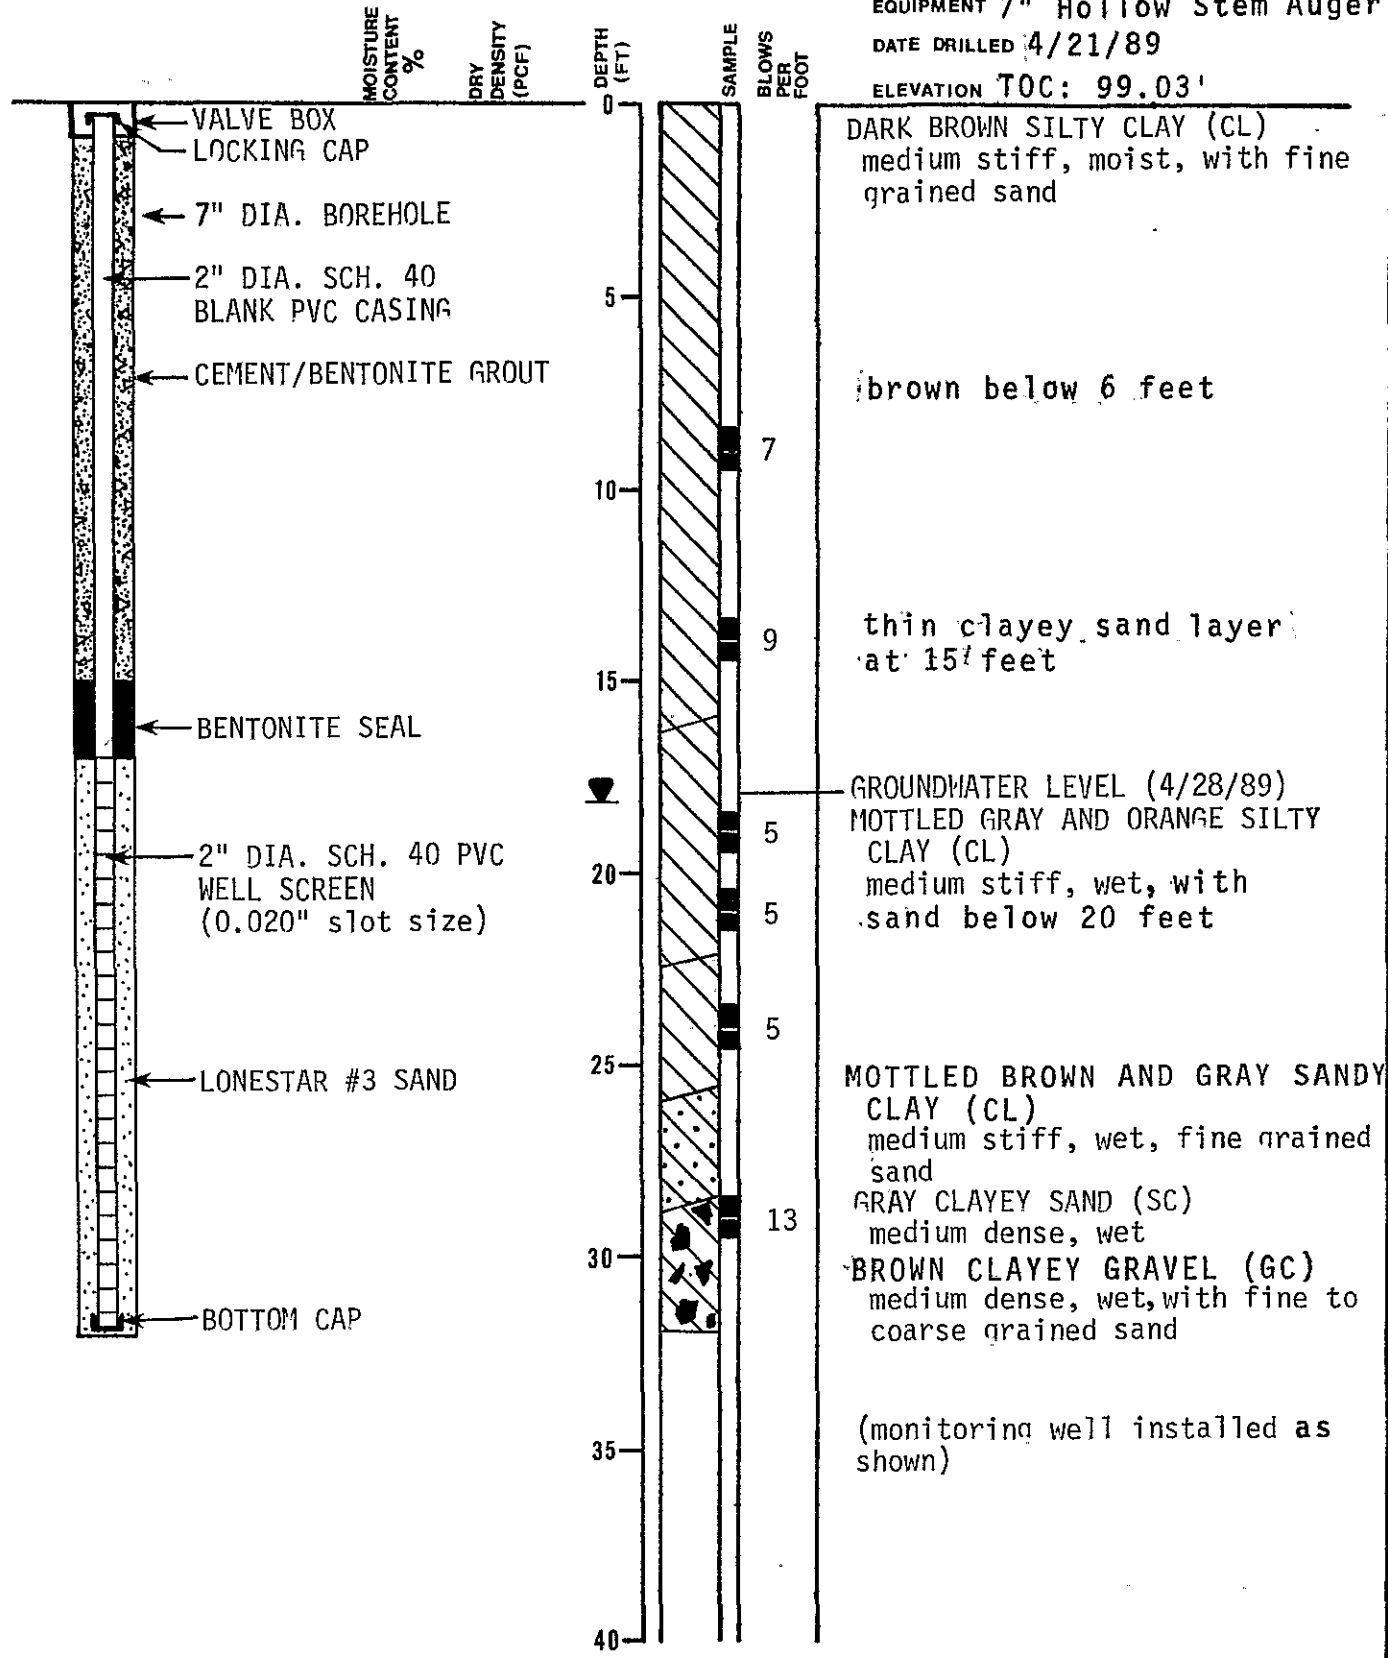

Subsurface Consultants

FIRESTATION 19 - OAKLAND, CA
 JOB NUMBER 272.010
 DATE 5/4/89
 APPROVED *[Signature]*

PLATE
4

81.10'

81.05'

81.00'

80.95'

80.90'

80.85'

80.80'

2

1

3

PAVED PARKING AREA


DRIVEWAY

FIRE STATION

DRIVEWAY




APPROXIMATE SCALE (feet)

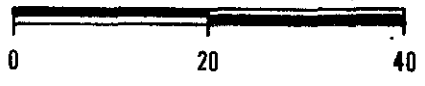

89249

C57 Lic.# C57-522125

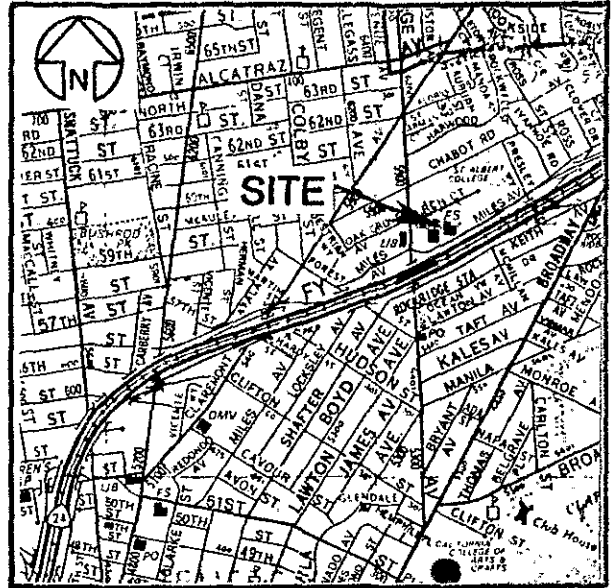

VICINITY MAP

MILES AVENUE

ELEVATION REFERENCE
TOP OF CURB
ASSUMED AT 100.00 FEET

	PIEZOMETER
	MONITORING WELL
	PROPERTY LINE
	GROUNDWATER ELEVATION CONTOURS (FEET) (4/28/89).
	APPROXIMATE PREVIOUS UNDERGROUND TANK LOCATION

SITE SKETCH

Subsurface Consultants

FIRE STATION 19 - OAKLAND, CA

PLATE

JGB NUMBER
272.010

DATE
4/15/89

APPROVED

1

CONFIDENTIAL

STATE OF CALIFORNIA DWR
WELL COMPLETION REPORT
(WELL LOGS)

REMOVED





 
 



 


Figure 2. Monitoring and Extraction Well Locations - Chevron Service Station #92258, 5800 College Avenue, Oakland, California

WELL MW-6 (BH-F)

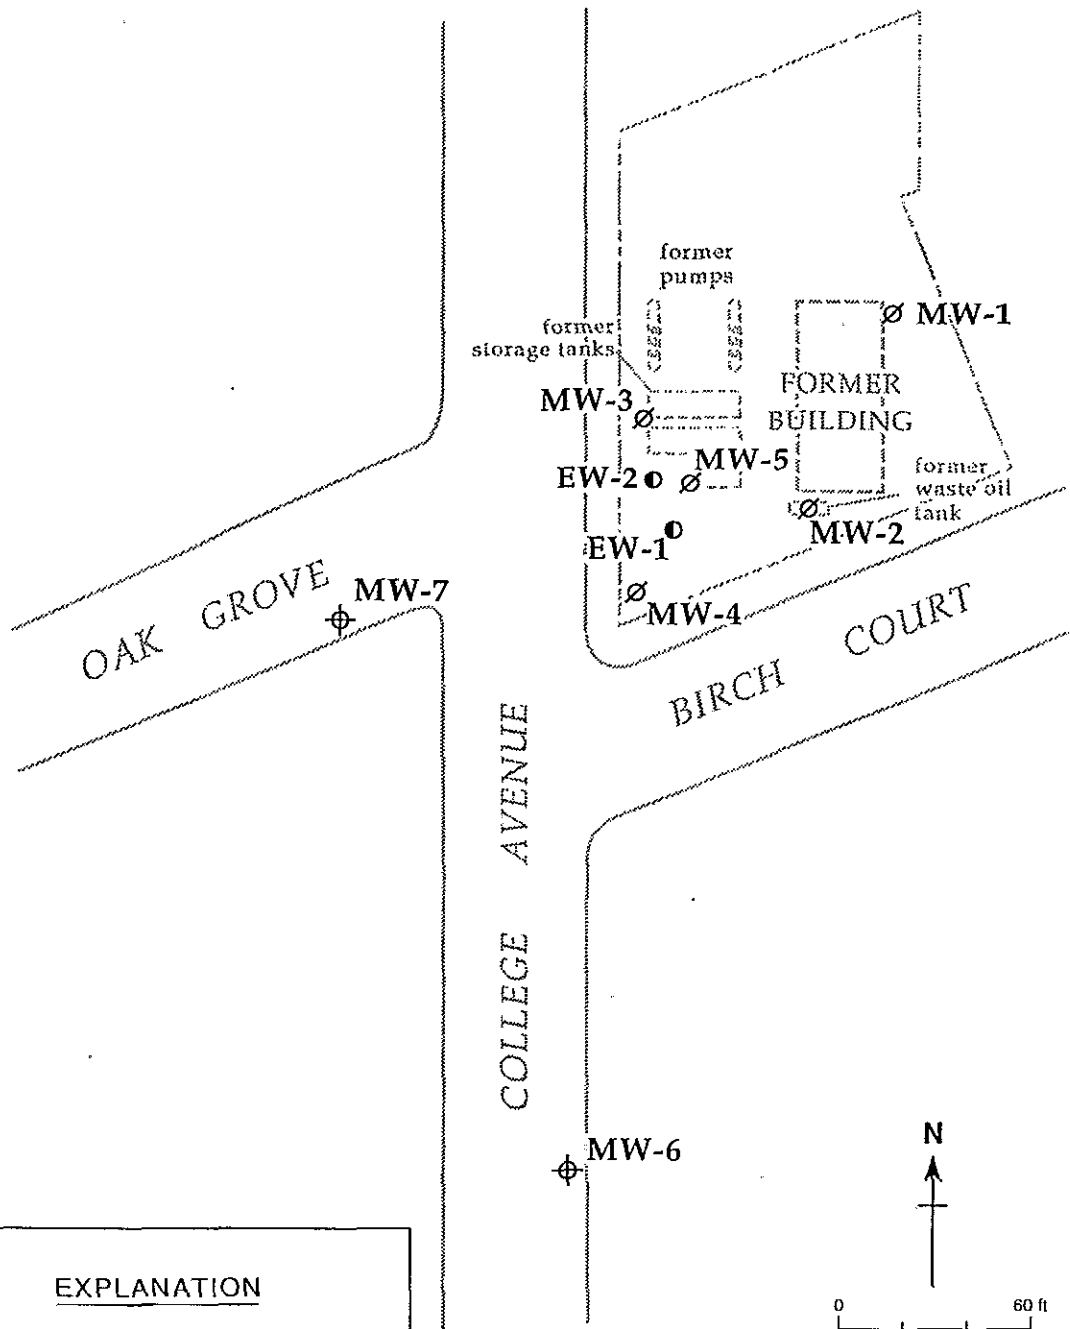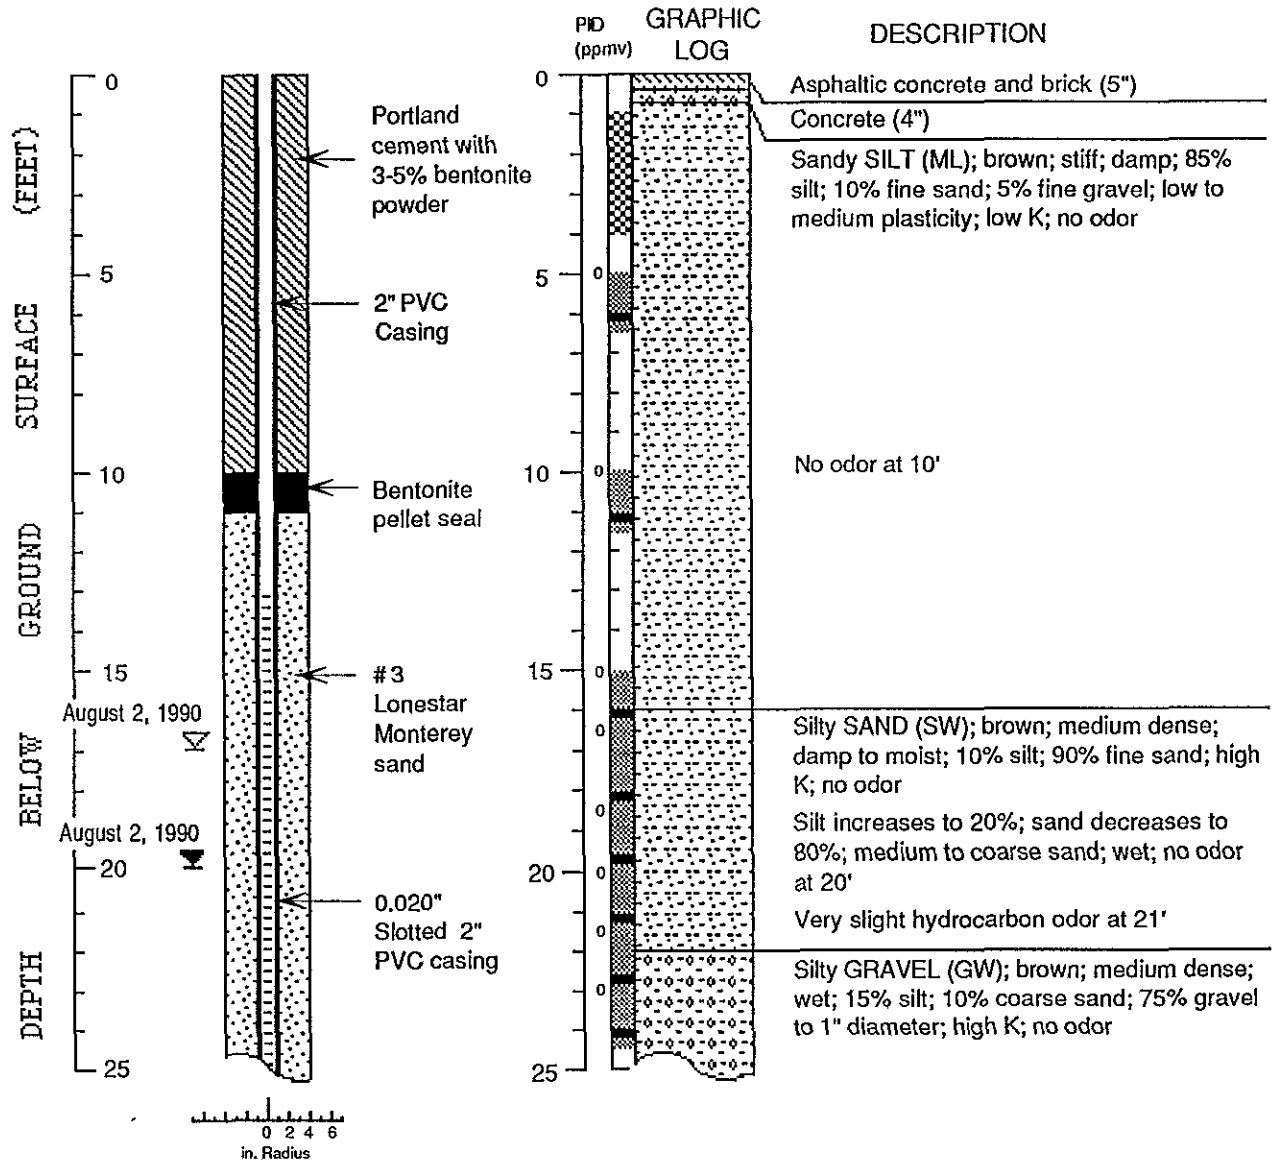

EXPLANATION

-  Water level during drilling (date)
-  Water level (date)
-  Contact (dotted where approx.)
-  Uncertain contact
-  Location of recovered drive sample
-  Location of drive sample sealed for chemical analysis
-  Cutting sample
-  K = Estimated hydraulic conductivity


Logged by: Robert Kitay
 Supervisor: Richard Weiss; EG 1112
 Drilling Company: Soils Exploration Services, Vacaville, CA
 Driller: Russ Ellis
 Drilling Method: Hollow-stem auger
 Date Drilled: August 2, 1990
 Well Head Completion: 4" Locking well-plug, traffic-rated vault
 Type of sampler: Split barrel (1.5", 2.0", 2.5" ID)
 Ground Surface Elevation: 179.04 feet above mean sea level

Well Construction and Boring Log - Well MW-6 (BH-F)

Chevron Service Station #92258
Oakland, California




WELL MW-6 (BH-F) (cont.)

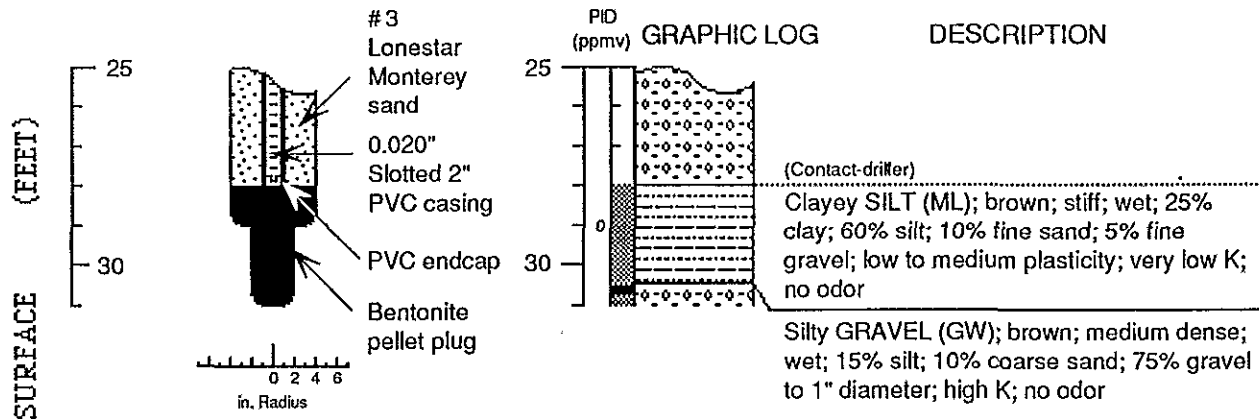



WELL MW-7 (BH-G)

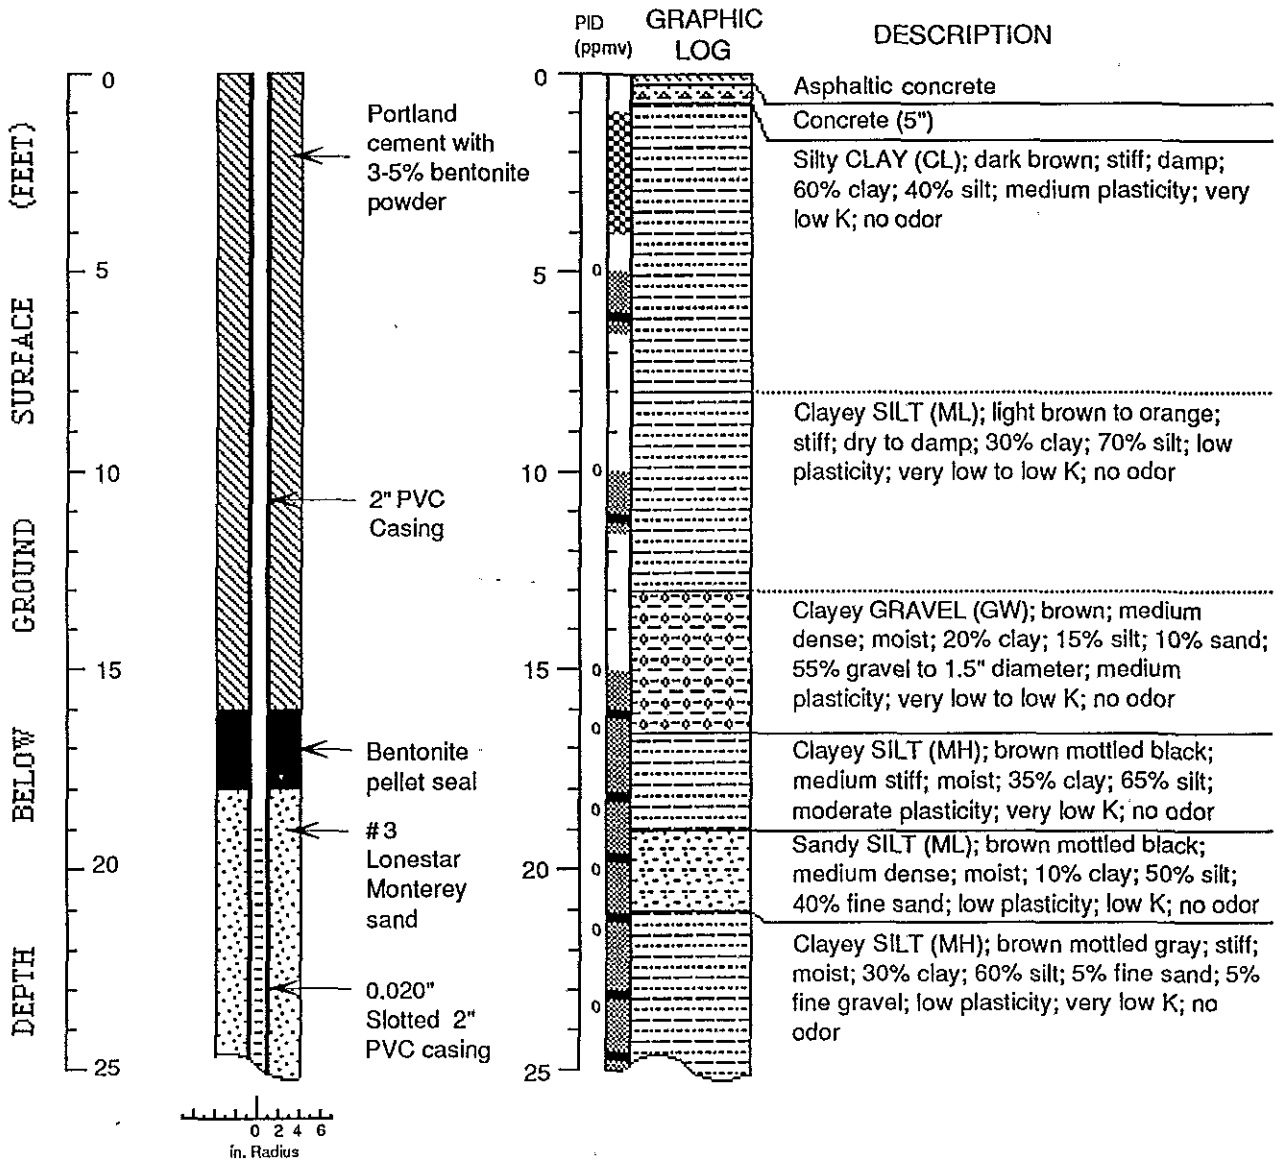

EXPLANATION


- Water level during drilling (date)
- Water level (date)
- Contact (dotted where approx.)
- Uncertain contact
- Location of recovered drive sample
- Location of drive sample sealed for chemical analysis
- Cutting sample
- K = Estimated hydraulic conductivity

Logged by: Robert Kitay
 Supervisor: Richard Weiss; EG 1112
 Drilling Company: Soils Exploration Services, Vacaville, CA
 Driller: Russ Ellis
 Drilling Method: Hollow-stem auger
 Date Drilled: August 3, 1990
 Well Head Completion: 4" Locking well-plug, traffic-rated vault
 Type of sampler: Split barrel (1.5", 2.0", 2.5" ID)
 Ground Surface Elevation: 180.53 feet above mean sea level

Well Construction and Boring Log - Well MW-7 (BH-G) Chevron Service Station #92258
Oakland, California



WELL MW-7 (BH-G) (cont.)

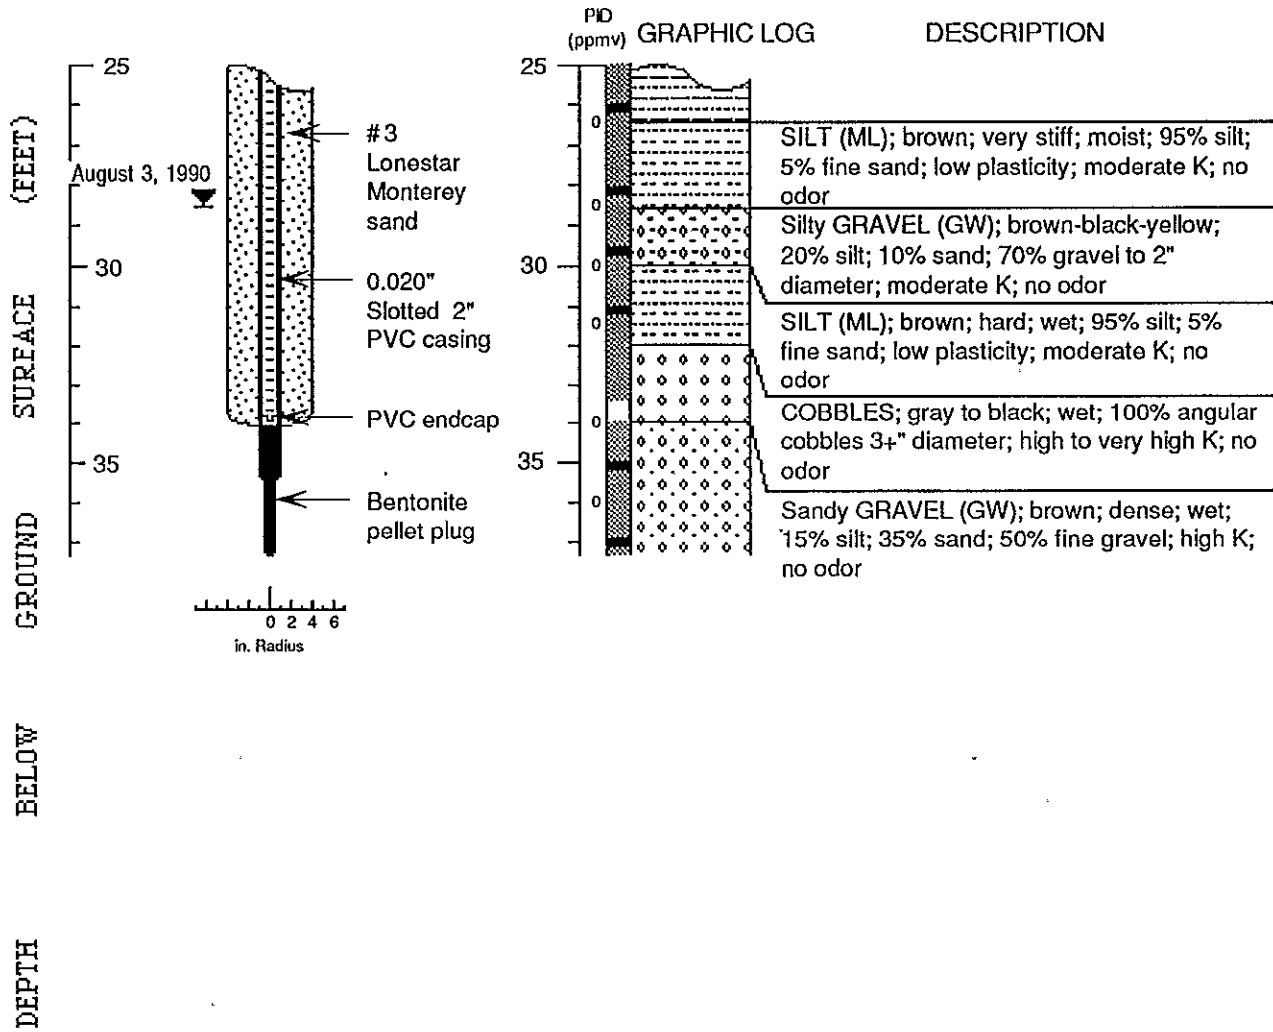


Well Construction and Boring Log - Well MW-7 (BH-G) Chevron Service Station #92258
Oakland, California

CONFIDENTIAL

STATE OF CALIFORNIA DWR
WELL COMPLETION REPORT
(WELL LOGS)

REMOVED

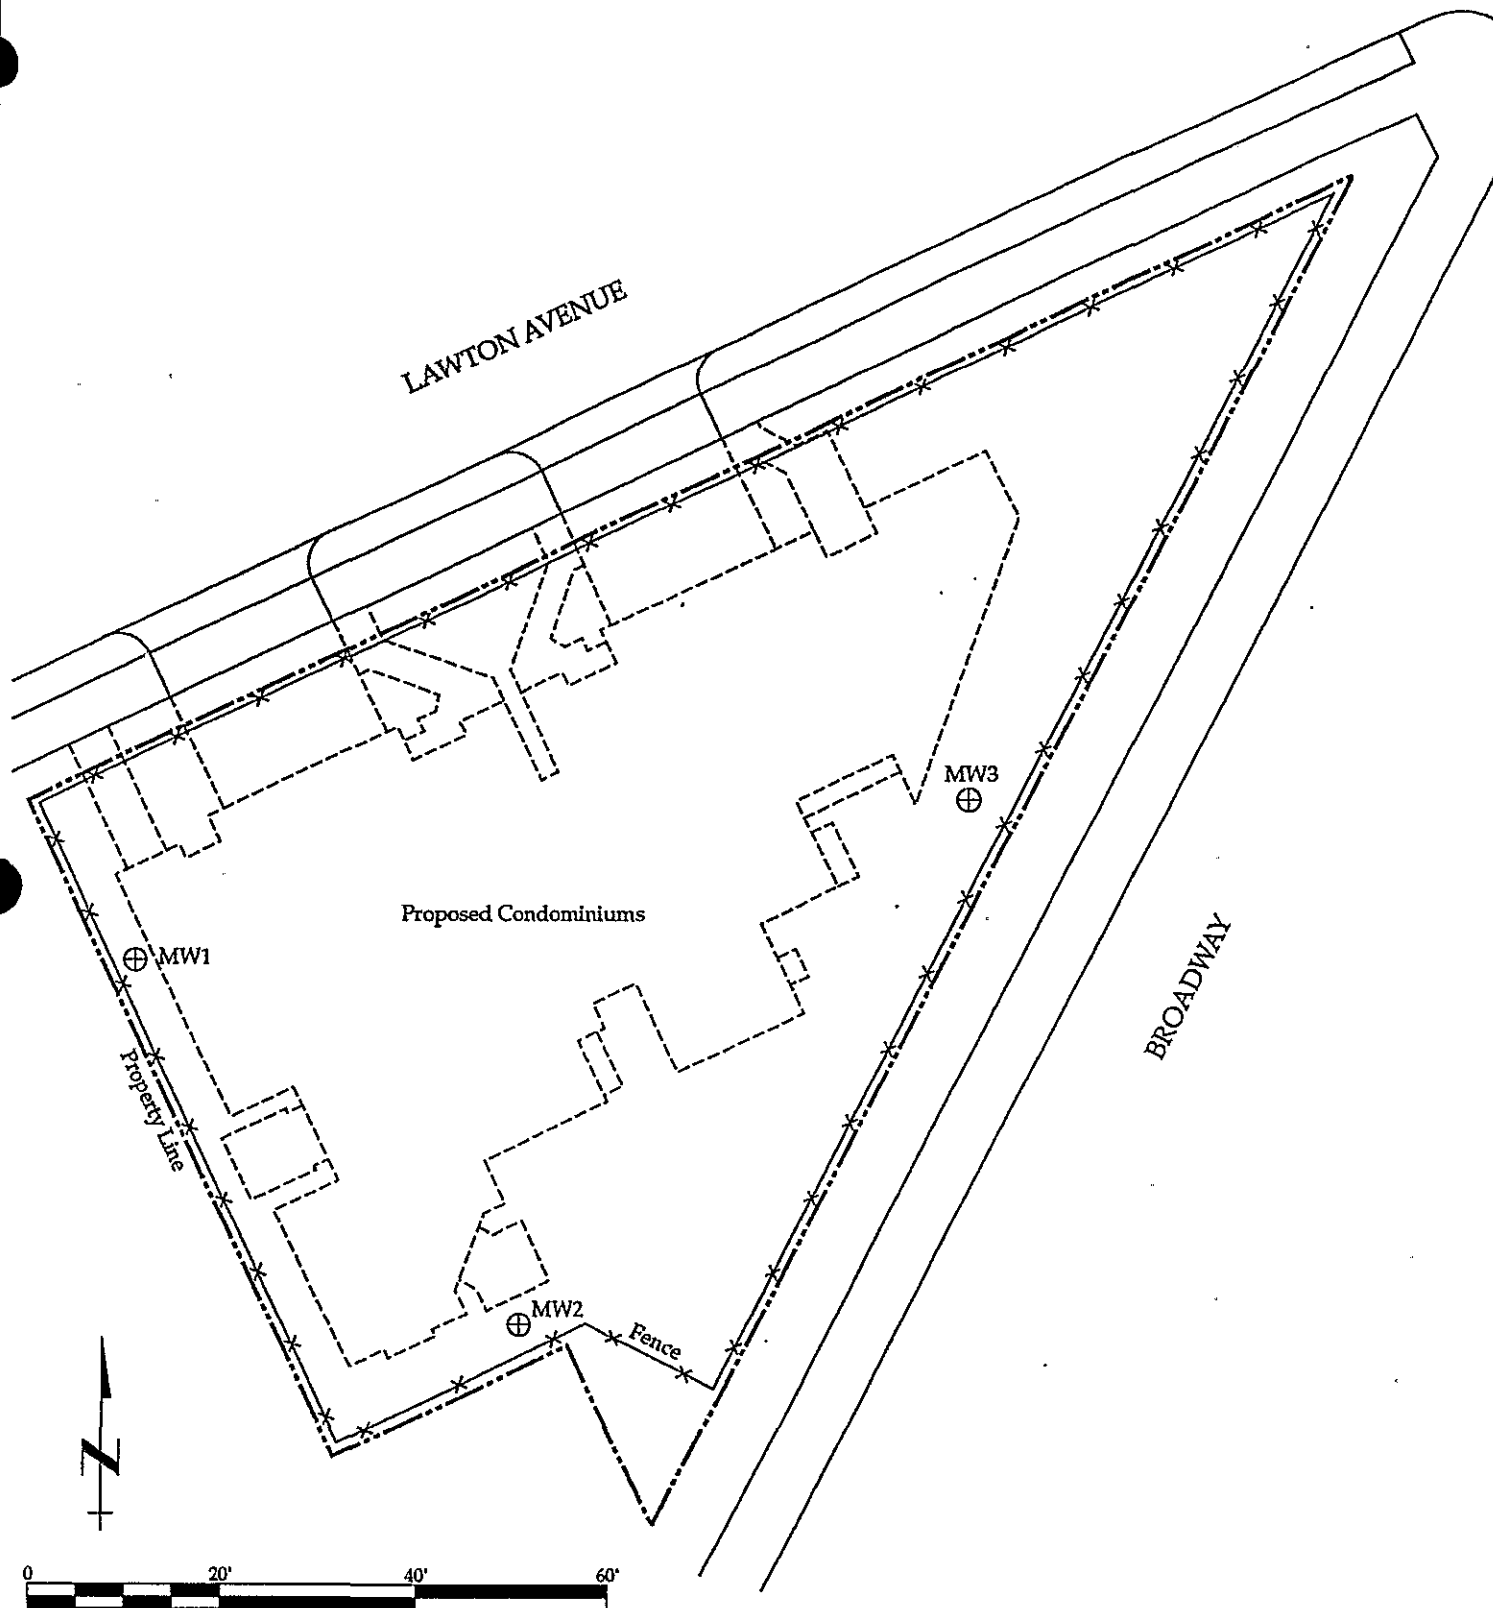

8/92

EXPLANATION

⊕ MW-3 Proposed Monitor Well location

Site Location Map

Former Chevron Service Station #9-3575
5775 Broadway
Oakland, California

FIGURE

2




17046.01

CONFIDENTIAL

STATE OF CALIFORNIA DWR
WELL COMPLETION REPORT
(WELL LOGS)

REMOVED

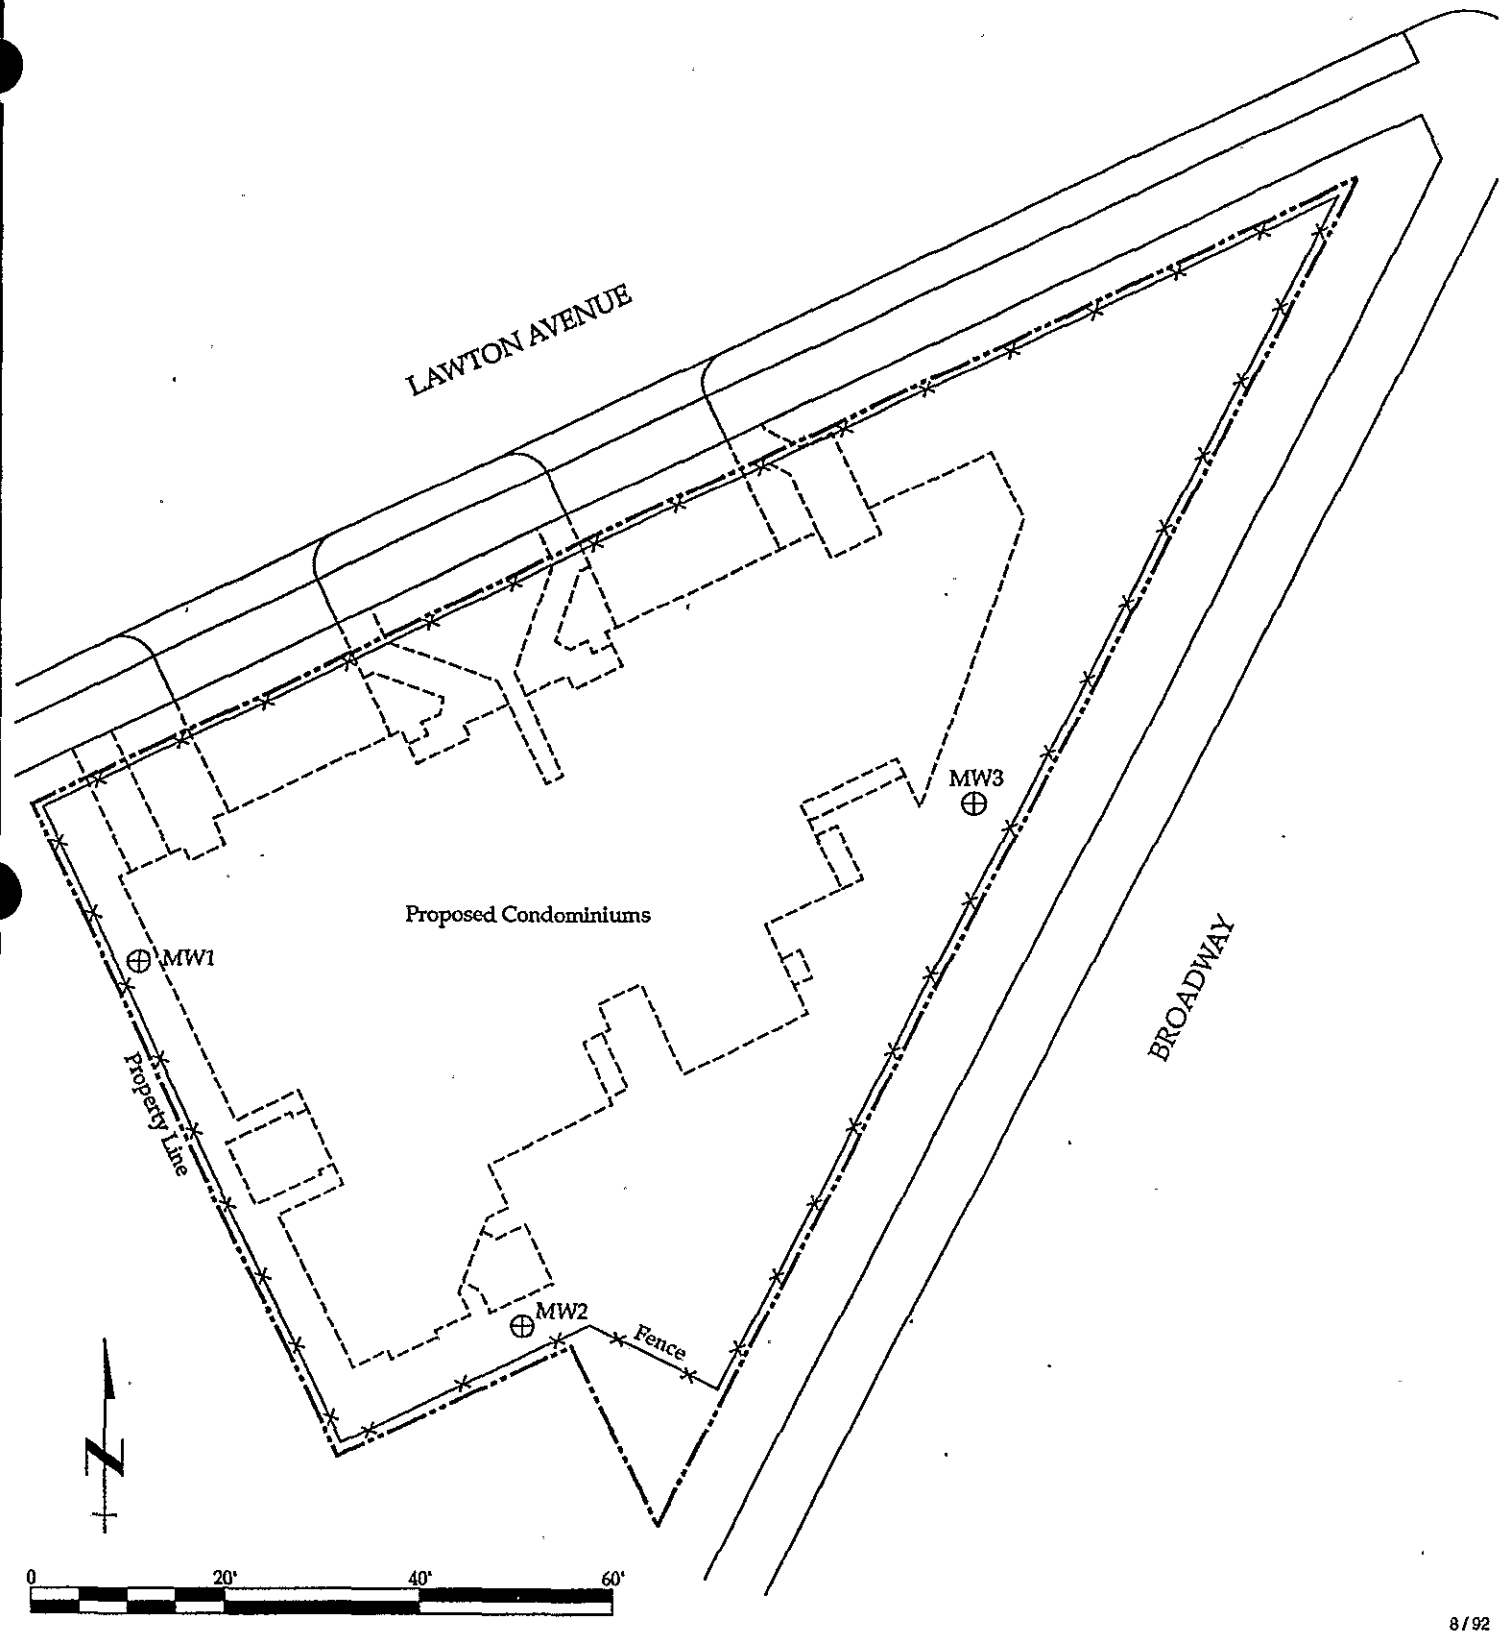

EXPLANATION

⊕ MW-3 Proposed Monitor Well location

Site Location Map
 Former Chevron Service Station #9-3575
 5775 Broadway
 Oakland, California

FIGURE
2


CONFIDENTIAL

STATE OF CALIFORNIA DWR
WELL COMPLETION REPORT
(WELL LOGS)

REMOVED

367293

~~15/4W 134418/410 134456~~

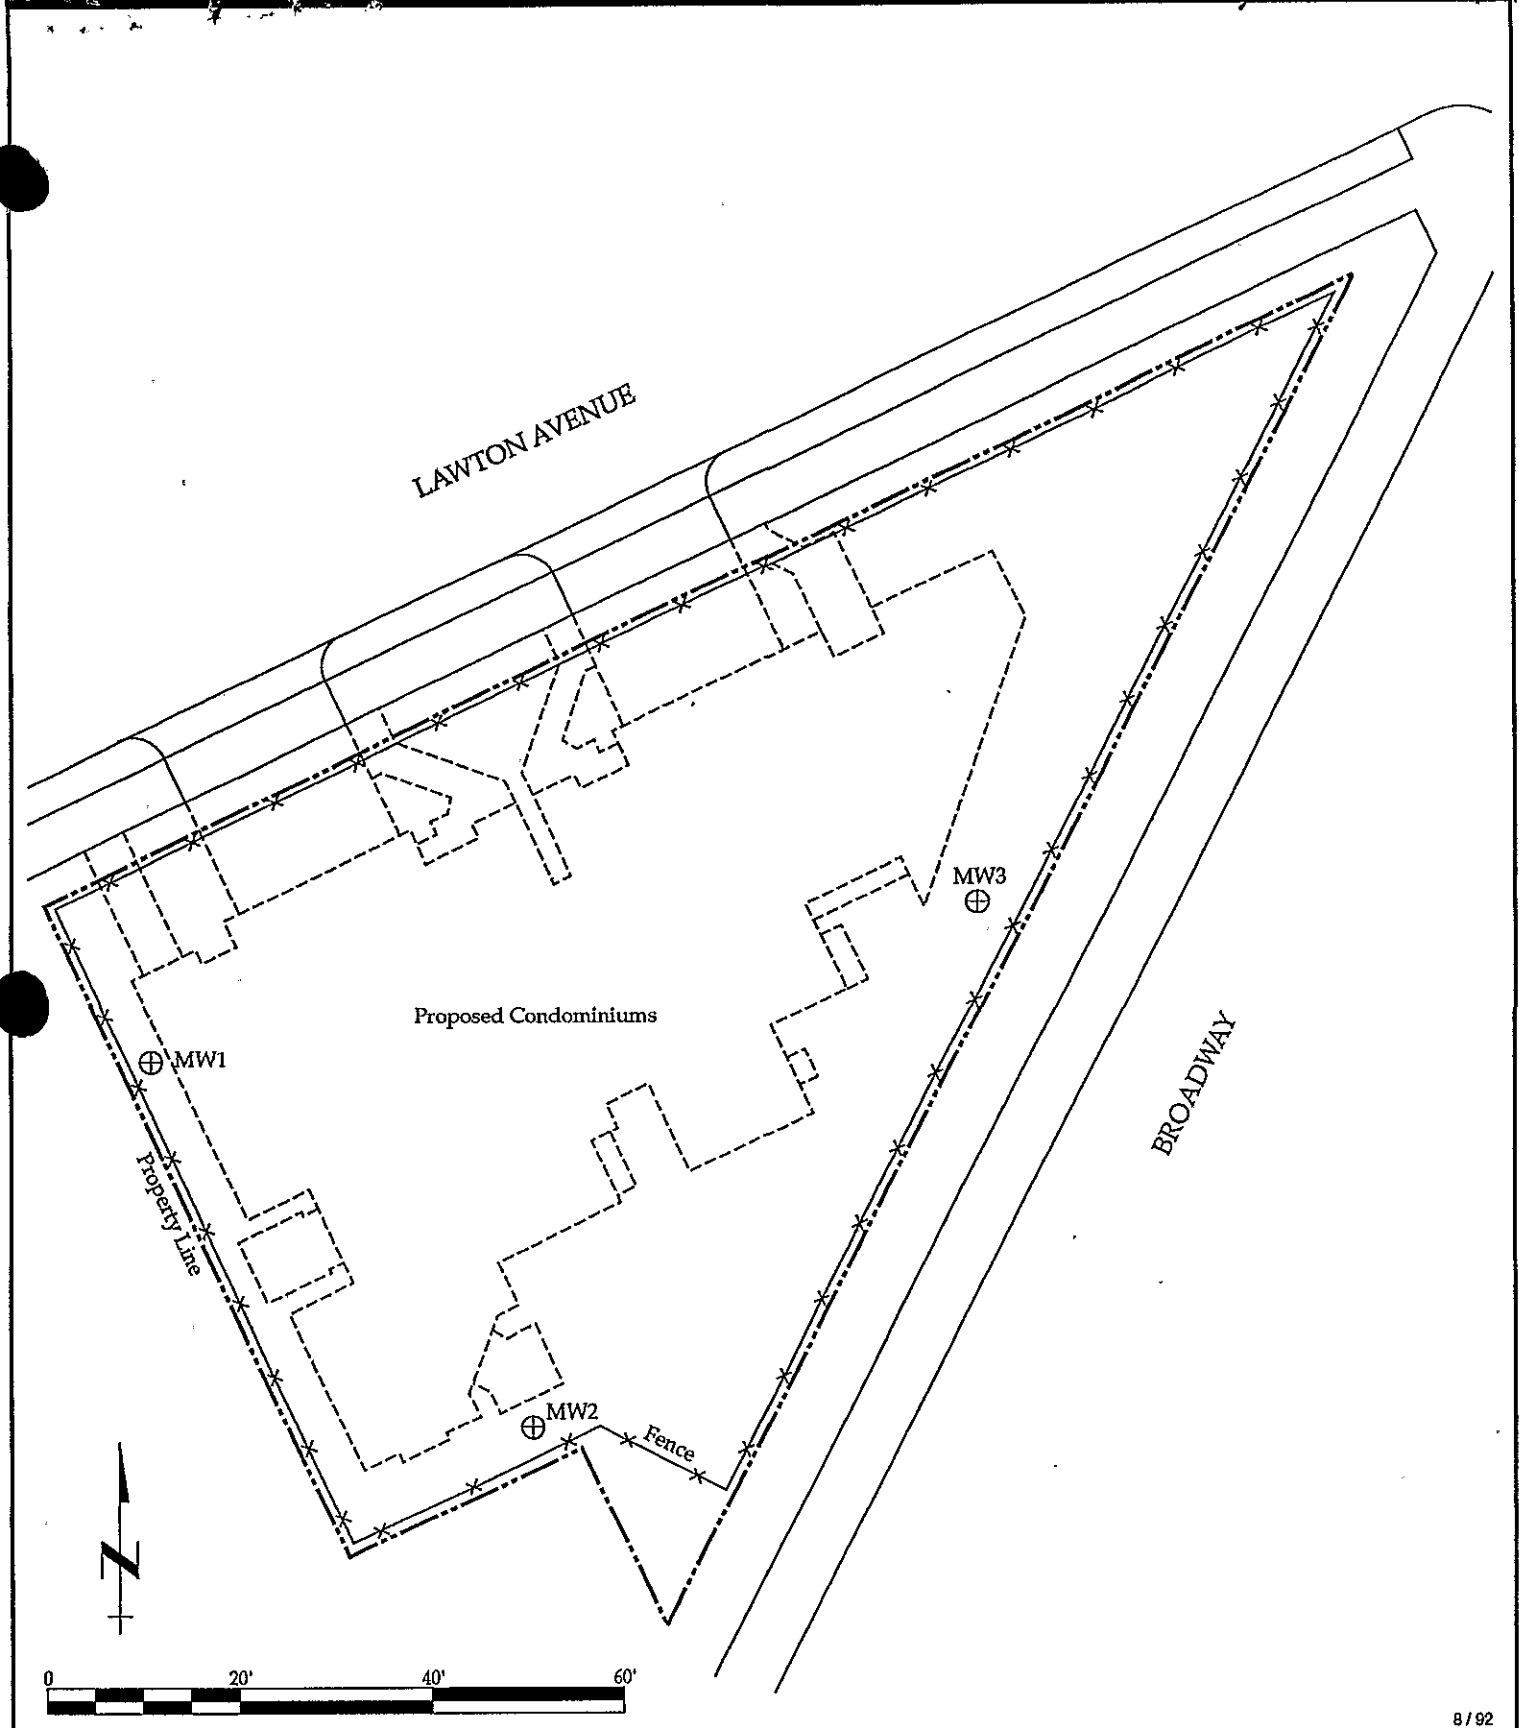

8/92

EXPLANATION

⊕ MW-3 Proposed Monitor Well location

Site Location Map

Former Chevron Service Station #9-3575
5775 Broadway
Oakland, California

FIGURE

2



17046.01

CONFIDENTIAL

STATE OF CALIFORNIA DWR
WELL COMPLETION REPORT
(WELL LOGS)

REMOVED

CONFIDENTIAL

STATE OF CALIFORNIA DWR
WELL COMPLETION REPORT
(WELL LOGS)

REMOVED

CONFIDENTIAL

STATE OF CALIFORNIA DWR
WELL COMPLETION REPORT
(WELL LOGS)

REMOVED

CONFIDENTIAL

STATE OF CALIFORNIA DWR
WELL COMPLETION REPORT
(WELL LOGS)

REMOVED

CONFIDENTIAL

**STATE OF CALIFORNIA DWR
WELL COMPLETION REPORT
(WELL LOGS)**

REMOVED

CONFIDENTIAL

STATE OF CALIFORNIA DWR
WELL COMPLETION REPORT
(WELL LOGS)

REMOVED

CONFIDENTIAL

STATE OF CALIFORNIA DWR
WELL COMPLETION REPORT
(WELL LOGS)

REMOVED

CONFIDENTIAL


STATE OF CALIFORNIA DWR
WELL COMPLETION REPORT
(WELL LOGS)

REMOVED

WELL LOCATION SKETCH

12019


SECTION 13M80
TOWNSHIP 1 N
RANGE 4 E

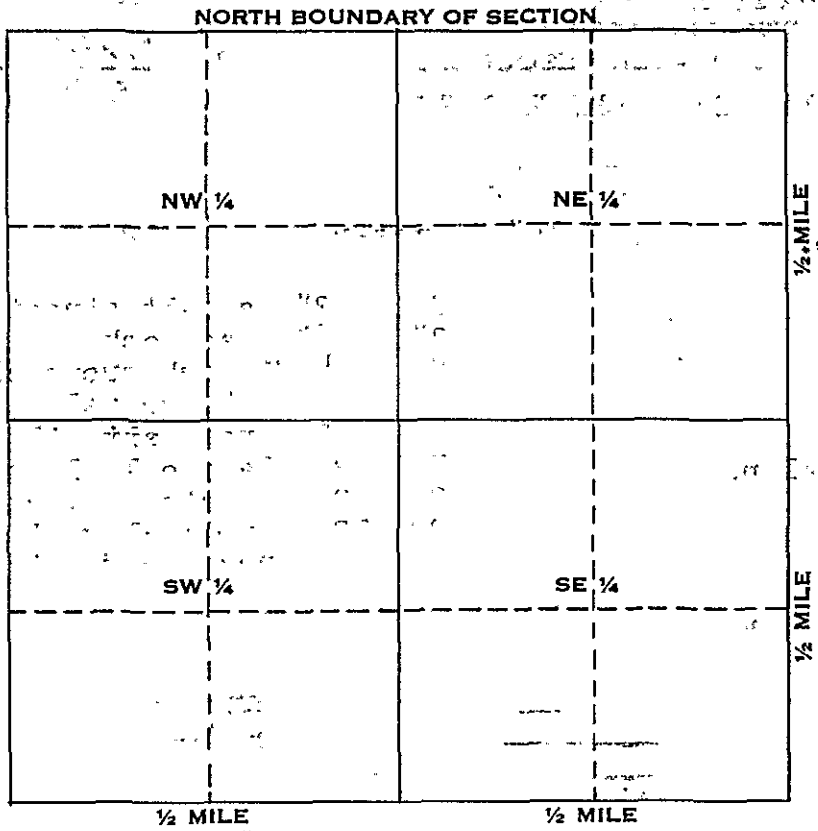

Township 1 N (S)
Range 4 E (W)
Section No. 13 M 80


A. Location of well in sectionized areas.
Sketch roads, railroads, streams, or other features as necessary.

SKETCH
No scale
ACFC & WCD

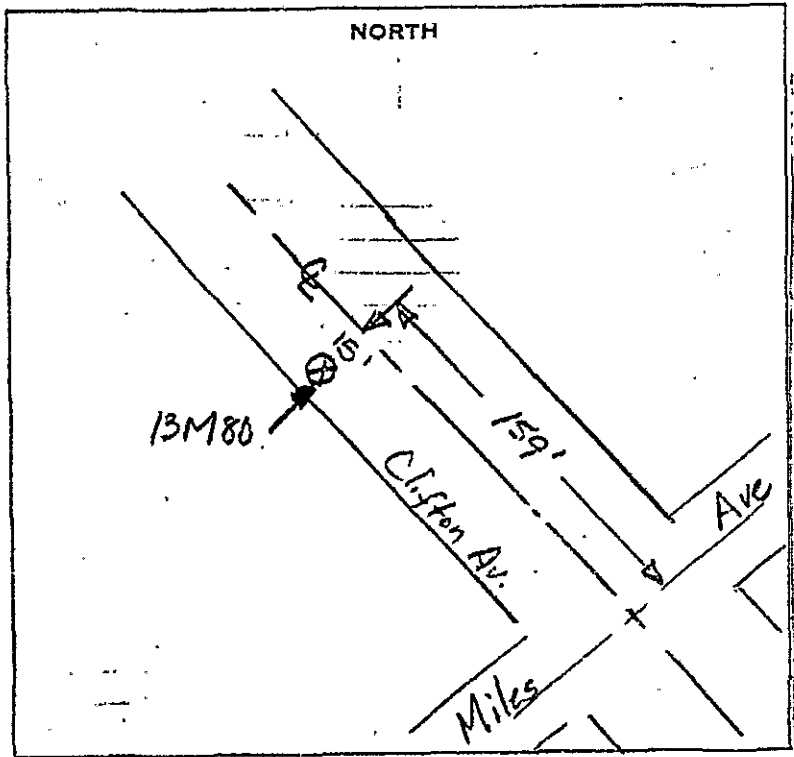


1976 SEP 2 PM 1 31

DEPT. OF WATER
RESOURCES

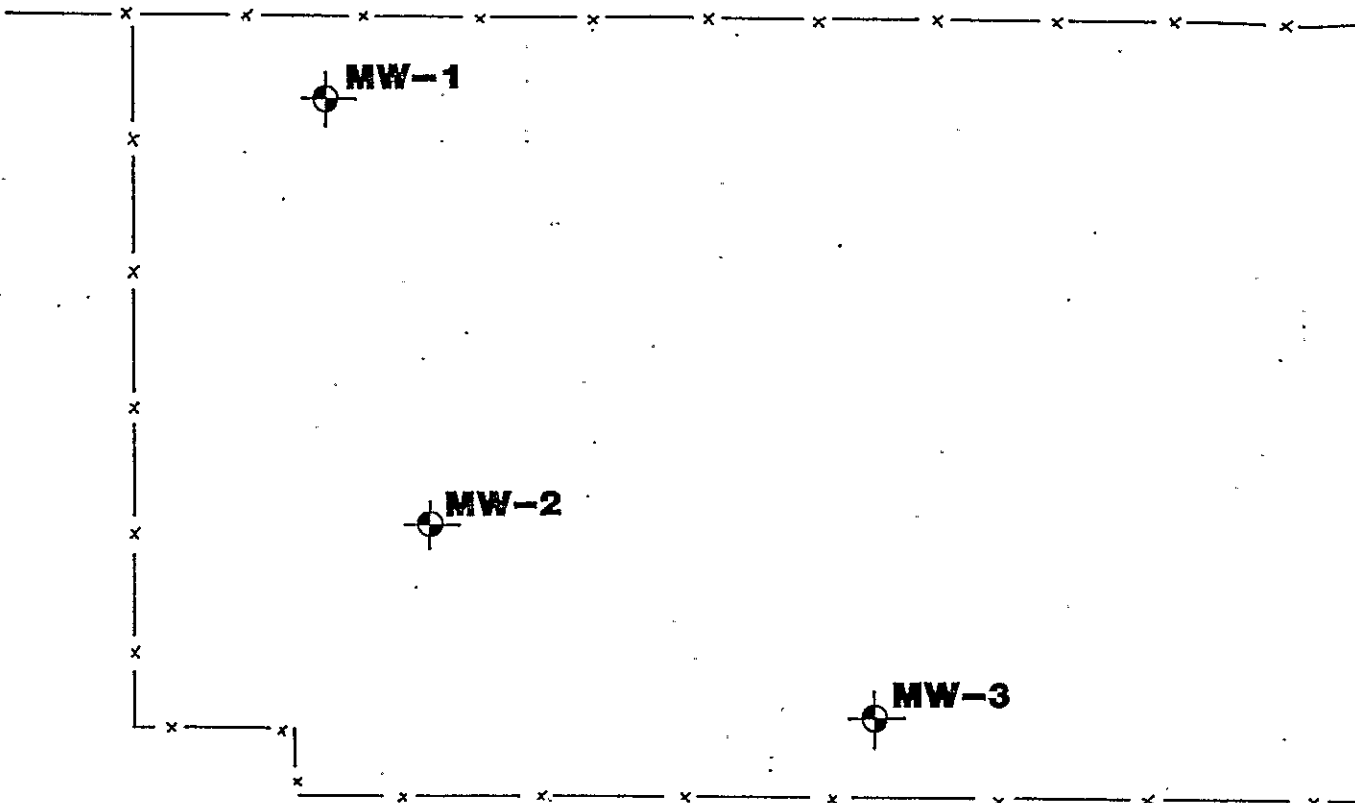

VICINITY MAP

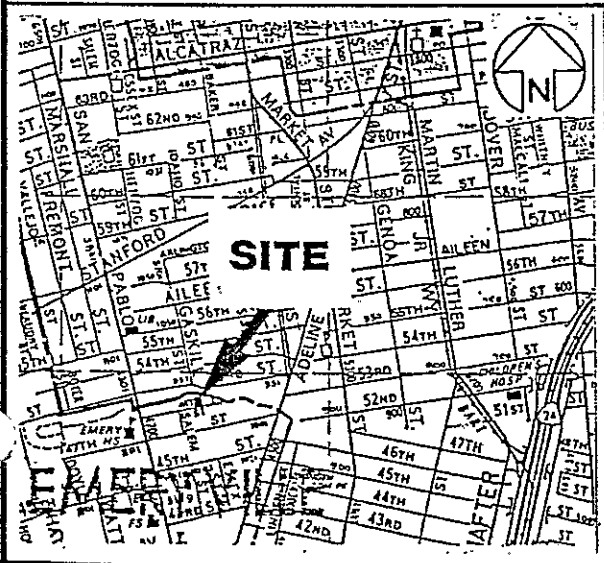

01-539K-Z

01804W 14 N01-03

X 14N01
Y 14N02
Z 14N03

ADJACENT RESIDENCE

SIDEWALK

48TH STREET

ADJACENT RESIDENCE



MONITORING WELL



FENCE



APPROXIMATE SCALE (feet)



SITE PLAN

Subsurface Consultants

1056 48TH STREET - EMERYVILLE, CA

PLATE

JOB NUMBER
537.006

DATE
10/28/92

APPROVED
MMW

1

01-539K-B

ZONE 7 WATER AGENCY

5997 PARKSIDE DRIVE

PLEASANTON, CALIFORNIA 94588

VOICE (510) 424-2600

FAX (510) 462-3914



DRILLING PERMIT APPLICATION

FOR APPLICANT TO COMPLETE

FOR OFFICE USE

LOCATION OF PROJECT 1056 48th Street
Emeryville, CA

PERMIT NUMBER 92529
LOCATION NUMBER 1S/4W 15R80 to 15R82

CLIENT
Name City of Emeryville
Address 2300 Powell St, 12th Floor Phone 510-435-0
City Emeryville Zip 94608

PERMIT CONDITIONS

Circled Permit Requirements Apply

APPLICANT
Name Marianne Watada
Subsurface Consultants, Inc.
Address 171-12th St #201 Phone 268-0461
City Oakland Zip 94607

A. GENERAL

1. A permit application should be submitted so as to arrive at the Zone 7 office five days prior to proposed starting date.
2. Submit to Zone 7 within 60 days after completion of permitted work the original Department of Water Resources Water Well Drillers Report or equivalent for well projects, or drilling logs and location sketch for geotechnical projects.
3. Permit is void if project not begun within 90 days of approval date.

TYPE OF PROJECT

Well Construction	_____	Geotechnical Investigation	_____
Shed Protection	_____	General	_____
Water Supply	_____	Contamination	_____
Monitoring	_____	Well Destruction	<u>X</u>

B. WATER WELLS, INCLUDING PIEZOMETERS

1. Minimum surface seal thickness is two inches of cement grout placed by tremie.
2. Minimum seal depth is 50 feet for municipal and industrial well or 20 feet for domestic and irrigation wells unless a lesser depth is specially approved. Minimum seal depth for monitoring wells is the maximum depth practicable or 20 feet.

PROPOSED WATER SUPPLY WELL USE

Domestic	_____	Industrial	_____	Other	<u>monitoring</u>
Municipal	_____	Irrigation	_____		

C. GEOTECHNICAL. Backfill bore hole with compacted cuttings or heavy bentonite and upper two feet with compacted material. In areas of known or suspected contamination, tremie cement grout shall be used in place of compacted cuttings.

DRILLING METHOD:

Mud Rotary _____ Air Rotary _____ Auger X
Cable _____ Other _____

D. CATHODIC. Fill hole above anode zone with concrete placed by tremie.

DRILLER'S LICENSE NO. _____

E. WELL DESTRUCTION. See attached.

Each well will be drilled out. The casing, seal and gravel pack will be removed. The resulting holes will be backfill with neat cement using tremie methods.

WELL PROJECTS

Drill Hole Diameter	<u>8</u> in.	Maximum Depth	<u>28</u> ft.
Casing Diameter	<u>2</u> in.	Number	<u>3</u>
Surface Seal Depth	<u>14</u> ft.		

GEOTECHNICAL PROJECTS

Number of Borings	_____	Maximum Depth	_____ ft.
Hole Diameter	_____ in.		

ESTIMATED STARTING DATE 10/27/92
ESTIMATED COMPLETION DATE 10/27/92

Approved Wyman Hong Date 23 Oct
Wyman Hong

I hereby agree to comply with all requirements of this permit and Alameda County Ordinance No. 79-88.

APPLICANT'S SIGNATURE Marianne Watada Date 10/22/92

CONFIDENTIAL

STATE OF CALIFORNIA DWR
WELL COMPLETION REPORT
(WELL LOGS)

REMOVED

15/4W 1301-3




KAPREALIAN ENGINEERING, INC.

Consulting Engineers


380348A-C



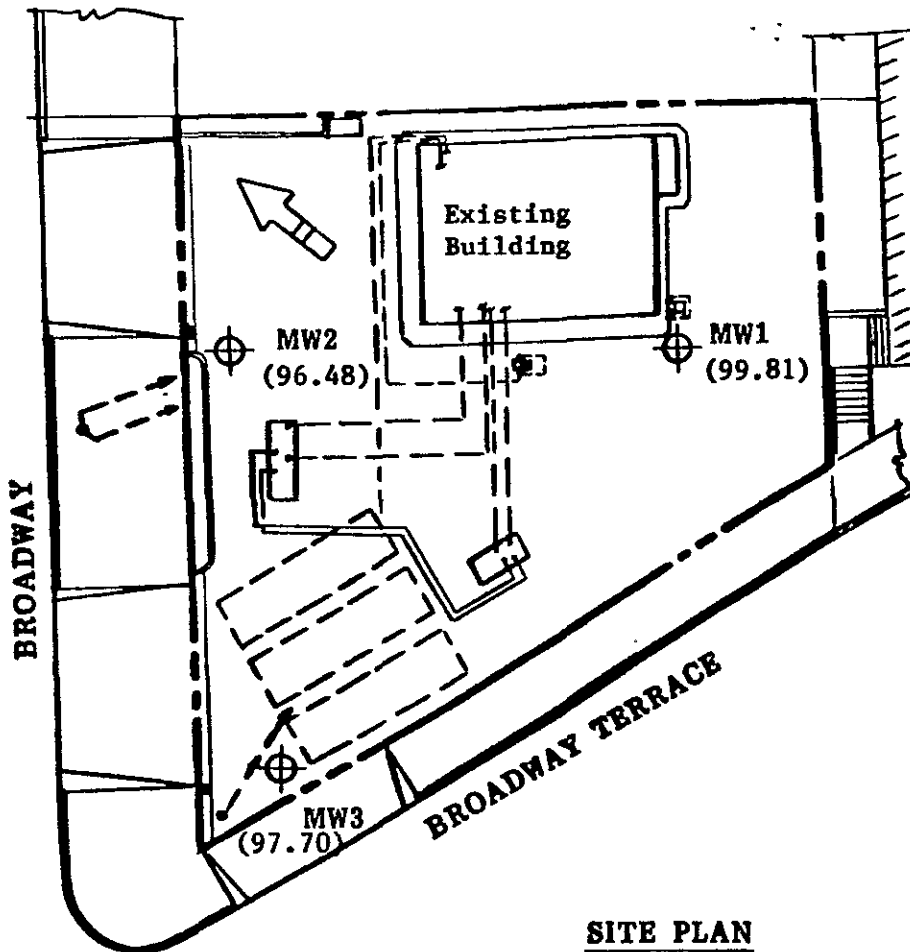

P.O. BOX 996 • BENICIA, CA 94510
(707) 746-6915 • (707) 746-6916 • FAX: (707) 746-5581

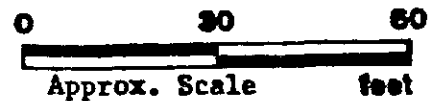

SITE PLAN

LEGEND



-  Monitoring Well
-  Ground Water Elevation in feet on 4/23/90.
-  Top of MW3 Well Cover assumed 100.00 feet as datum.
-  Ground Water Flow Direction

Unocal Service Station #1028
5300 Broadway
Oakland, California

15/401391

BORING LOG

380348A

Project No. KEI-P89-1111		Boring & Casing Diameter 9" 2"		Logged By D.L. <i>Don Brown</i>	
Project Name Unocal Oakland-5300 Broadway		Well Head Elevation N/A		Date Drilled 4/6/90	
Boring No. MW1		Drilling Method Hollow-stem Auger		Drilling Company EGI	

Penetration blows/6"	G. W. level	Depth (ft) Samples	Strati- graphy USCS	Description
		0		A. C. Pavement
			N/A	BEDROCK - FRANCISCAN COMPLEX Shale, locally silty, hard, weathered, fractured, dry, olive gray and olive brown, dark reddish brown in some fractures.
50-5 1/2		5		Shale Bedrock, hard, moist to dry, weathered, locally decomposed and clayey, olive brown and strong brown.
41/46/50 5 1/2"				
	▼	10		Shale, as above, moist to wet, locally sheared.
26/50-5"				
50-2"		15		Shale, as above, olive gray, fractured less weathered than above, hardness increasing with depth.
		20		
				TOTAL DEPTH: 15'

15/44/391

380348A


WELL COMPLETION DIAGRAM

PROJECT NAME: Unocal - Oakland - 5300 Broadway BORING/WELL NO. MW1

PROJECT NUMBER: KEI-P89-1111

WELL PERMIT NO.: 90154

Flush-mounted Well Cover

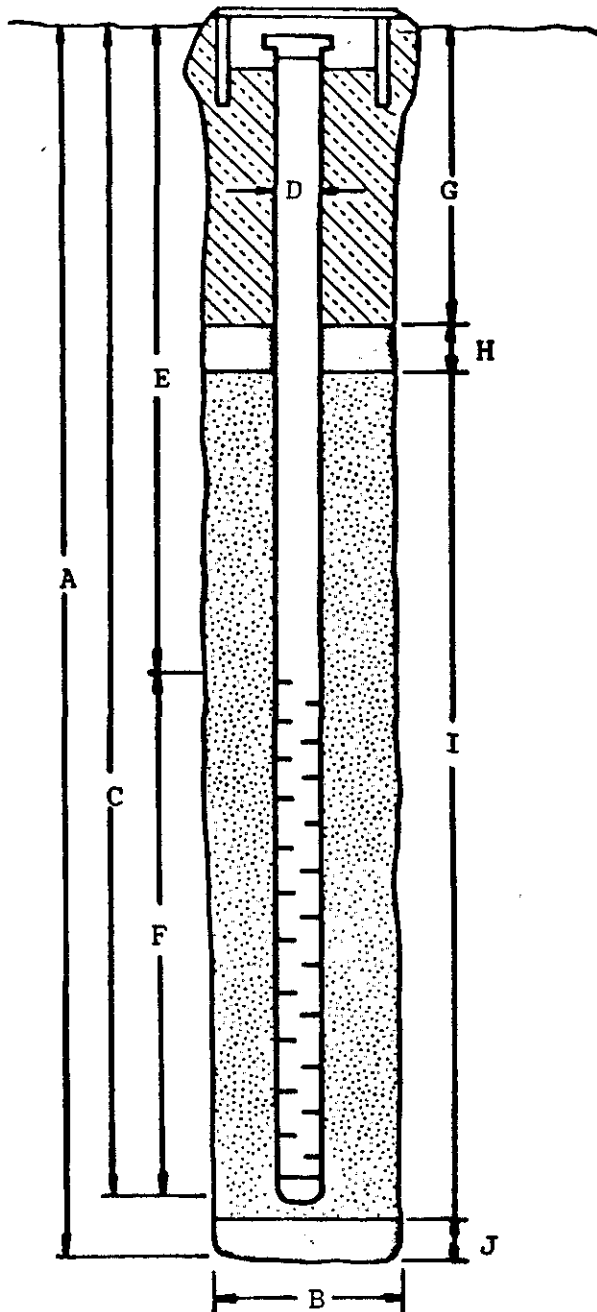

A. Total Depth: 19'

B. Boring Diameter*: 9"

Drilling Method: Hollow Stem

Auger

C. Casing Length: 19'

Material: Schedule 40 PVC

D. Casing Diameter: OD = 2.375"

ID = 2.067"

E. Depth to Perforations: 3'

F. Perforated Length: 16'

Perforation Type: Machined Slot

Perforation Size: 0.020"

G. Surface Seal: 1'

Seal Material: Concrete

H. Seal: 1'

Seal Material: Bentonite

I. Gravel Pack: 17'

Pack Material: RMC Lonestar Sand

Size: #3

J. Bottom Seal: None

Seal Material: N/A

*Boring diameter can vary from 8-1/4" to 9" depending on bit wear.

15/441302


BORING LOG					380348B
Project No. KEI-P89-1111		Boring & Casing Diameter 9" 2"		Logged By D.L. <i>[Signature]</i>	
Project Name Unocal Oakland-5300 Broadway		Well Head Elevation N/A		Date Drilled 4/6/90	
Boring No. MW2		Drilling Method Hollow-stem Auger		Drilling Company EGI	
Penetration blows/6"	G. W. level	Depth (ft) Samples	Strati- graphy USCS	Description	
		0		A. C. Pavement Sand and gravel base.	
			CL/ CH	Sandy clay, 10-15% gravel, very stiff, moist, yellowish brown and red, gravel is composed of weathered shale fragments.	
26/50-5"			N/A	BEDROCK - FRANCISCAN COMPLEX Shale, hard, weathered, slightly moist to dry, fractured, locally decomposed and clayey, olive and olive brown, dark reddish brown in fractured planes.	
50-6"		5			
50-5"		10		Shale Bedrock, as above, hard, dry, fractured, olive gray, olive brown and strong brown in fractures, weathered, wet below 9.5 feet.	
50-5 3/4		15		Shale, as above, wet, less weathered than above.	
		20		TOTAL DEPTH: 19'	

3803486

WELL COMPLETION DIAGRAM

PROJECT NAME: Unocal - Oakland - 5300 Broadway BORING/WELL NO. MW2PROJECT NUMBER: KEI-P89-1111WELL PERMIT NO.: 90154

Flush-mounted Well Cover

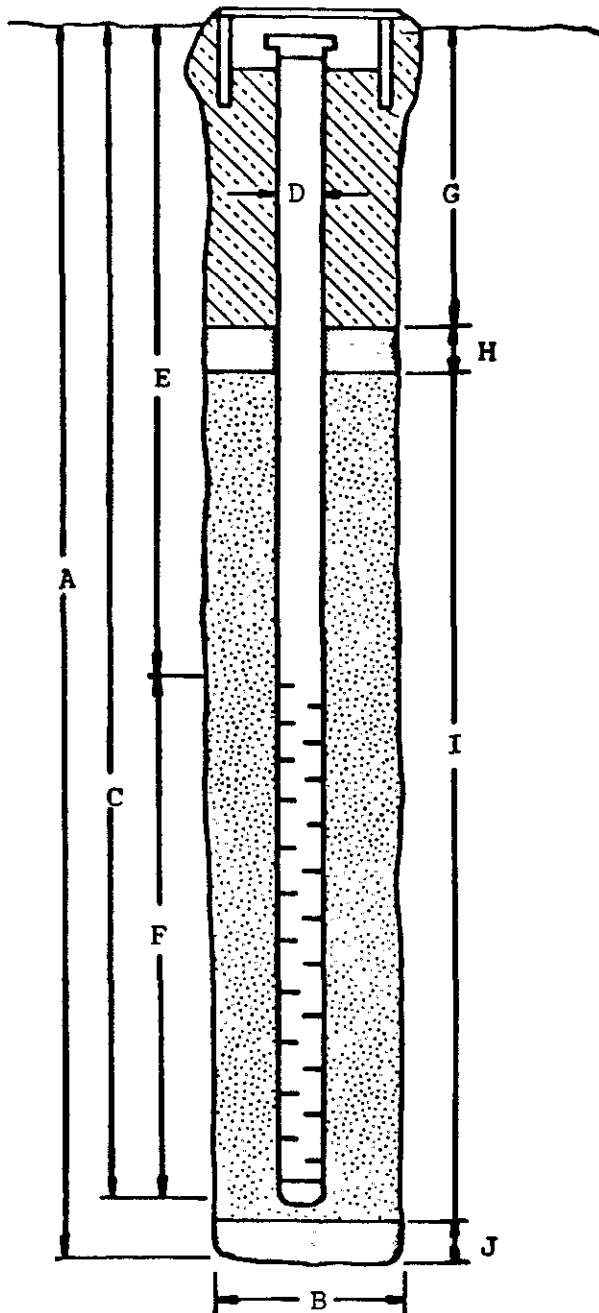A. Total Depth: 19'B. Boring Diameter*: 9"Drilling Method: Hollow Stem
AugerC. Casing Length: 19'Material: Schedule 40 PVCD. Casing Diameter: OD = 2.375"ID = 2.067"E. Depth to Perforations: 4'F. Perforated Length: 15'Machined
Perforation Type: SlotPerforation Size: 0.020"G. Surface Seal: 1.5'Seal Material: ConcreteH. Seal: 1.5'Seal Material: BentoniteI. Gravel Pack: 16'RMC Lonestar
Pack Material: SandSize: #3J. Bottom Seal: NoneSeal Material: N/A


*Boring diameter can vary from 8-1/4" to 9" depending on bit wear.

15401303

BORING LOG

380348C

Project No. KEI-P89-1111	Boring & Casing Diameter 9" 2"	Logged By D.L. <i>John Brewer</i>
Project Name Unocal Oakland-5300 Broadway	Well Head Elevation N/A	Date Drilled 4/6/90 & 4/9/90
Boring No. MW3	Drilling Method Hollow-stem Auger	Drilling Company EGI

Penetration blows/6"	G. W. level	Depth (ft) Samples	Strati- graphy USCS	Description
		0		Concrete Pavement
			CL/ CH	Sandy clay, 10-20% gravel, very stiff, moist, yellowish brown, gravel is shale, bedrock weathered to soil.
20/24/50 -5"		5	N/A	BEDROCK - FRANCISCAN COMPLEX Shale, moderately hard to hard, slightly moist to dry, weathered, locally decomposed and clayey, fractured, olive brown and strong brown, black in some fracture planes.
50-3"				
51		10		Shale to silty shale, as above, moderately decomposed and clayey between 9 and 10 feet.
		15		Shale to silty shale, as above, less weathered than above, hardness increasing with depth.
		20		TOTAL DEPTH: 20'

380348C


WELL COMPLETION DIAGRAM

PROJECT NAME: Unocal - Oakland - 5300 Broadway BORING/WELL NO. MW3

PROJECT NUMBER: KEI-P89-1111

WELL PERMIT NO.: 90154

Flush-mounted Well Cover

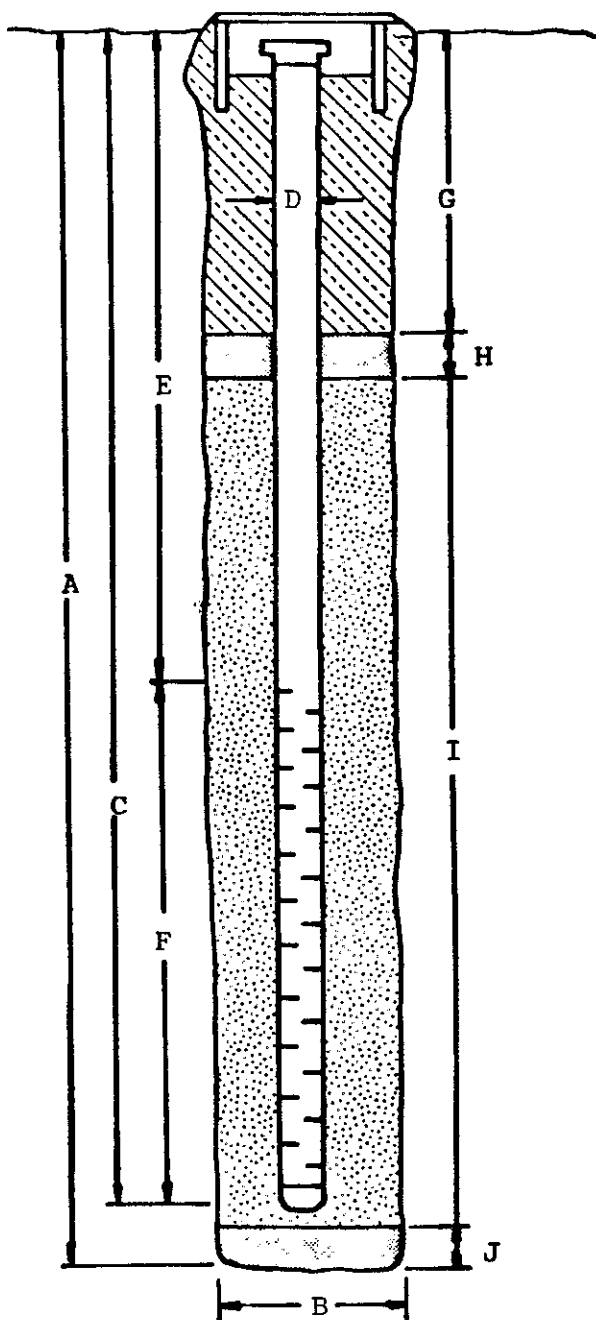

A. Total Depth: 20'

B. Boring Diameter*: 9"

Drilling Method: Hollow Stem Auger

C. Casing Length: 20'

Material: Schedule 40 PVC

D. Casing Diameter: OD = 2.375"
ID = 2.067"

E. Depth to Perforations: 4'

F. Perforated Length: 16'

Perforation Type: Machined Slot

Perforation Size: 0.020"

G. Surface Seal: 1.5'

Seal Material: Concrete

H. Seal: 1.5'

Seal Material: Bentonite

I. Gravel Pack: 17'

Pack Material: RMC Lonestar Sand

Size: #3

J. Bottom Seal: None

Seal Material: N/A

*Boring diameter can vary from 8-1/4" to 9" depending on bit wear.