




2 STORY BRICK BUILDING

RECEIVED
10:07 am, Apr 22, 2009
Alameda County
Environmental Health

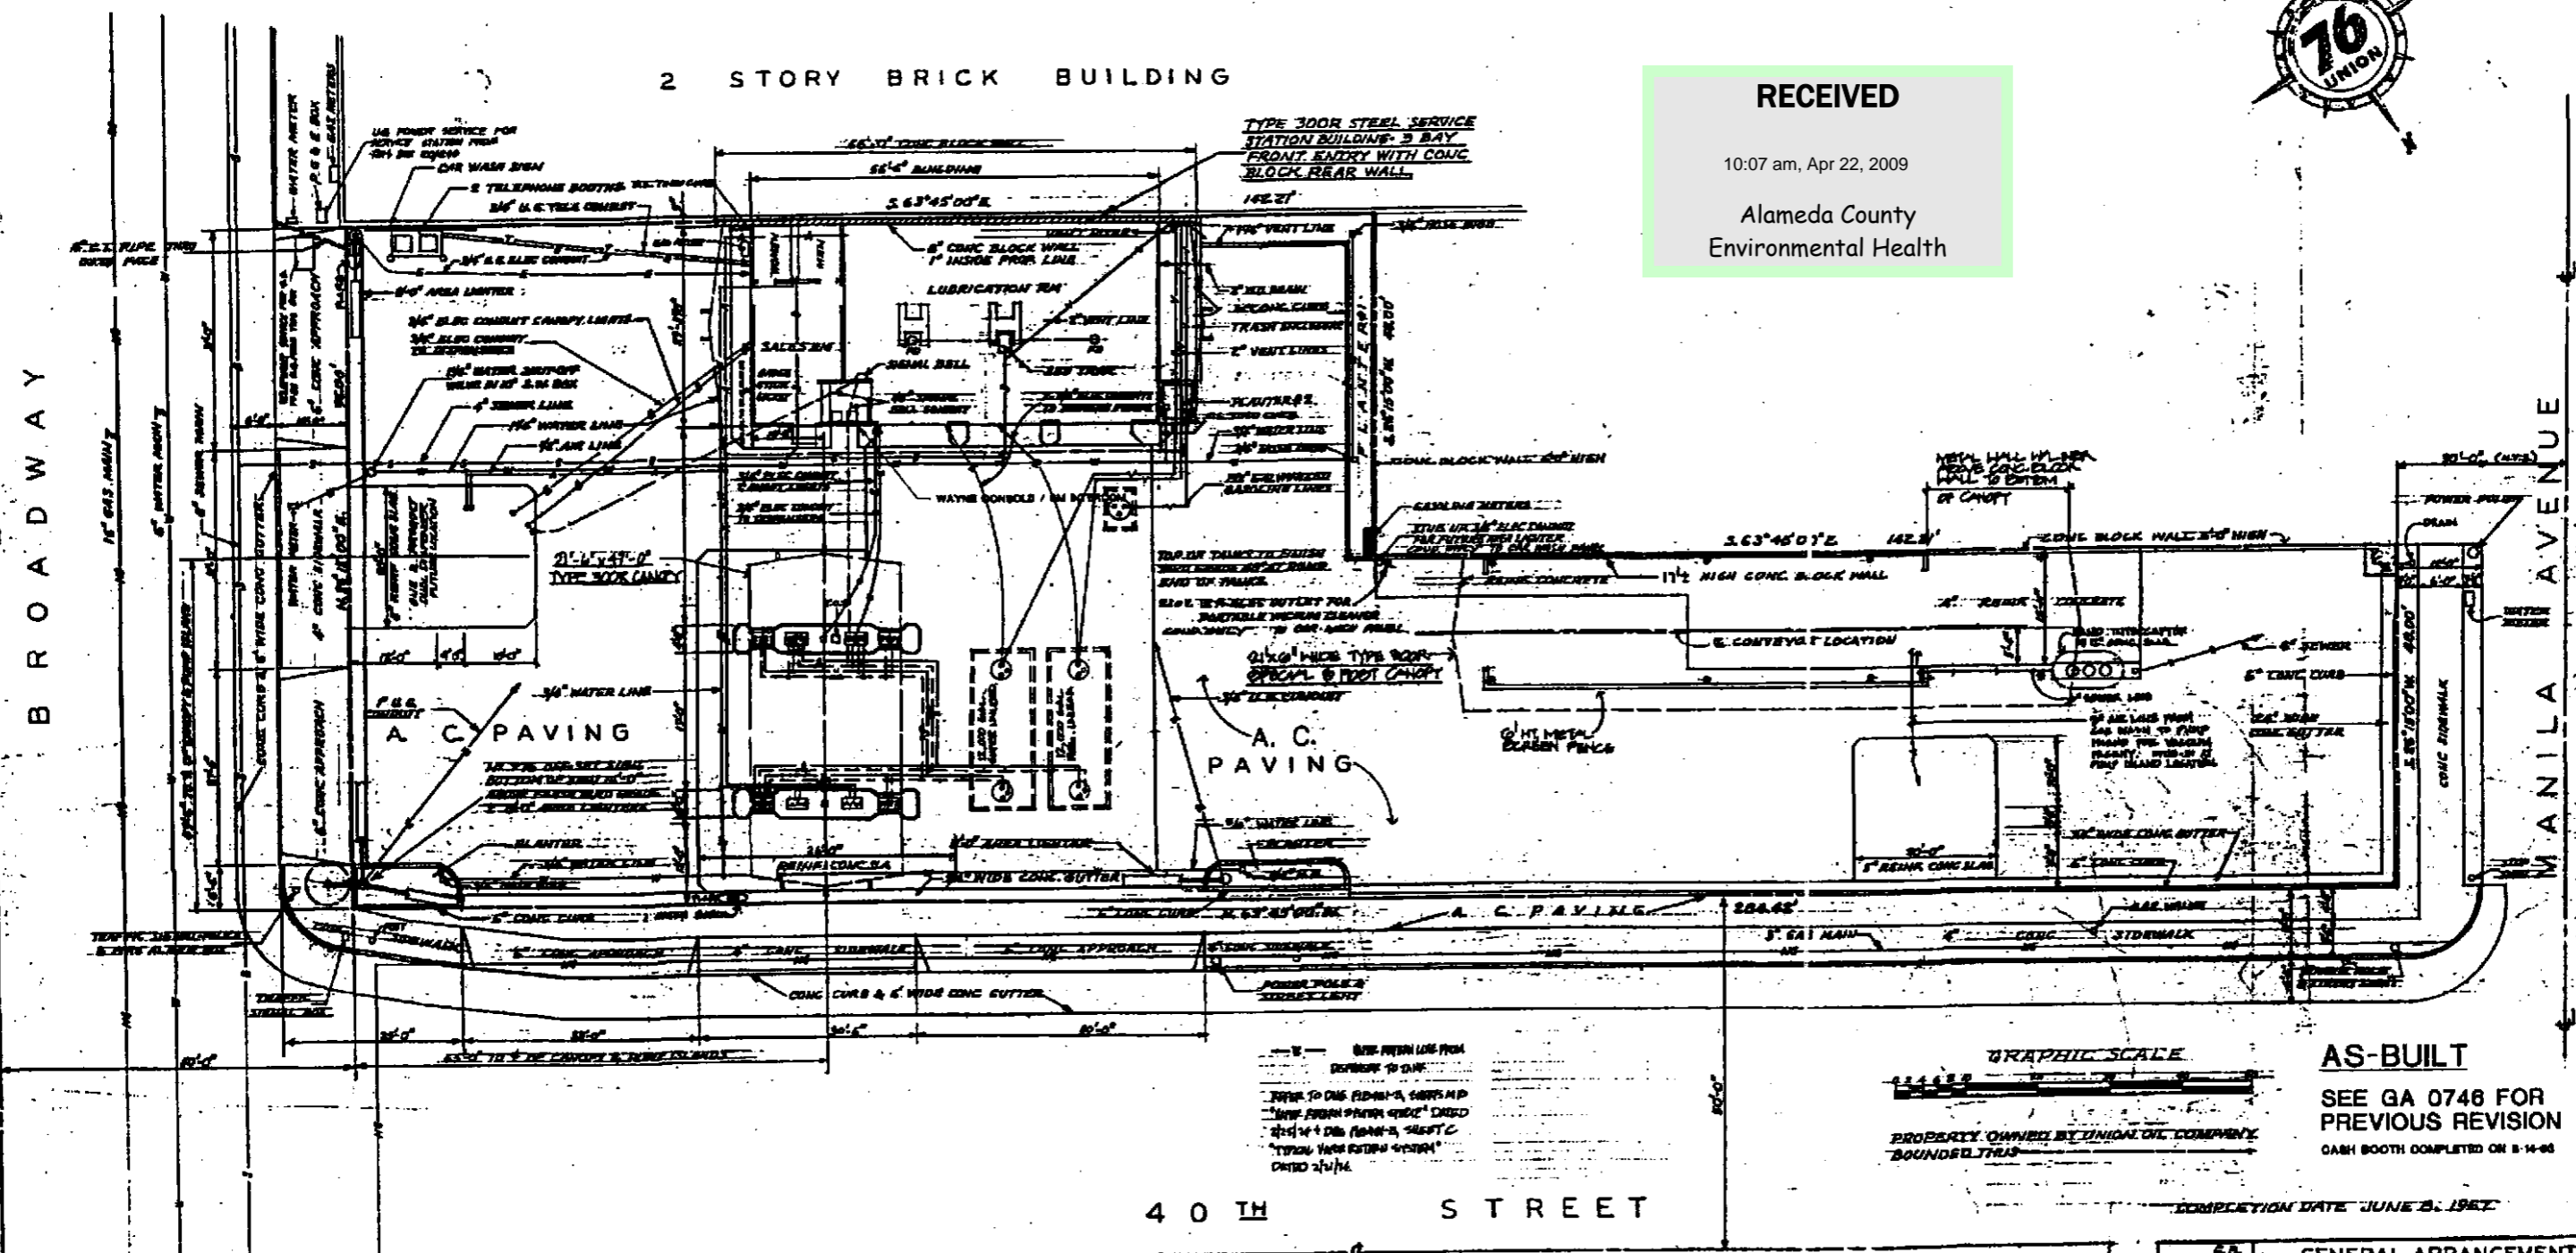

--- V --- ONE FROM LINE FROM DEPARTMENT TO DATE
--- S --- FROM TO DATE FROM-TO, SHOWS MP
--- W --- FROM FROM FROM-TO DATE
--- T --- FROM FROM FROM-TO DATE
--- C --- FROM FROM FROM-TO DATE

GRAPHIC SCALE
1" = 10'-0"
PROPERTY OWNED BY UNION OIL COMPANY
BOUNDARY LINES

AS-BUILT
SEE GA 0748 FOR PREVIOUS REVISION
GASH BOOTH COMPLETED ON 8-14-66


DATE	REVISED	BY	REASON
4-5-66	DESIGNING CORRECTED UNDERGROUND		
6-14-66	NO ED. LINES FROM OVERHEAD & TANKS		
1-8-66	PROTECT CAT-WALKS AND ISLANDS		
11-27-66	ADD SIGN-N (DISTANCE TO DRIVE)		
7-8-66	ADD SIGNAGE FOR FUEL FROM MAIN TANK		

COMPLETION DATE JUNE 2, 1967


GENERAL ARRANGEMENT SERVICE STATION NO 746 40TH STREET & BROADWAY OAKLAND, CALIFORNIA	
UNION OIL COMPANY OF CALIFORNIA	SS0746A

Store # 250746 Date: 12/27/90
Unit # 0746 Code: GEN Color
Description: GEN ARRANGEMENT


WESTERN REGION BOX:
#9532

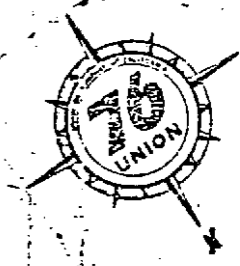

2 STORY BRICK BUILDING

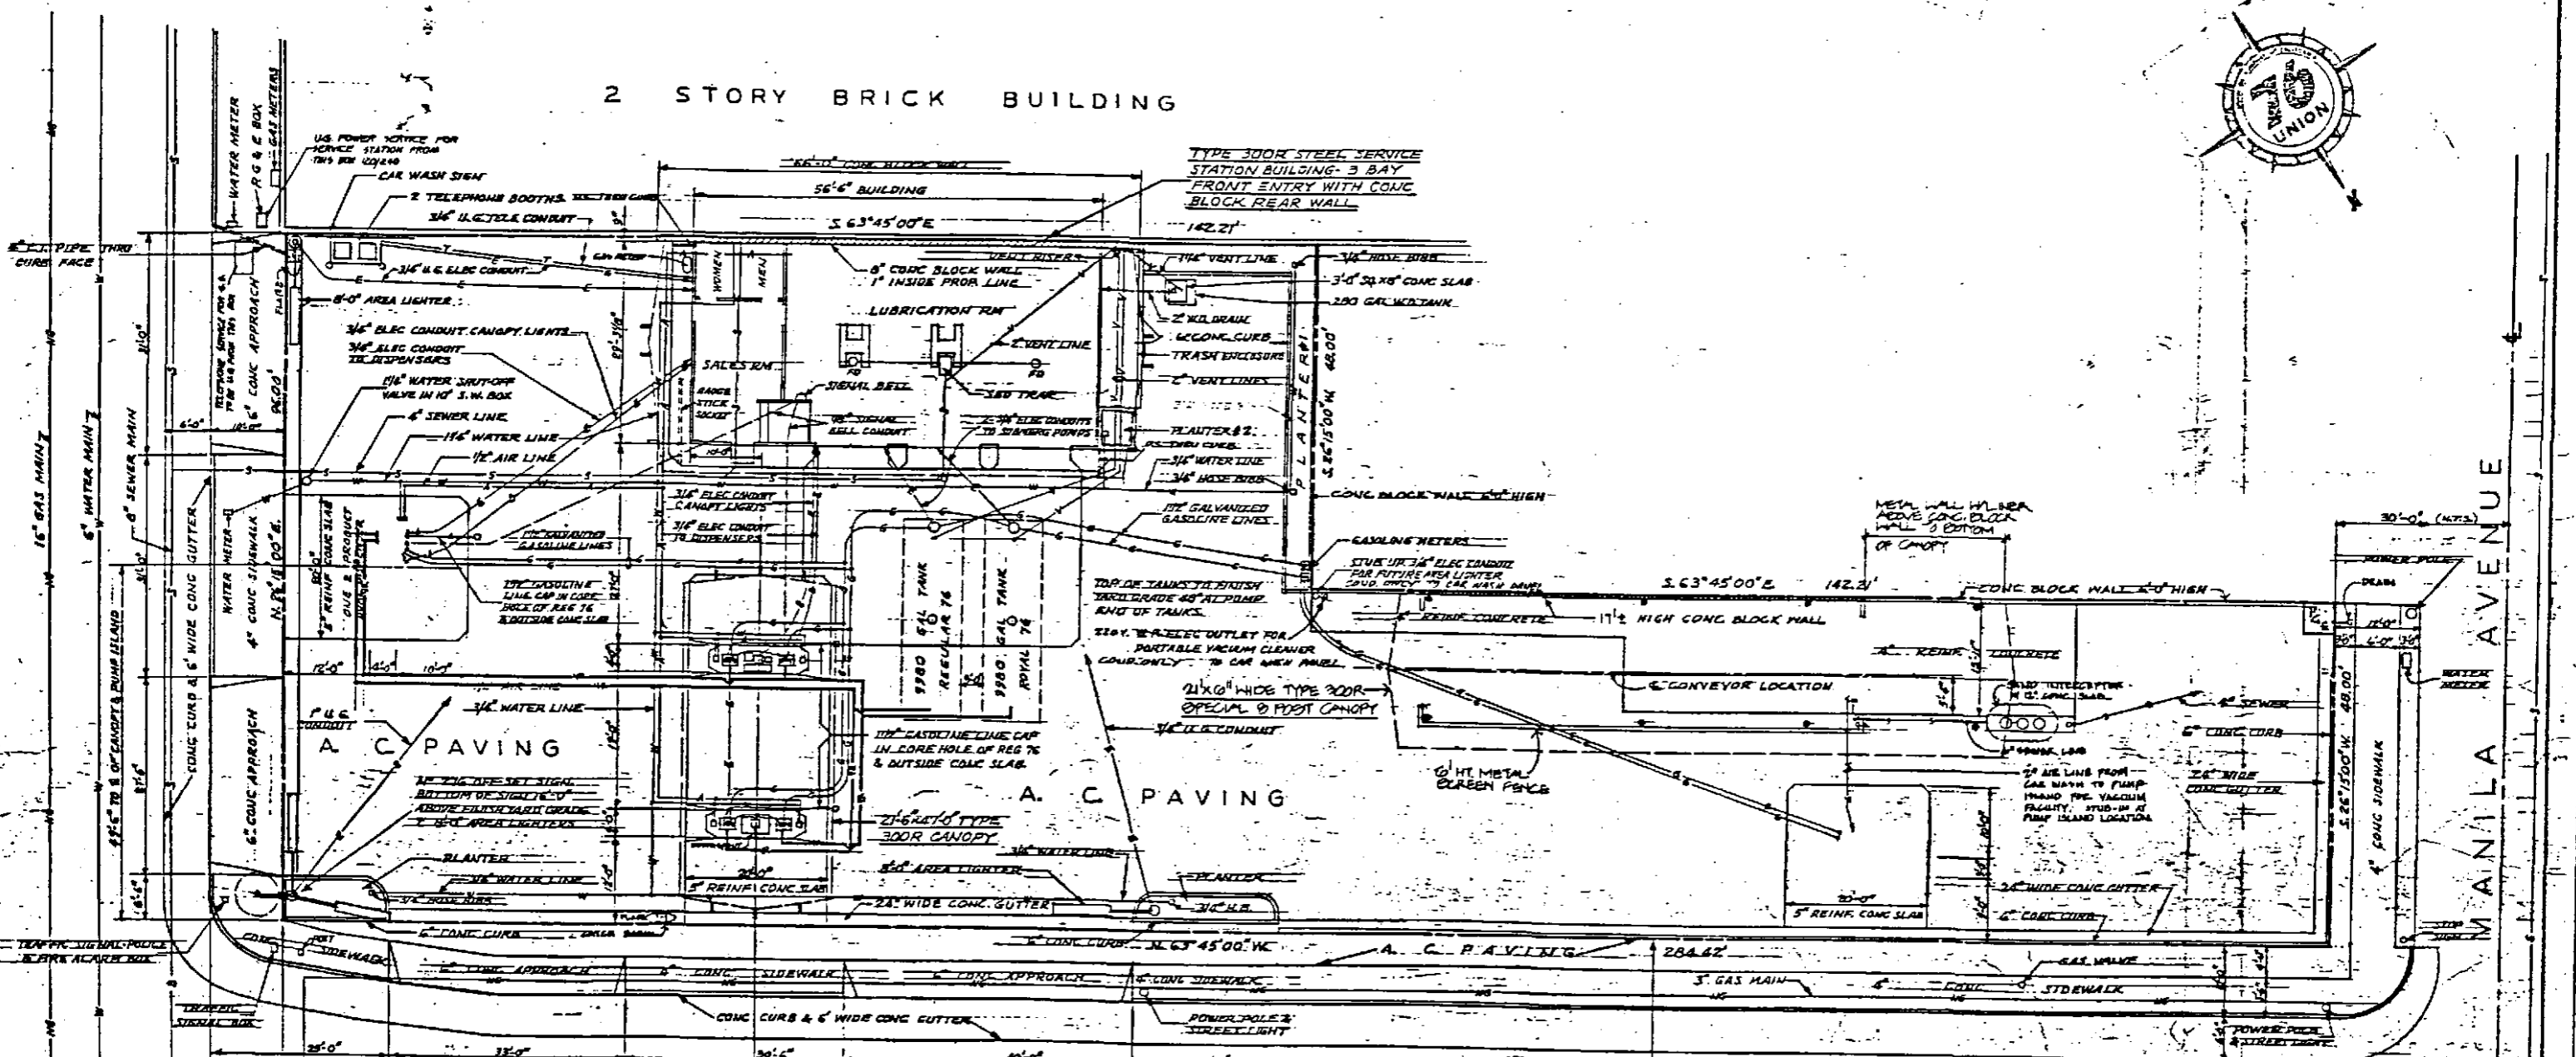

- W --- WAVE RETURN LINE FROM DEPOSITOR TO TANK
- P --- PIPE TO OIL FIGHTER'S, SHEETS AND WAVE RETURN SYSTEM SPEC' DATED 1/24/46 + OIL FIGHTER'S SHEET C
- T --- TYPICAL WAVE RETURN SYSTEM DATED 2/14/46

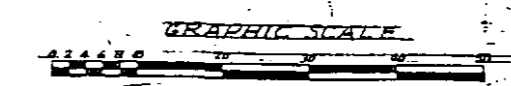

PROPERTY OWNED BY UNION OIL COMPANY BOUNDED THUS

40 TH STREET

COMPLETION DATE JUNE 5, 1961

DATE	REVISED	BY	REVISION
4-5-1961	DRAWING CORRECTED, UNDERGROUND FACILITIES INSTALLED AS SHOWN	G.B.	
5-14-61	LOOSE VE. LINES FROM OVERHEADS TO TANKS	B.H.	
1-2-62	CORRECTED CAPMANS AND PLANNED	M.B.	
	AS SHOWN (DISPENSERS SELECTED)		

GENERAL ARRANGEMENT SERVICE STATION NO 746 40TH STREET & BROADWAY OAKLAND, CALIFORNIA	
UNION OIL COMPANY OF CALIFORNIA	F-3-746-1.1