



POST OFFICE ROAD

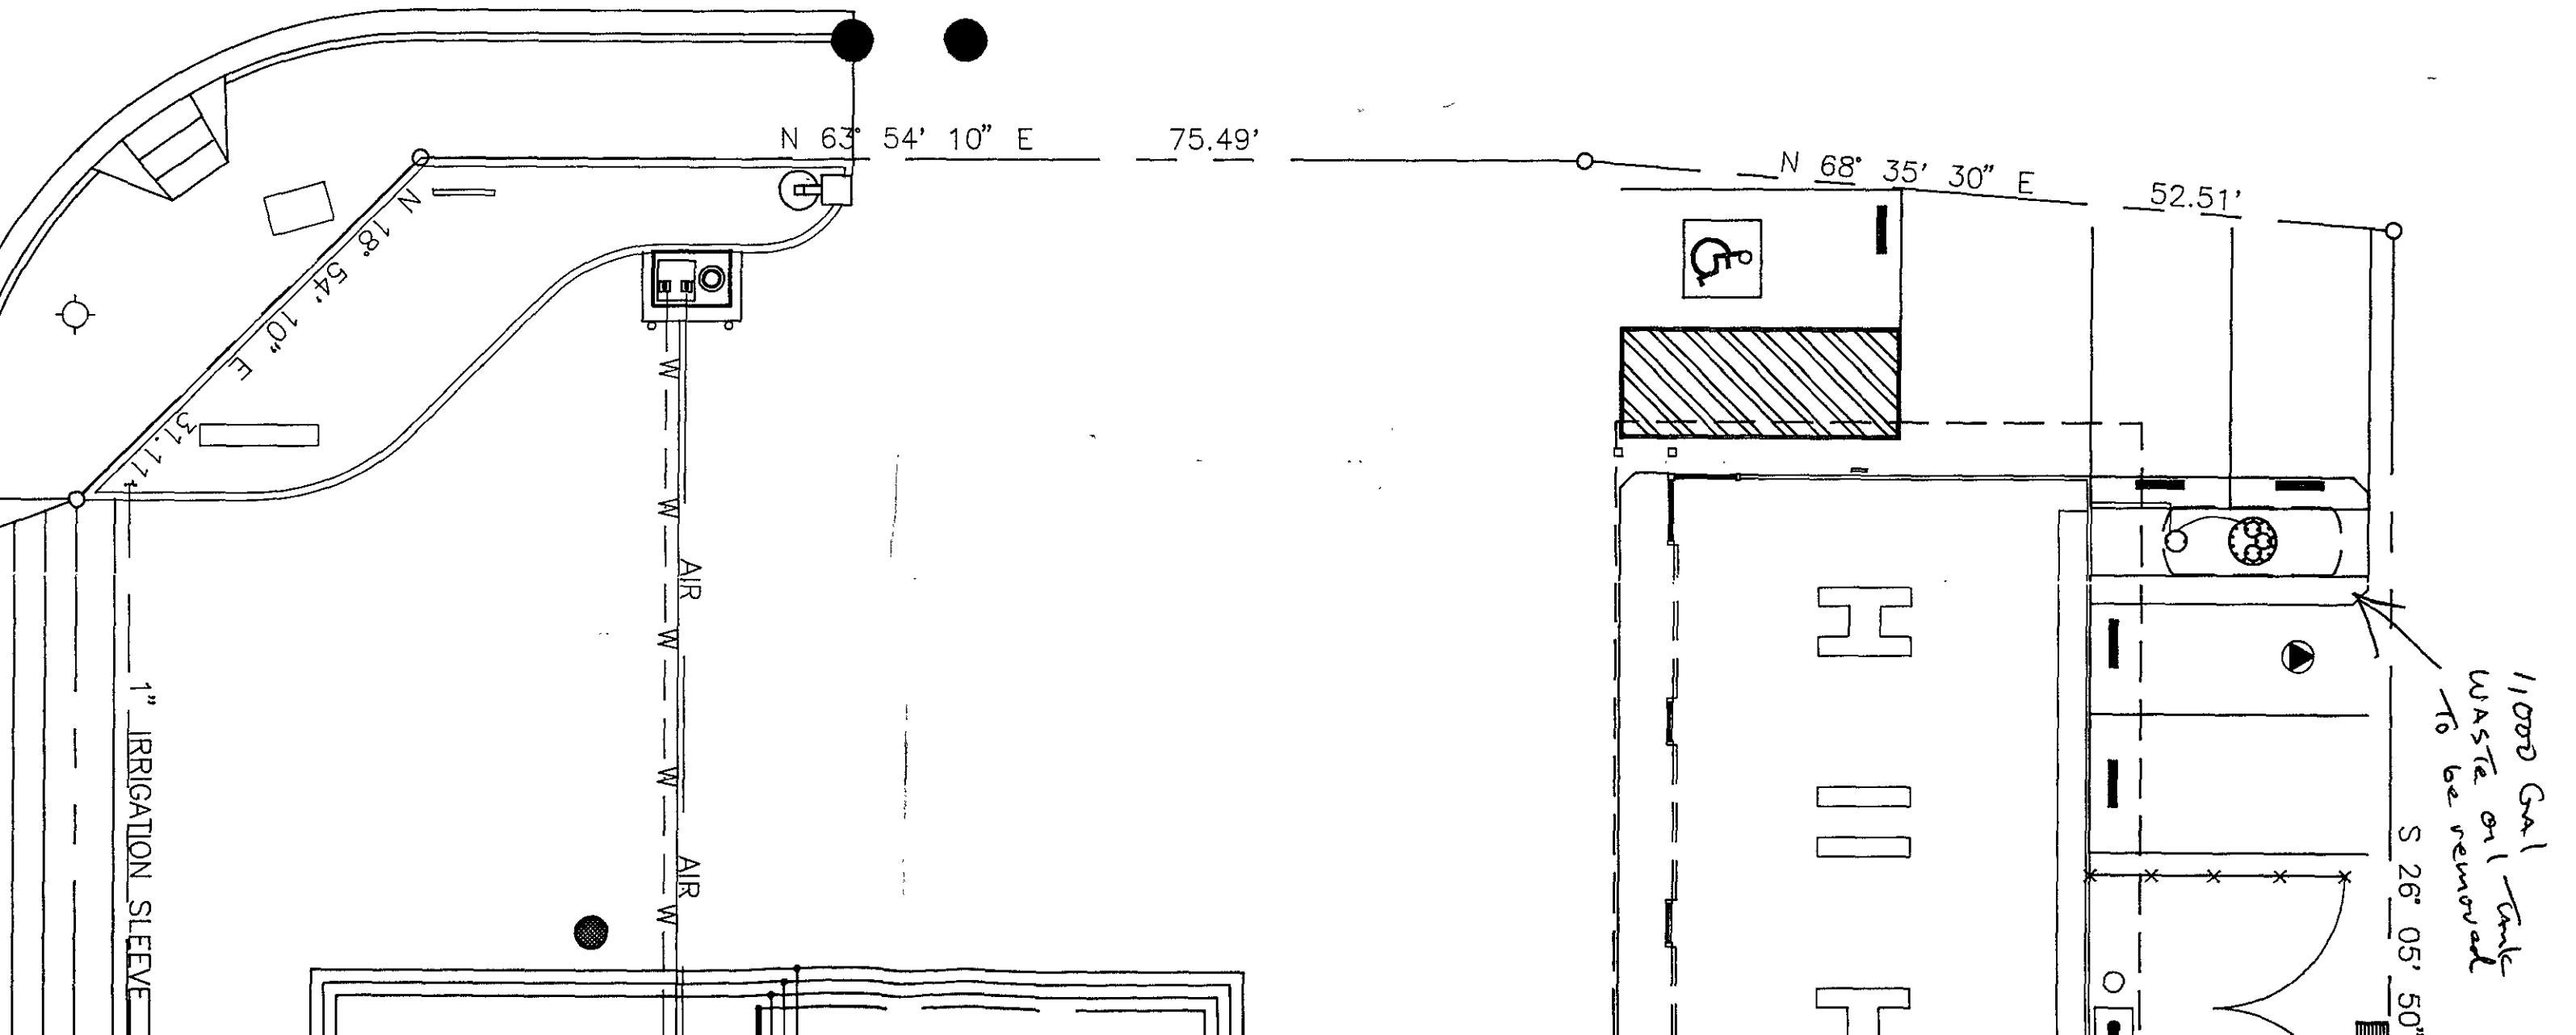

Tank
wood

05' 50" E

118.64'

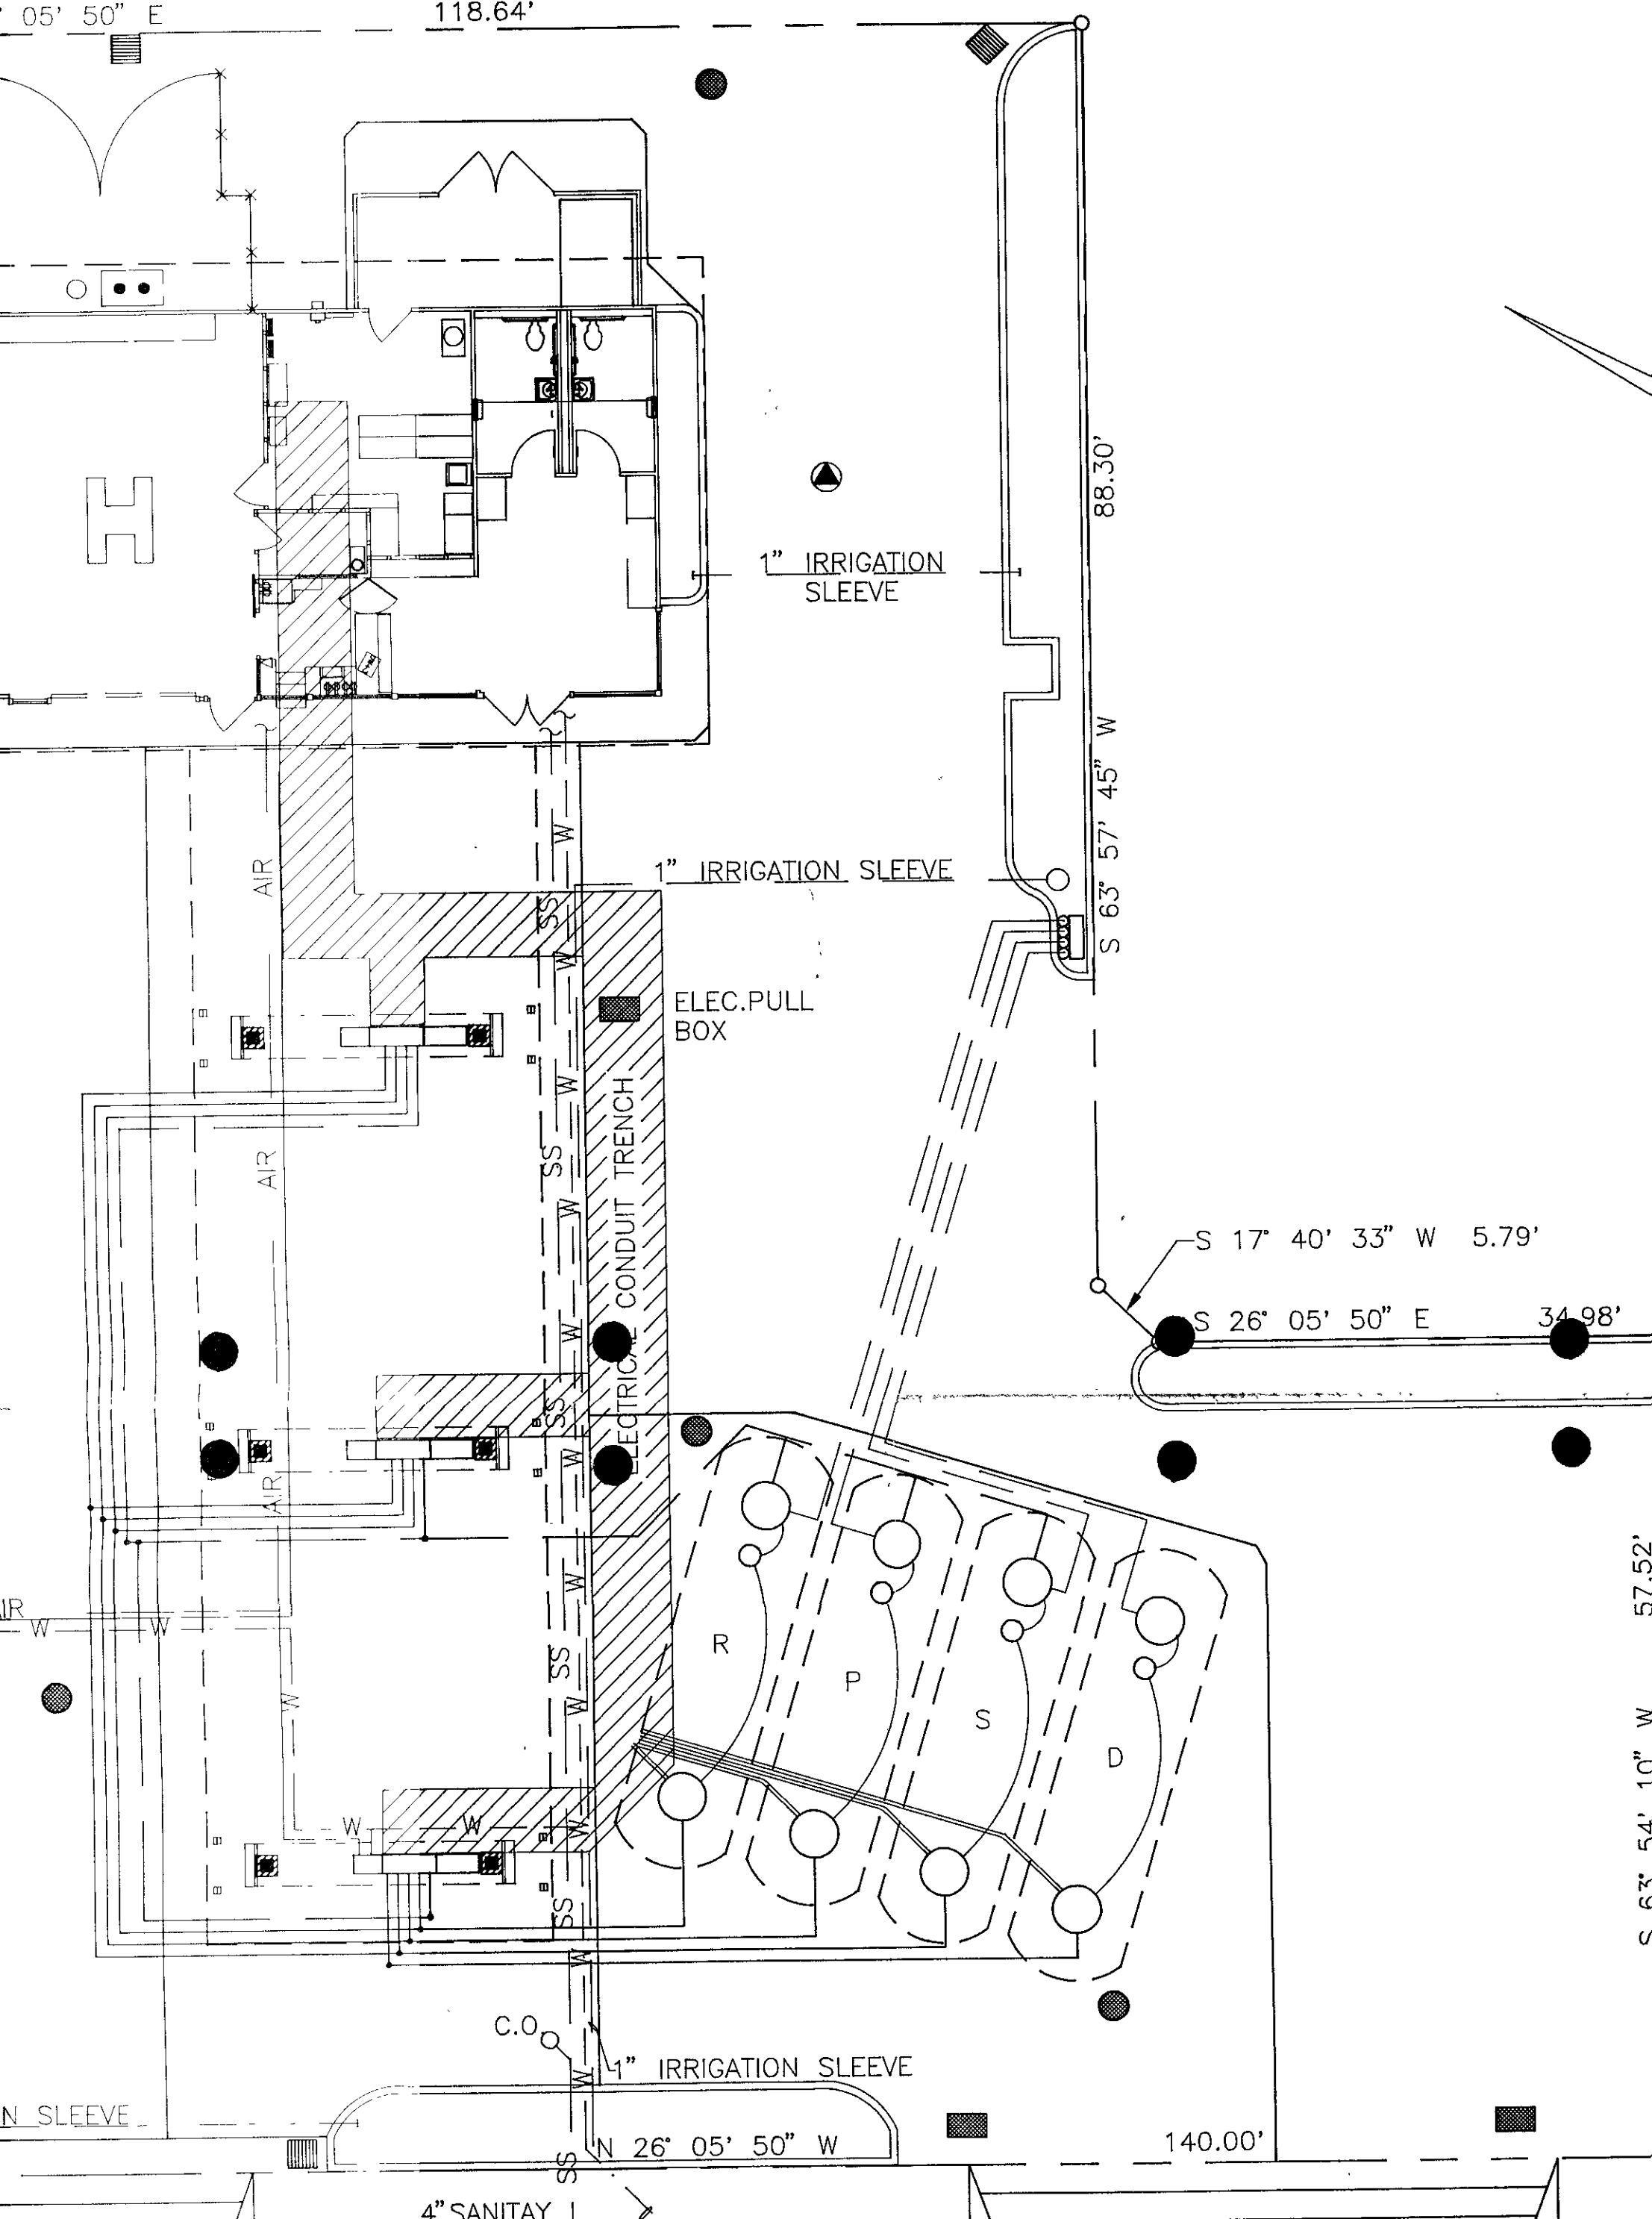

1" IRRIGATION SLEEVE

1" IRRIGATION SLEEVE

ELEC. PULL BOX

ELECTRICAL CONDUIT TRENCH

S 17° 40' 33" W 5.79'

S 26° 05' 50" E 34.98'



1" IRRIGATION SLEEVE

N 26° 05' 50" W


140.00'


4" SANITAY

S 63° 54' 10" W 57.52'

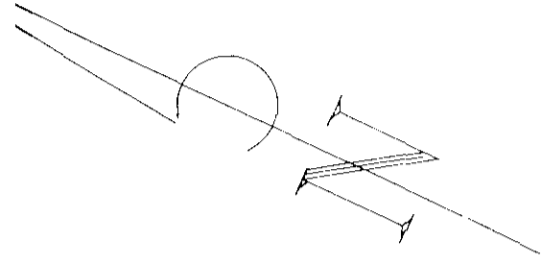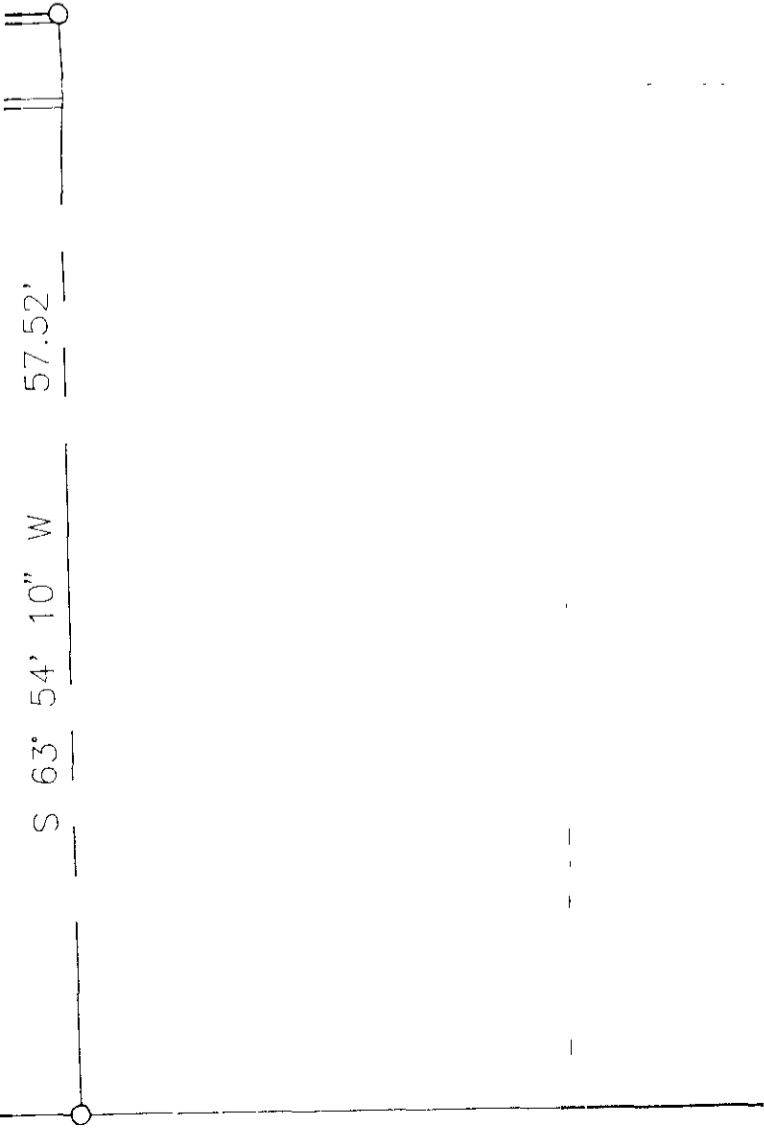


POST OFFICE ROAD

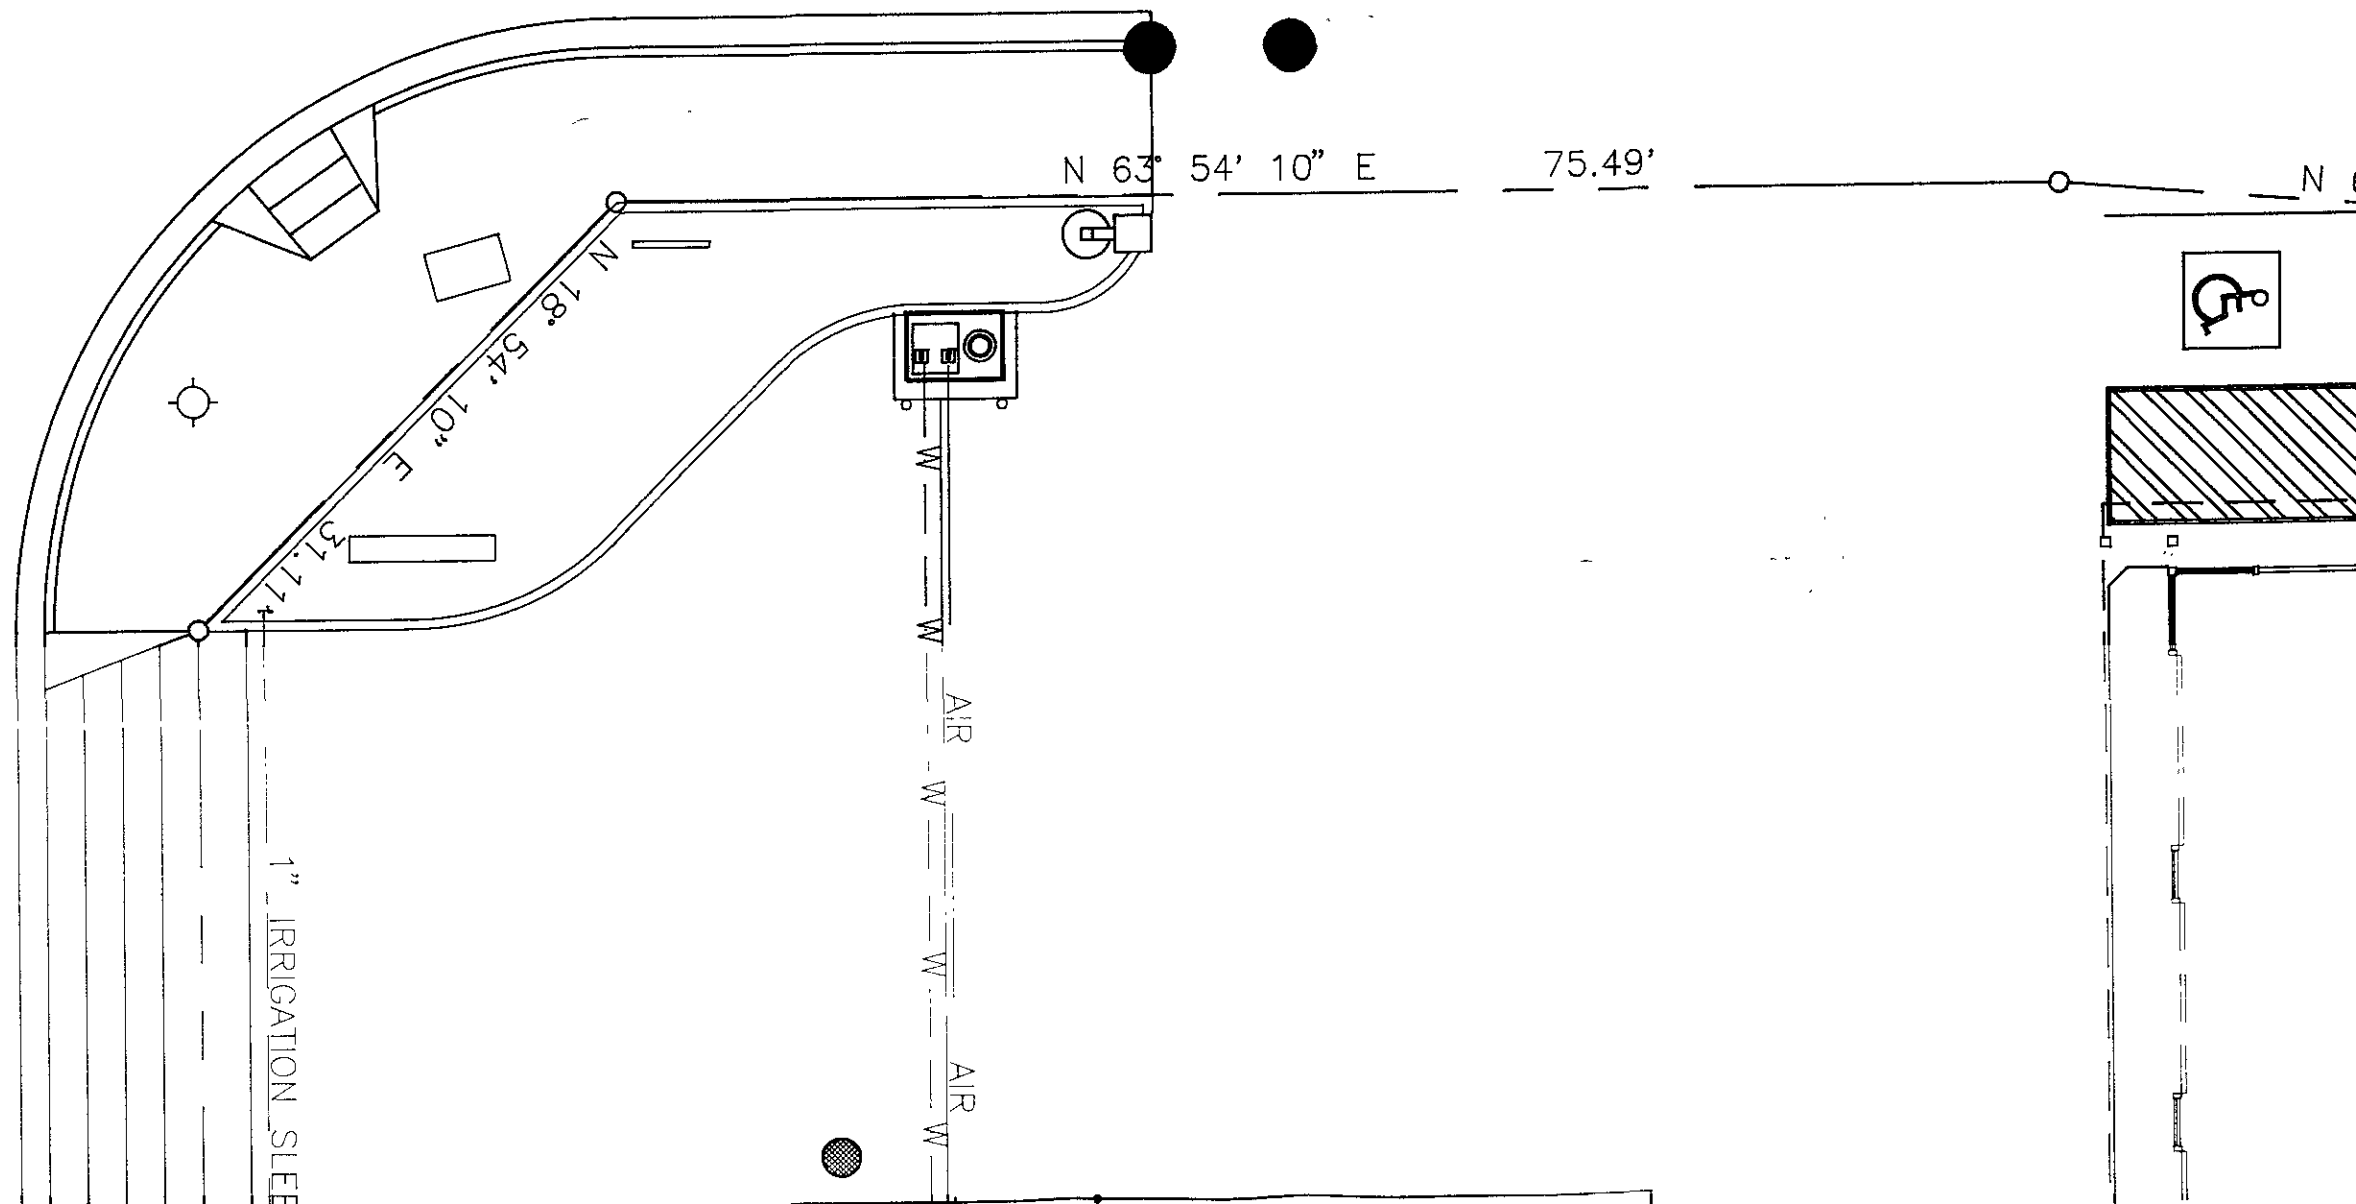



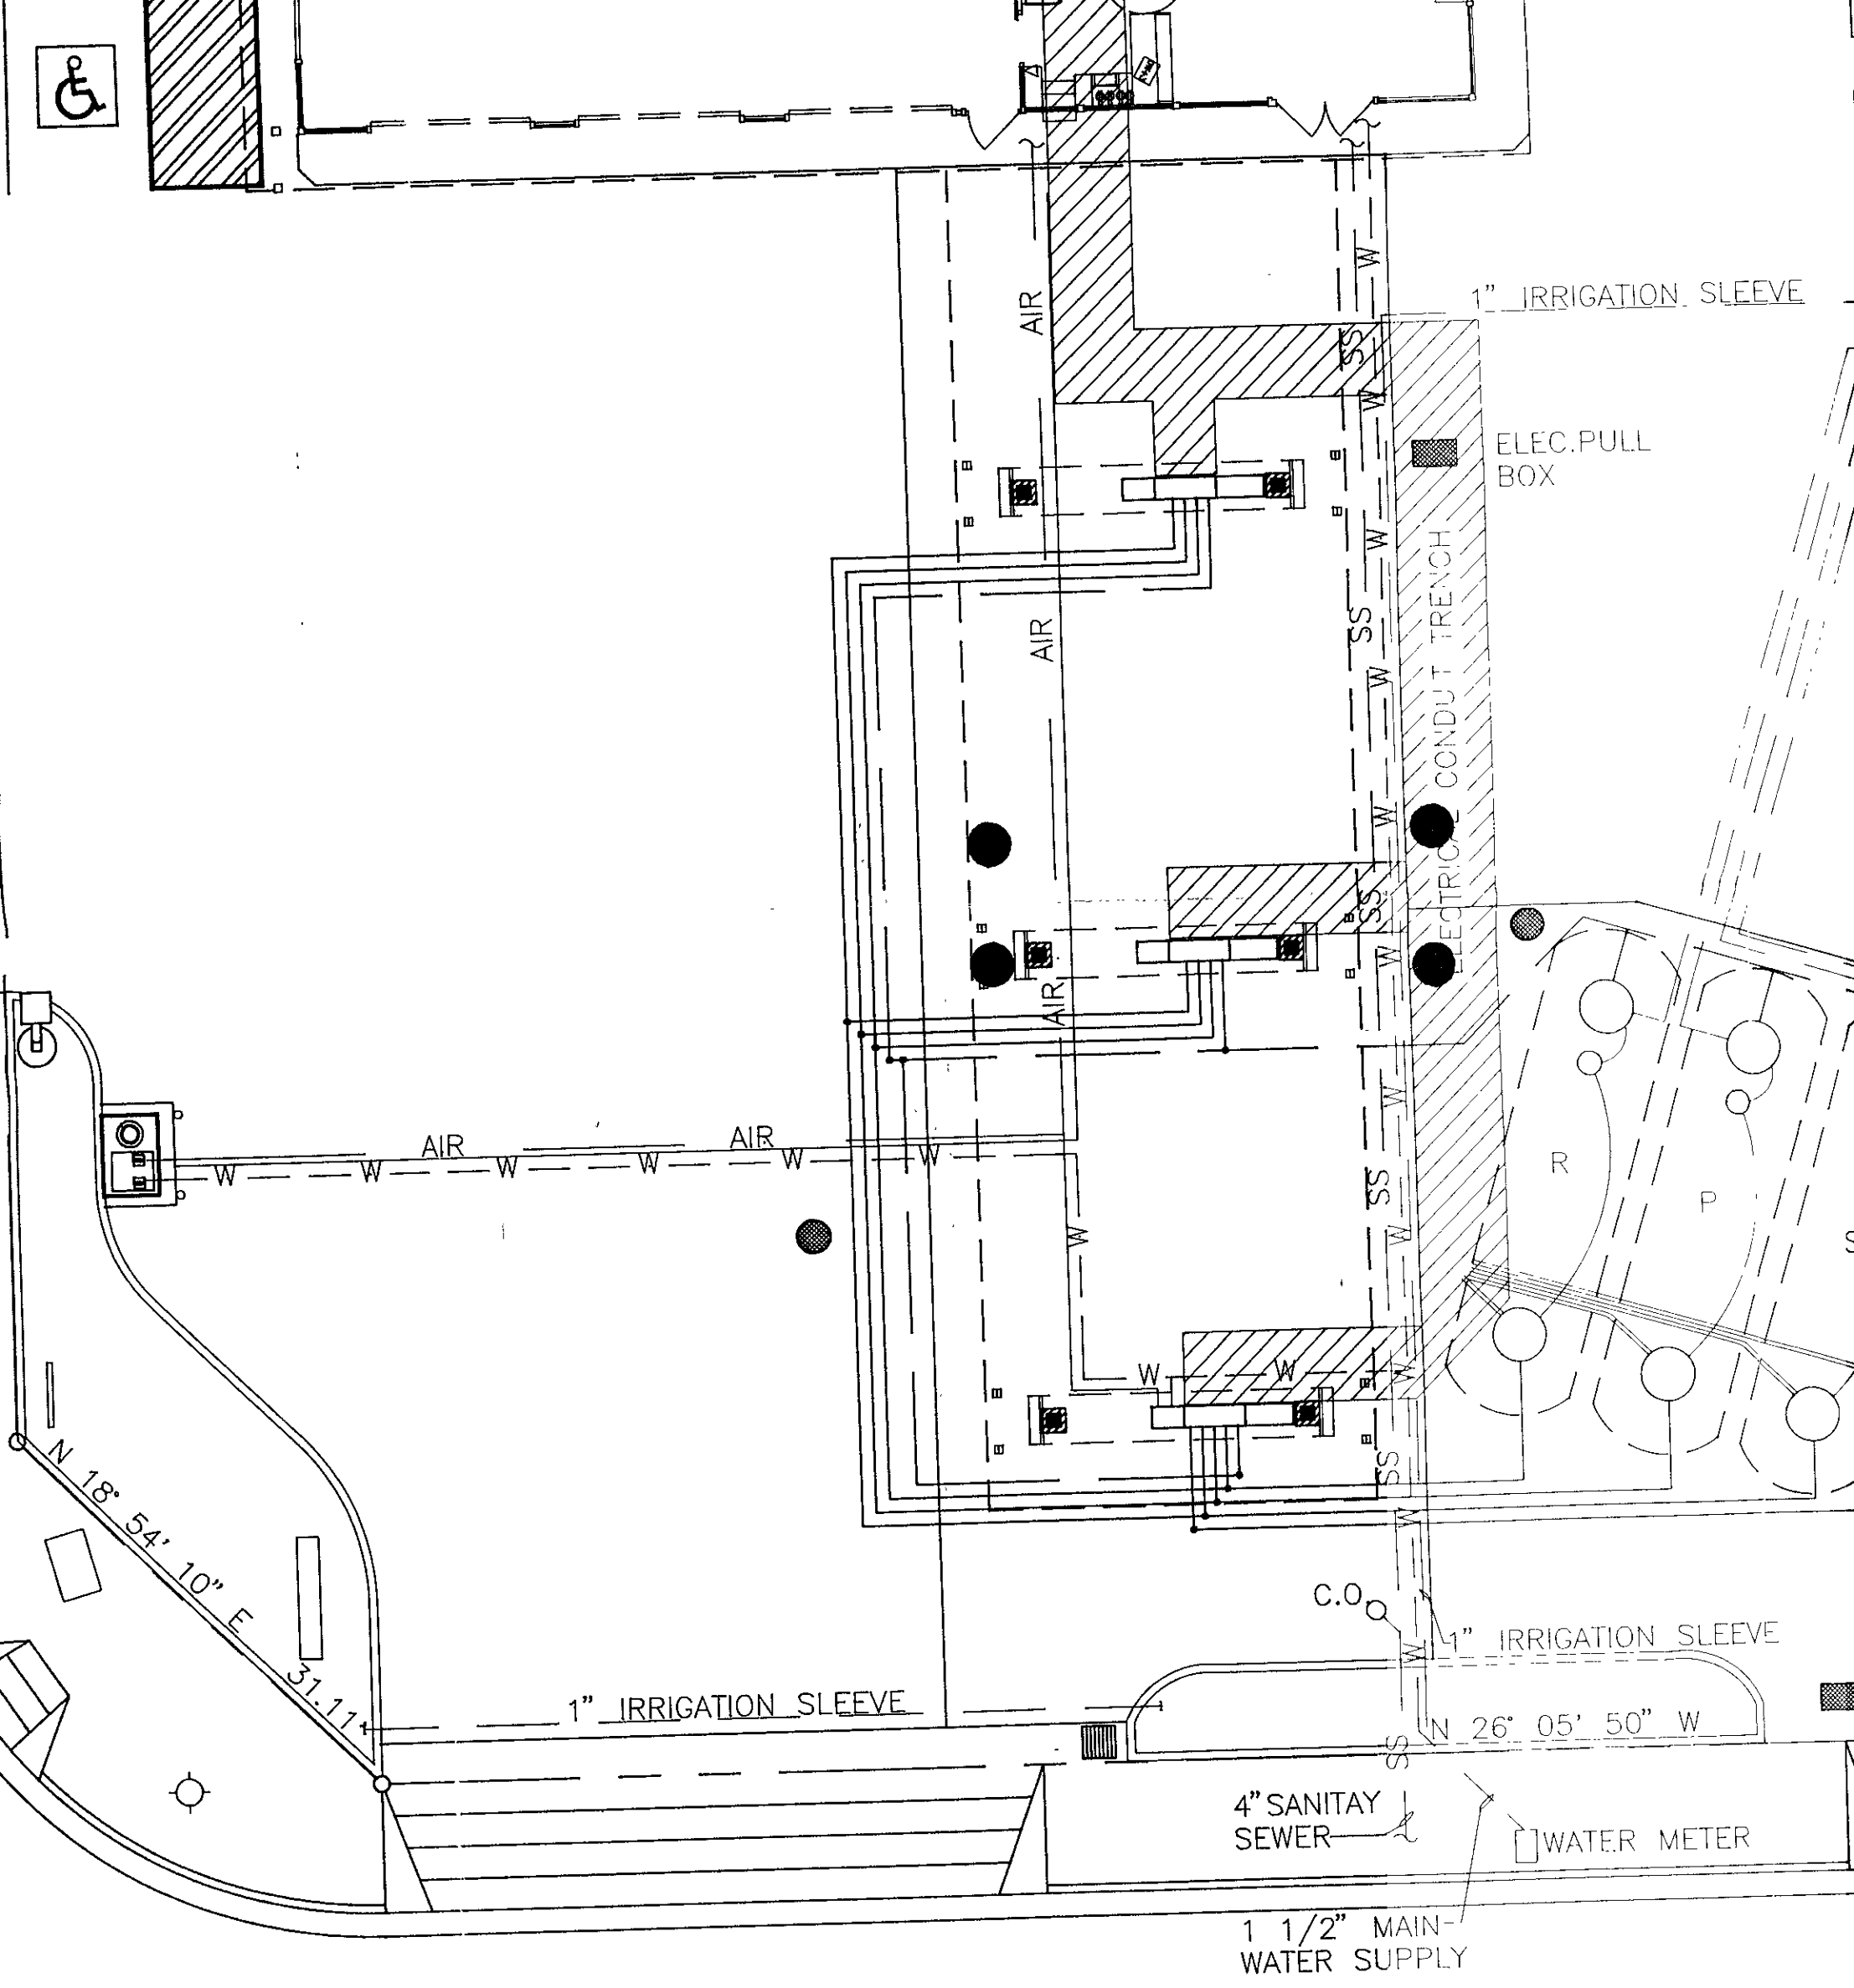



HESPERIAN BOULEVARD

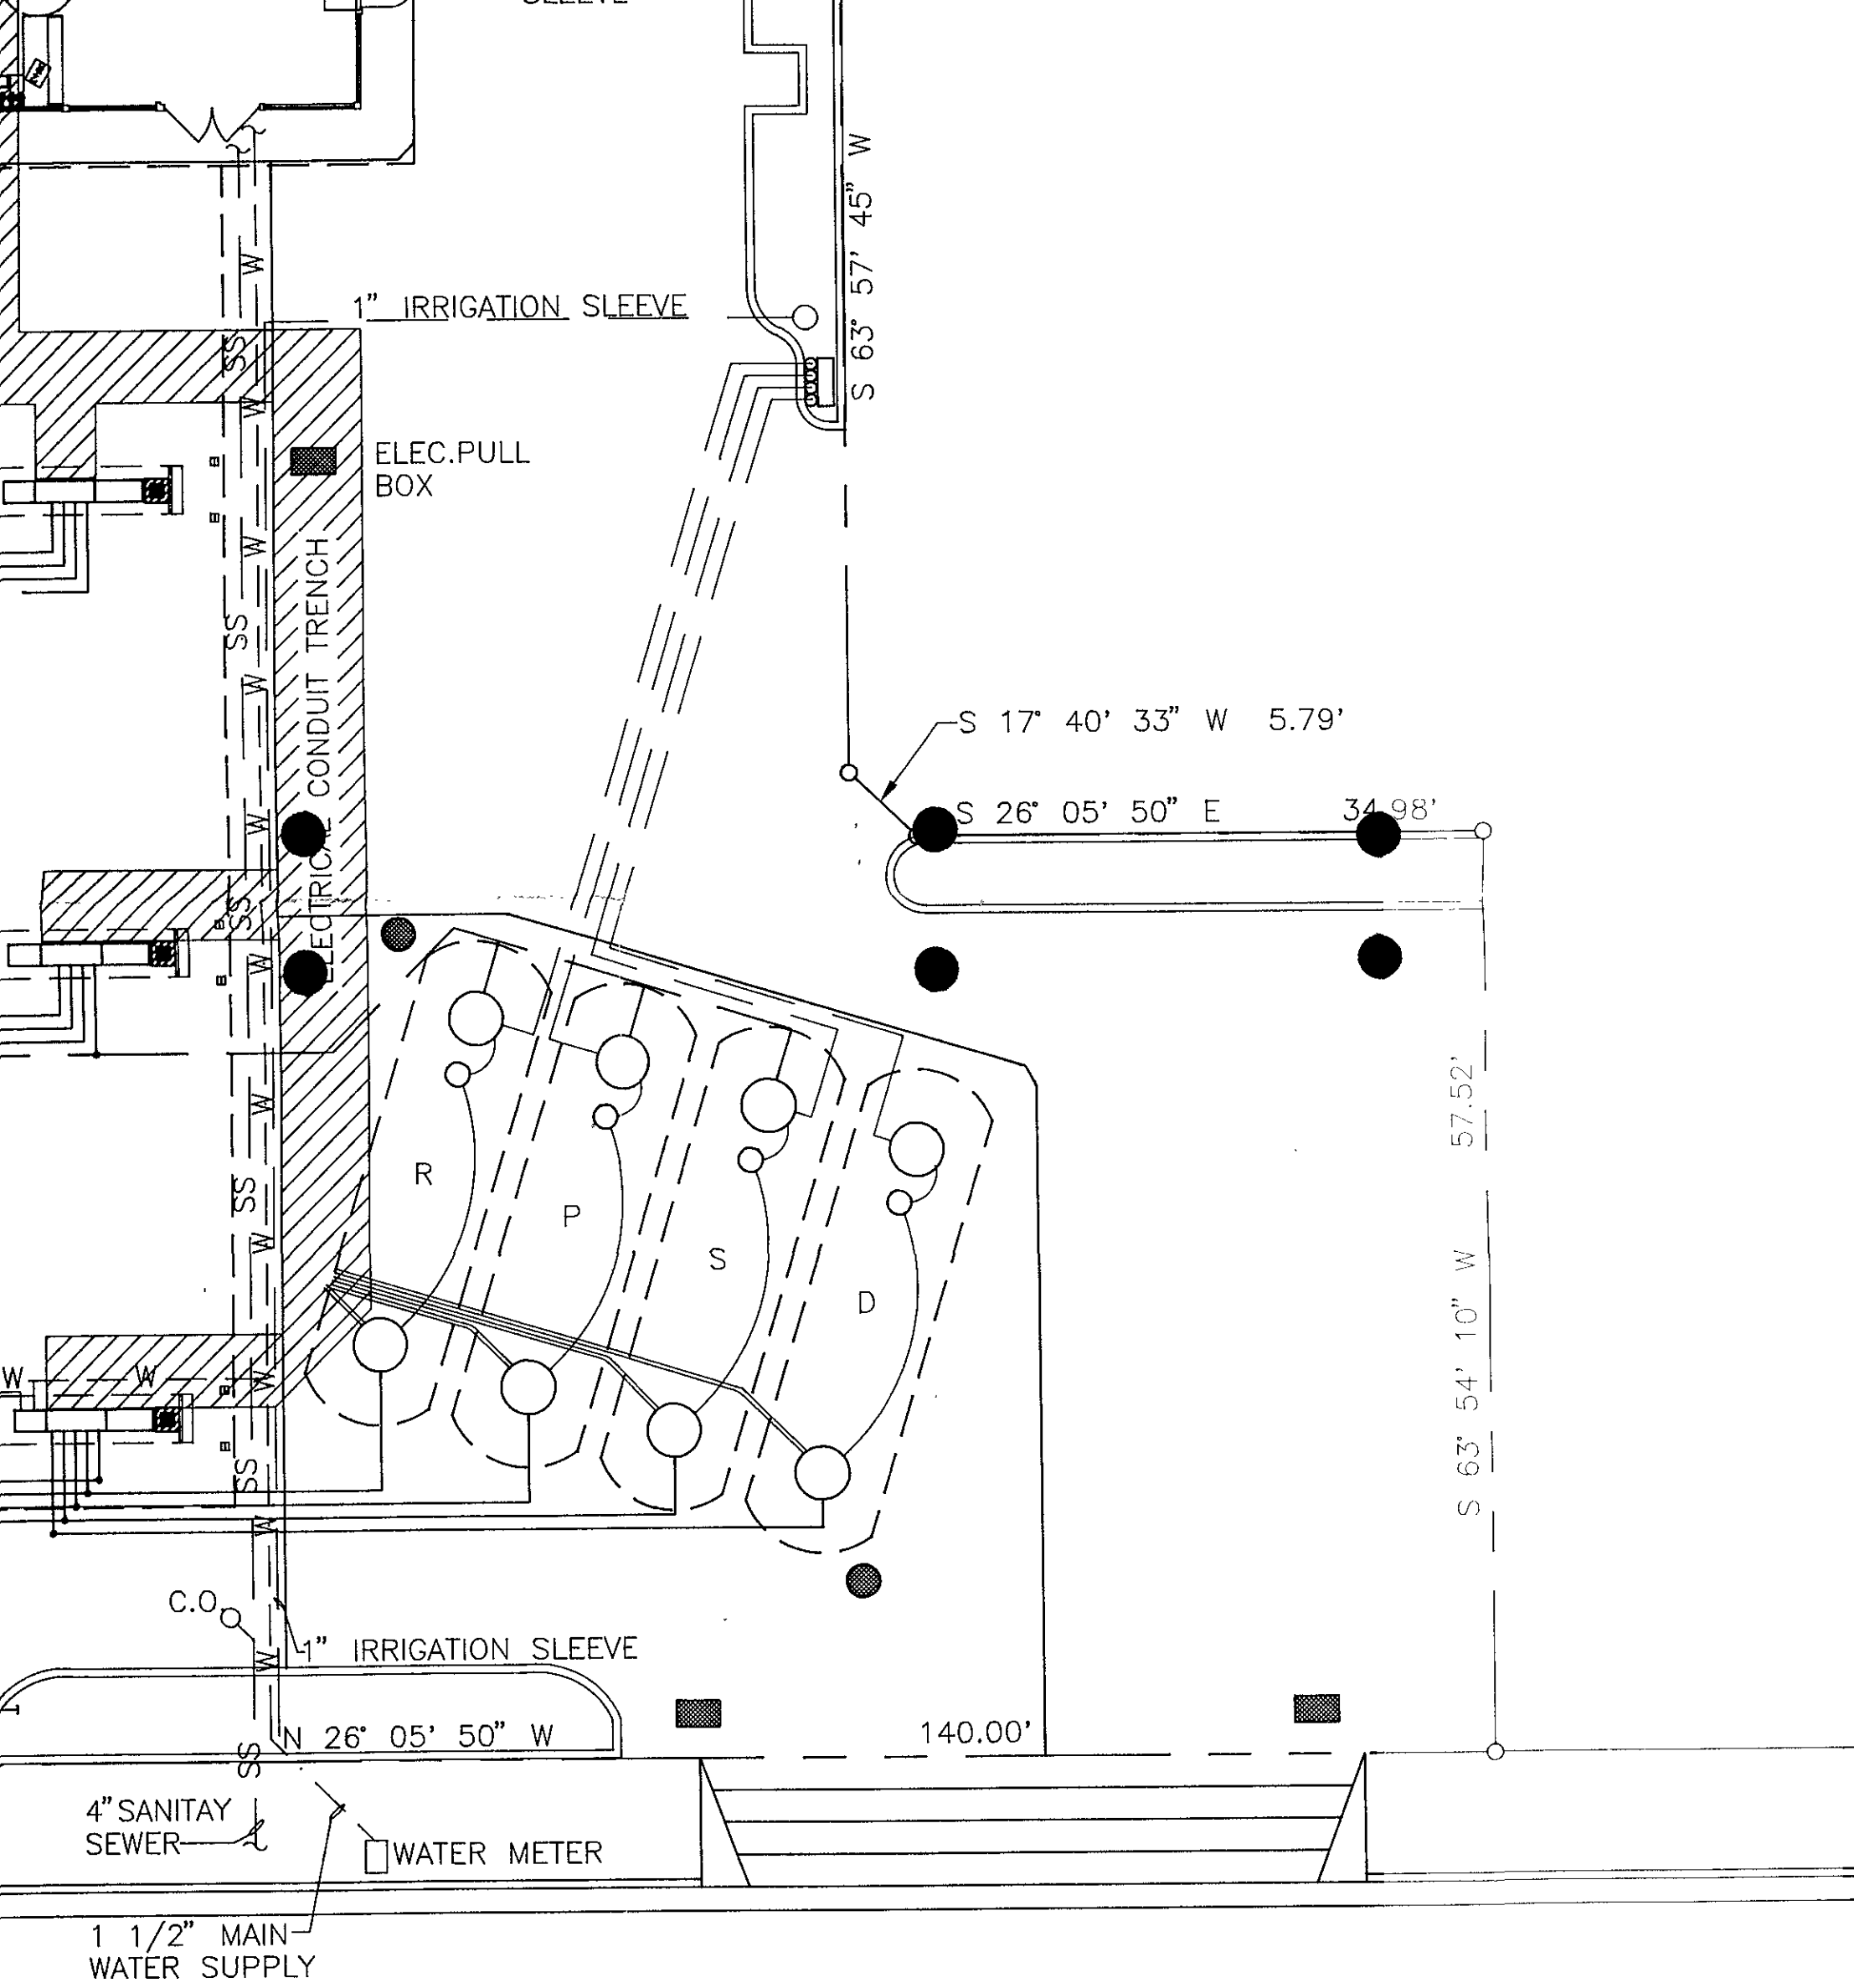

ERIAN BOULEVARD

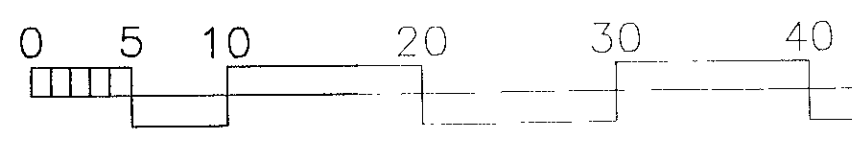

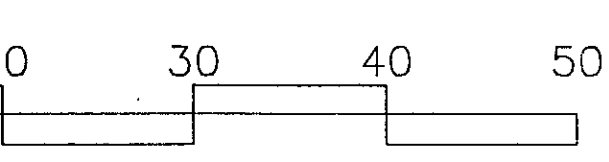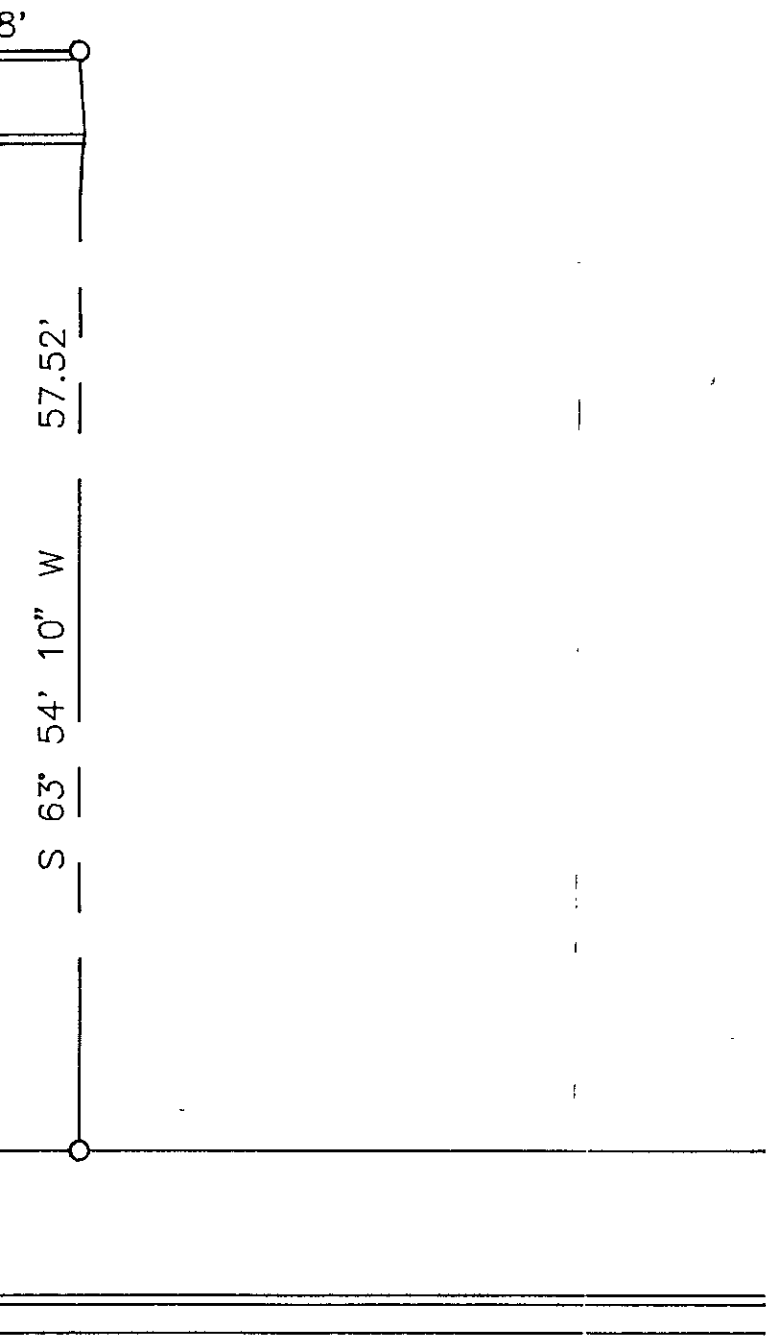

 Chevron Northwest Region		SITE PLAN	
		DEALER OPERATED 9-0504 15900 HESPERIAN BOULEVARD SAN LORENZO, CALIFORNIA	
REVISIONS			
△ AS CONSTRUCTED	06/30/94	HCH	
△			
△			
△			
△			
		SCALE: 1" = 10'-0" DATE: 06/30/94 DR. HCH CH. APP.	
		IF THIS DRAWING IS 11x17 SCALE 1" = 20'-0"	