

December 30, 1991

91 DEC 01 711 2: 33

Mr. Barney Chan Alameda County Health Department 80 Swan Way, Suite 200 Oakland, CA.

Dear Mr. Chan;

Re: Bioremediated soil sampling at 105th Avenue site, Oakland.

SJV consultants performed a sampling of bioremediated soil, at the subject site, on October 23, 1991. Two composite samples were obtained from five sampling points each. The samples were retrieved from approximately one-half the height of the pile and in the center of the pile (See attached Plate 1). The five samples were agitated and then a sample taken by filling a 2" x 6" clean brass tube. The tube was sealed with aluminum foil, capped, sealed with tape and labeled. Two composite samples were delivered to Chromolab, under proper Chain of Custody (See Appendix).

The results of this sampling indicate that the hydrocarbon content of the soils has been remarkably reduced with the southern half of the pile having the higher values (See Appendix).

It is our recommendation that this soil continue being remediated until it meets the standards of the regulatory agency for either removal or reuse on the site. I would expect that the regulatory agency might require a few more analysis to determine the leaching potential, or lack thereof, from the soil before approving the use on site.


If there are any questions concerning this matter please call Verl k. Rothlisberger at (510)-568-1234.

Sincerely Yours,

Verl K. Rothlisberger

President

753 Peralta Aue San Julandro ICA 1945 T 1445 | 568 | 1234 \* FAX | 568 | 2218 | 0245 Harrison #13 Far vega INV 86100 (702-705-0823 • • AX-736-2519

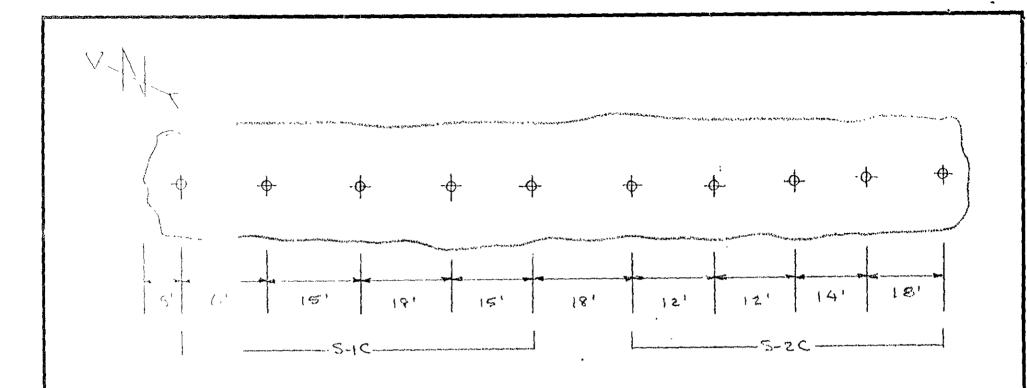

Soil Sa	MALINA LOCATION	ίω .
SCALE: Nami	APPROVED BY:	DRAWN BY L. Du.
DATE:   2-11-91	1	REVISED
MAYER	PROPERTIES 105 TH	
557 Con.	2 12 6 mg & 1.3 mg \$	DRAWING NUMBER

## CHROMALAB FILE # 1091208 ORDER # 3888

## CHAIN OF CUSTODY RECORD

SUV COMBULTANTS

PERSONNEL			SITE INFORMA	TION		
Sampler (Signature) 193-5366		Job Name V.CI.OFCA.  Job Number 0191030.00  Sample Location 105 TH AVE.				
Field Crew Superviso	er	-		REMEDIA		
Field Company 🤝		NESULTANTS				
Project Geologist/En	gineer <u>K</u>	A. MADELICAL	.○ P.O. Number	<del></del>		<u></u>
						والمستقل المستويد
Relinguished by (Stg	pature)	/ <b>~</b>   /11	ed by (Signature	_	Date 10/23/9/	Time /0'30
Relinquished by ((Sig	nature)	Receivi	ed by (Signature	)	Oate	Time
	. 1.1		danna) a gand i	.nor vocaint" coo	tion below	<u></u>
Analysi:	s laporatory	should complete sign, and reti	ing copy to Sh	ipper		
Sample Sample Number Type	No. of Cont.	Site Identification	Date Sampled	Analysis Requested		ole Cond.
5-10 Soic		COMPOSITE	10-23-91	TPHCD	<u> </u>	
5-10 Soil		· 11	10-23-91	FF 552	0	
5-21 Soil	1	((	10-23-91	TPH CP	<u>.                                    </u>	
5-26 Soil	1	14	10-23-91	5520	<u></u> -	
	1	<del></del>			<u></u>	
		<del></del>				
	<u></u>	<del></del>				
		<del></del>				
		<del></del>				
## CHROMALAB, INC.

Analytical Laboratory (E694)

October 30, 1991

ChromaLab File No.: 1091208

S.J.V. CONSULTANTS

Attn: K. A. Madenwald

RE: Two soil samples for Diesel and Oil & Grease analyses

Project Name: V.C.I. OF CA

Project Location: Bioremediation Pile

Project Number: 0191030.00

Date Sampled: Oct. 23, 1991 Date Submitted: Oct. 23, 1991 Date Extracted: Oct. 28, 1991 Date Analyzed: Oct. 28, 1991

RESULTS:

Sample I.D.	Diesel (mg/kg)	Oil & Grease (mg/kg)
S-1C	9.2	240
S-2C	57	340
BLANK	N.D.	N.D.
SPIKED RECOVERY	88.2%	<del></del>
DETECTION LIMIT	1.0	10
METHOD OF ANALYSIS	3550/8015	5520 E&F

ChromaLab, Inc.

David Duong

Chief Chemist

Eric Tam

Laboratory Director