
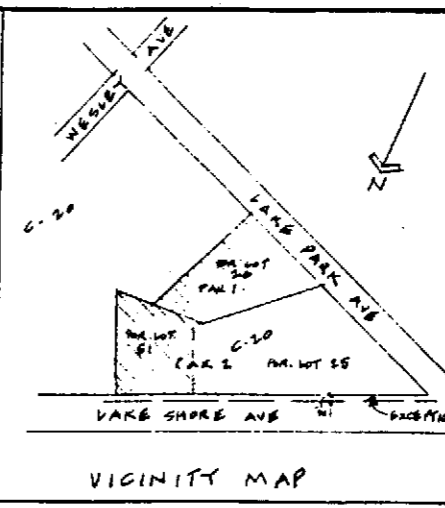


RECEIVED

2:02 pm, Mar 26, 2009

Alameda County
Environmental Health

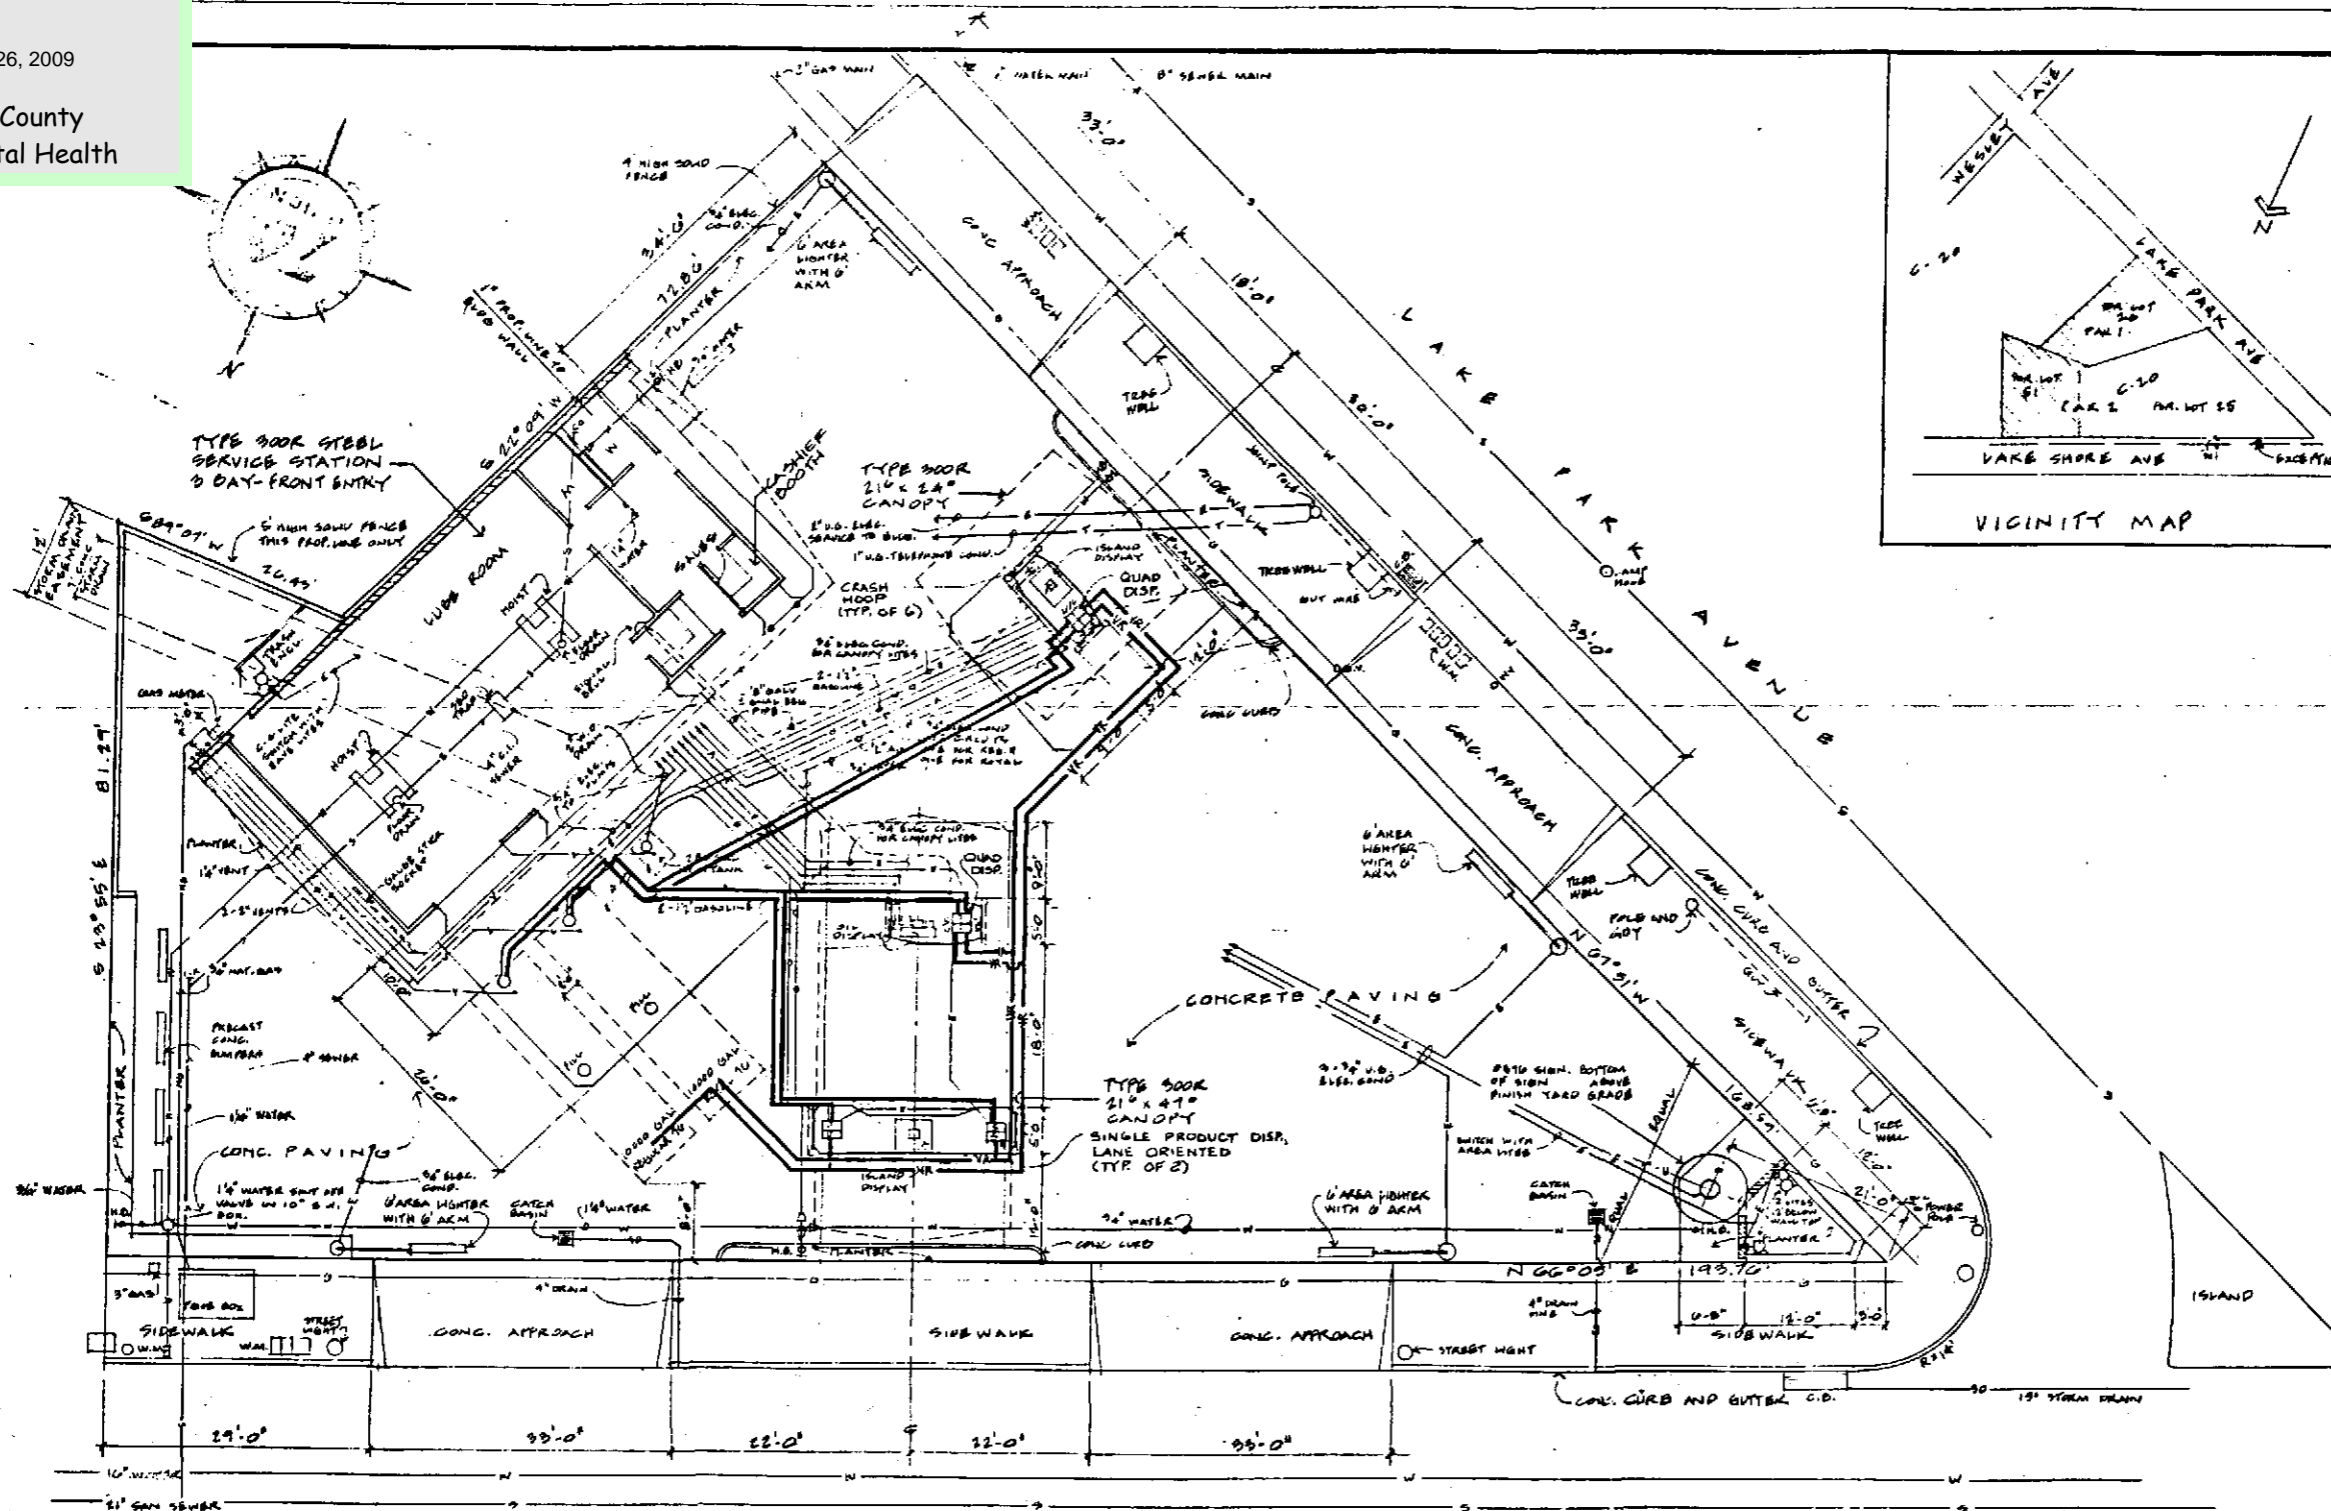

REFERENCE DRAWINGS			
NUMBER	SHEET	TITLE	DATE
10P499W	1-0	GENERAL SPECS. & SCOPE OF WORK	6-21-66
FS-5325	1-1	GENERAL ARRANGEMENT	"
"	1-2	MECHANICAL DRAWING	"
"	1-3	GRADING PLAN	"
"	1-4	CURBSET	5-9-66
10P499W	A-1	BUILDING ELEVATIONS & FINISH	6-21-66
"	A-1.1	" FLOOR PLAN	"
"	A-2	24' CANOPY PLAN & ELEVATIONS	3-18-64
"	A-2.1	41' "	"
"	B-0	CONCRETE SPECS.	1-1-66
"	B-1	BUILDING FOOTING PLAN	"
"	B-1.1	CONC. BLOCK WALL	"
"	B-2	BUILDING SLAB PLAN	2-1-66
"	B-3	YARD DETAILS	"
"	B-4	24' CANOPY FOUNDATION	4-26-66
"	B-4.1	41' "	5-24-66
"	C-0	STEEL SPECIFICATIONS	1-1-66
"	D-0	PUMPING	1-1-66
"	D-1.1	" PLAN	2-1-66
"	D-1.1	" DETAILS	"
"	E-0	ELECTRICAL SPECS.	1-1-66
"	E-1	" - BUDG. OVERHEAD	2-1-66
"	E-2	" - BUDG. UNDERGROUND	"
"	E-3	" - 24' CANOPY	"
"	E-3.1	" - 41' CANOPY	"
"	E-6	AREA LIGHTS	6-21-66
"	F-1.1	"	"
"	F-1.2	"	"
"	F-2	INTERIOR VENEER	2-1-66
"	G-2.1	HEATING	5-25-66
"	H-1	EQUIPMENT SPECS.	1-1-66
"	H-1.1	"	"
"	H-2	" - BUILDINGS	2-1-66
"	H-3	" - RESTROOMS	"
"	H-4	" - CABINETS	6-1-66
"	H-5	" - ISLANDS	2-1-66
"	H-6	"	4-1-66
"	J-1	PETROLEUM PIPING	2-1-66
"	K-0	EARTHWORK - ASPHALT PAVING	1-1-66
"	M-0	PAINTING SPECS.	1-1-66
"	M-0.1	"	"
"	M-1	" - BUILDING	2-1-66
"	M-2	" - 24' CANOPY	"
"	M-2.1	" - 41' CANOPY	"

NEW VAPOR RETURN LINE FROM DISPENSER TO TANK
REFER TO DING DRAWING-3, SHEETS A+B
"VAPOR RETURN SYSTEM SPEC." DATED 2/26/74 & DING DRAWING-3, SHEET C
"TYPICAL VAPOR RETURN SYSTEM" DATED 2/21/74



PROPERTY OWNED BY UNION OIL CO.
DONATED THUS: _____
DATE OF COMPLETION OCT. 12, 1966

WESTERN REGION BOX:
#9532

Store # 255325 Date: 12/4/64
Unit # 5325 Code: GEN Color
Description: GEN ARRANGEMENT

CONTRACTOR	CONTR. JOB NO.
GENERAL ARRANGEMENT SERVICE STATION 5325 LAKESHORE AVE + LAKE PARK AVE OAKLAND CALIFORNIA	
UNION OIL COMPANY OF CALIFORNIA LOS ANGELES, CALIF.	DRAWING NO. FB-5325-1.1

NUMBER	DATE	REVISIONS

DATE	REVISIONS	BY	CHKD
12-5-64	DRAWING CORRECTED: UNDERGROUND FACILITIES INSTALLED AS SHOWN		
5-24-74	ADDED V.E. LINES FROM DISPENSERS TO TANKS		
9-28-84	ADD CASHIER BOOTH		
11-20-84	CONC. PAVING - AS BUILT		
12-4-84	ISLAND EXTENSION + NEW DISPENSERS		

APPROVED FOR CONSTRUCTION
DATE: _____
DRAWN BY: WF
CHECKED BY: _____
TRACED BY: _____
SCALE: 1" = 10'
DATE: 2-8-66