



0.5

December 6, 2000

REPORT
of
SENSITIVE RECEPTORS SURVEY
and
AREA WELL SURVEY
for
2221 Union Street
Oakland, CA

Submitted by:
AQUA SCIENCE ENGINEERS, INC.
208 West El Pintado
Danville, CA 94526
(925) 820-9391

ENVIRONMENTAL
PROTECTION
00 DEC 11 PM 4:17

1.0 INTRODUCTION

This report presents Aqua Science Engineers Inc. (ASE)'s sensitive receptor survey and area well survey at 2221 Union Street Oakland California (*Figure 1*). This survey was requested by the Alameda County Health Care Services Agency (ACHSCA).

2.0 SCOPE OF WORK

ASE's scope of work for this project was as follows:

- 1) Review all available records from the California Department of Water Resources (DWR) and the Alameda County Public Works Agency (ACPWA) to determine the location, use and construction of any wells located within a 1,000-foot radius of the site.
- 2) Contact the City of Oakland and public utility companies to locate any underground utilities within the 1,000-foot radius that could possibly act as conduits for groundwater contamination.
- 3) Prepare maps and tables showing the locations and construction of wells in the site vicinity.
- 4) Prepare maps showing the location of underground utilities in the site vicinity.

3.0 RECORD SEARCH

3.1 DWR and ACPWA

All available records at the DWR office in Sacramento and the ACPWA were reviewed for township, range, and sections within the vicinity of the site. A total of twenty-five (25) Water Well Drilling Reports were on file that are located within the 1,000-foot radius of the site. The locations of all the wells within the 1,000-foot radius are presented on *Figure 2* and detailed in *Table One*. The DWR reports for the wells located within the 1,000-foot radius are presented in *Appendix A*.

4.0 UNDERGROUND UTILITY SEARCH

4.1 City of Oakland, Public Works Department

ASE reviewed the storm and sewer sheets at the City of Oakland Public Works Department offices. The locations of the storm and sewer lines within the 1,000-foot radius of the site and are presented as *Figure 3*. The depth of these conduits ranges between approximately 5-10-feet below ground surface (bgs) approximately

4.2 Pacific Gas and Electric Company (PG&E)

ASE reviewed the natural gas and underground electric conduit maps at PG&E. The locations of the natural gas and electric conduits within the 1,000-foot radius of the site and are presented as *Figures 4 and 5* respectively.

4.3 East Bay Municipal Utility District (EBMUD)

ASE reviewed the water conduit locations at EBMUD. The locations of the water conduits within the 1,000-foot radius of the site are located on *Figure 6*.

5.0 SUMMARY OF WELLS SURROUNDING SITE

A total of twenty-five (25) wells are located to be within a 1,000-foot radius of the site. Fourteen (14) of the located wells are used for monitoring purposes. Nine (9) of the wells are peizometers and one (1) well is used for industrial purposes. Three (3) other wells were reported as being destroyed. The location of all the wells identified are shown on *Figure 2*, and known details of the wells are tabulated in *Table One*. It should be noted that there were no municipal or domestic drinking water wells located within the 1,000-foot radius of the site.

6.0 GROUNDWATER ELEVATION AND GRADIENT

The annual fluctuation of groundwater at the site is between 3.06 and 8.81-feet bgs, and the average depth to groundwater at the site is 5.2-feet bgs. The depth to water and groundwater elevation data are presented in *Table Two*. The groundwater flow at the site has fluctuated from the west to northeast with a predominant flow to the northeast at an average gradient of 0.024 feet/foot. A groundwater elevation (potentiometric surface) map and rose diagram are presented as *Figure 7*.

7.0 SUMMARY OF POTENTIAL IMPACT TO RECEPTORS WITHIN THE SITE VICINITY

There are no domestic/municipal drinking water wells or bodies of surface water (potential sensitive receptors) within the site vicinity.

The depth of the storm and sewer lines ranges between 5-10-feet bgs approximately. The depth of the electric and gas lines ranges between 3-5-feet bgs. The depth of the water lines ranges between 3-7-feet bgs.

The exact location of the site's subsurface utilities are unknown because the site is almost completely surfaced with reinforced concrete making it difficult to locate these on-site underground utilities. Based on the average depth to water and gradient at the site, and the depth range of the individual utility conduits, ASE believes that it is possible that some downgradient conduits lie below the water table.

8.0 REPORT LIMITATIONS

This sensitive receptors survey and area well survey presents all data available to ASE at the time this survey was completed. It is possible that other wells may exist within the study area which could not be located and that some records may exist that were not made available to ASE. This report was completed to meet the requirements outlined in the scope of work. It does not appear to be possible to obtain additional details of the well construction of the wells presented in this report without physically opening the individual wells and conducting tests on the wells.


Aqua Science Engineers appreciates the opportunity to assist Mr. Kendall with their environmental needs. Should you have any questions or comments, please feel free to call us at (925) 820-9391.

Respectfully submitted,

AQUA SCIENCE ENGINEERS, INC.



Ian Reed
Associate Geologist

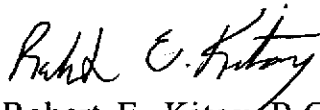

Robert E. Kitay, R.G., R.E.A.
Senior Geologist




Attachments: Figures 1 to 7
 Appendix A

*
TABLE ONE
AREA WELL SURVEY
1,000-FOOT RADIUS
2221 UNION STREET
OAKLAND, CA

ADDRESS	WELL USE	OWNER	DATE INSTALLED	DEPTH OF WELL (FEET)	FIGURE 2 REFERENCE NUMBER
1218 24TH Street	Monitoring	Tim Williams	03/01/89	30	1
1218 24th Street	Monitoring	Northwestern Venetian Blind	03/01/89	25	1
1218 24th Street	Monitoring	Northwestern Venetian Blind	10/01/89	26	1
1218 24th Street	Monitoring	Northwestern Venetian Blind	10/01/89	26	1
2210 Union Street	Monitoring	Alex Guidotti	09/01/90	Unknown	2
2311 Adeline Street	Monitoring	Ned Clyde Construction	01/01/89	17	3
2311 Adeline Street	Monitoring	Ned Clyde Construction	01/01/89	17	3
2311 Adeline Street	Piezometer	Ned Clyde Construction	03/01/89	Unknown	3
2311 Adeline Street	Piezometer	Ned Clyde Construction	03/01/89	Unknown	3
2311 Adeline Street	Piezometer	Ned Clyde Construction	03/01/89	Unknown	3
2311 Adeline Street	Piezometer	Ned Clyde Construction	04/01/89	Unknown	3
2311 Adeline Street	Piezometer	Ned Clyde Construction	05/01/89	Unknown	3
2311 Adeline Street	Piezometer	Ned Clyde Construction	05/01/89	Unknown	3
2311 Adeline Street	Piezometer	Ned Clyde Construction	05/01/89	Unknown	3
2311 Adeline Street	Piezometer	Ned Clyde Construction	05/01/89	Unknown	3
2311 Adeline Street	Industrial	Ned Clyde Construction	05/01/89	Unknown	3
2311 Adeline Street	Monitoring	Ned Clyde Construction	01/01/89	17	3
2311 Magnolia Street	Destroyed	Aldo Guidotti	11/01/92	15	4
2311 Magnolia Street	Destroyed	Aldo Guidotti	11/01/92	15	4
2311 Magnolia Street	Destroyed	Aldo Guidotti	11/01/92	15	4
2433 Poplar Street	Monitoring	Findley Adhesive	03/01/95	10	5
2433 Poplar Street	Monitoring	Findley Adhesive	03/01/95	8	5
2452 Magnolia Street	Monitoring	Bonta Collins	09/01/89	21	6
2452 Magnolia Street	Monitoring	Bonta Collins	02/01/89	20	6
2730 Peralta Street	Monitoring	Custom Alloy	10/01/90	Unknown	7
2730 Peralta Street	Monitoring	Custom Alloy	10/01/90	Unknown	7

TABLE TWO
Groundwater Elevation Data
2221 Union Street, Oakland, California

WELL ID	DATE OF MEASUREMENT	TOP OF CASING ELEVATION IN FEET (MSL)	DEPTH TO WATER (feet)	GROUNDWATER ELEVATION IN FEET (MSL)
MW-1	9/2/99	15.00	8.81	6.19
	11/2/99		5.94	9.06
	11/4/99		7.15	7.85
	11/9/99		4.72	10.28
	2/7/00		3.55	11.45
	5/16/00		3.88	11.12
	8/8/00		5.79	9.21
MW-2	9/2/99	15.29	6.29	9.00
	11/2/99	15.24	6.01	9.23
	11/4/99		5.94	9.30
	11/9/99		5.28	9.96
	2/7/00		4.12	11.12
	5/16/00		4.24	11.00
	8/8/00		5.68	9.56
MW-3	9/2/99	15.15	6.26	8.89
	11/2/99	15.17	5.74	9.43
	11/4/99		6.09	9.08
	11/9/99		5.64	9.53
	2/7/00		3.06	12.11
	5/16/00		3.80	11.37
	8/8/00		3.54	11.63
MW-4	11/2/99	15.21	5.86	9.35
	11/4/99		5.85	9.36
	11/9/99		4.56	10.65
	2/7/00		3.66	11.55
	5/16/00		3.89	11.32
	8/8/00		5.77	9.44

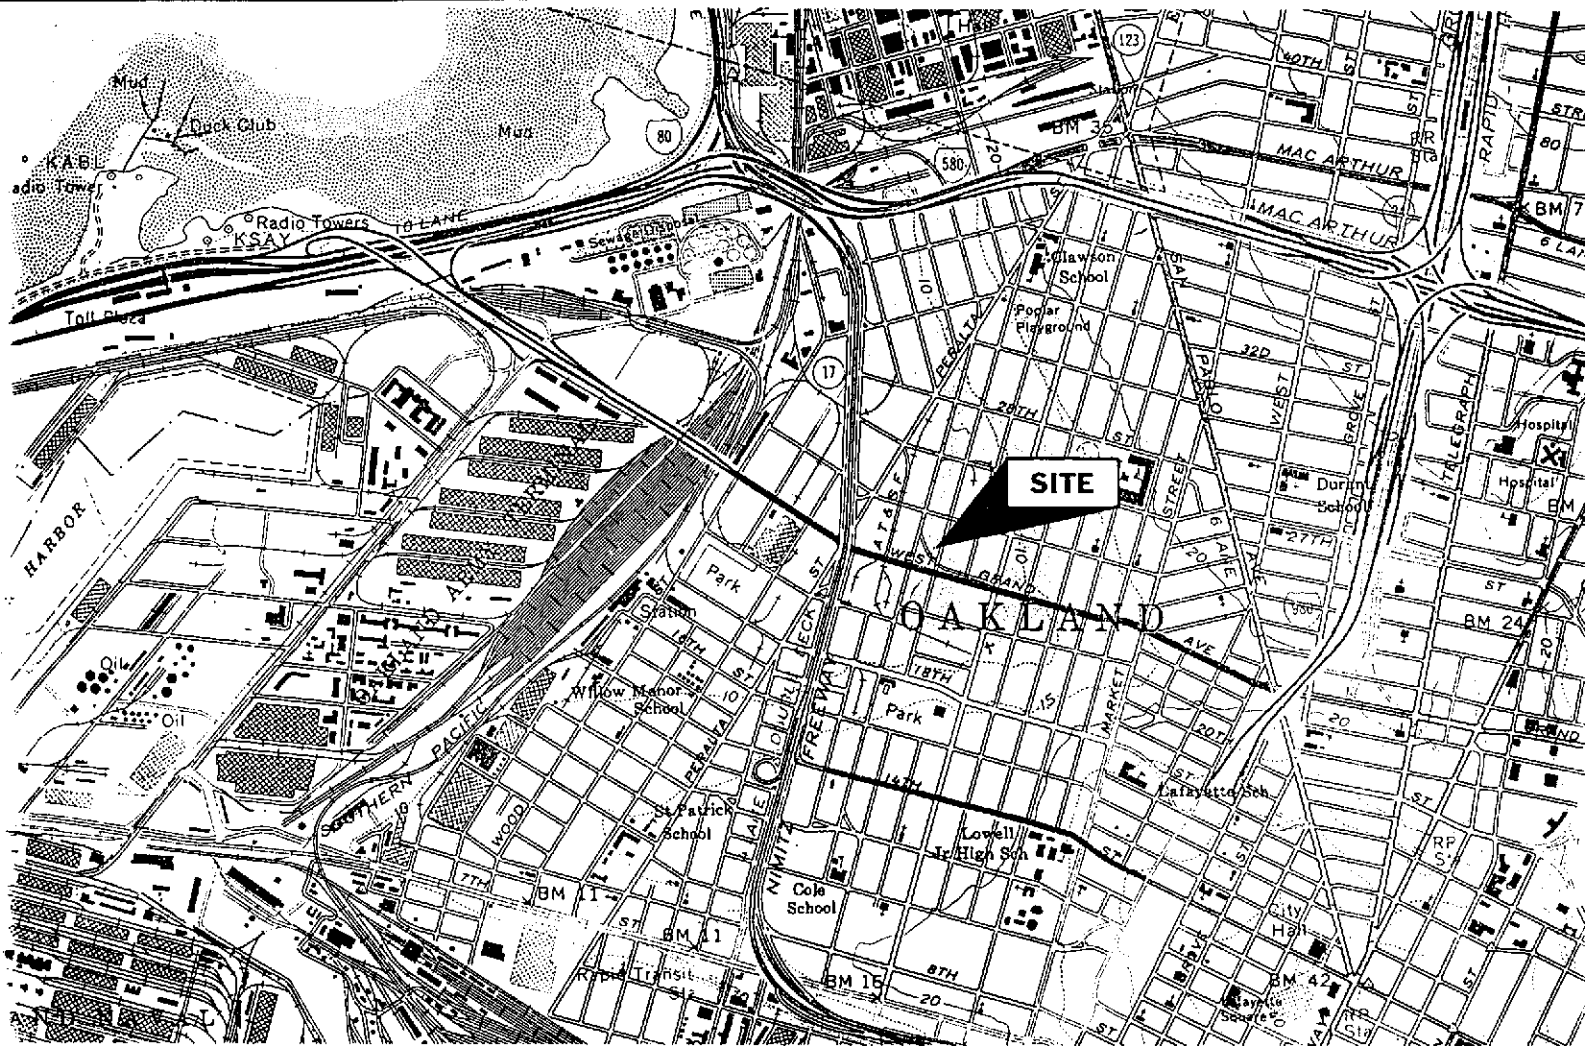


NORTH

LOCATION MAP

2221 Union Street
Oakland, California

AQUA SCIENCE ENGINEERS, INC. Figure 1

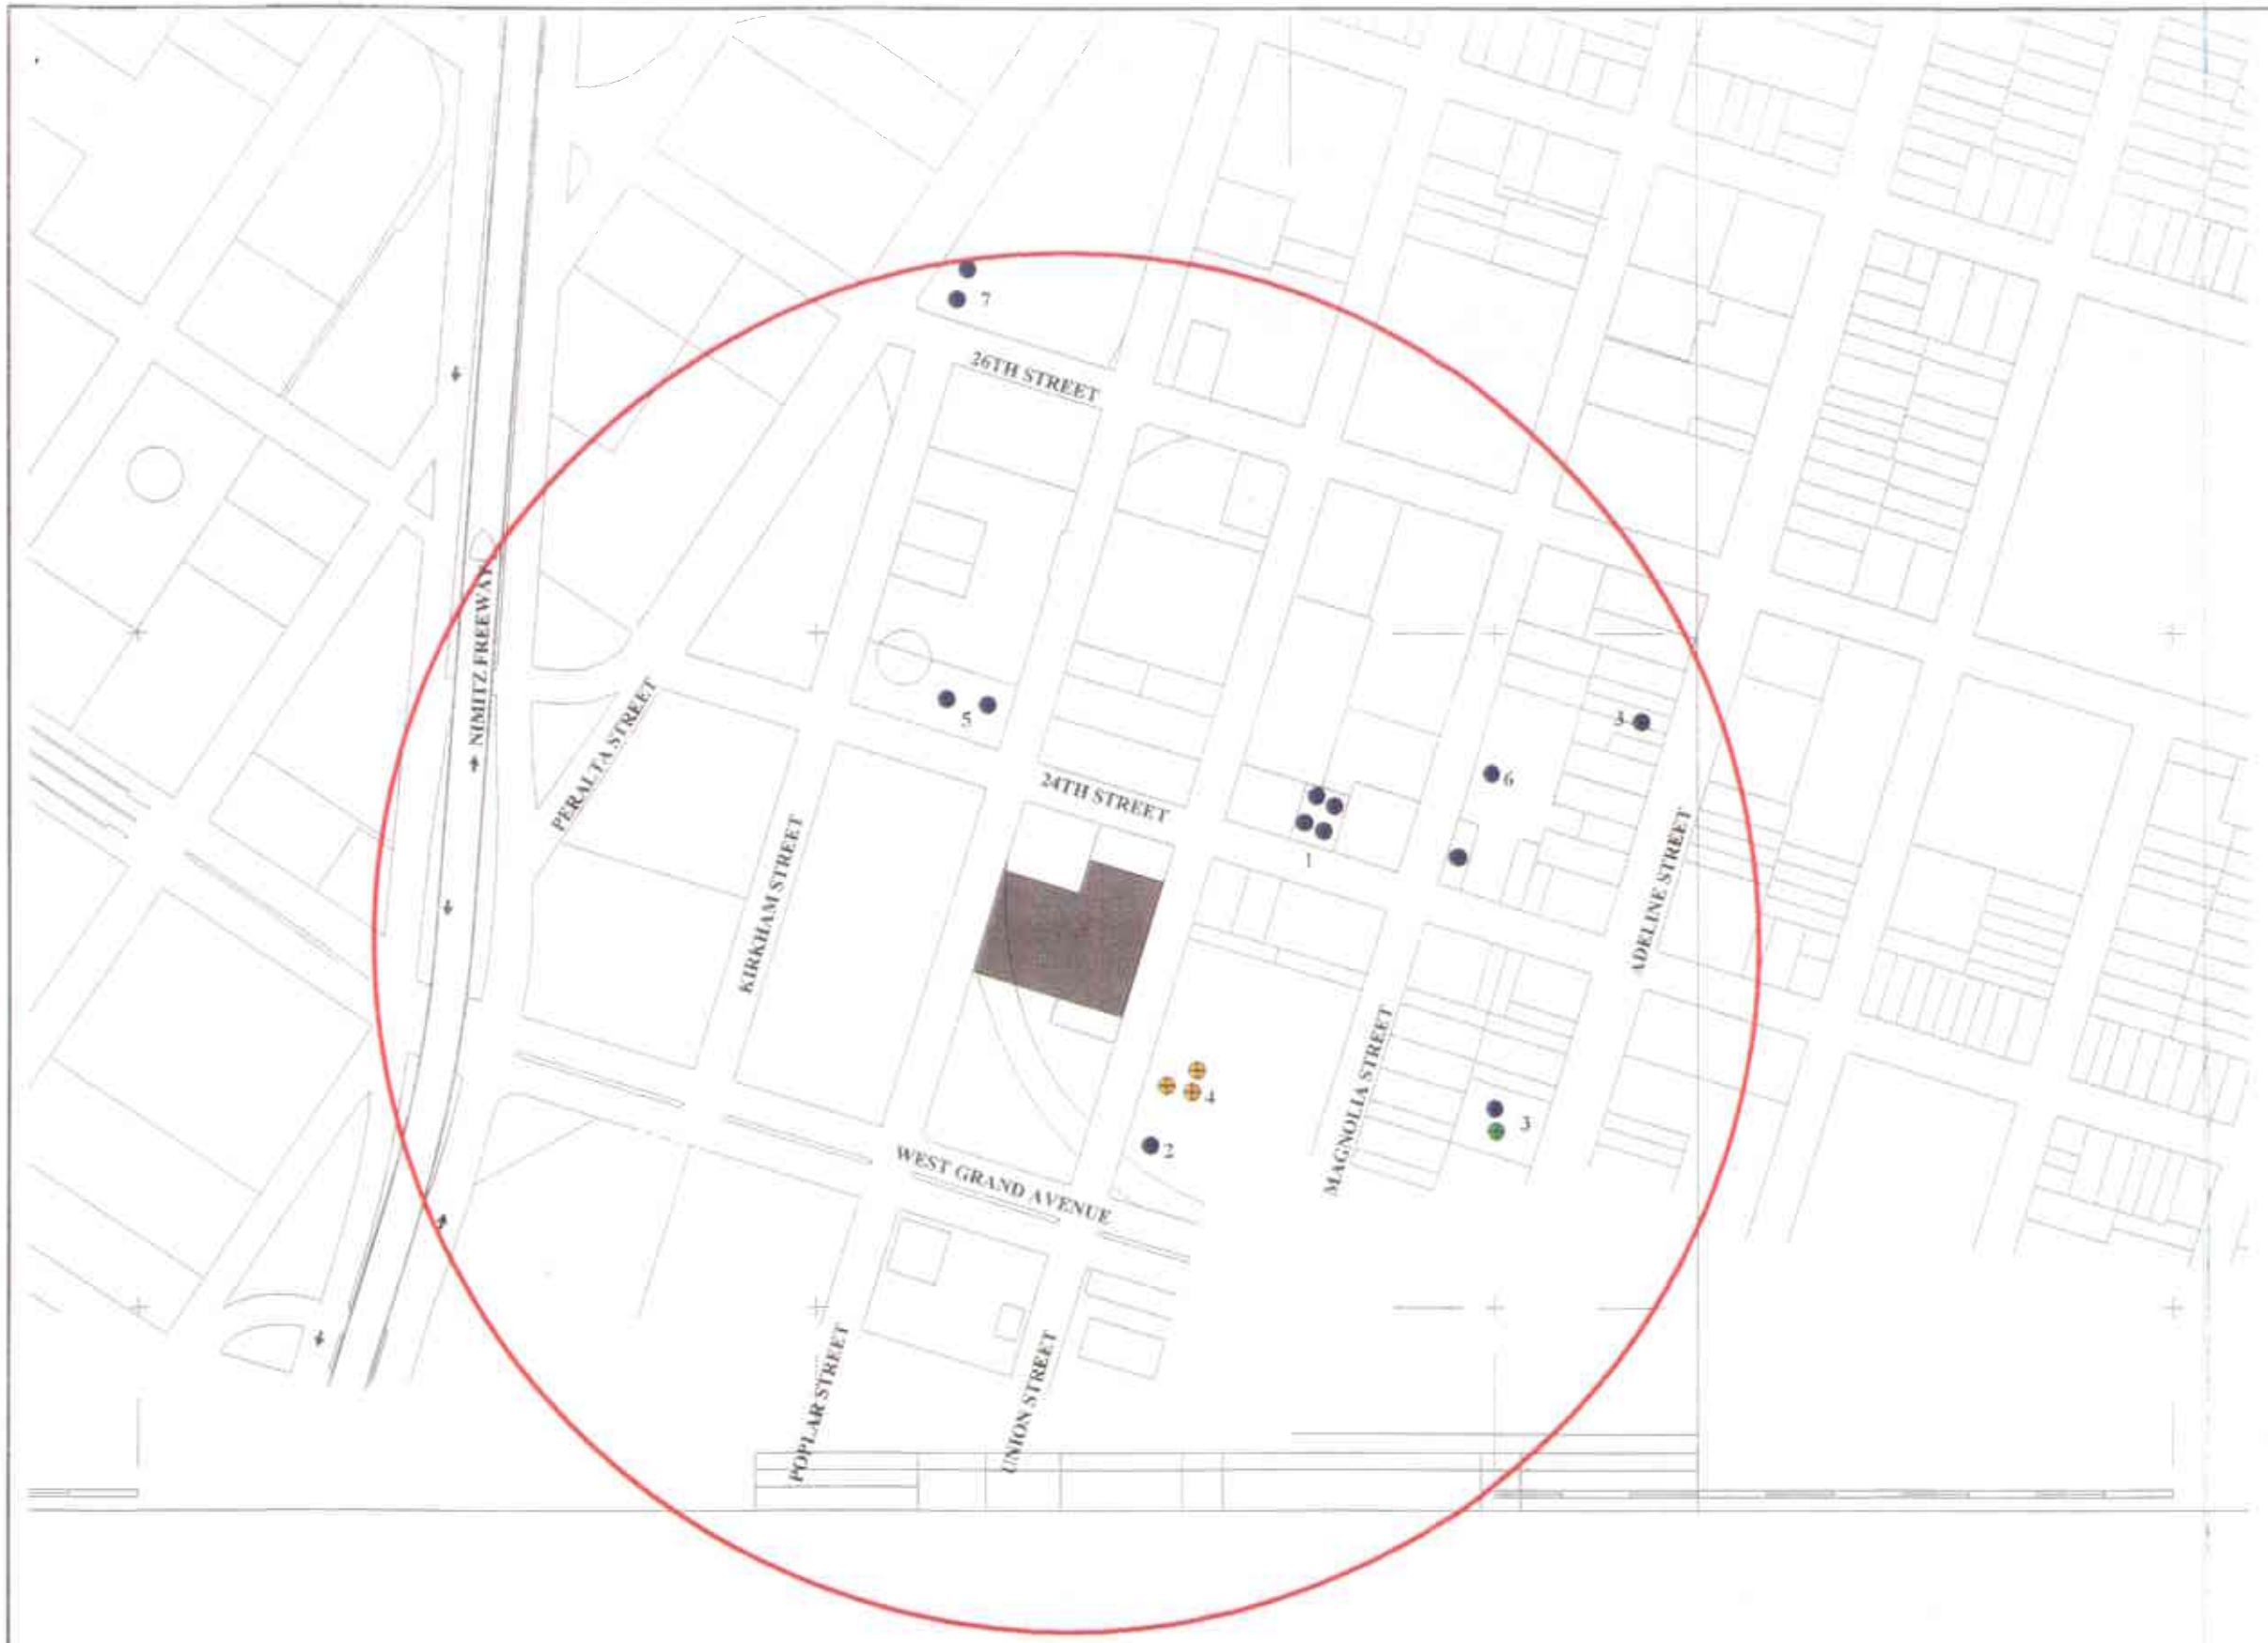

WELLS

- Industrial
- Destroyed
- Monitoring
- Peizometer

Locations are Approximate


- Site of Concern
- 1,000 Foot Radius

SCALE




**AREA WELL SURVEY
1,000 FOOT RADIUS**

**2221 UNION STREET
OAKLAND, CA**

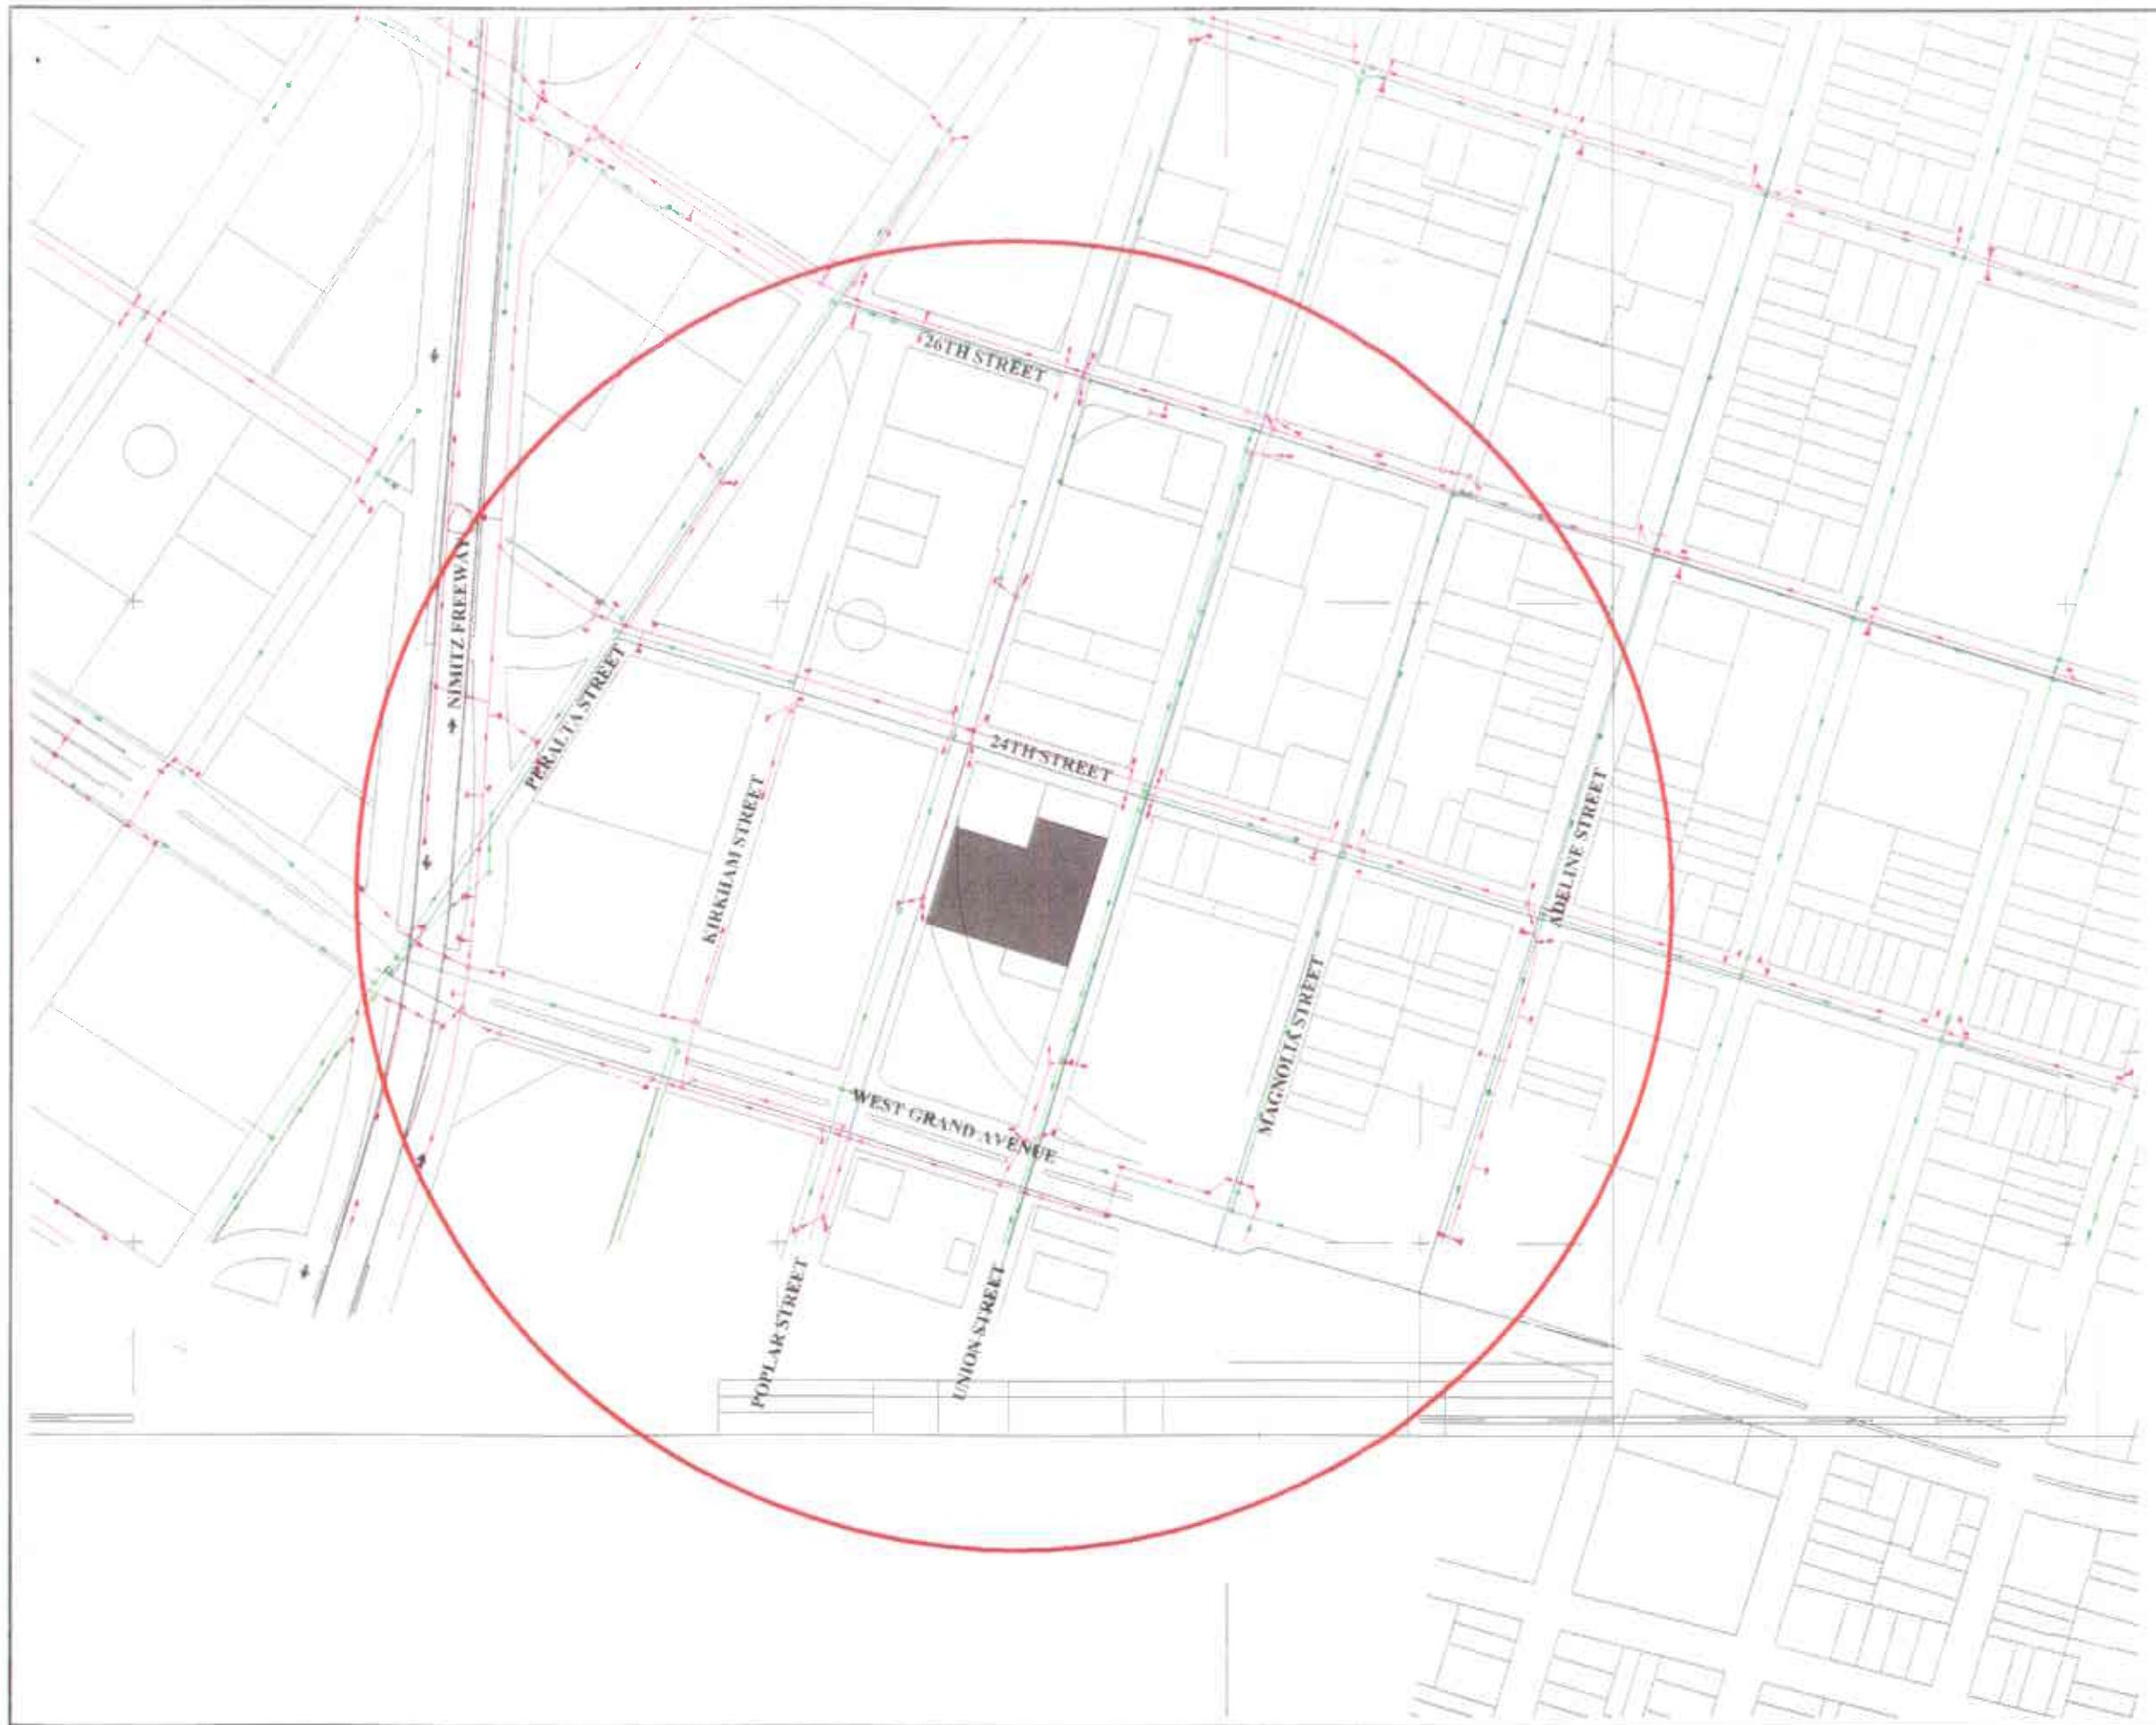

Sewer Conduits

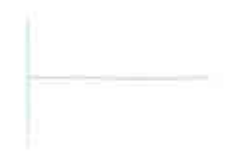


Storm Conduits



Locations are Approximate



Site of Concern

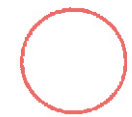


1,000 Foot Radius

SCALE



LOCATION OF SEWER AND STORM CONDUITS

**2221 UNION STREET
OAKLAND, CA**

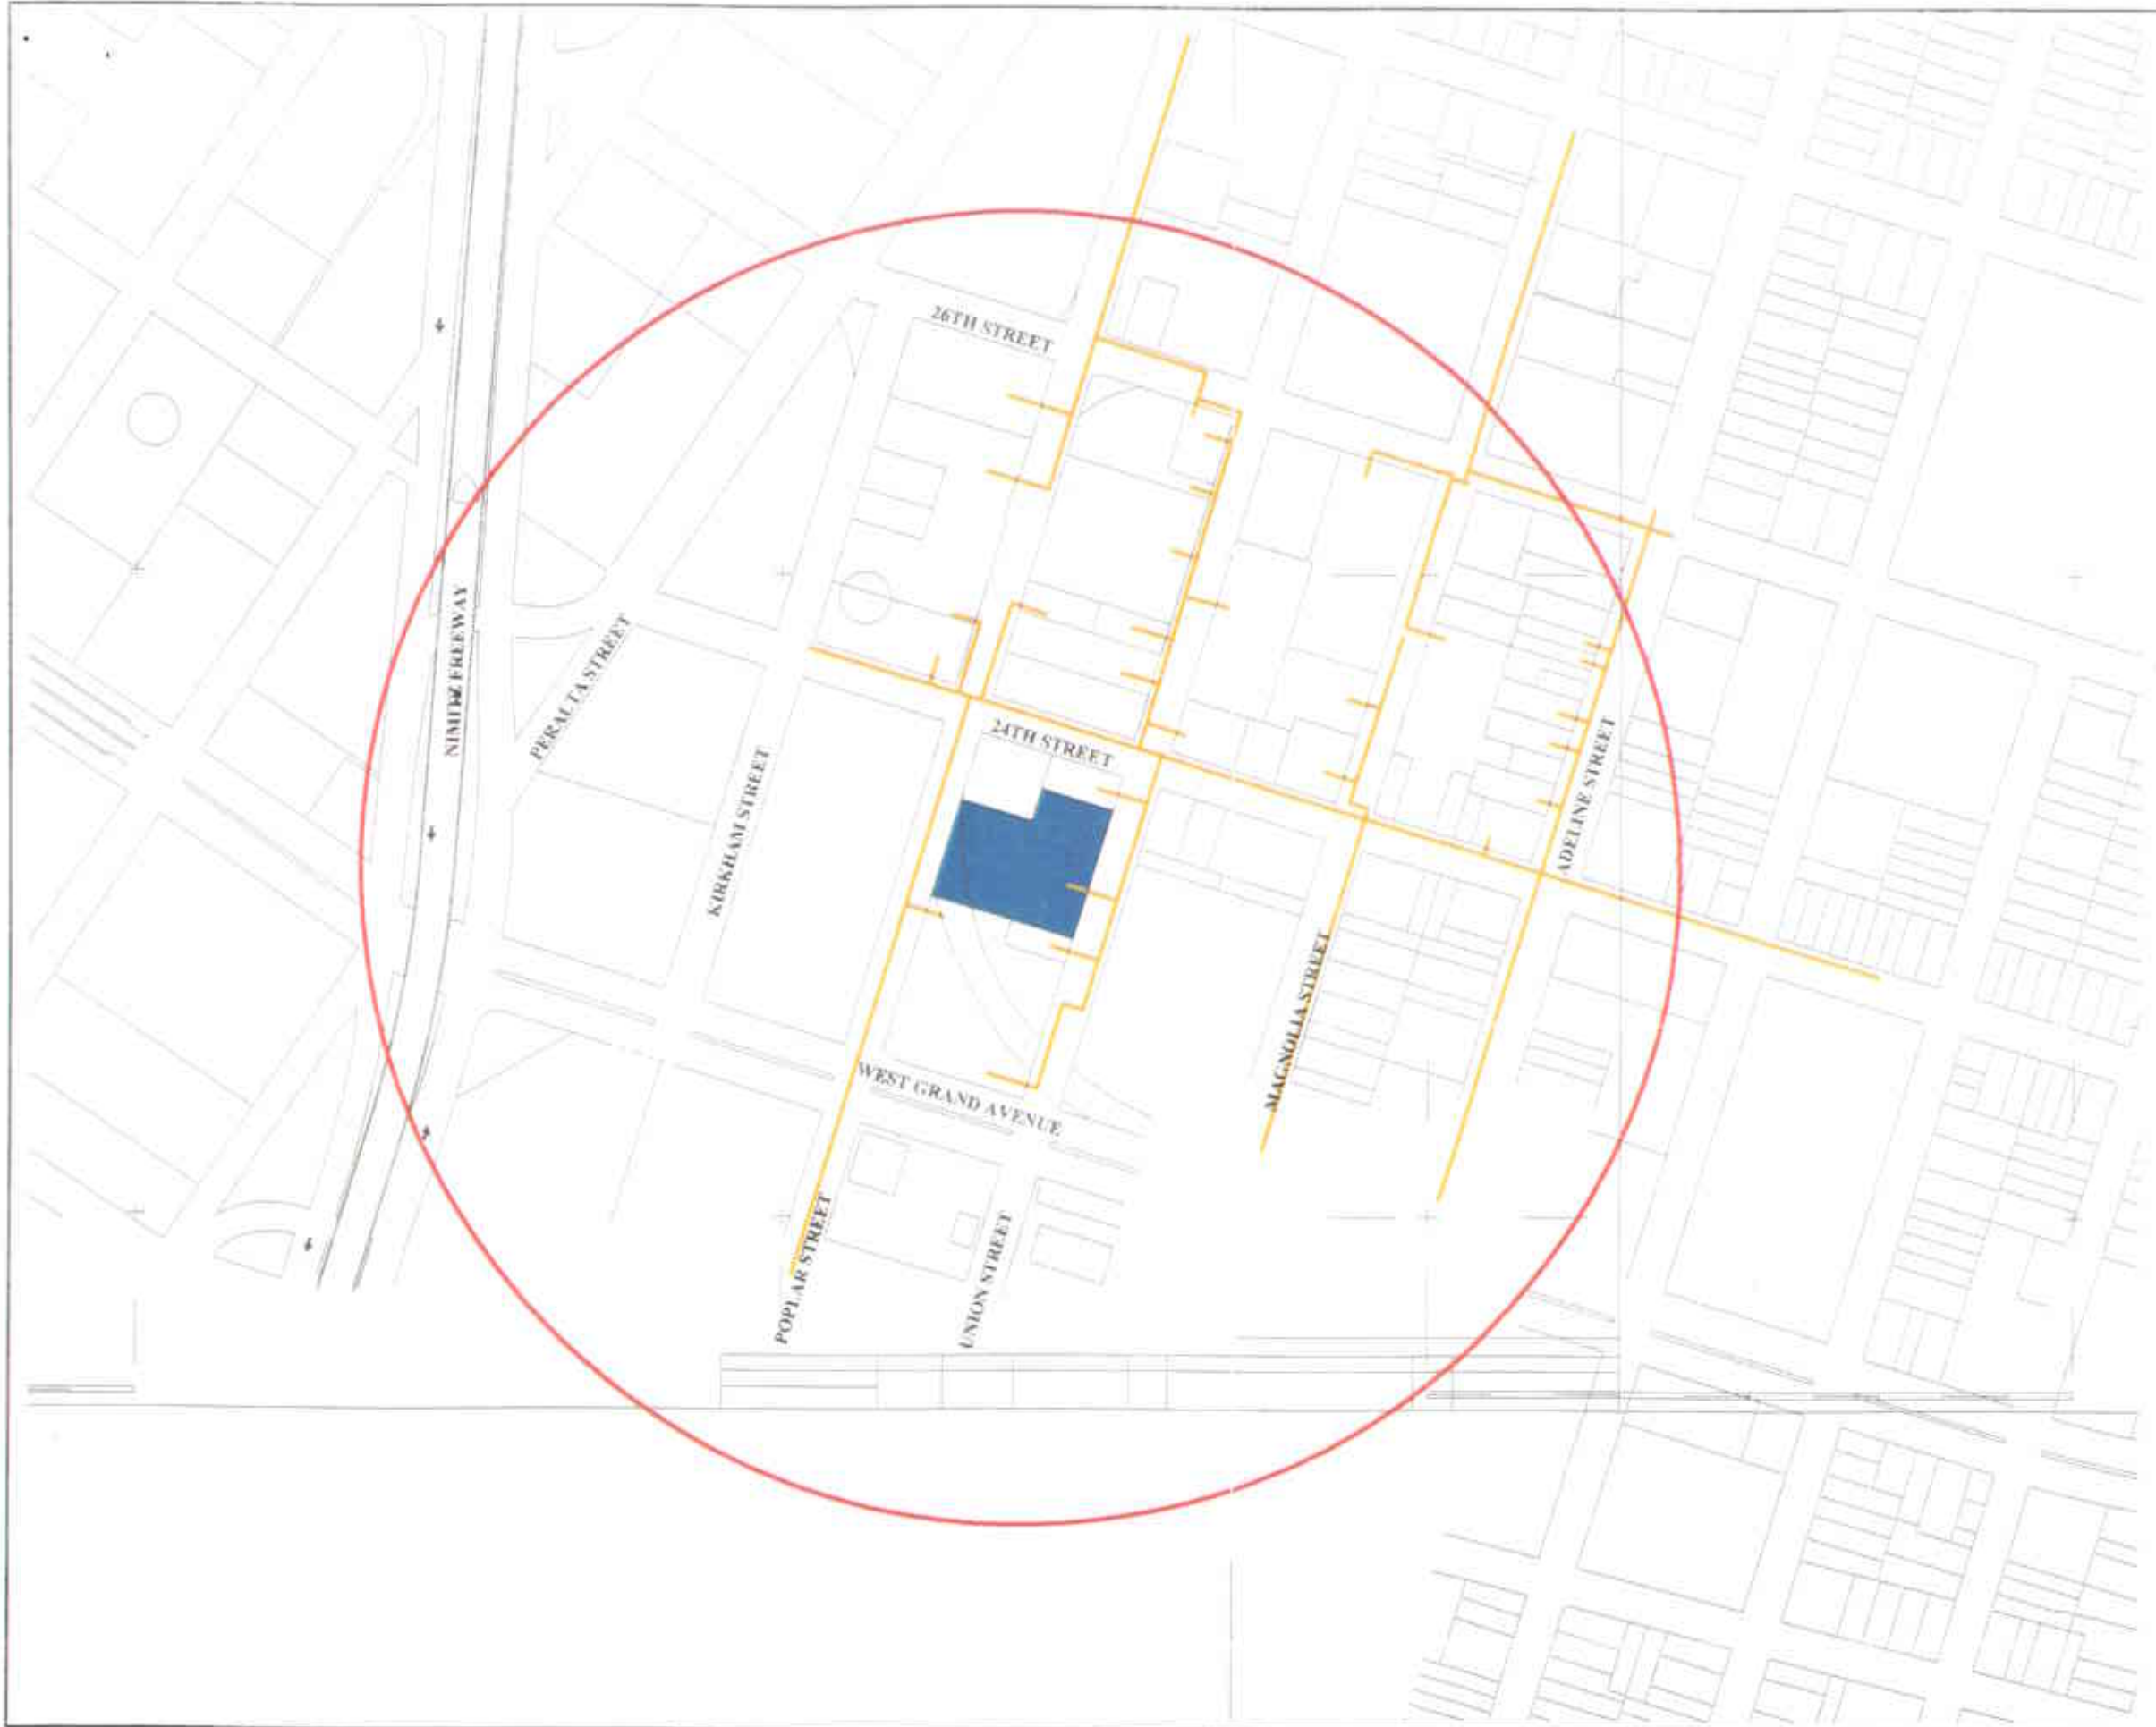

Gas Conduits



Locations are Approximate



Site of Concern




1,000 Foot Radius

SCALE




**LOCATION OF
GAS CONDUITS**

**2221 UNION STREET
OAKLAND, CA**

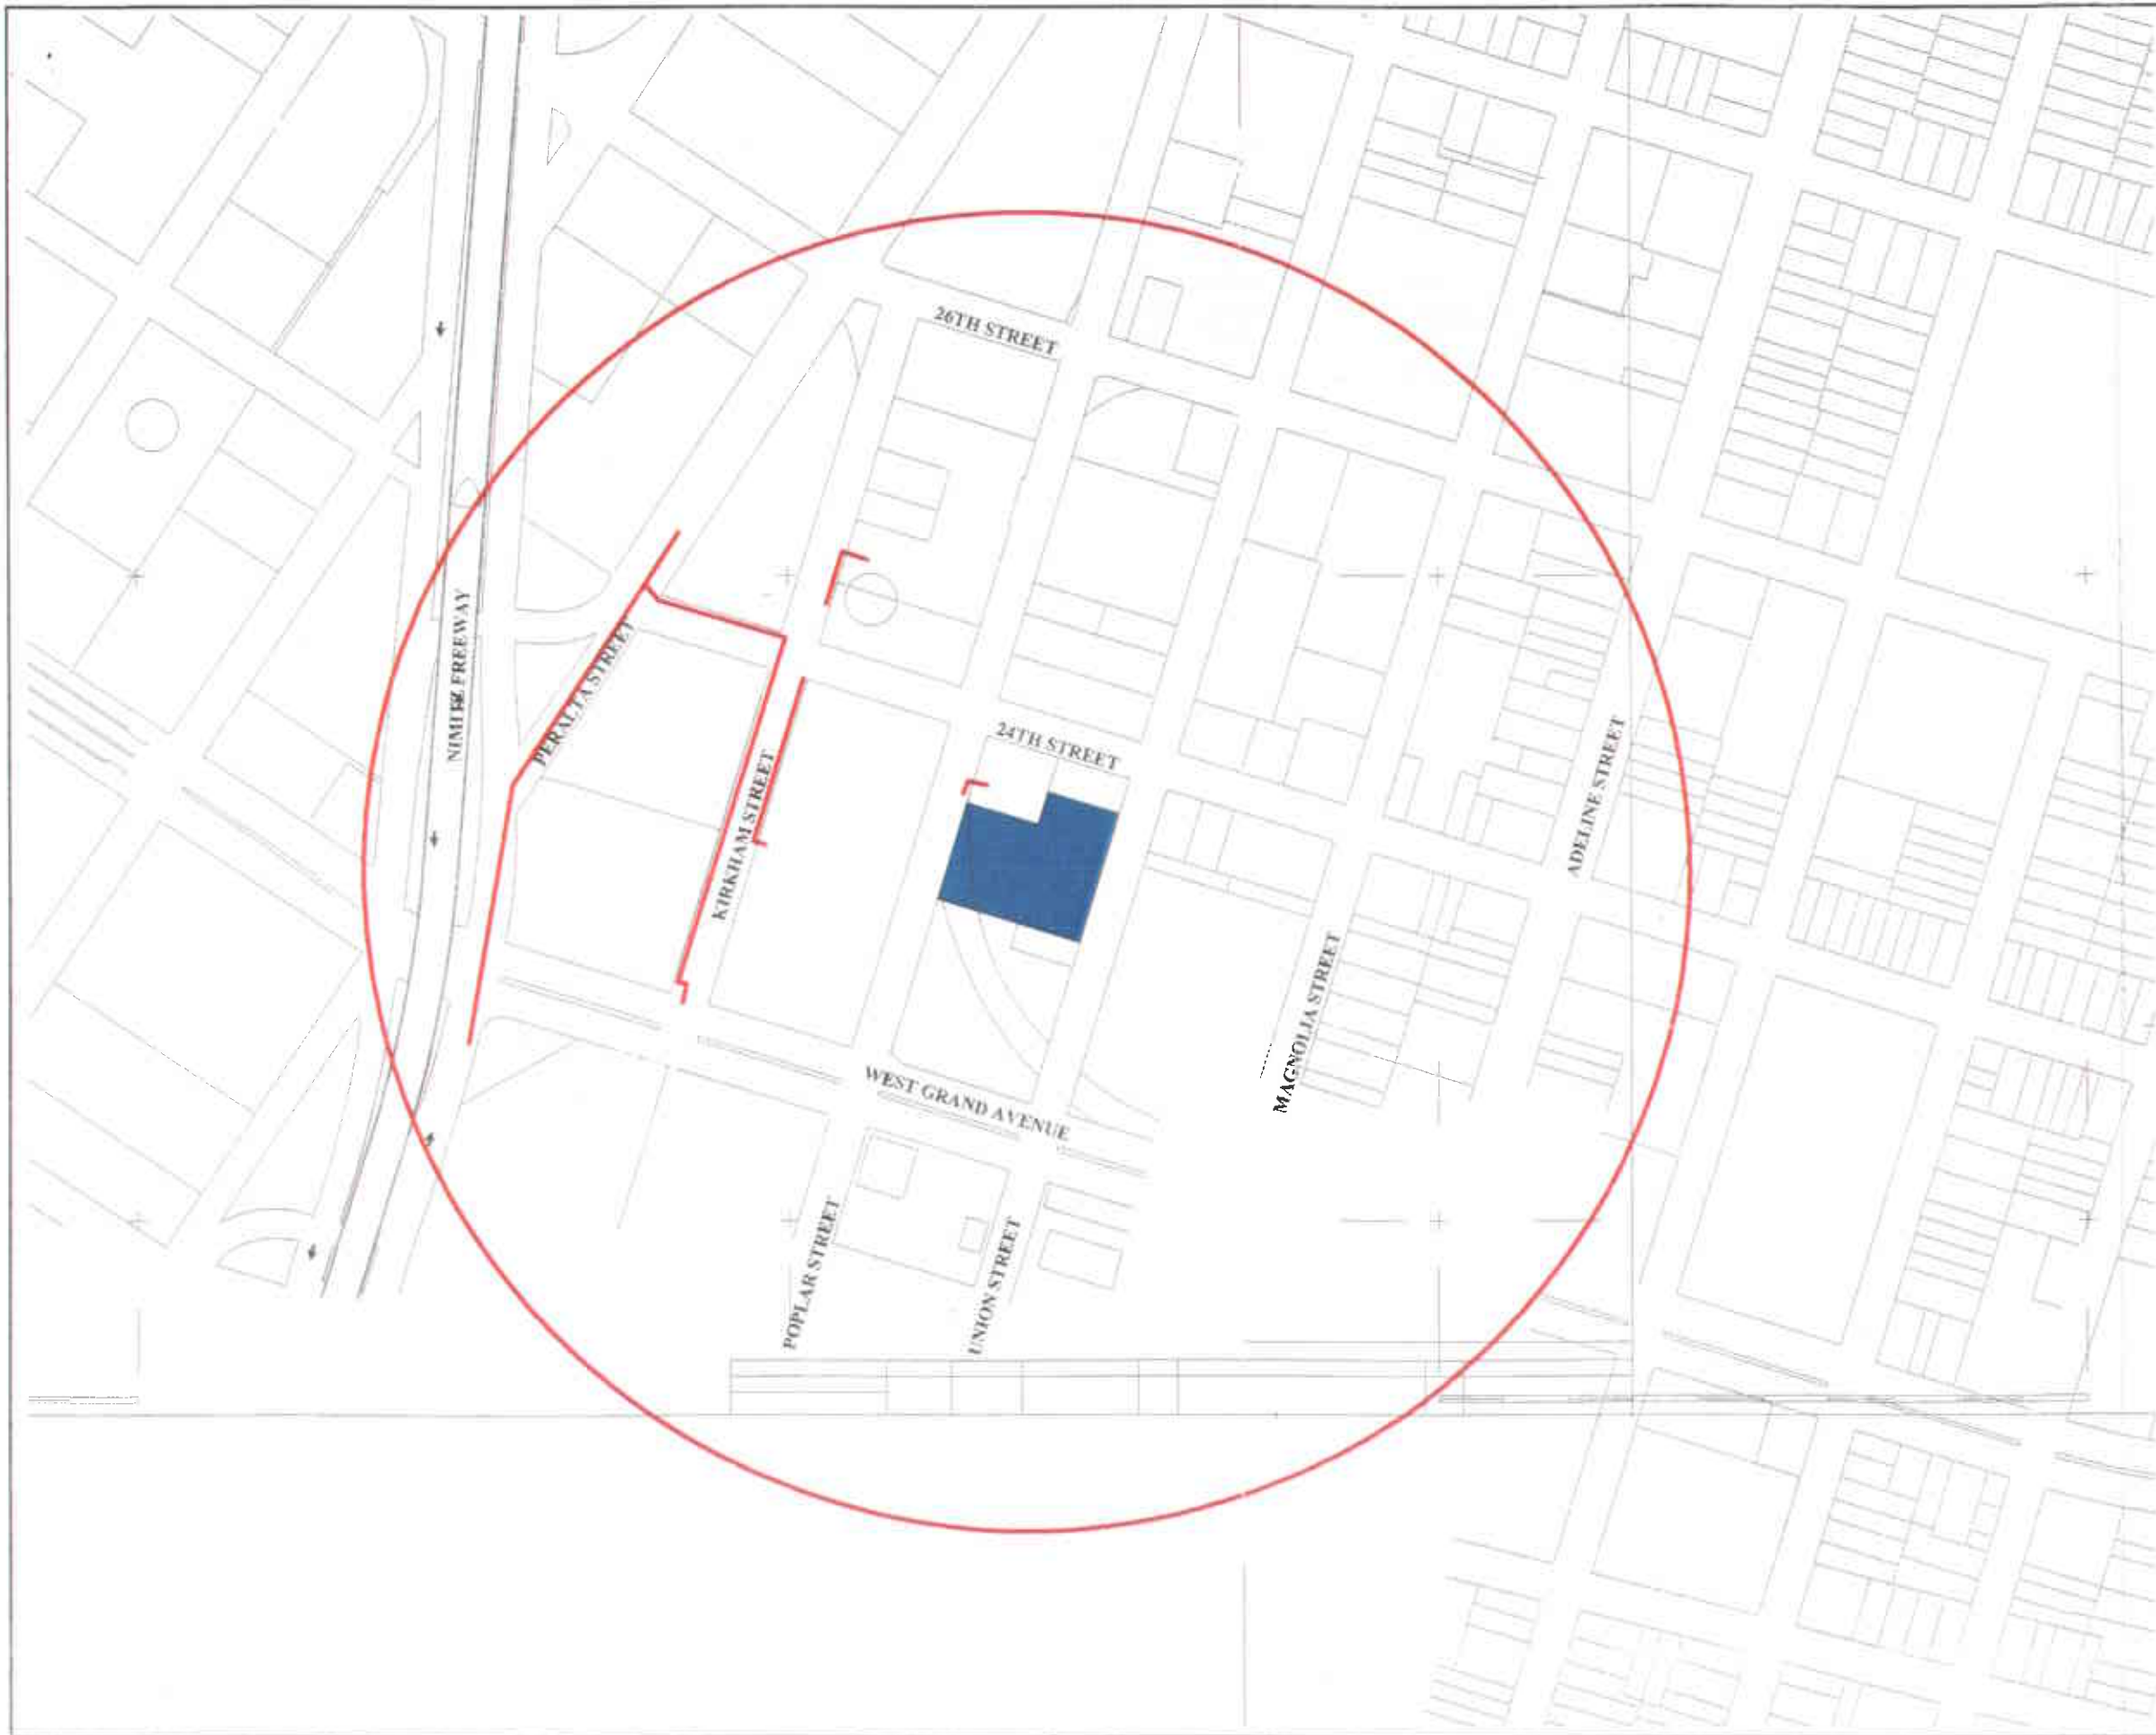

Electric Conduits

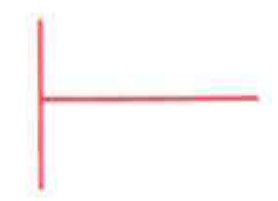

Locations are Approximate



Site of Concern




1,000 Foot Radius

SCALE




**LOCATION OF
ELECTRIC CONDUITS**

**2221 UNION STREET
OAKLAND, CA**

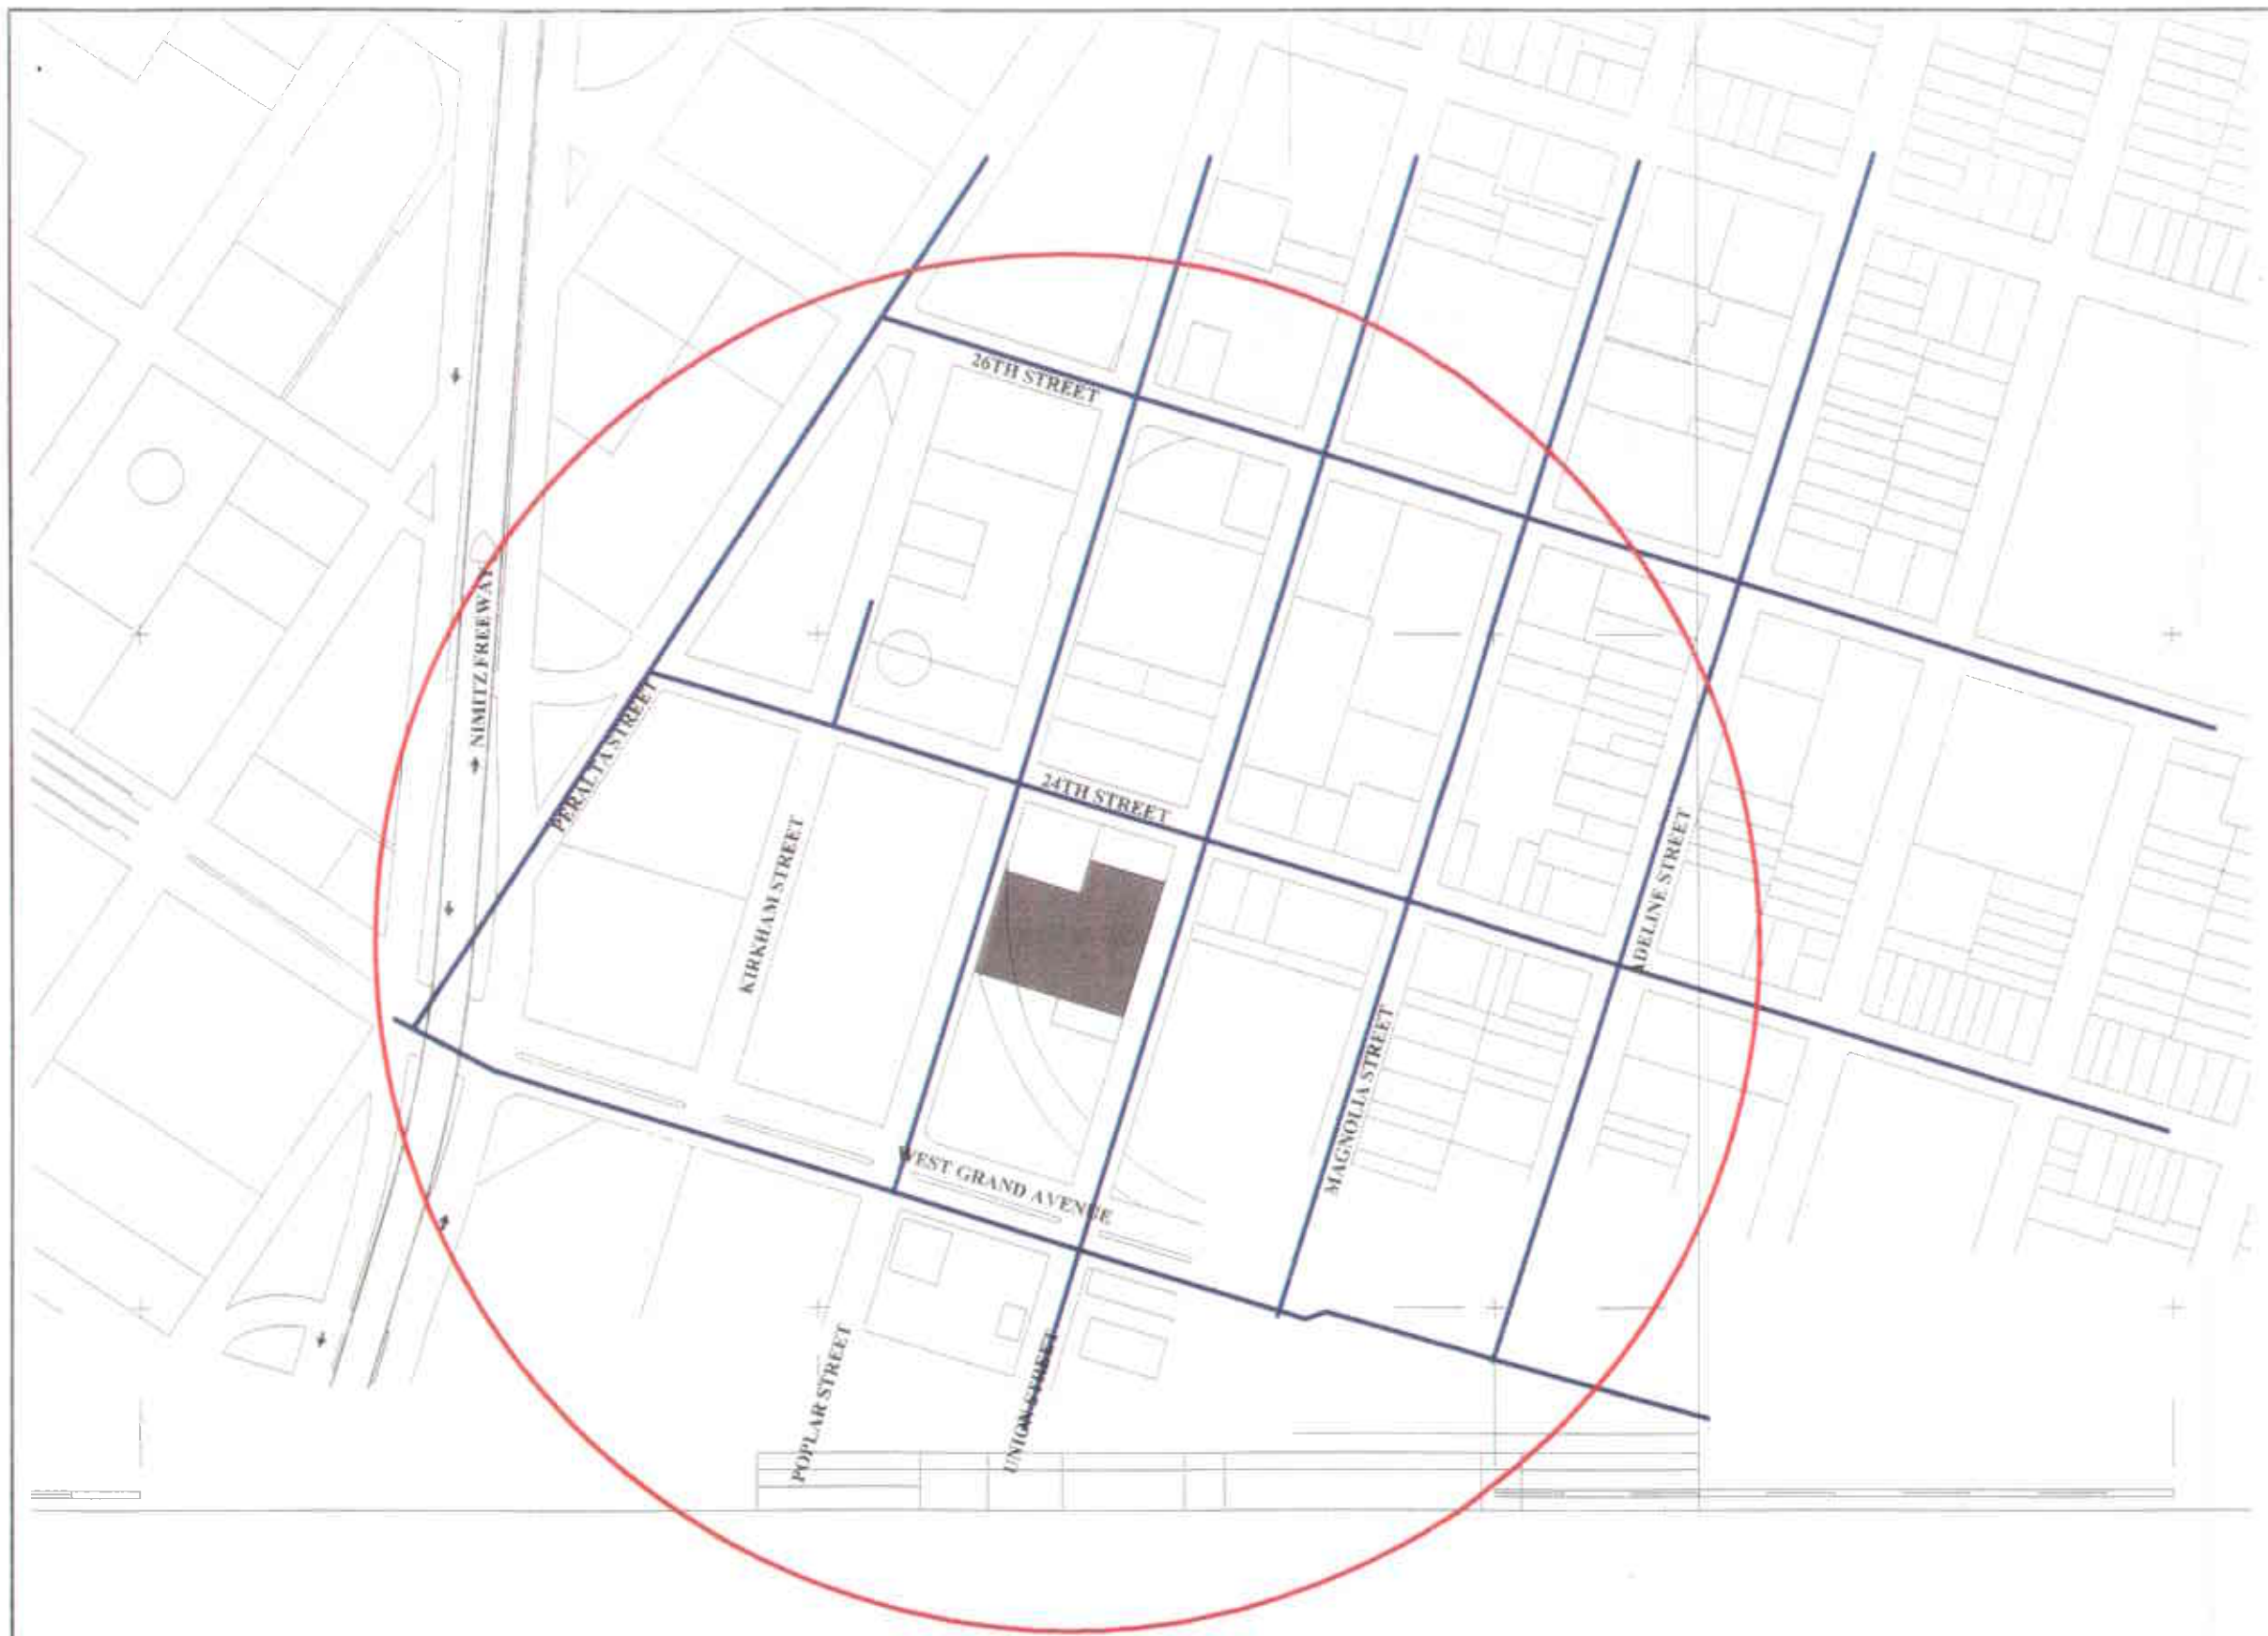

Water Conduits

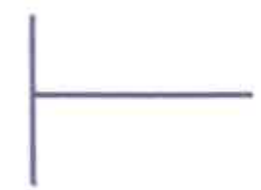

Locations are Approximate



Site of Concern





1,000 Foot Radius

SCALE



LOCATION OF WATER CONDUITS

**2221 UNION STREET
OAKLAND, CA**

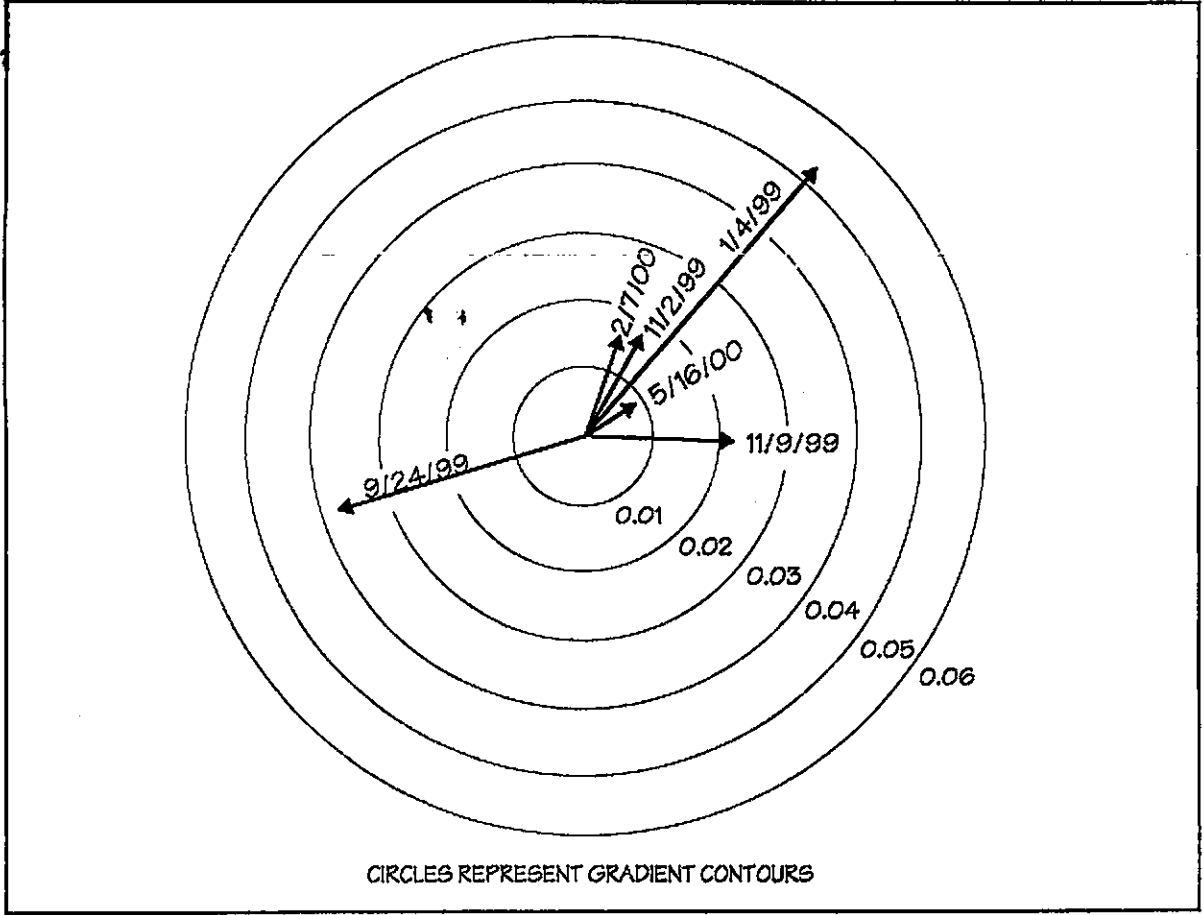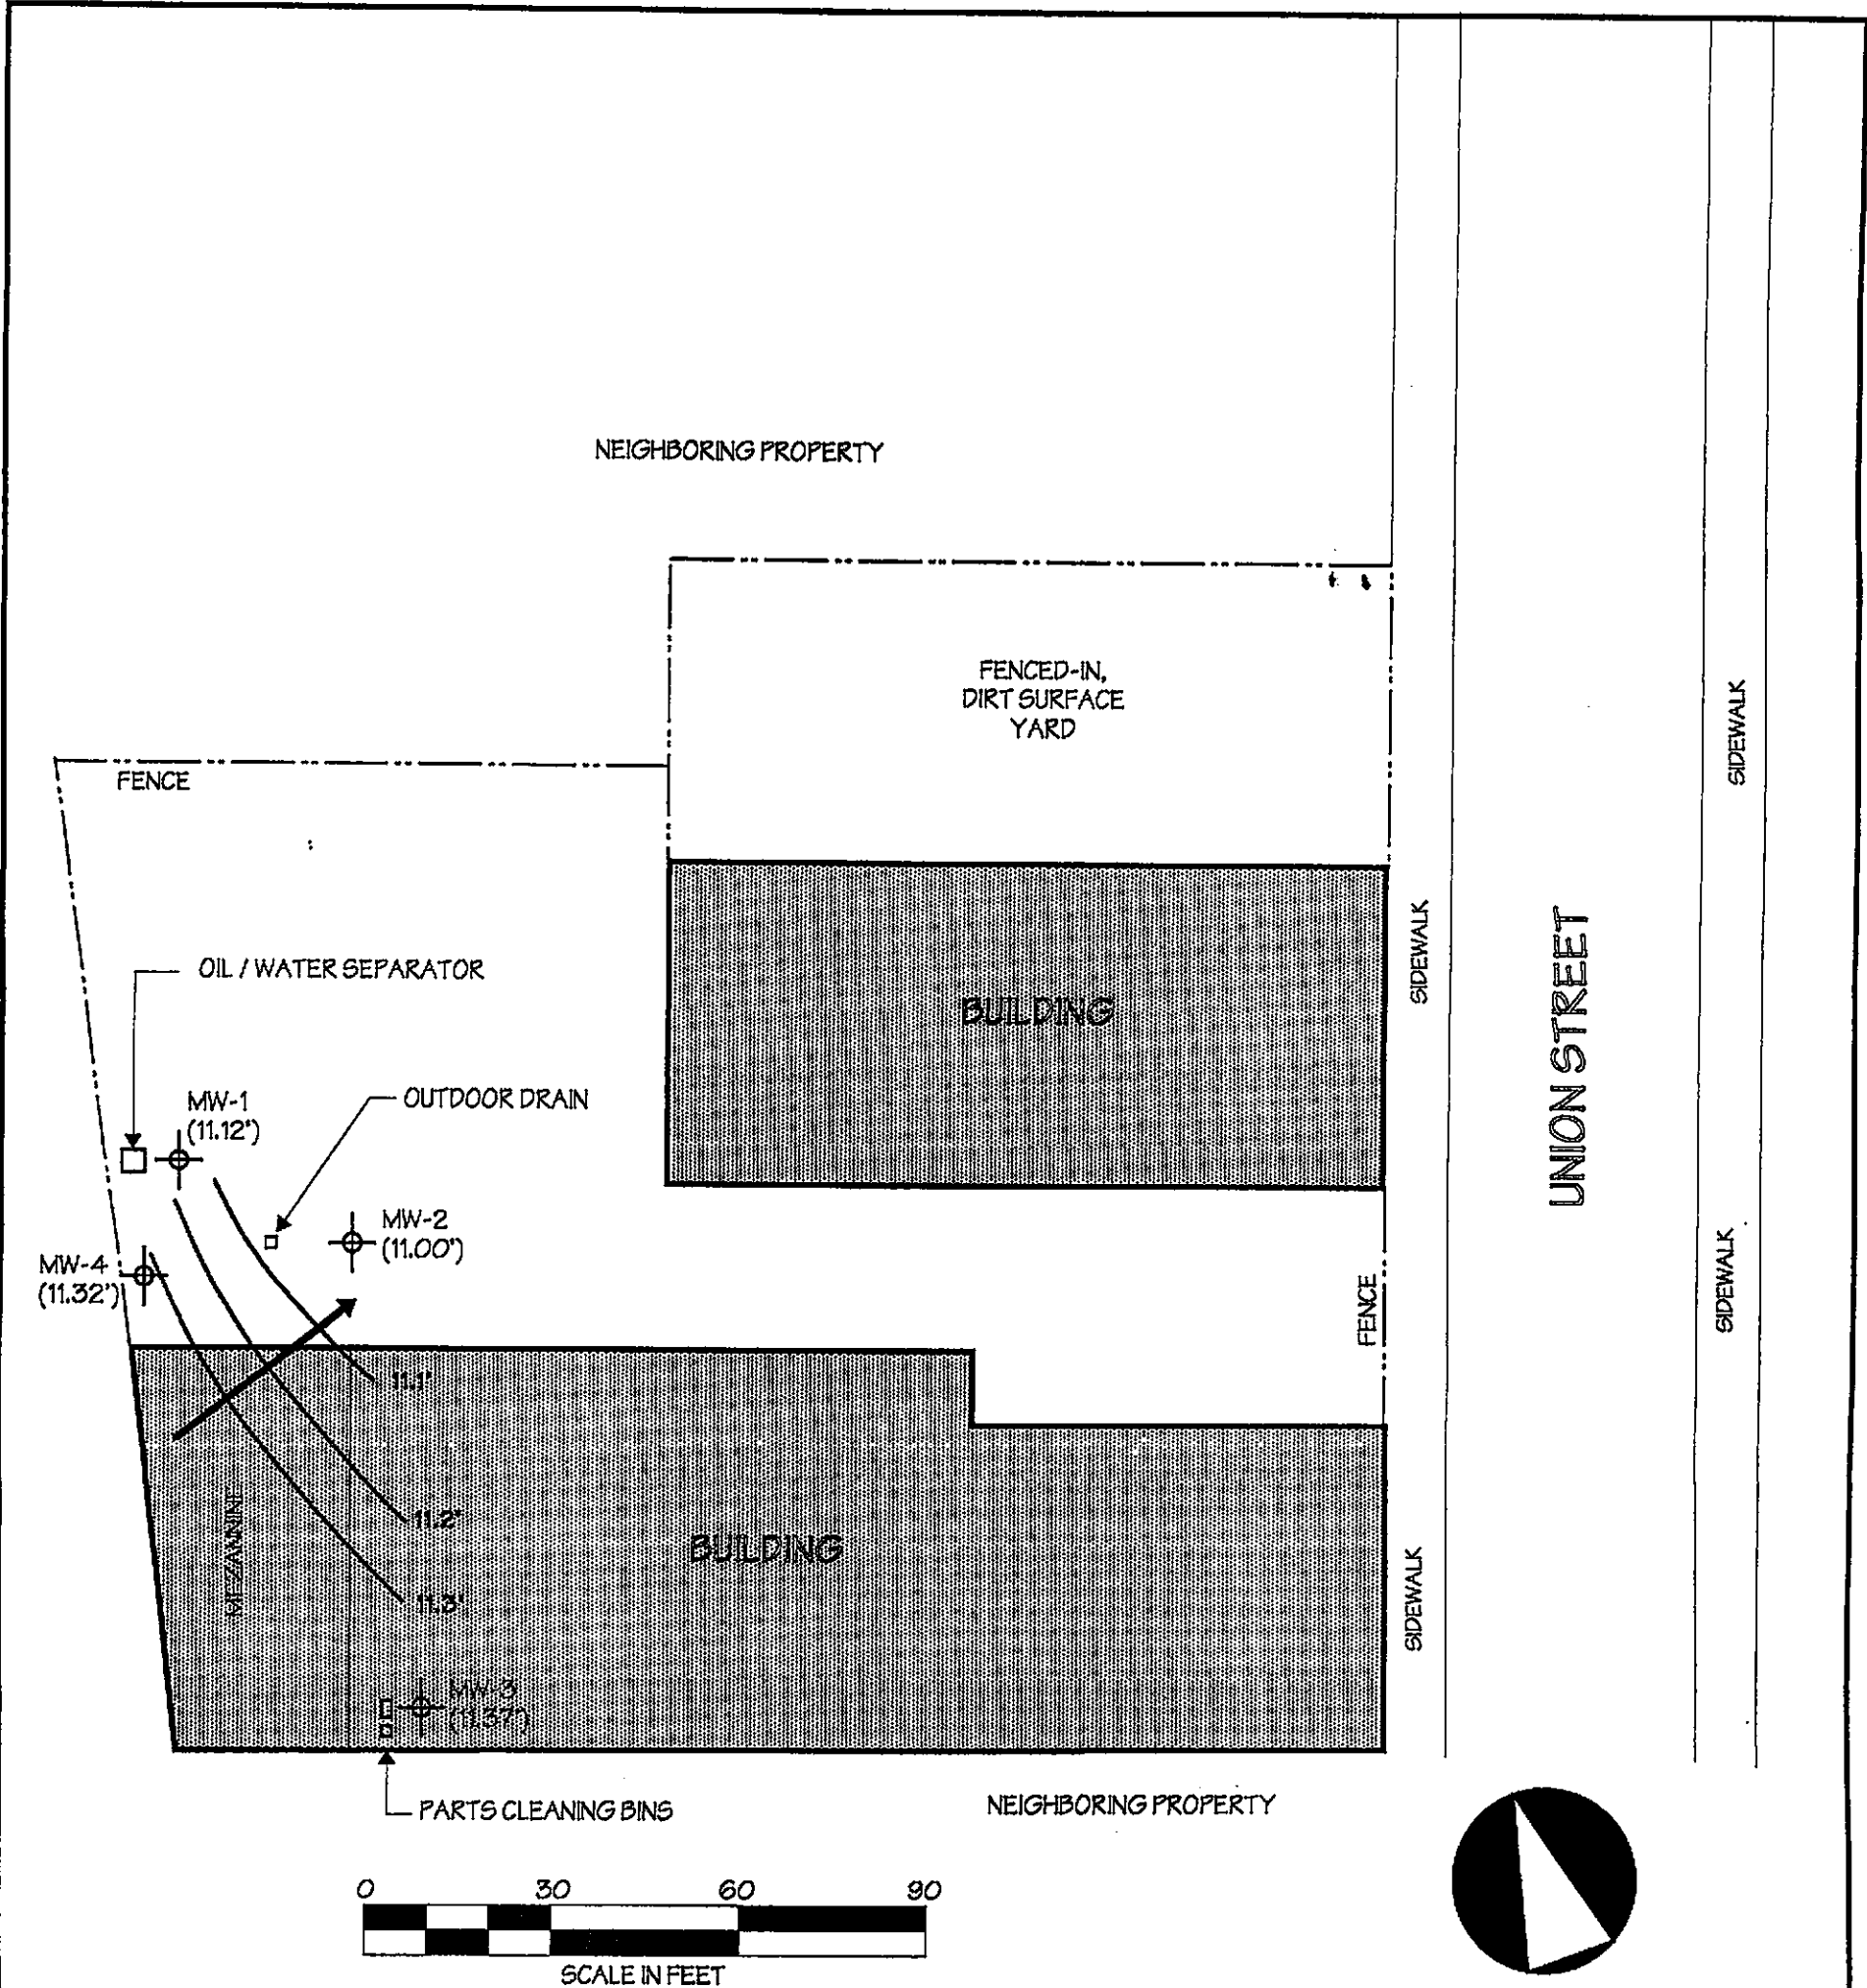

LEGEND

MW-4 (11.32')

ASE Monitoring Well with groundwater elevation in feet based on site datum referenced to regional topographic map

11.3'

Potentiometric Surface Elevation of Groundwater

Groundwater Flow Direction

POTENTIOMETRIC SURFACE MAP - MAY 16, 2000

VACANT PROPERTY
2221 UNION STREET
OAKLAND, CALIFORNIA

APPENDIX A

DWR Report for Area Well Survey
Radius of Site

CONFIDENTIAL

STATE OF CALIFORNIA DWR
WELL COMPLETION REPORT
(WELL LOGS)

REMOVED

CONFIDENTIAL

STATE OF CALIFORNIA DWR
WELL COMPLETION REPORT
(WELL LOGS)

REMOVED

Oakland City Center
500 12th Street
Suite 100
Oakland, CA 94607-4014
(415) 893-3600

01-421N-Q

Woodward-Clyde Consultants

1S/4W27H1

2 Borings

Incl
Add

April 7, 1989

Alameda County Flood Control
And Water Conservation District
5997 Parkside Drive
Pleasanton, California 94566

Attention: Permits Department

Gentlemen:

Subject: Well Construction Report, Permits 89028 and 89133,
Location 1S/4W 27H80


This Well Construction Report transmits information required by Groundwater Protection Ordinance, Permits 89028 for the installation of one monitoring well and two soil borings and Permit 89133 for the destruction of the monitoring well.

The well and borings were installed at 2311 Adeline Street (see Figures 1 and 2) on January 27, 1989. No free water was encountered in the soil borings at time of drilling and they were backfilled immediately after drilling with compacted cuttings. The monitoring well was constructed using 2-in. diameter PVC casing, backfilled with clean sand, sealed with 1 foot of bentonite pellets and a 4-foot surface seal of cement/bentonite grout. The monitoring well was abandoned by drilling out the casing and sand pack and grouting with cement/bentonite grout on March 10, 1989. Because the water bearing formation produces water very slowly at this site, the drilled-out monitoring well was virtually dry at time of abandonment and did not require a tremie pipe to backfill. Logs of the monitoring well and borings are attached in Appendix A.

If you have any question concerning the installation or abandonment of these soil borings and monitoring well please call Stan Clarke at 874-3096.

Sincerely,

Woodward-Clyde Consultants

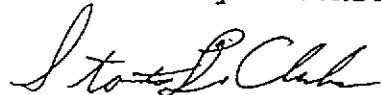

Stanton L. Clarke, P.E.
Project Engineer

Consulting Engineers, Geologists
and Environmental Scientists

Offices in Other Principal Cities




01-421N-CONS1
 & - ABAND.

Inw ADD 15/4W 27H1

Woodward-Clyde Consultants

PROJECT NAME NED CLYDE NO. 8910023A

BORING LOCATION		MW - 1		ELEVATION AND DATUM		N/A	
DRILLING AGENCY		ENSCO		DRILLER		J.R. Richards	
DRILLING EQUIPMENT		Diedrich D - 25 (Skid Rig)		DATE STARTED		January 27, 1989	
DRILLING METHOD		8" Hollow Stem Augers		DATE FINISHED			
DRILL BIT		8" Auger		COMPLETION DEPTH		16.5'	
SIZE AND TYPE OF CASING		2" PVC		SAMPLER		2.5" Modified California Type	
TYPE OF PERFORATION		0.020" Factory slot		NO. OF SAMPLES		DIST. N/A	
SIZE AND TYPE OF PACK		#2/12 Lonestar Monterey Sand		UNDIST.		6	
TYPE OF SEAL		NO. 1 Bentonite Pellets		WATER LEVEL		FIRST 11'	
		NO. 2 Neat Cement		COMPL.		N/A 72 HRS. 7.94	
FROM		6 TO 16 F.		LOGGED BY:		CHECKED BY:	
FROM		4.9 TO 16.5 F.		C. Parten		S. Clarke	
FROM		3.9 TO 4.9 F.					
FROM		0.5 TO 3.9 F.					

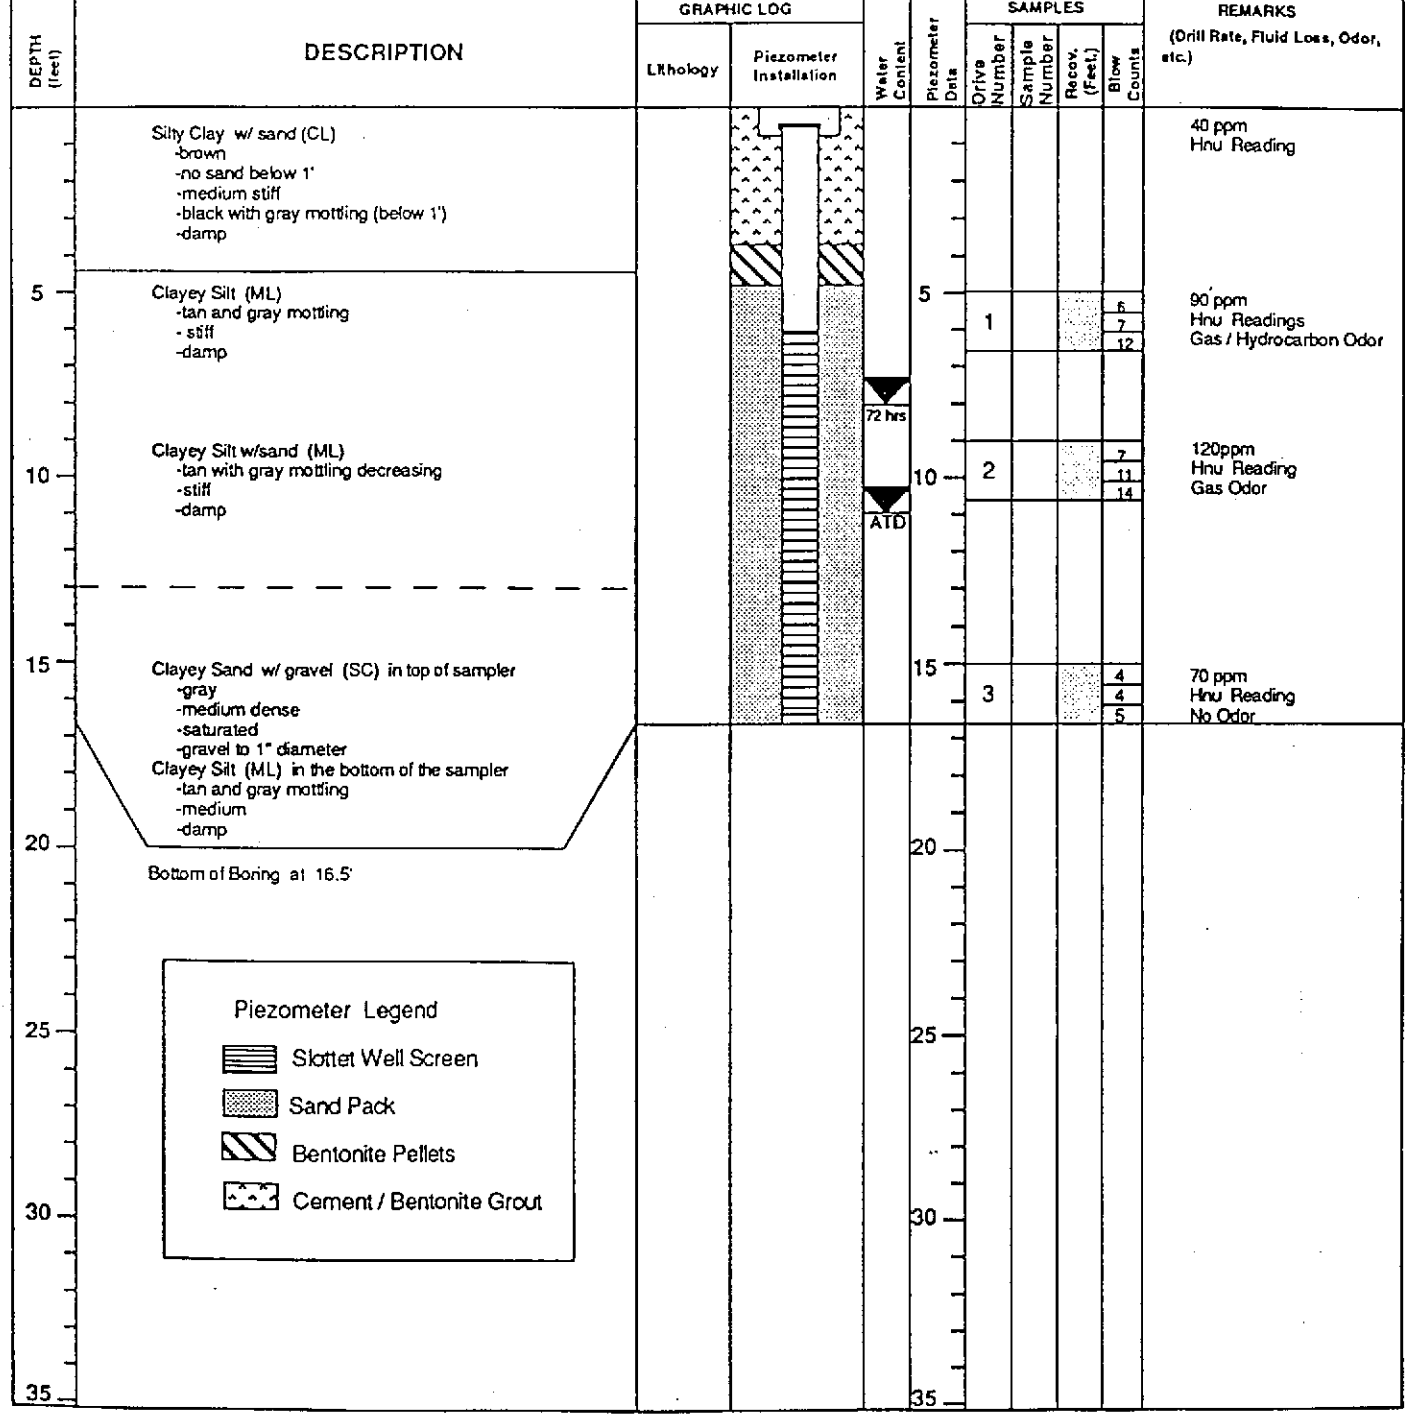




01-4211 Inuv Addv 13/4W 27A

BORING LOCATION		B-1		ELEVATION AND DATUM		N/A	
DRILLING AGENCY		ENSCO		DRILLER		J.R. Richards	
DRILLING EQUIPMENT		Diedrich D - 25 (Skid Rig)		DATE STARTED		January 27, 1989	
DRILLING METHOD		8" Hollow Stem Augers		DATE FINISHED			
SIZE AND TYPE OF CASING		N/A		COMPLETION DEPTH		16.5'	
TYPE OF PERFORATION		N/A		NO. OF SAMPLES		DIST. N/A	
SIZE AND TYPE OF PACK		N/A		WATER LEVEL		FIRST 12	
TYPE OF SEAL		N/A		UNDIST.		6	
NO. 1		N/A		COMPL.		24 HRS. N/A	
NO. 2		N/A		LOGGED BY:		C. Parten	
				CHECKED BY:		S. Clarke	


DEPTH (feet)	DESCRIPTION	GRAPHIC LOG		Water Content	Piezometer Data	SAMPLES					REMARKS (Drill Rate, Fluid Loss, Odor, etc.)
		Lithology	Piezometer Installation			Drive Number	Sample Number	Recon. (Feet)	Blow Counts		
5	Silty Clay w/gravel (CL) -brown Silty Clay (CL) -black, gray mottling Clayey Silt (ML) -gray w/ slight tan mottling -medium -damp					1			5 8 9	170 ppm to 140 ppm Hnu Readings Slight Odor	
10	Clayey Silt w/sand (ML) -tan w/ gray mottling -medium -damp					2			6 8 10	110 ppm Hnu Reading Gas Odor	
15	Gravelly Clayey Sand (SC) -tan and gray -medium dense -saturated -gravel to 1" diameter					3			5 8 10	70 ppm Hnu Reading Slight Odor	
16.5	Bottom of Boring at 16.5'										

BORING LOCATION B-2		ELEVATION AND DATUM N/A	
DRILLING AGENCY ENSCO	DRILLER J.R. Richards	DATE STARTED DATE FINISHED January 27, 1989	
DRILLING EQUIPMENT Diedrich D-25 (Skid Rig)		COMPLETION DEPTH 16.5'	SAMPLER 2.5" Modified California Type
DRILLING METHOD 8" Hollow Stem Augers	DRILL BIT 8" Auger	NO. OF SAMPLES	DIST. N/A
SIZE AND TYPE OF CASING N/A		WATER LEVEL FIRST 9 1/2	UNDIST. 6
TYPE OF PERFORATION N/A		LOGGED BY: C. Parten	
SIZE AND TYPE OF PACK N/A		CHECKED BY: S. Clarke	
TYPE OF SEAL	NO. 1 N/A	FROM N/A TO N/A FL.	
	NO. 2 N/A	FROM N/A TO N/A FL.	

DEPTH (feet)	DESCRIPTION	GRAPHIC LOG		Water Content	Piezometer Data	SAMPLES			REMARKS (Drill Rate, Fluid Loss, Odor, etc.)
		Lithology	Piezometer Installation			Drive Number	Sample Number	Recov. (Feet)	
5	Silty Clay w/gravel (CL) -brown -black								
5	Clayey Silt (ML) w/ sand lenses -gray w/ tan mottling -medium -damp					1		5 6 10	250 ppm Hnu Readings Gas Odor
10	Clayey Silt w/sand (ML) -tan w/ gray mottling -medium -moist			ATD		2		4 7 7	175ppm Hnu Reading Gas Odor
15	Clayey Sand w/ gravel (SC) -gray -medium dense -saturated -gravel to 1" diameter					3		6 12 13	160 ppm Hnu Reading Slight Odor
20	Bottom of Boring at 16.5'								
25									
30									
35									

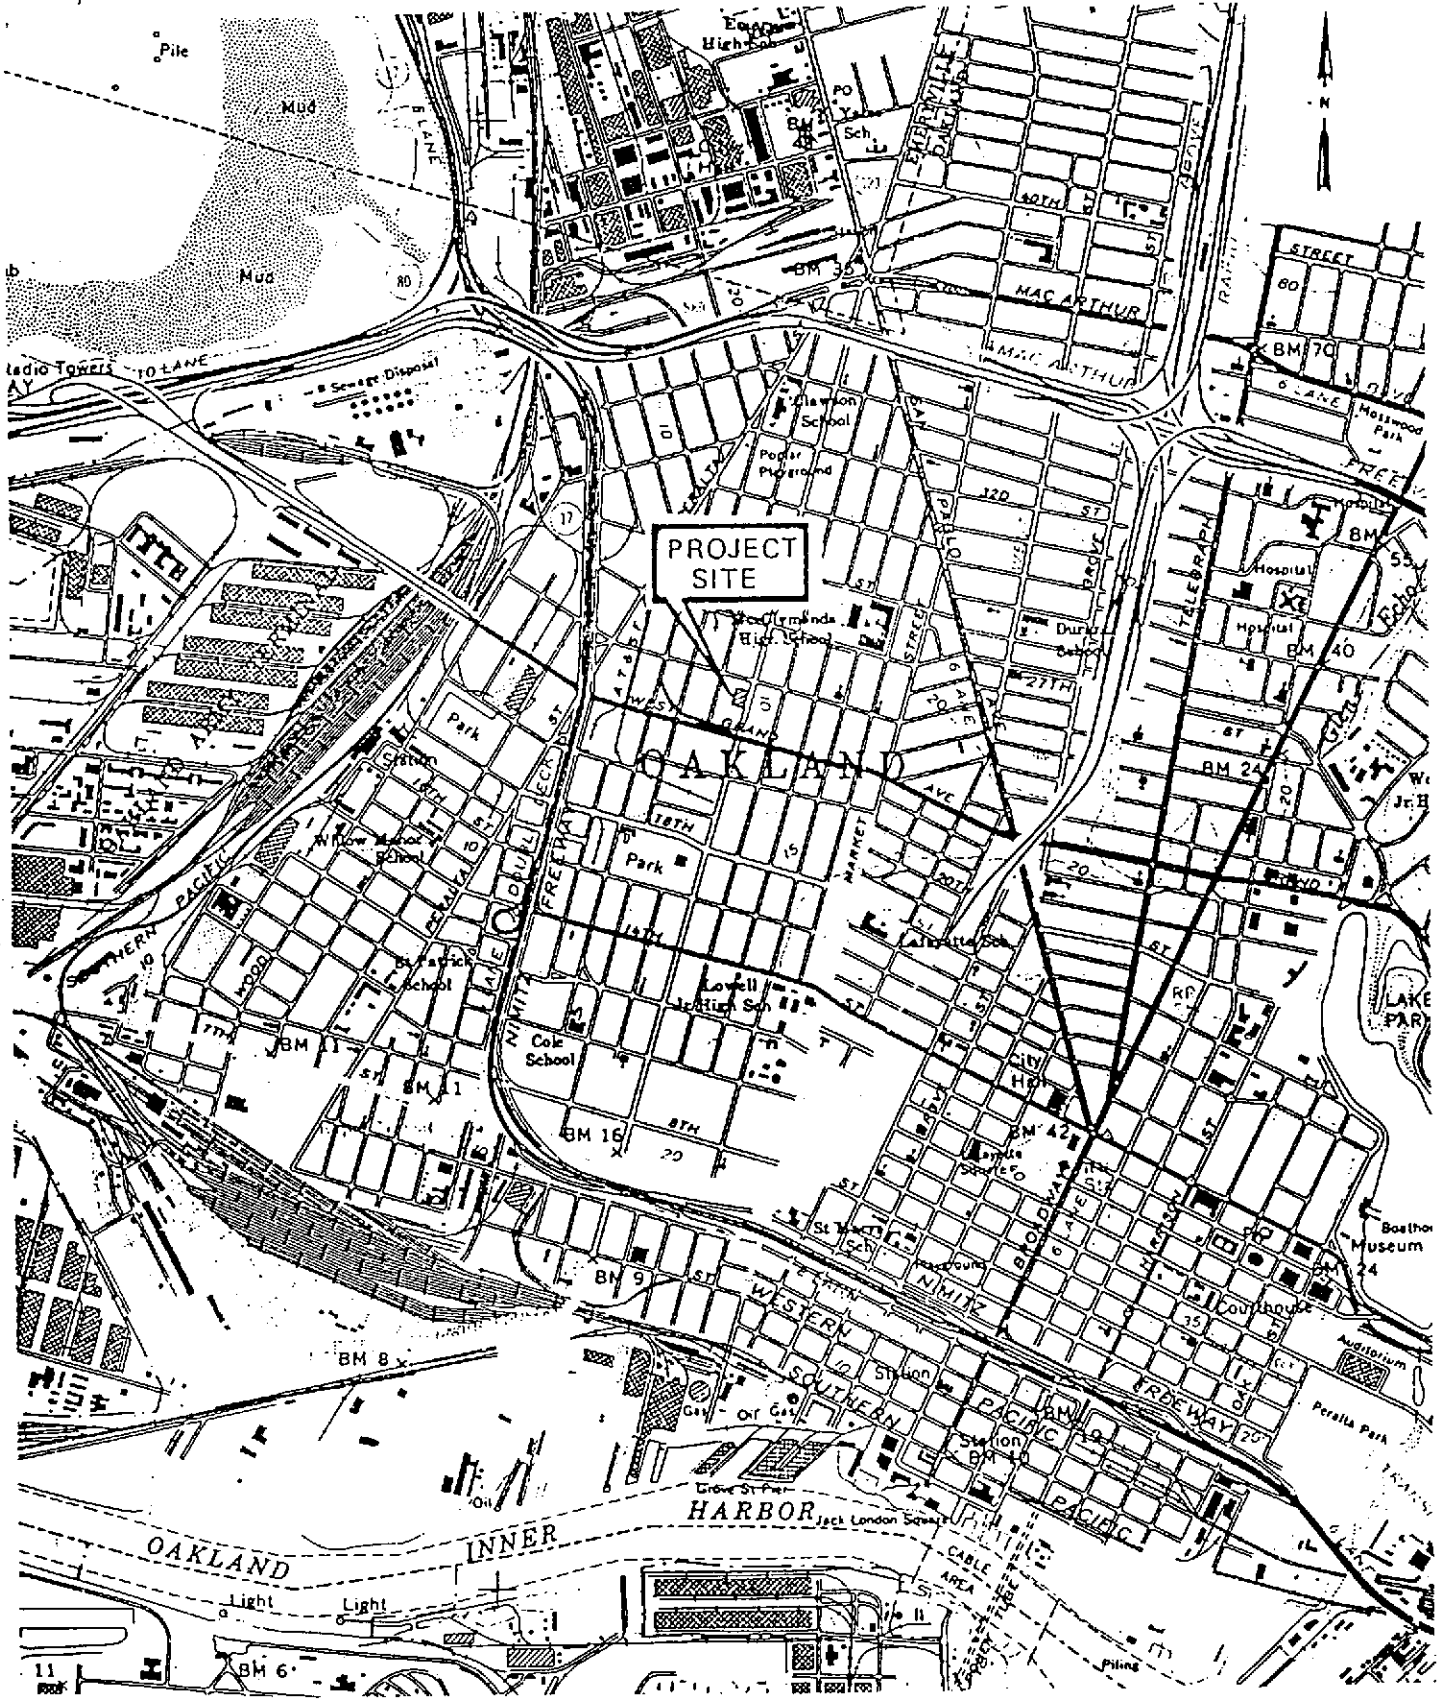


Reference USGS Oakland West, California
1959, Revised 1980

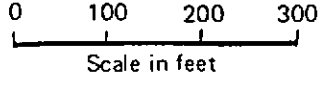

Project No. 8910023A	NED CLYDE CONSTRUCTION	SITE LOCATION MAP	Figure 1
Woodward-Clyde Consultants			

Woodward-Clyde Consultants	Project No. 8910023A
	NED CLYDE CONSTRUCTION
SITE PLAN 2311 ADELINE STREET	
Figure 2	

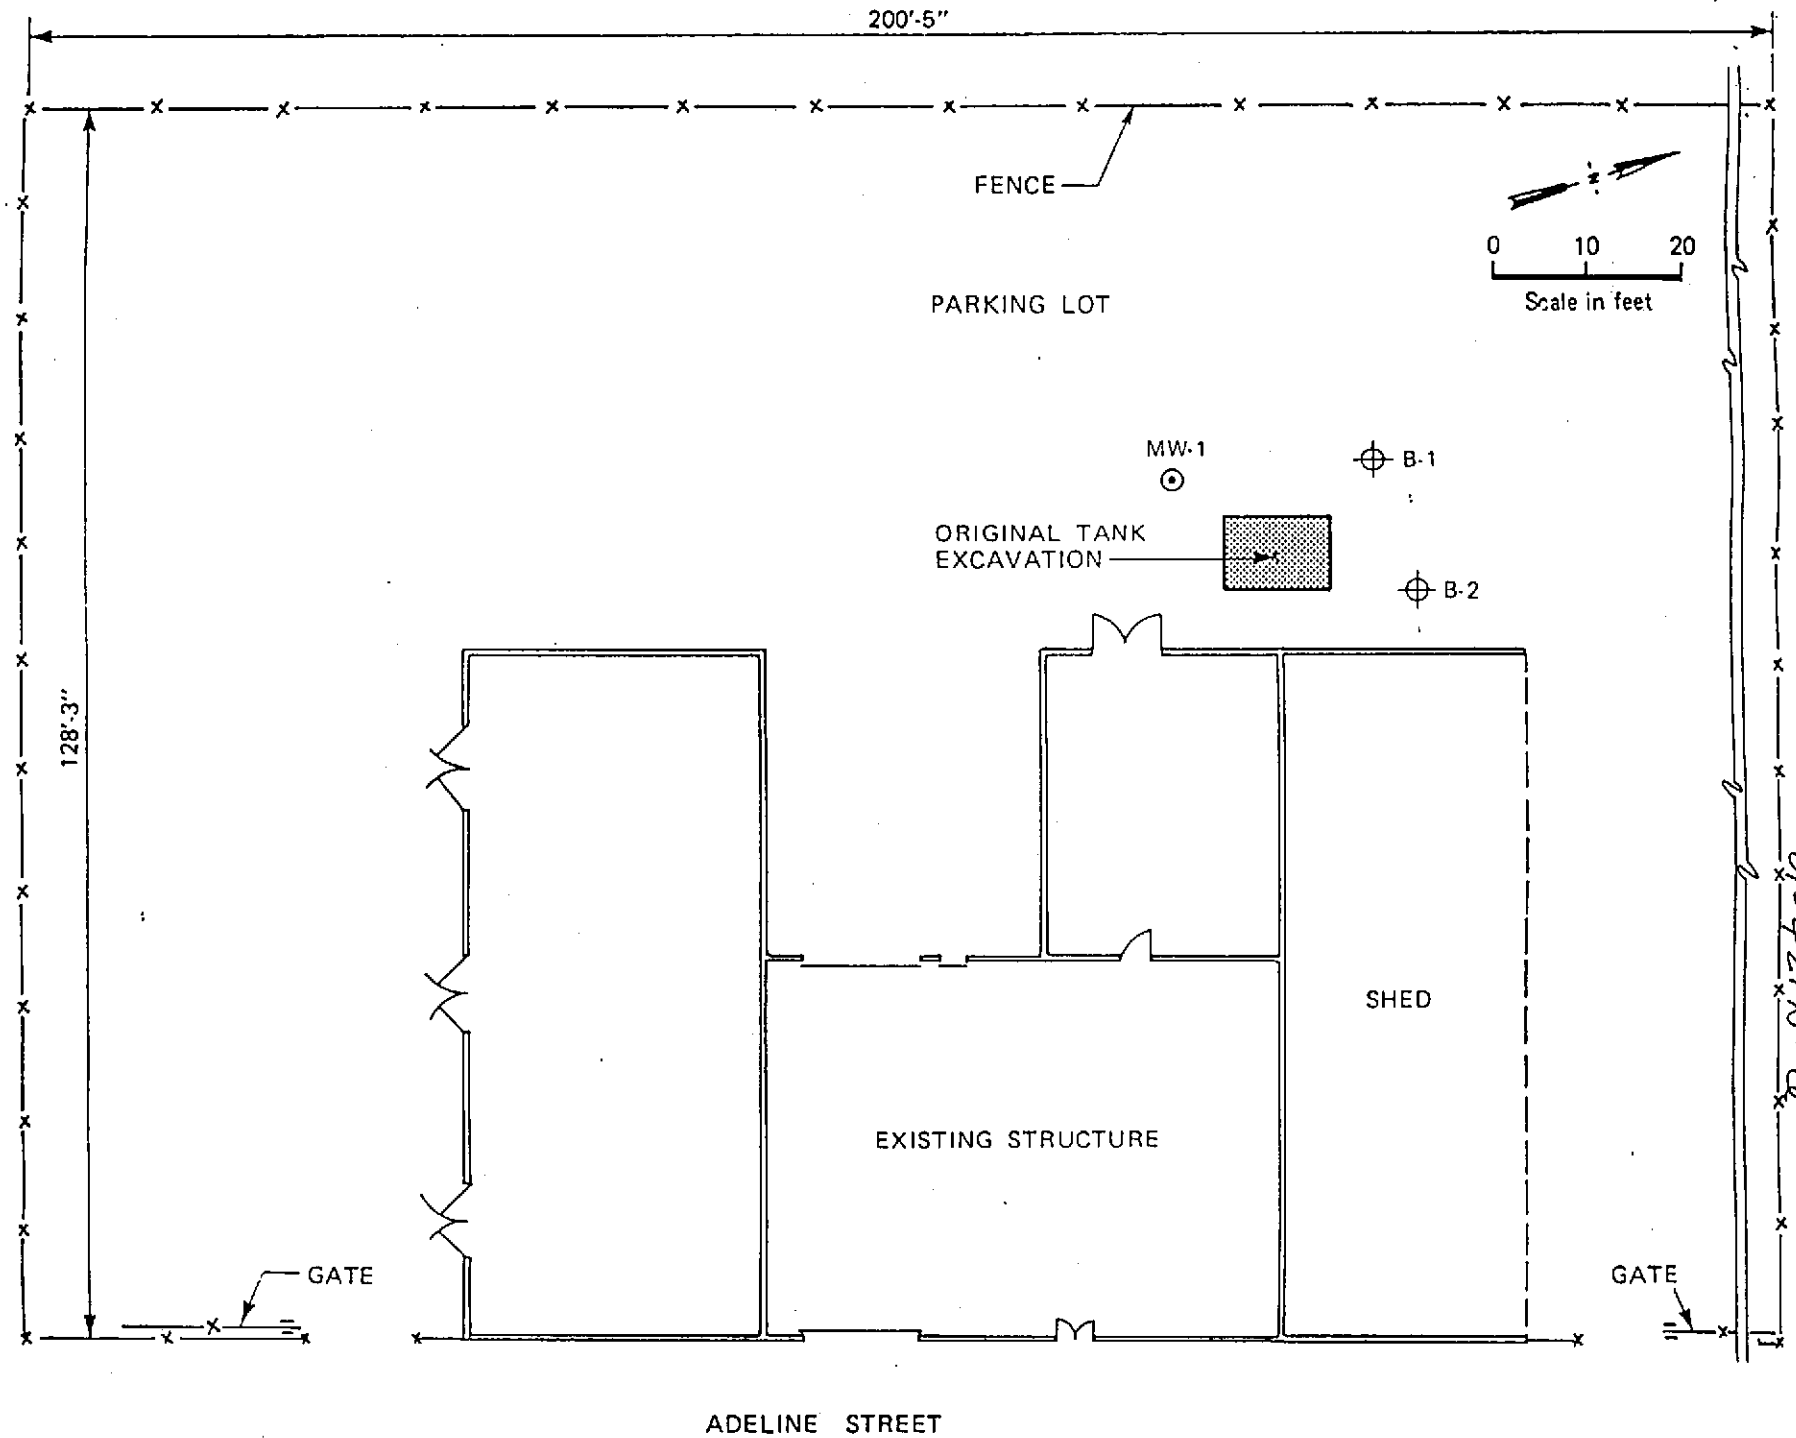

ADELINE STREET

1514W 27G1
01-471Z

UNION ST.

SIDEWALK

EXISTING BLDG.

DIESEL DISPENSER

VENT

8000 GAL. DIESEL TANK

EXISTING BLDG.

VENTS

WASTE OIL FILL

GASOLINE DISPENSER


PIPING

1000 GAL. UNDERGROUND GASOLINE TANK

500 GAL. WASTE OIL TANK

MAGNOLIA ST.

GRAND AVE. W

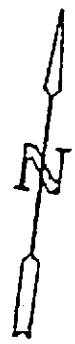

Geo-Environmental Technology

SCALE: NONE
DATE: 14 JUNE 89

PLOT PLAN FOR:
ALDO GUIDOTTI

DRAWN BY *SM*
REVISED

2311 MAGNOLIA ST.
OAKLAND, CA 94607

260 Cristlich Lane
Campbell, CA 95008 (408) 559-1220

PLATE 1

screened interval, and extended to approximately 1 foot above the screen. A bentonite and concrete seal was placed from the top of the sand pack to the ground surface. A locking cap and protective traffic-rated vault box was installed on the top of the well.

Potentially contaminated soil cuttings and samples not retained for chemical analysis were contained in secured 55 gallon storage on-site. The storage drums were properly sealed and labeled. All drilling and sampling equipment was steam-cleaned upon completion of well installation.

Groundwater Sampling Procedure

Groundwater sampling was performed by GET using techniques approved by the Environmental Protection Agency (EPA), and the California Regional Water Quality Control Board, (RWQCB). These techniques require that:

1. Wells will be developed until the water is free of fine-grained sediments and/or until field measurements of pH, electrical conductivity, and temperature stabilize. Approximately four to ten well volumes of water will be removed during development of the well.
2. Equipment inserted into the well during development will be decontaminated by washing or steam cleaning prior to and after its use.

GET's sampling procedure consisted of first measuring the water level in the well and then checking for the presence of floating petroleum product using a clear teflon bailer. Because no free product was detected, the well was purged of four casing volumes of water. In order to ensure that a representative sample was obtained, the pH, electrical conductivity and temperature were monitored and documented on a well sampling field sheet. (See Figure 4). Using a teflon bailer, two samples entitled 9070-1 and 9070-2 were collected on 10/26/90 at 1:30 pm. They had a pH of 7.4, an electrical conductivity of .01, and a temperature of 65 degrees. Samples were placed into appropriate EPA-approved containers, labeled, logged onto chain-of-custody documents, and transported to the laboratory. All sampling equipment was properly decontaminated with a trisodiumphosphate, (TSP), solution followed with a tap water rinse. A field blank sample (9070-2) was prepared for quality control purposes, prior to collection of groundwater samples. Potentially contaminated purge water and decontaminant rinsate was contained in secured 55-gallon storage drums on-site. The drums were properly sealed and labeled.

Site Description

A site map showing the current layout of the site is presented in Figure 2. This figure shows the locations of existing structures and the former underground storage tanks, as well as adjacent streets. Site sketch maps showing the sources of the samples are shown in figures 3 and 4

Well Installation

In order to determine if site operations have impacted groundwater, GET installed one groundwater monitoring well within the tank pit excavation area. The well is within five feet of the former waste oil storage tank location in the estimated downgradient direction. The well location is shown on Figure 2 entitled Site Map and Soil Sample Plot Plan and on Figure 3 entitled Boring Log MW-1.

The soils boring was drilled using an 8-inch diameter continuous-flight hollow-stem B-57 mobile drill auger. The boring was logged by a Professional Engineer using the Unified Soil Classification System and standard geologic techniques. (See Appendix A) Soil samples for logging and chemical analysis were collected at 9', 14', and 20' depths and were entitled SB-1, SB-2 and SB-3 respectively. These samples were collected by advancing a California-modified split-spoon sampler with brass liners into undisturbed soil beyond the tip of the auger. The sampler was driven 18 inches, using a 140-pound hammer with a 30" drop. Soil samples above groundwater were retained in brass liners, capped with aluminum foil and plastic end caps, and sealed in clean glass containers for possible chemical analysis. The samples were placed on ice and transported to the laboratory accompanied by the appropriate chain-of-custody documentation. All drilling and sampling equipment was thoroughly steam-cleaned prior to utilization.

The boring for the monitoring well (appendix A) penetrated 14.5 feet through the water bearing zone to a depth of 21 feet. Permeable sand and gravel was encountered at 19.5 feet. As a result, the boring was stopped and bentonite used to seal the well between 19.5 and 21 feet. The boring was then converted to a groundwater monitoring well with the installation of a 2-inch diameter, flush-threaded Schedule 40 PVC casing and 0.020-inch factory slotted Triloc screen. 13 feet of screen was placed through the entire saturated section extending to two feet above the static water level in order to account for fluctuations in groundwater elevation. A 2 X 12 graded #3 RMC Lone Star Lapis Lustre sand pack was placed in the annular space across the



01-547R-T

MW-4 01504W27602
MW-5 01-894 G03
MW-6 G04

ALAMEDA COUNTY FLOOD CONTROL AND WATER CONSERVATION DISTRICT
5987 PARKSIDE DRIVE PLEASANTON, CALIFORNIA 94588 (415) 454-2600

GROUNDWATER PROTECTION ORDINANCE PERMIT APPLICATION

FOR APPLICANT TO COMPLETE

FOR OFFICE USE

LOCATION OF PROJECT Pacific Cryogenics
2311 Magnolia Street
Oakland, CA 94607

PERMIT NUMBER 92607
LOCATION NUMBER _____

CLIENT
Name Aldo Guidotti / Estate of Jean Josephine
Address 1 Bates Blvd #300 Phone _____
City Orinda Zip 94536

PERMIT CONDITIONS

Circled Permit Requirements Apply

APPLICANT
Name Hageman-Aguilar, Inc.
3732 Mt Diablo Blvd
Address Suite 372 Phone (510)284-1661
City Lafayette Zip 94549

- (A) GENERAL
 1. A permit application should be submitted so as arrive at the Zone 7 office 11w days prior proposed starting date.
 2. Submit to Zone 7 within 60 days after completi or permitted work the original Department Water Resources Water Well Drillers Report equivalent for well projects, or drilling ic and location sketch for geotechnical projects.
 3. Permit is void if project not begun within days of approval date.
- (B) WATER WELLS, INCLUDING PIEZOMETERS
 1. Minimum surface seal thickness is two inches cement grout placed by tremie.
 2. Minimum seal depth is 50 feet for municipal a industrial wells or 20 feet for domestic an irrigation wells unless a lesser depth specially approved. Minimum seal depth f monitoring wells is the maximum depth practicab or 20 feet.
- C. GEOTECHNICAL. Backfill bore hole with compacted cut tings or heavy bentonite and upper two feet with co pacted material. In areas of known or suspect contamination, treated cement grout shall be used place of compacted cuttings.
- D. CATHODIC. Fill hole above anode cone with concre placed by tremie.
- E. WELL DESTRUCTION. See attached.

TYPE OF PROJECT
Well Construction _____ Geotechnical Investigation _____
Cathodic Protection _____ General _____
Water Supply _____ Contamination _____
Monitoring X Well Destruction _____

PROPOSED WATER SUPPLY WELL USE
Domestic _____ Industrial _____ Other _____
Municipal _____ Irrigation _____

DILLING METHOD: excavation backfill wells
Air Rotary _____ Air Rotary _____ Auger _____
Cable _____ Other X

DRIER'S LICENSE NO. NONE (excavation backfill wells) bb

WELL PROJECTS
Drill Hole Diameter _____ In. Maximum _____
Casing Diameter 4 In. Depth 15 ft.
Surface Seal Depth 3 ft. Number 3

GEOTECHNICAL PROJECTS
Number of Borings _____ Maximum _____
Hole Diameter _____ In. Depth _____ ft.

ESTIMATED STARTING DATE 11/19/92
ESTIMATED COMPLETION DATE 11/19/92

I hereby agree to comply with all requirements of this Ordinance and Alameda County Ordinance No. 73-68.

APPLICANT'S SIGNATURE Hary Aguiar Date 11/18/92

Approved Wymen Hong Date 19 Nov 92
Wymen Hong

121969

bb



385

01-547 R-T

15/4W-2762-4

UNION STREET

MAGNOLIA STREET

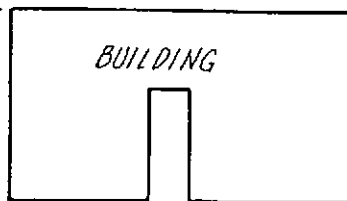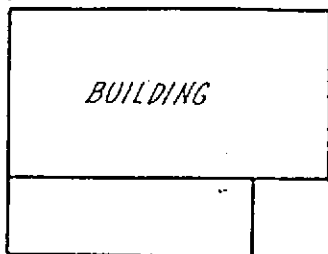


← PREVIOUS
8,000-GAL DIESEL TANK



MW-3



PREVIOUS
1,000-GAL
GASOLINE TANK →

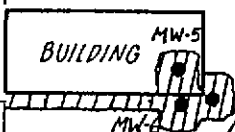

MW-1

MW-5





MW-6

MW-4

PREVIOUS
550-GAL
WASTE OIL TANK →

EXCAVATION

MW-2

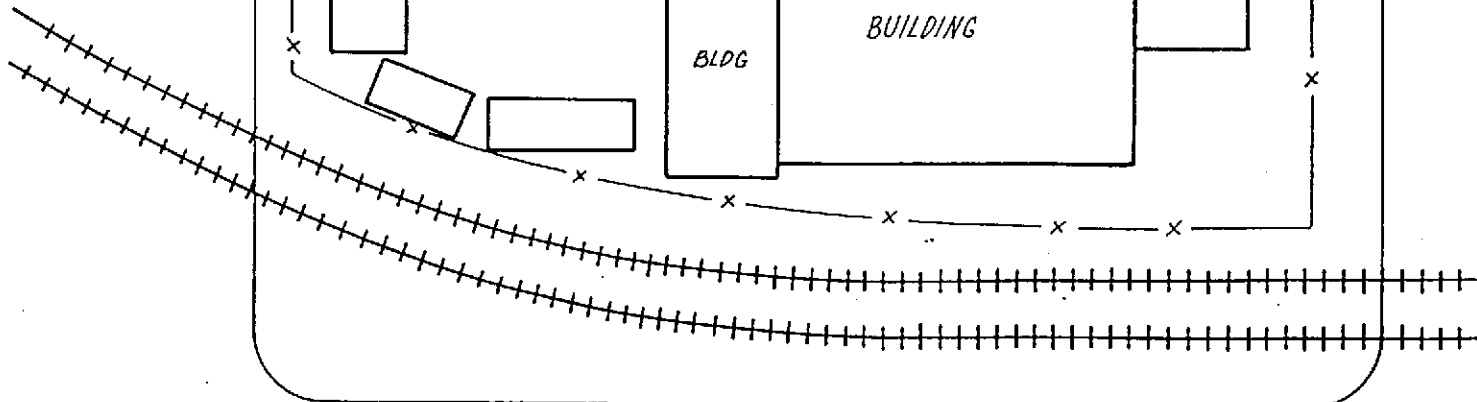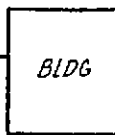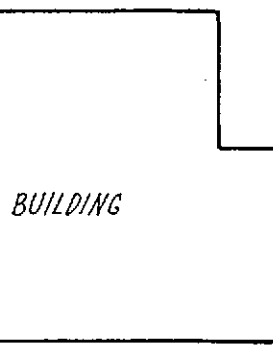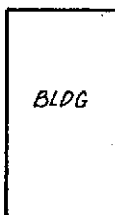

WEST GRAND AVENUE

485


OL-547 R-T

15/4W-276.2-4


MW-3

Locations of Backfill Wells
MW-4, MW-5 and MW-6

2311 Magnolia Street
Oakland, CA

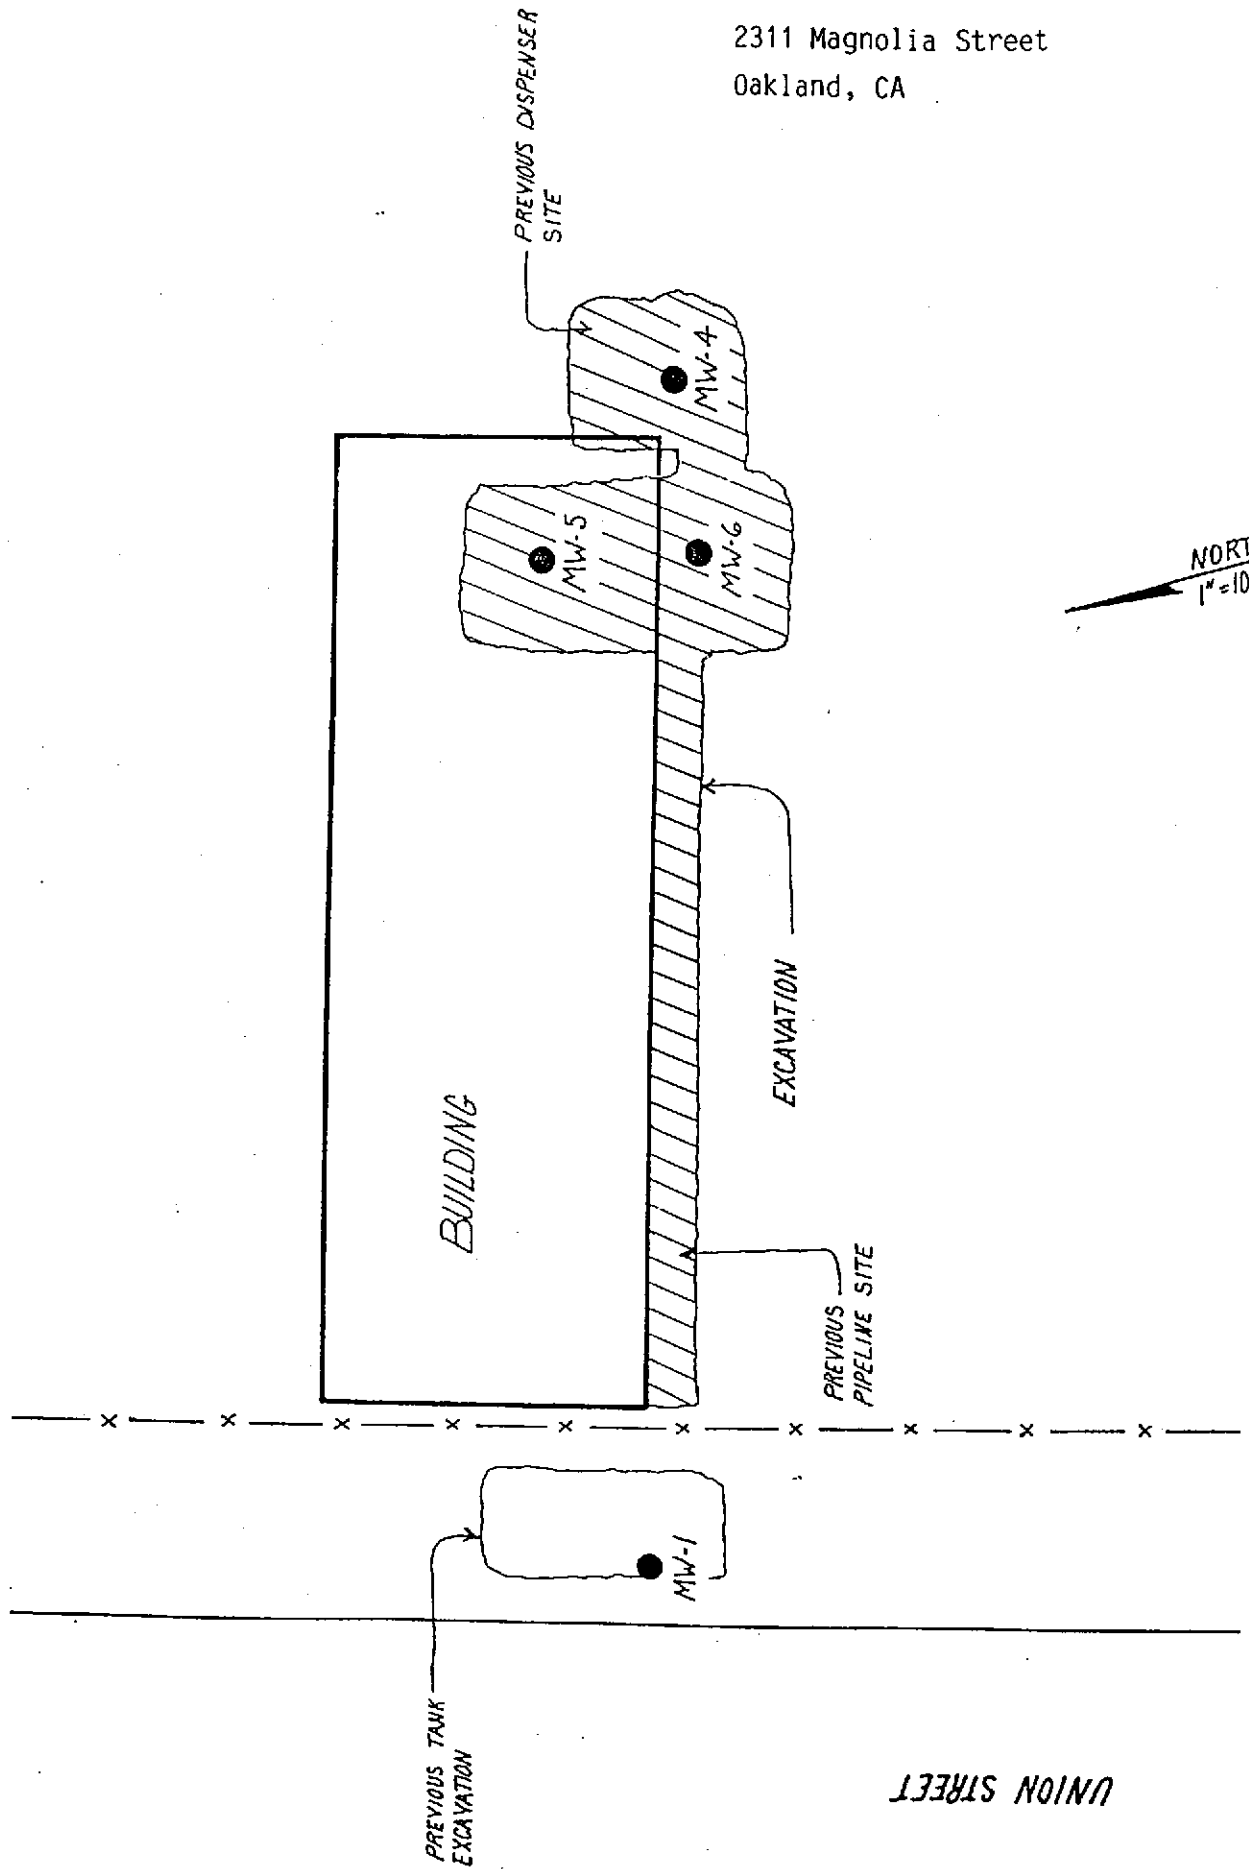

UNION STREET

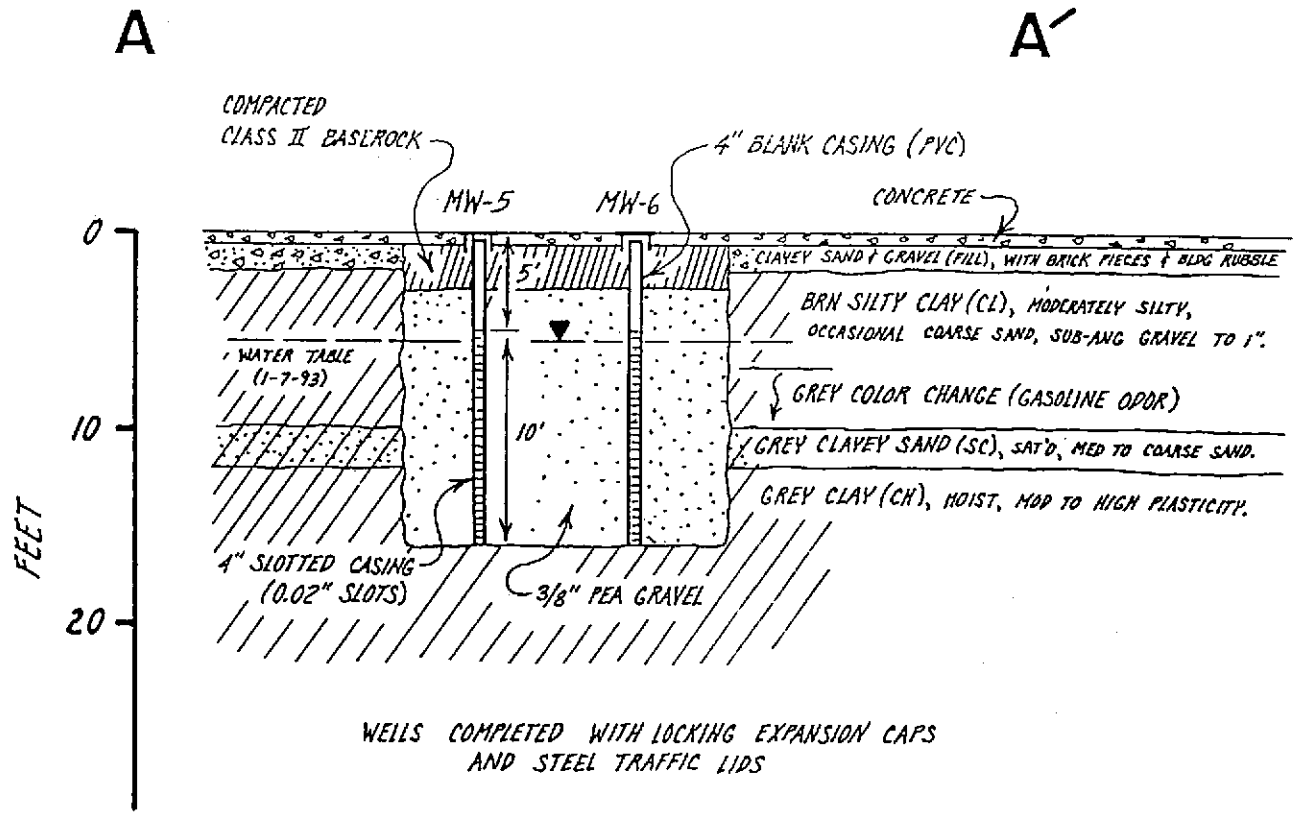

WELLS COMPLETED WITH LOCKING EXPANSION CAPS
AND STEEL TRAFFIC LIDS

SCALE

HORIZ: 1"=10'
VERT: 1"=10'

2311 Magnolia Street
Oakland, California

MW-4, MW-5, MW-6 all
have similar data
were excavations - backfilled

Oakland City Center
500 12th Street
Suite 100
Oakland, CA 94607-4014
(415) 893-3600

01-033A-B&F
Woodward-Clyde Consultants

Invd
Add✓

IS/4W 27A 2-9
IS/4W 27A
9 Borings
RECEIVED

June 2, 1989

JUN -5 1989

Alameda County Flood Control
And Water Conservation District
5997 Parkside Drive
Pleasanton, California 94566

ZONE 7, ACFC&WCD

Attention: Permits Department

Gentlemen:

Subject: Well Construction Report, Permits 89146, 89176, 89213,
89241, and 89310.

This Well Construction Report transmits information required by Groundwater Protection Ordinance, Permits 89146, 89176, 89213, 89241, and 89310 for the installation of several monitoring wells, piezometers, and soil borings and for the destruction of the piezometers. The wells, piezometers, and borings were installed at 2311 Adeline Street (see Figure 1) during the period of March 11 through May 11, 1989.

Three piezometers (P-N, P-SE, and P-SW) were installed under permit 89146 on March 11 in locations shown on Figure 2. The piezometers were installed according to the well logs attached in Appendix 1. Piezometer P-N was drilled to 30 ft depth and backfilled with cement/bentonite grout to 14 ft depth prior to installation of the piezometer casing. The hole was backfilled immediately after drilling and had about 1 foot of water in the bottom at the time of grouting. The upper seals were installed above the water table with bentonite pellets and cement/bentonite grout. Grout was installed by shoveling into the hole. Water levels were periodically measured in the piezometers and on April 11 the depth below top of casing were 6.36 ft, 11.21 ft, and 11.14 ft for P-N, P-SE, and P-SW, respectively.

The piezometers were abandoned on May 11 under permit 89310. Each piezometer was drilled out to the bottom of the sand pack using an 8-inch diameter auger and then immediately backfilled with cement/bentonite grout. Because the water bearing formation at this site produces water very slowly and because the borings were relatively shallow (less than 30 feet), the drilled-out piezometers accumulated between 0 and 2 feet of water prior to backfilling at time of abandonment. Grouting was done by tailgating from a cement truck.

Eight soil borings (B-3 through -10) were drilled on April 10, 11, and 12 under permit 89213 in locations identified on Figure 2. This is two borings more than were initially requested under permit

Consulting Engineers, Geologists
and Environmental Scientists

Offices in Other Principal Cities



15/4W-27H


89213. The borings were logged and sampled and the boring logs are presented in Appendix 1. The borings were backfilled immediately after drilling with cement/bentonite grout. The holes had very little water in them (between 0 and 2 feet) at time of backfilling so it was not necessary to tremie grout into the holes. Boring B-10 was a hand augered dry hole to 5 feet and was backfilled with tamped in cuttings.

One monitoring well (MW-2) was installed on April 10 under permit 89176 (and also mistakenly under permit 89213) and four additional monitoring wells (MW-3 through -6) were installed on May 11 under permit 89241 in locations shown on Figure 3. Each well was logged and installed with sand packs and seals as shown on the monitoring well logs attached in Appendix 1. Each well was sealed above the groundwater table by bentonite pellets and end-dumped cement/bentonite grout. The wells are being monitored for TPH (gasoline) and BTE&X on a quarterly basis and the results of the monitoring are available from the Alameda County Health Care Services. On May 23, the wells were sounded and their water levels were 9.37 ft, 8.38 ft, 11.08 ft, 9.73 ft, and 10.58 ft depth below top of casing for MW-2 through -6, respectively.

If you have any question concerning the installation or abandonment of these soil borings, monitoring wells, or piezometers, please call Stan Clarke at 874-3096.

Sincerely,

Woodward-Clyde Consultants

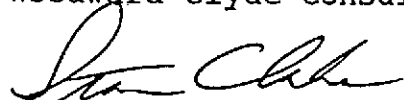


Stanton L. Clarke, P.E.
Project Engineer


cc Ned Clyde Construction



15/4W-2714
01-033A-RP

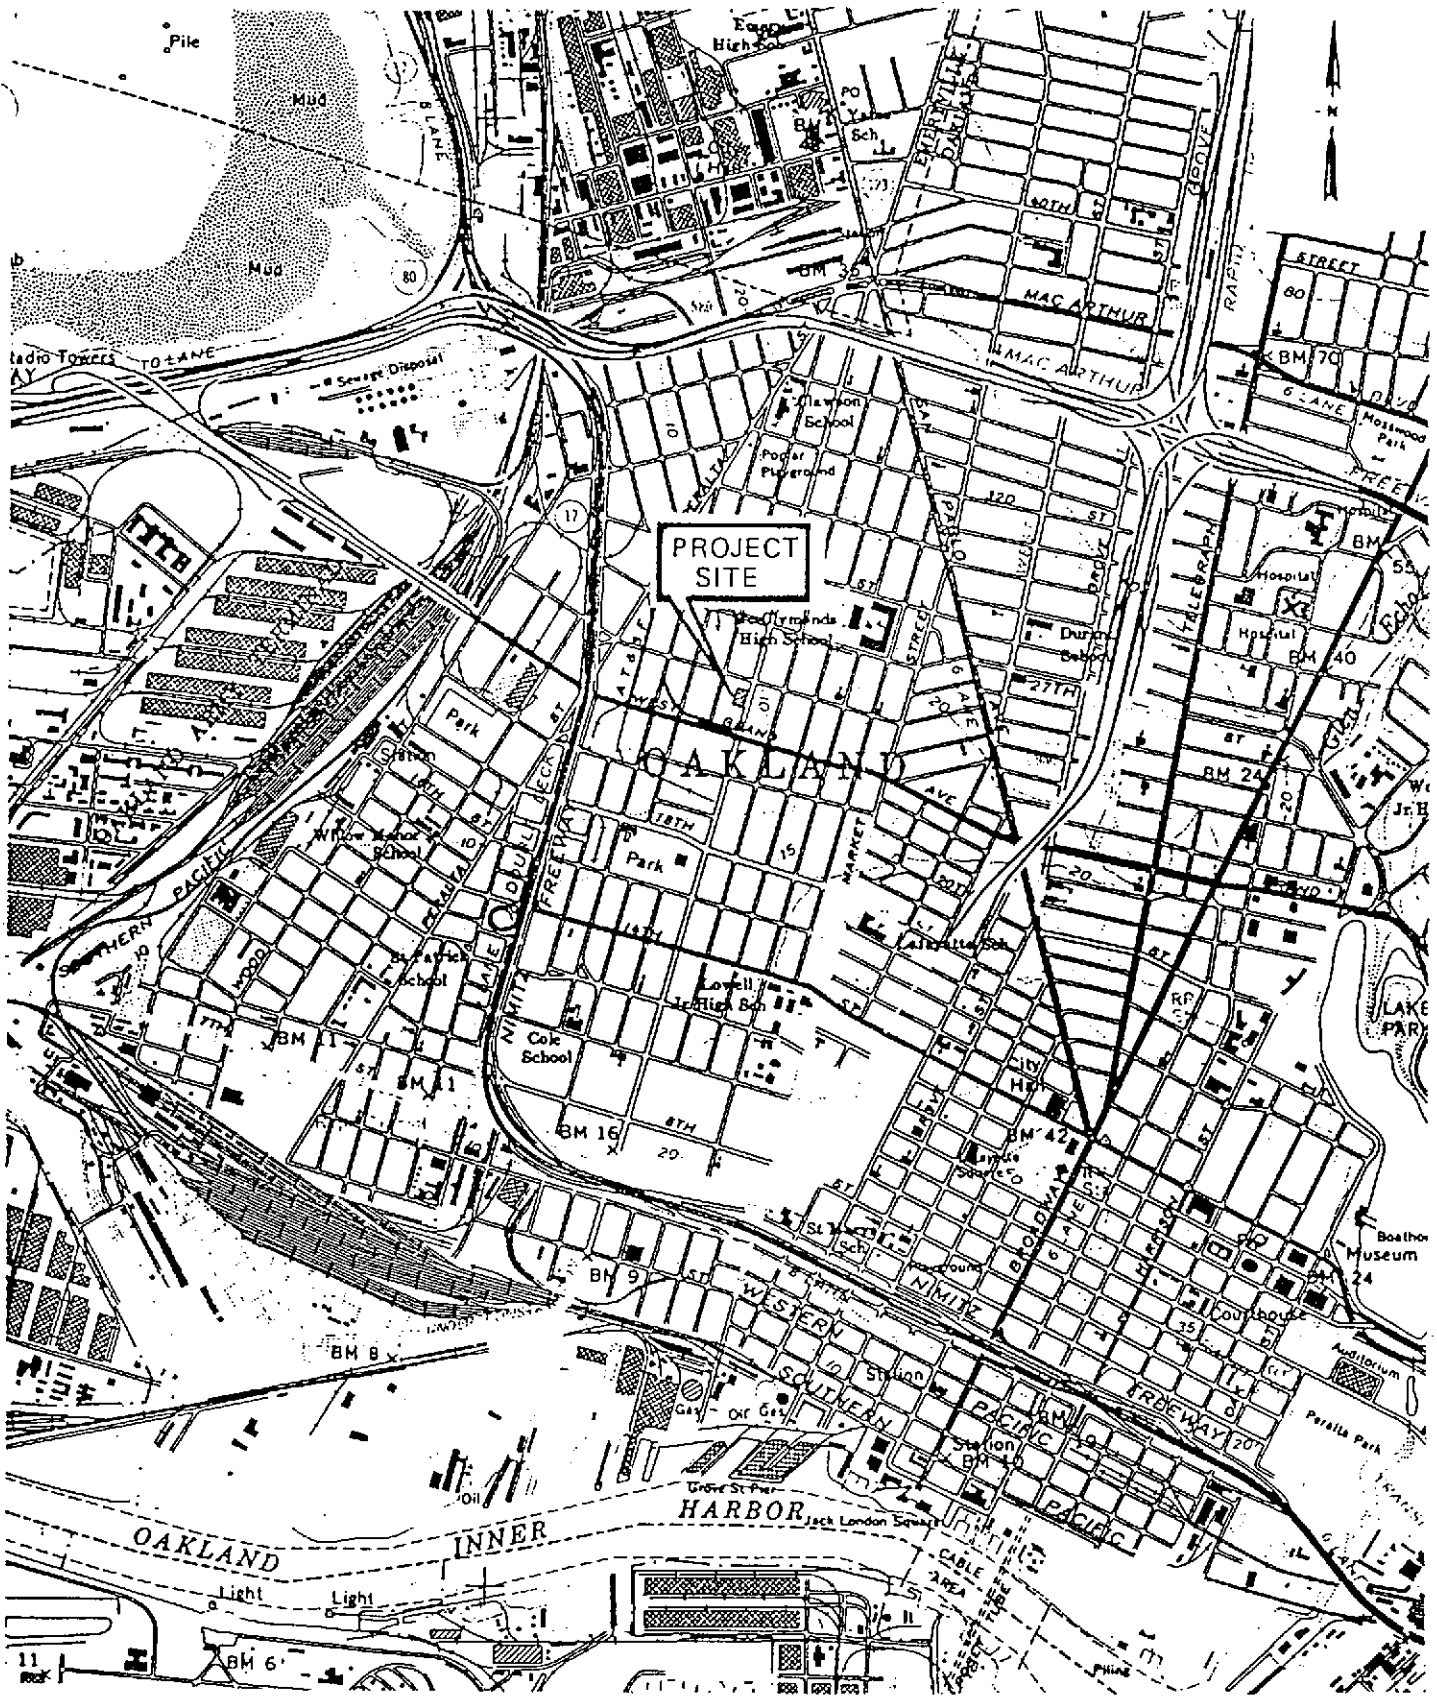


Reference USGS Oakland West, California
1959, Revised 1980

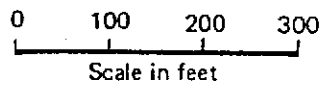


Project No. 8910023A	NED CLYDE CONSTRUCTION	SITE LOCATION MAP	Figure 1
Woodward-Clyde Consultants			

Woodward-Clyde Consultants	Project No. 8810023C
	NED CLYDE CONSTRUCTION
PHASE 2 INVESTIGATION PLAN 2311 ADELINE STREET	
Figure 2	

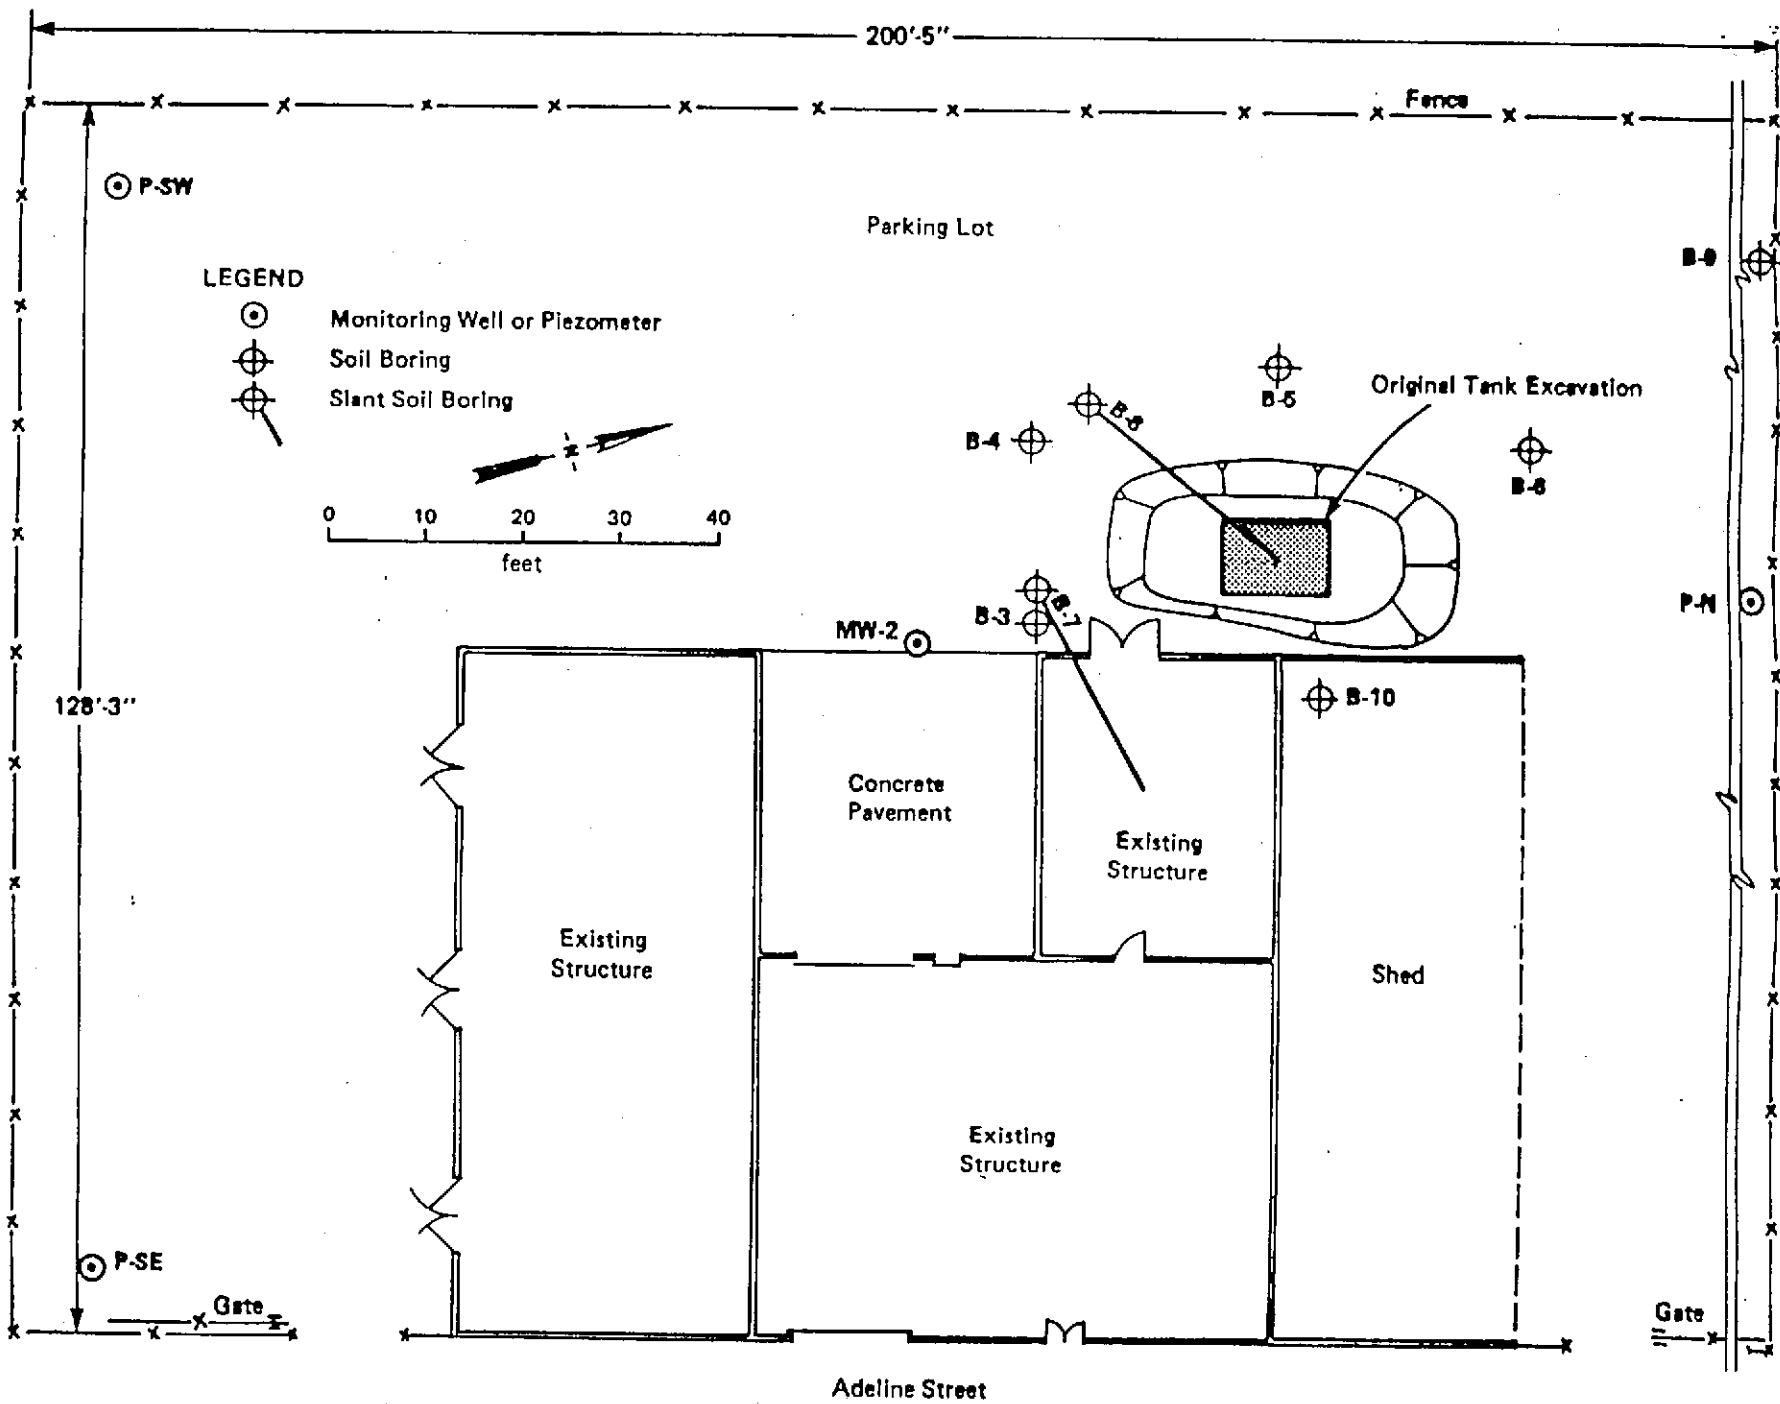

Woodward-Clyde Consultants	Project No. 8910023B
	NED CLYDE CONSTRUCTION
RELATIVE GROUNDWATER ELEVATIONS	
MAY 23, 1989	
2311 ADELINE STREET	
Figure 3	

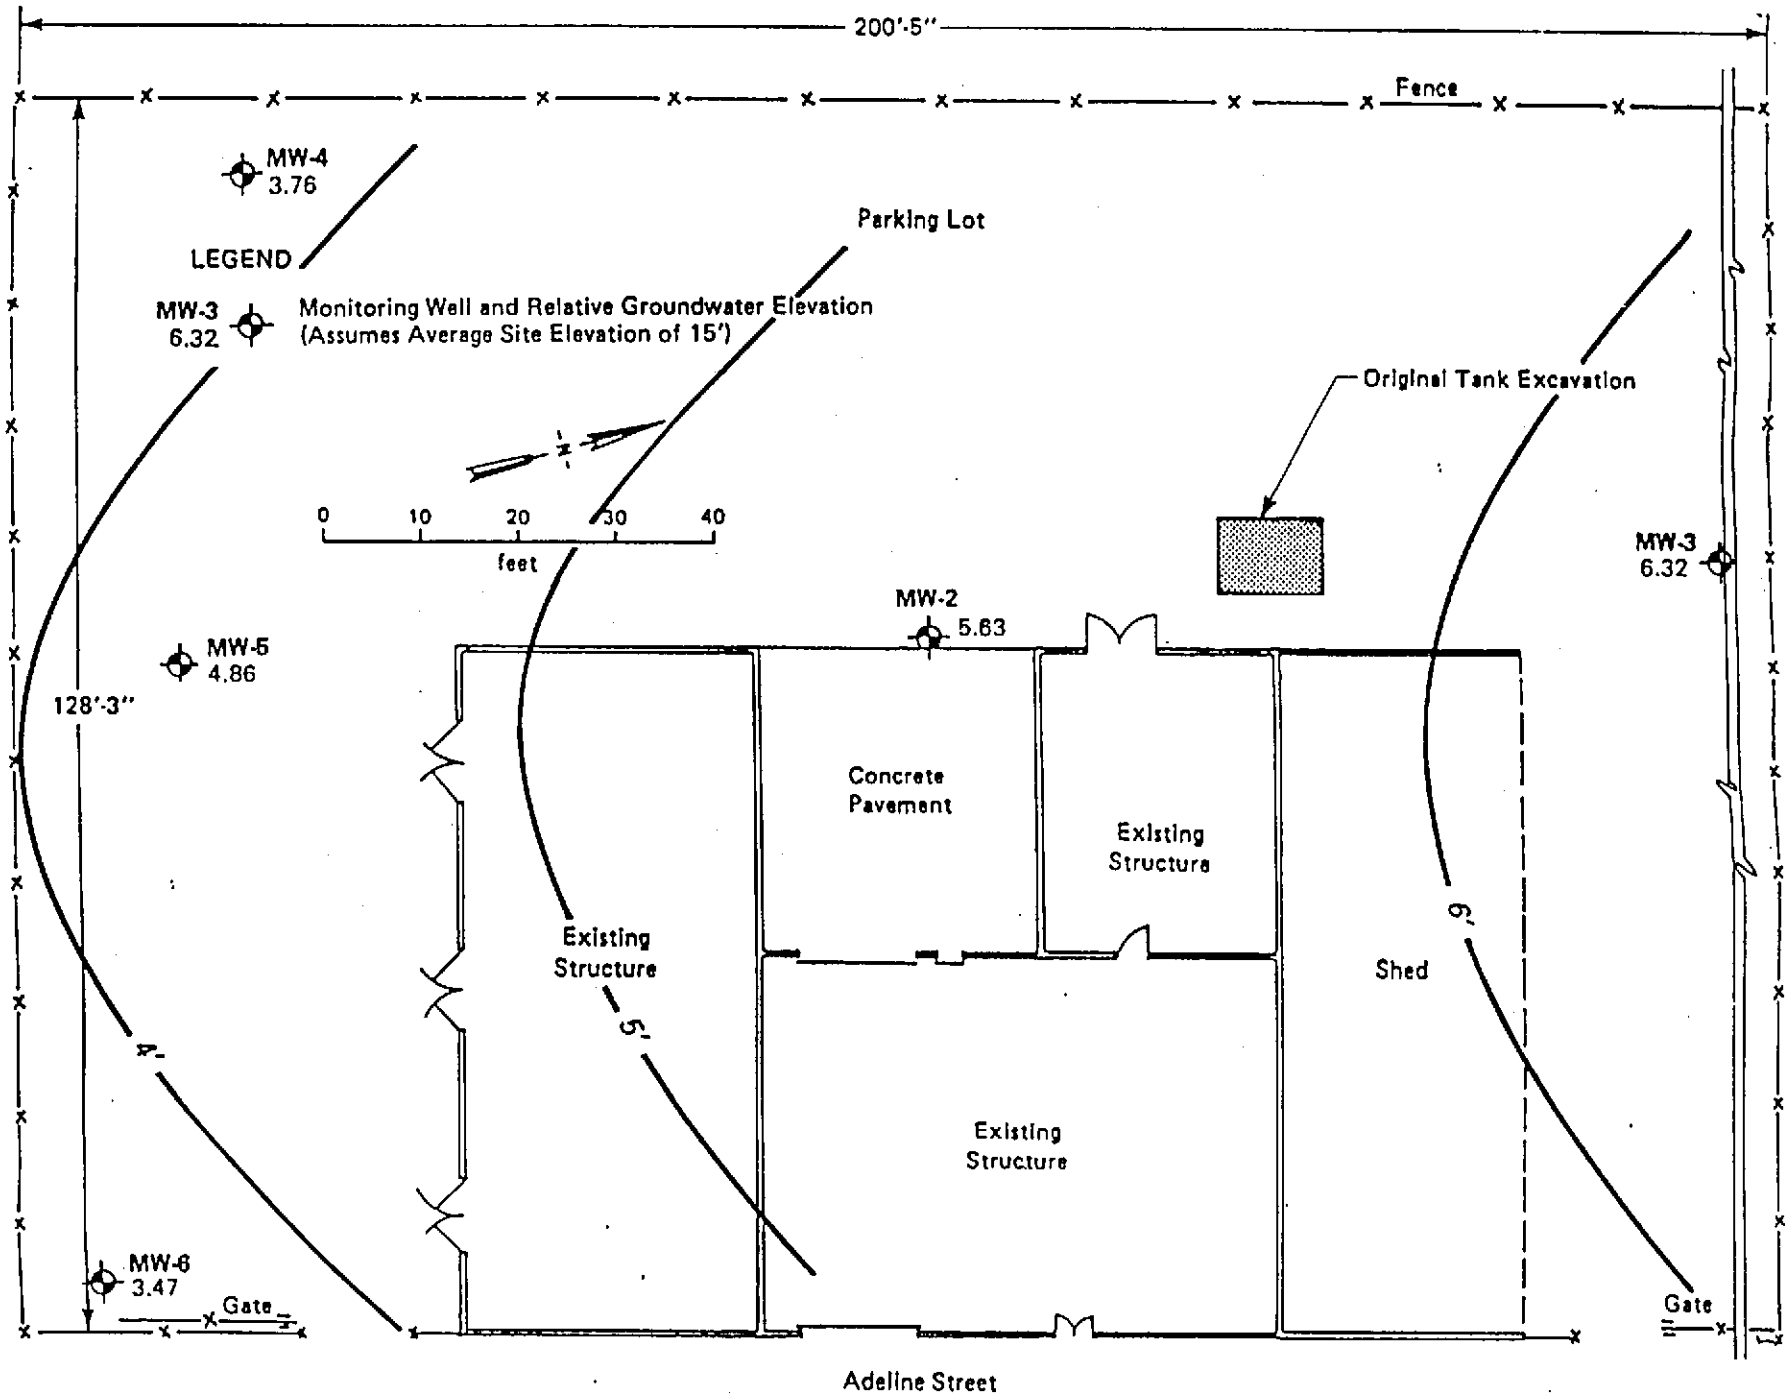

01-033A-18 15/40-27H

01-033A-EP
IS/4W-27H

APPENDIX A
LOGS OF BORINGS

Woodward-Clyde Consultants

PROJECT NAME NED CLYDE GW MONITORING NO. 8910023B

Add Inv 15/4w 27H 2

BORING LOCATION P-N North side of Property		ELEVATION AND DATUM N/A	
DRILLING AGENCY ENSCO	DRILLER G. Nunes	DATE STARTED DATE FINISHED March 10, 1989	
DRILLING EQUIPMENT Mobile B-34		COMPLETION DEPTH 16'	SAMPLER N/A
DRILLING METHOD 8" Hollow-stem Auger	DRILL BIT 8" Auger	NO. OF SAMPLES	DIST. N/A UNDIST. N/A
SIZE AND TYPE OF CASING 2" Schedule 40 PVC		WATER LEVEL	FIRST N/A COMPL. N/A 24 HRS. N/A
TYPE OF PERFORATION .010" Slotted	FROM 4.0 TO 14.0 Ft.	LOGGED BY: C. Parton and S. Clarke	
SIZE AND TYPE OF PACK #2/12 Lonestar Monterey Sand	FROM 3.0 TO 14.0 Ft.		
TYPE OF SEAL	FROM 2.0 TO 3.0 Ft.		
	NO. 1 Bentonite Pellets	FROM 0.0 TO 2.0 Ft.	CHECKED BY:
	NO. 2 Concrete/Bentonite Grout	and 30.0 TO 14.0 Ft.	

DEPTH (feet)	DESCRIPTION	GRAPHIC LOG		Water Content	Piezometer Data	SAMPLES					REMARKS (Drill Rate, Fluid Loss, Odor, etc.)
		Lithology	Piezometer Installation			Drive Number	Sample Number	Recov. (Feet)	Blow Counts		
0 - 5	Sandy Clay (CL) dark brown, moist										
5 - 10	Silty Clay (CH) Moist, light brown										
10 - 15	Sandy Clay (CL) light brown, moist										
15 - 20	Silty Clay (CL) brown, saturated										
20 - 30	Gravel layer, to 1/2" diam., becoming wet										
30 - 35	Augered to 30', backfilled to 14' with cement bentonite grout										

Piezometer Legend

- Slotted Well Screen
- Sand Pack
- Bentonite Pellets
- Cement/Bentonite Grout

Woodward-Clyde Consultants

PROJECT NAME **NED CLYDE GW MONITORING** NO. **8910023B**

Add Inv ✓ 15/4W 27H3 01-0000

BORING LOCATION P-SE SE Corner of Property		ELEVATION AND DATUM N/A	
DRILLING AGENCY ENSCO	DRILLER G. Nunes	DATE STARTED DATE FINISHED March 10, 1989	
DRILLING EQUIPMENT Mobile B-34		COMPLETION DEPTH 16'	SAMPLER N/A
DRILLING METHOD 8" Hollow-stem Auger	DRILL BIT 8" Auger	NO. OF SAMPLES	DIST. N/A UNDIST. N/A
SIZE AND TYPE OF CASING 2" Schedule 40 PVC		WATER LEVEL	FIRST COMPL. N/A 24 HRS. N/A
TYPE OF PERFORATION .010" Slotted	FROM 6.0 TO 16.0 Ft.	LOGGED BY: A. McDonald	
SIZE AND TYPE OF PACK #2/12 Lonestar Monterey Sand	FROM 4.0 TO 16.0 Ft.		
TYPE OF SEAL			
NO. 1 Bentonite Pellets	FROM 3.0 TO 4.0 Ft.	CHECKED BY:	
NO. 2 Concrete/Bentonite Grout	FROM 0.0 TO 3.0 Ft.		

DEPTH (feet)	DESCRIPTION	GRAPHIC LOG		Water Content	Piezometer Data	SAMPLES					REMARKS (Drill Rate, Fluid Loss, Odor, etc.)
		Lithology	Piezometer Installation			Drive Number	Sample Number	Recover. (Feet)	Blow Counts		
0 - 5	Gravel Base Coarse, (Fill) brown, moist										
5 - 10	Silty Clay (CH) Moist, dark gray										
10 - 15	Silty Clay (CL) dark brown, moist, very stiff										
15 - 20	Clayey Silt (ML) Light brown, fine sand, moist										
20 - 25	Gravel layer, to 1/2" diam., becoming wet										
25 - 30	Silty Sand (SM), medium grained, saturated										
30 - 35	Augered to 18', hole caved to 16'										

Piezometer Legend


- Slotted Well Screen
- Sand Pack
- Bentonite Pellets
- Cement/Bentonite Grout

Add Inv 15/4W 27H 4 01-033C


Woodward-Clyde Consultants

PROJECT NAME NED CLYDE GW MONITORING NO. 8910023B

BORING LOCATION P-SW SE Corner of Property		ELEVATION AND DATUM N/A			
DRILLING AGENCY ENSCO	DRILLER G. Nunes	DATE STARTED March 10, 1989			
DRILLING EQUIPMENT Mobile B-34		COMPLETION DEPTH 16'	SAMPLER N/A		
DRILLING METHOD 8" Hollow-stem Auger	DRILL BIT 8" Auger	NO. OF SAMPLES	DIST. N/A UNDIST. N/A		
SIZE AND TYPE OF CASING 2" Schedule 40 PVC		WATER LEVEL	FIRST COMPL. N/A 24 HRS. N/A		
TYPE OF PERFORATION .010" Slotted	FROM 6.0 TO 16.0 FL.	LOGGED BY: A. McDonald			
SIZE AND TYPE OF PACK #2/12 Lonestar Monterey Sand	FROM 4.0 TO 16.0 FL.			CHECKED BY:	
TYPE OF SEAL					
NO. 1 Bentonite Pellets	FROM 3.0 TO 4.0 FL.				
NO. 2 Concrete/Bentonite Grout	FROM 0.0 TO 3.0 FL.				

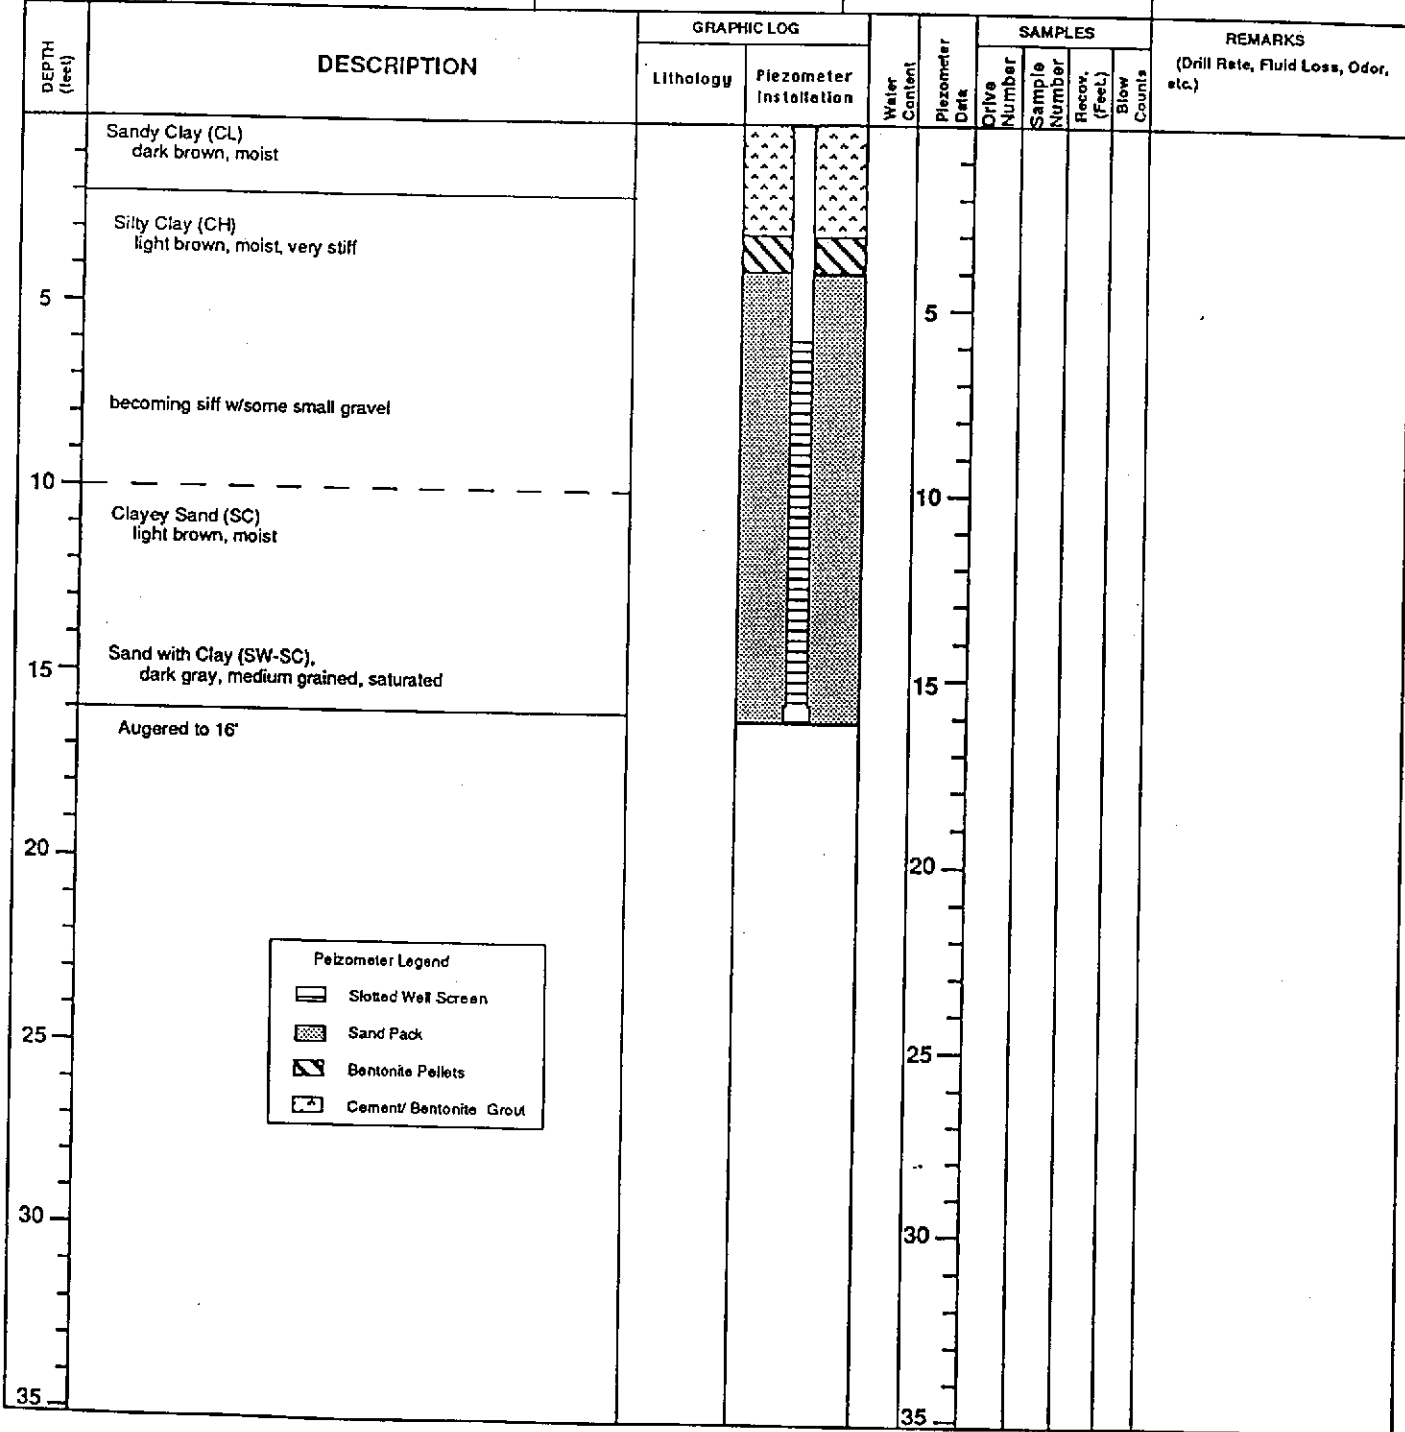


BORING LOCATION MW-7 10' E of SW corner of building		ELEVATION AND DATUM N/A	
DRILLING AGENCY ENSCO	DRILLER Frank	DATE STARTED November 29, 1990	
DRILLING EQUIPMENT Mobile B-51		COMPLETION DEPTH 18'	SAMPLER 2.0" Modified California Type
DRILLING METHOD 8" Hollow-stem Auger	DRILL BIT 8" Auger	NO. OF SAMPLES DIST. 4	UNDIST. N/A
SIZE AND TYPE OF CASING 2" Schedule 40 PVC		WATER LEVEL FIRST 12	COMPL. N/A 24 HRS. N/A
TYPE OF PERFORATION .020" Slotted		LOGGED BY: T. Ross	
SIZE AND TYPE OF PACK #2/20 Lonestar Monterey Sand		CHECKED BY:	
TYPE OF SEAL	NO. 1 Bentonite Pellets	FROM 5.0 TO 6.0 FL.	
	NO. 2 Cement	FROM 0.4 TO 5.0 FL.	

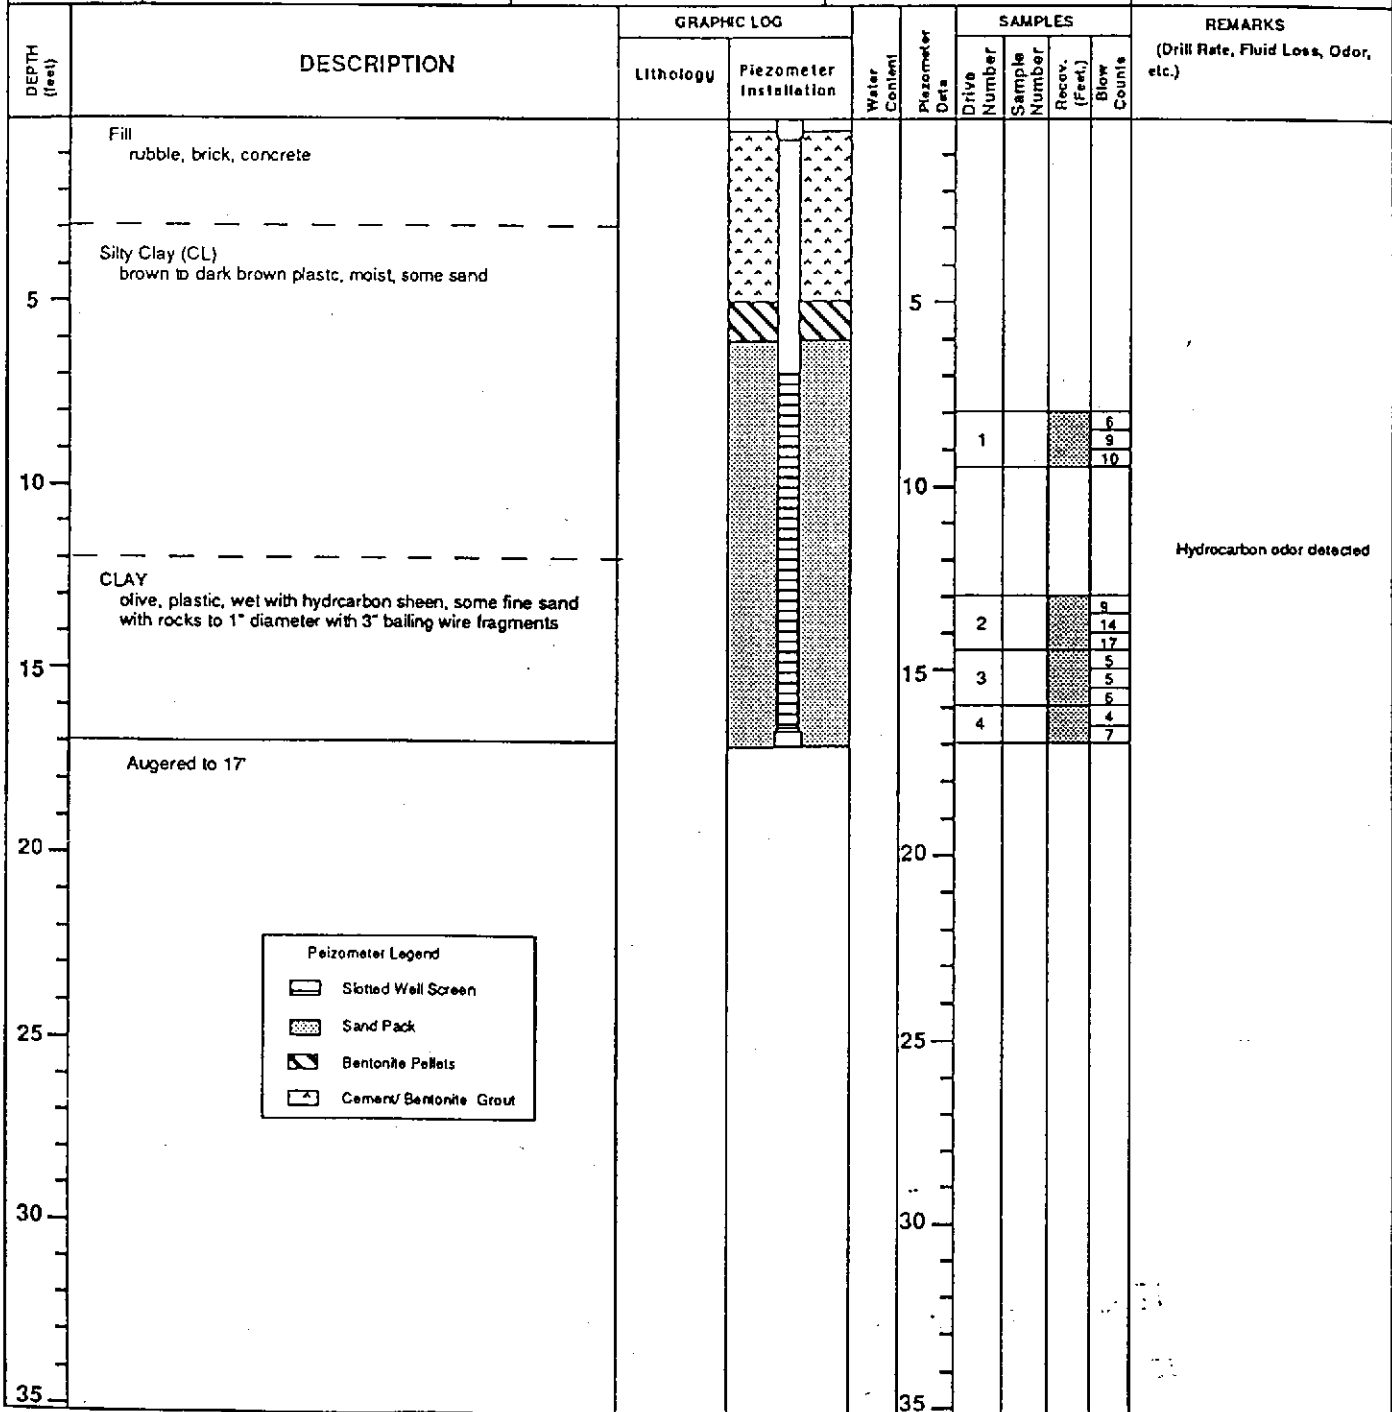

phone 415-893 3600

Driller Enesco Environmental
ENSCO?

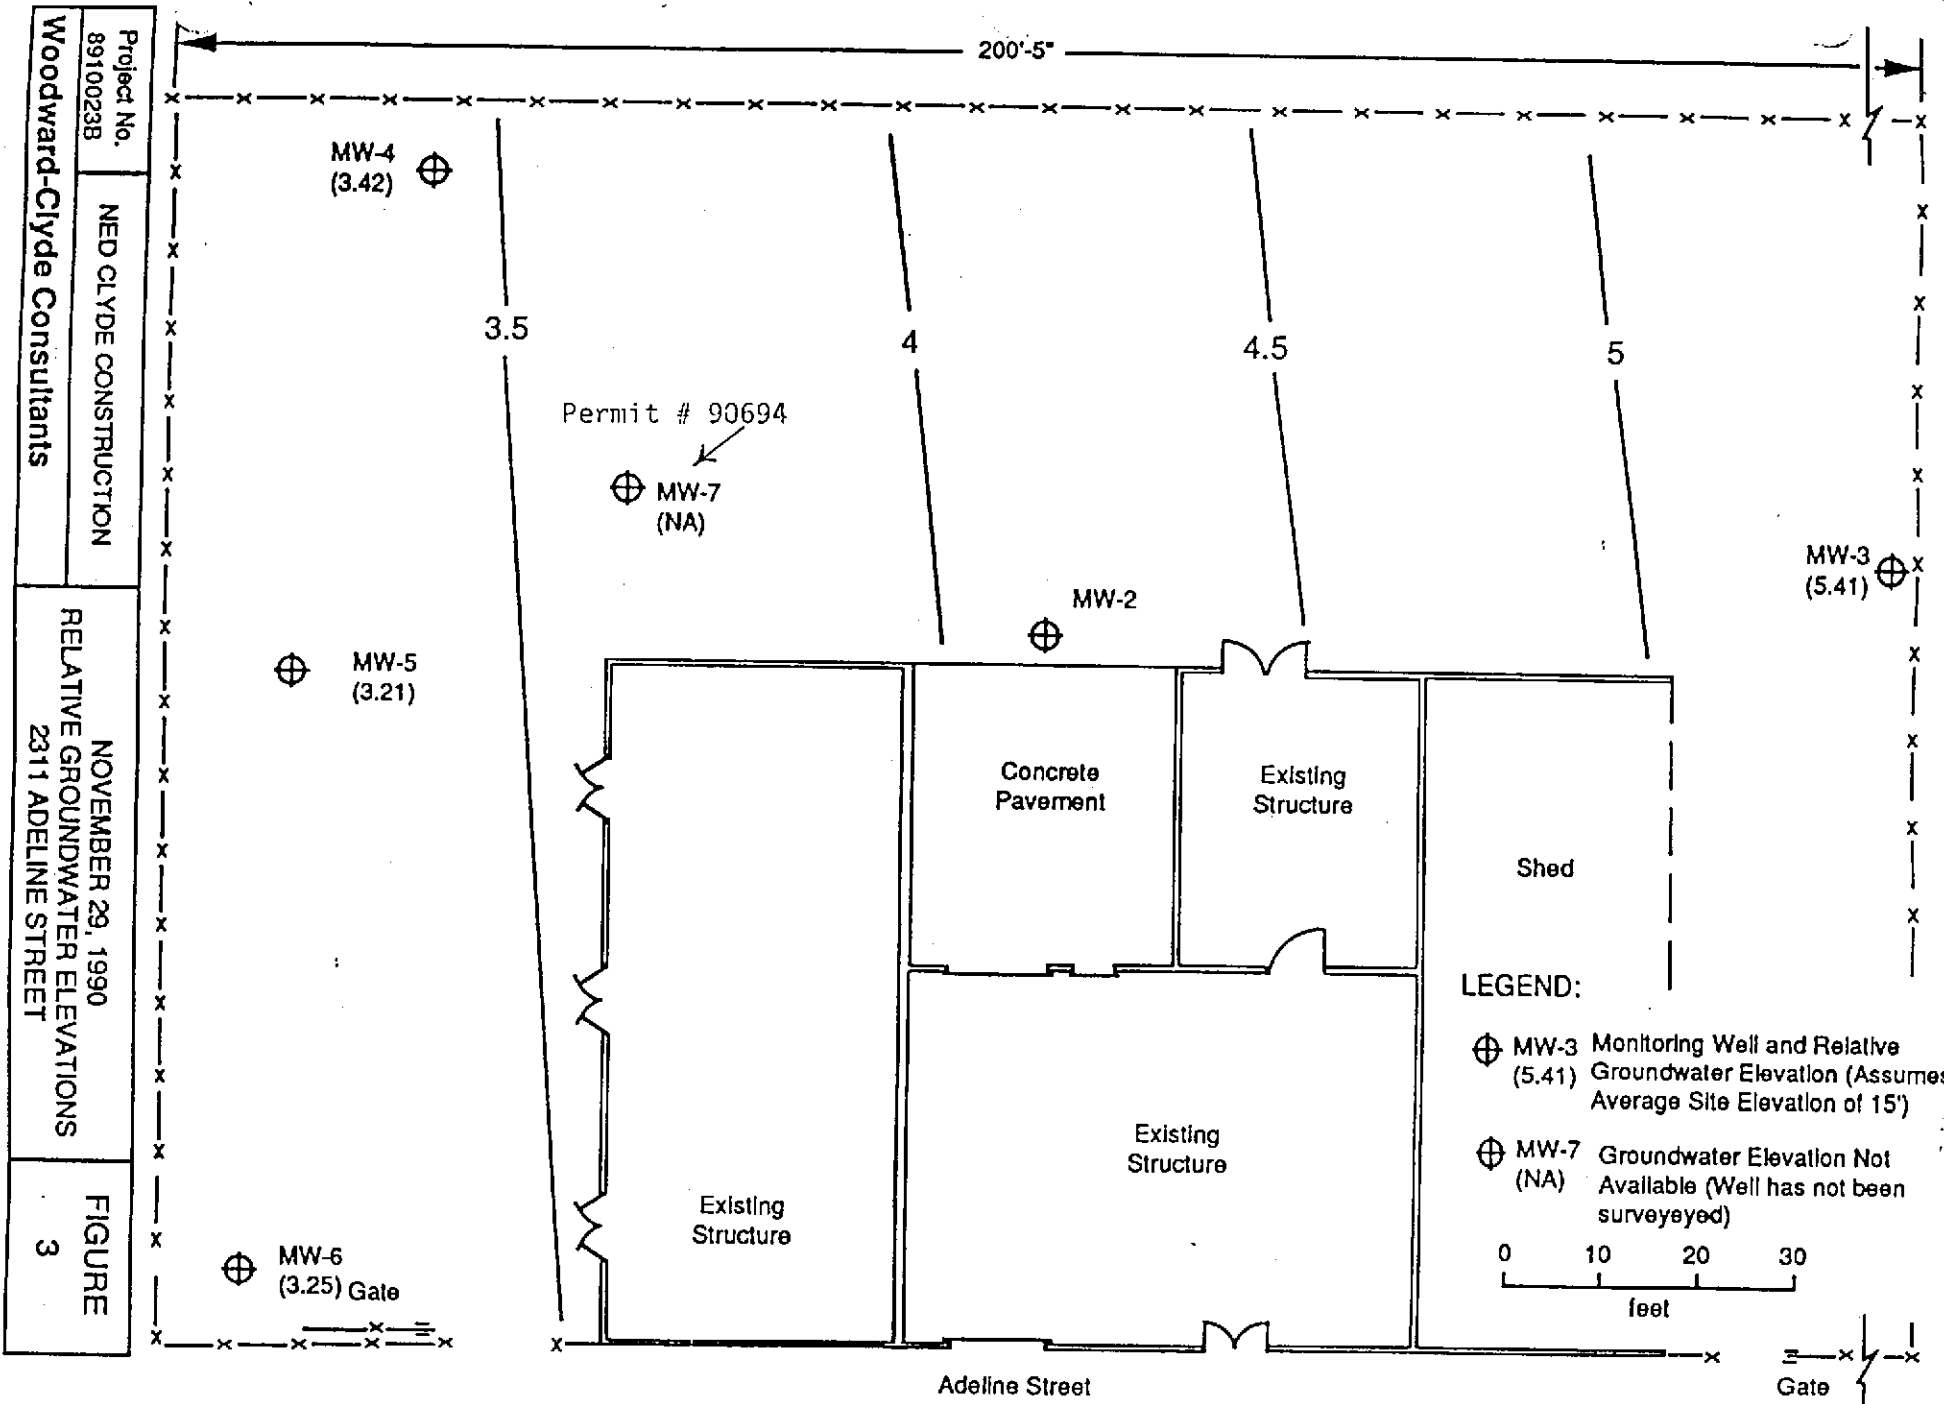

15/4W 27H10

BORING LOCATION B-3		ELEVATION AND DATUM N/A	
DRILLING AGENCY ENSCO	DRILLER G. Nunes	DATE STARTED DATE FINISHED April 10, 1989	
DRILLING EQUIPMENT Mobile B-53		COMPLETION DEPTH 24.5'	SAMPLER 2.5" Modified California Type
DRILLING METHOD 8" Hollow-stem Auger	DRILL BIT 8" Auger	NO. OF SAMPLES	DIST. 4 UNDIST. N/A
SIZE AND TYPE OF CASING N/A		WATER LEVEL	FIRST 18' COMPL. N/A 24 HRS. N/A
TYPE OF PERFORATION N/A		FROM N/A TO N/A FL.	
SIZE AND TYPE OF PACK N/A		FROM N/A TO N/A FL.	
TYPE OF SEAL	NO. 1 N/A	FROM N/A TO N/A FL.	
	NO. 2 N/A	FROM N/A TO N/A FL.	
		LOGGED BY: J. Springer	
		CHECKED BY:	

DEPTH (feet)	DESCRIPTION	GRAPHIC LOG		Water Content	Piezometer Data	SAMPLES			REMARKS (Drill Rate, Fluid Loss, Odor, etc.)
		Lithology	Piezometer Installation			Drive Number	Sample Number	Recover. (Feet.)	
0-5	Silty Clay (CL-CH) black, plastic, damp								20 ppm HNu Reading Hydrocarbon Odor
5-10	Clay (CH) dark blue-gray, plastic, damp becomes olive brown					1		8 15 20	250 ppm HNu Reading Strong Hydrocarbon Odor
10-15	Clay (CH) mottled olive brown and light gray, damp, plastic, specs of charcoal					2		10 12 12	3 ppm HNu Reading Slight (?) Hydrocarbon Odor
15-20	Clay (CH) steel gray, plastic, occasional pebbles, trace of sand					3		8 10 10	7 ppm HNu Reading
20-25	As above					4		7 10 13	0 ppm HNu Reading
25-35	Bottom of boring at 24.5'								

Woodward-Clyde Consultants

ADDU INC 15/4W 274 01-033E
 PROJECT NAME NED CLYDE PHASE 2 NO. 8910023C

BORING LOCATION B-4		ELEVATION AND DATUM N/A	
DRILLING AGENCY ENSCO	DRILLER G. Nunes	DATE STARTED April 10, 1989	
DRILLING EQUIPMENT Mobile B-53		COMPLETION DEPTH 19.5'	SAMPLER 2.5" Modified California Type
DRILLING METHOD 8" Hollow-stem auger	DRILL BIT 8" Auger	NO. OF SAMPLES	DIST. 3 UNDIST. N/A
SIZE AND TYPE OF CASING N/A		WATER LEVEL	FIRST N/A COMPL. N/A 24 HRS. N/A
TYPE OF PERFORATION N/A	FROM N/A TO N/A Ft.	LOGGED BY: J. Springer	
SIZE AND TYPE OF PACK N/A	FROM N/A TO N/A Ft.		
TYPE OF SEAL	NO. 1 N/A NO. 2 N/A		

DEPTH (feet)	DESCRIPTION	GRAPHIC LOG		Water Content	Piezometer Data	SAMPLES				REMARKS (Drill Rate, Fluid Loss, Odor, etc.)
		Lithology	Piezometer Installation			Drive Number	Sample Number	Recov. (Feet)	Blow Counts	
0 - 5	Clay (CH) black, little silt, plastic, damp									2 ppm HNu Reading Hydrocarbon Odor
5 - 10	Clay (CH) olive green, plastic, damp As above					1		8 12 12		350 ppm HNu Reading Strong Hydrocarbon Odor
10 - 15	Clay (CH) mottled olive brown and steel gray, little sand					2		10 10 18		10 ppm HNu Reading Hydrocarbon Odor
15 - 20	Clay (CH) steel gray, plastic, few pebbles					3		6 8 8		0 ppm HNu Reading
20 - 19.5	Bottom of boring at 19.5'									

BORING LOCATION B-6			ELEVATION AND DATUM N/A		
DRILLING AGENCY ENSCO		DRILLER G. Nunes	DATE STARTED April 11, 1989 DATE FINISHED		
DRILLING EQUIPMENT Mobile B-53			COMPLETION DEPTH 19.5'	SAMPLER 2.5" Modified California Type	
DRILLING METHOD 8" Hollow-stem Auger		DRILL BIT 8" Auger	NO. OF SAMPLES	DIST. 3	UNDIST. N/A
SIZE AND TYPE OF CASING N/A			WATER LEVEL	FIRST N/A	COMPL. N/A 24 HRS. N/A
TYPE OF PERFORATION N/A		FROM N/A TO N/A FL.	LOGGED BY: J. Springer		CHECKED BY:
SIZE AND TYPE OF PACK N/A		FROM N/A TO N/A FL.			
TYPE OF SEAL	NO. 1 N/A	FROM N/A TO N/A FL.			
	NO. 2 N/A	FROM N/A TO N/A FL.			

DEPTH (feet)	DESCRIPTION	GRAPHIC LOG		Water Content	Piezometer Data	SAMPLES					REMARKS (Drill Rate, Fluid Loss, Odor, etc.)
		Lithology	Piezometer Installation			Drive Number	Sample Number	Recov. (Feet.)	Blow Counts		
5	Silty Clay (CL-CH) black, plastic, damp										3.5 ppm HNu Reading Hydrocarbon Odor
10	Clay (CH) olive green, trace of sand, plastic, damp					1		9 17 17			200 ppm HNu Reading Strong Hydrocarbon Odor
15	as above sandy at top of sample, trace of gravel					2		6 6 8			10 ppm HNu Reading
20	Clay (CH) steel gray, little silt, damp					3		7 7 12			0 ppm HNu Reading
20	Bottom of boring at 19.5'										

BORING LOCATION B-7			ELEVATION AND DATUM N/A		
DRILLING AGENCY ENSCO		DRILLER	DATE STARTED April 11, 1989		
DRILLING EQUIPMENT Mobile B-53			COMPLETION DEPTH 31.5'	SAMPLER 2.5" Modified California Type	
DRILLING METHOD 8" Hollow-stem Auger		DRILL BIT	NO. OF SAMPLES	DIST. 4	UNDIST. N/A
SIZE AND TYPE OF CASING N/A			WATER LEVEL	FIRST N/A	COMPL. N/A 24 HRS. N/A
TYPE OF PERFORATION N/A		FROM N/A TO N/A FL.	LOGGED BY: J. Springer		CHECKED BY:
SIZE AND TYPE OF PACK N/A		FROM N/A TO N/A FL.			
TYPE OF SEAL	NO. 1 N/A	FROM N/A TO N/A FL.			
	NO. 2 N/A	FROM N/A TO N/A FL.			

DEPTH (feet)	DESCRIPTION	GRAPHIC LOG		Water Content	Piezometer Data	SAMPLES				REMARKS (Drill Rate, Fluid Loss, Odor, etc.)
		Lithology	Piezometer Installation			Drive Number	Sample Number	Recov. (Feet)	Blow Counts	
5	Silty Clay (CH) black, plastic, damp									45 Degree angle boring drift = N80E 15 ppm HNu Reading Slight Hydrocarbon Odor
10	Clay (CH) olive green with black streaks, plastic, damp									
10	Gravelly Sand (SW) gray, little silt, foundation fill (?)					1			Push	True vertical depth = 7.1' 20 ppm HNu Reading Slight Hydrocarbon Odor
15	Clay (CH) mottled olive brown and gray, plastic, damp					2			Push	True vertical depth = 10.6' 350 ppm HNu Reading Strong Hydrocarbon Odor
20	Gravelly Sand (SW) with some sandy clay (CH)									
20	Clay (CH) steel gray, little silt, damp, plastic					3			Push	True vertical depth = 14.1' 120 ppm HNu Reading Strong Hydrocarbon Odor
30	Sandy Clay (CL) mottled steel gray and olive brown, wet									
30	Bottom of boring at 31.5'					4			Push	True vertical depth = 21.2' 18 ppm HNu Reading Hydrocarbon Odor (Evaporates Quickly)
35										

Woodward-Clyde Consultants

ADD Inv 15/4/88 27H
 PROJECT NAME NED CLYDE PHASE 2 NO. 8910023C 01-0337

BORING LOCATION B-8		ELEVATION AND DATUM N/A	
DRILLING AGENCY ENSCO	DRILLER G. Nunes	DATE STARTED April 11, 1989	
DRILLING EQUIPMENT Mobile B-53		COMPLETION DEPTH 36.5'	SAMPLER 2.5" Modified California Type
DRILLING METHOD 8" Hollow-stem Auger	DRILL BIT 8" Auger	NO. OF SAMPLES	DIST. 5 UNDIST. N/A
SIZE AND TYPE OF CASING N/A		WATER LEVEL	FIRST N/A COMPL. N/A 24 HRS. N/A
TYPE OF PERFORATION N/A		FROM N/A TO N/A F.	
SIZE AND TYPE OF PACK N/A		FROM N/A TO N/A F.	
TYPE OF SEAL	NO. 1 N/A	FROM N/A TO N/A F.	
	NO. 2 N/A	FROM N/A TO N/A F.	
LOGGED BY: J. Springer		CHECKED BY:	

DEPTH (feet)	DESCRIPTION	GRAPHIC LOG		Water Content	Piezometer Date	SAMPLES				REMARKS (Drill Rate, Fluid Loss, Odor, etc.)
		Lithology	Piezometer Installation			Drive Number	Sample Number	Recov. (feet)	Blow Counts	
5	Silty Clay (CH) black, damp, plastic									45 Degree angle hole drift = N35E
10	Silty Sand (SM), black, few pebbles									True Depth = 7.1'
11	Clay (CH) olive green, plastic, damp					1			Push	14 ppm HNu Reading Slight Hydrocarbon Odor
15	Clay (CH) mottled olive brown and green, little silt, damp, plastic									True Depth = 10.6'
16						2			Push	300 ppm HNu Reading Strong Hydrocarbon Odor
20	Silty Clay (CH) mottled steel gray and olive brown, damp									True Depth = 14.1'
21						3			Push	14 ppm HNu Reading
25										
28	as above with little silt and trace of sand									True Depth = 19.1'
29						4			Push	22 ppm HNu Reading
35										True Depth = 24.8'

DEPTH (feet)	DESCRIPTION	GRAPHIC LOG		Water Content	Piezometer Data	SAMPLES				REMARKS (Drill Rate, Fluid Loss, Odor, etc.)
		Lithology	Piezometer Installation			DRIVE NUMBER	SAMPLE NUMBER	Recon. (ft)	Blow Counts	
35	Clay (CH) mottled olive brown and steel gray, plastic, moist				35		5		Push	True Depth = 24.8' 80 ppm HNu Reading Slight Hydrocarbon Odor
	Bottom of boring at 36.5'									
40					40					
45					45					
50					50					
55					55					
60					60					
65					65					
70					70					
75					75					
80					80					

Woodward-Clyde Consultants

Add ✓ Inv 15/4W27H 01-0338
 PROJECT NAME NED CLYDE PHASE 2 NO. 8910023C

BORING LOCATION B-9		ELEVATION AND DATUM N/A	
DRILLING AGENCY ENSCO	DRILLER G. Nunes	DATE STARTED April 11, 1989	
DRILLING EQUIPMENT Mobile B-53		COMPLETION DEPTH 7.5'	SAMPLER 2.5" Modified California Type
DRILLING METHOD 8" Hollow-stem Auger	DRILL BIT 8" Auger	NO. OF SAMPLES	DIST. 1
SIZE AND TYPE OF CASING N/A		WATER LEVEL	FIRST N/A
TYPE OF PERFORATION N/A		FROM N/A TO N/A FL.	LOGGED BY: J. Springer
SIZE AND TYPE OF PACK N/A		FROM N/A TO N/A FL.	CHECKED BY:
TYPE OF SEAL	NO. 1 N/A	FROM N/A TO N/A FL.	COMPL. N/A 24 HRS. N/A
	NO. 2 N/A	FROM N/A TO N/A FL.	

DEPTH (feet)	DESCRIPTION	GRAPHIC LOG		Water Content	Piezometer Data	SAMPLES				REMARKS (Drill Rate, Fluid Loss, Odor, etc.)
		Lithology	Piezometer Installation			Drive Number	Sample Number	Recov. (Feet)	Blow Counts	
0 - 5	Silty Clay (CH-CL) black, trace of sand, damp									0 ppm HNu Reading
5 - 7.5	Clay (CH) olive green, trace of sand, roots, plastic, damp					1			6 8 12	0 ppm HNu Reading
7.5 - 35	Bottom of boring at 7.5'									

BORING LOCATION B-10		ELEVATION AND DATUM N/A	
DRILLING AGENCY WCC	DRILLER J. Springer	DATE STARTED	DATE FINISHED April 12, 1989
DRILLING EQUIPMENT Hand Auger		COMPLETION DEPTH 7.2'	SAMPLER 2.5" Modified California Type
DRILLING METHOD Hand Auger	DRILL BIT 6" O.D.	NO. OF SAMPLES	DIST. 2 UNDIST. N/A
SIZE AND TYPE OF CASING N/A		WATER LEVEL	FIRST N/A COMPL. N/A 24 HRS. N/A
TYPE OF PERFORATION N/A	FROM N/A TO N/A FL	LOGGED BY: J. Springer	
SIZE AND TYPE OF PACK N/A	FROM N/A TO N/A FL		
TYPE OF SEAL	FROM N/A TO N/A FL		
NO. 1 N/A	FROM N/A TO N/A FL	CHECKED BY:	
NO. 2 N/A	FROM N/A TO N/A FL		

DEPTH (feet)	DESCRIPTION	GRAPHIC LOG		Water Content	Piezometer Data	SAMPLES				REMARKS (Drill Rate, Fluid Loss, Odor, etc.)	
		Lithology	Piezometer Installation			Drive Number	Sample Number	Recov. (Feet)	Blow Counts		
	Sandy Gravel (GW), black, dry										
	Clay (CH), olive green, little silt, damp										Slight Hydrocarbon Odor
	Silty Clay (CH-CL), black, wet										Strong Hydrocarbon Odor
	Clay (CH), black, damp, plastic										Strong Hydrocarbon Odor
5	Clay (CH), dark green, plastic, damp pebbly at 5.8'				5						Strong Hydrocarbon Odor
	Clay (CH), tan to olive green						1				Strong Hydrocarbon Odor
	Bottom of boring at 7.2'										2 grab samples taken at 7.2'
10					10						
15					15						
20					20						
25					25						
30					30						
35					35						

Inn A 98/1514W27H 5 01-033AL

Woodward-Clyde Consultants

PROJECT NAME NED CLYDE PHASE 2 NO. 8910023C

BORING LOCATION MW-2		ELEVATION AND DATUM N/A	
DRILLING AGENCY ENSCO	DRILLER G. Nunes	DATE STARTED DATE FINISHED April 10, 1989	
DRILLING EQUIPMENT Mobile B-53		COMPLETION DEPTH 20.9'	SAMPLER 2.5" Modified California Type
DRILLING METHOD 8" Hollow-stem Auger	DRILL BIT 8" Auger	NO. OF SAMPLES	DIST. 3
SIZE AND TYPE OF CASING 2" Schedule 40 PVC		WATER LEVEL	FIRST 16'
TYPE OF PERFORATION .010" Slotted		FROM 10.6 TO 20.6 PL	
SIZE AND TYPE OF PACK #1/20 Lonestar Monterey Sand		FROM 7.5 TO 20.6 PL	
TYPE OF SEAL	NO. 1 Bentonite Pellets	FROM 6.5 TO 7.5 PL	
	NO. 2 Concrete	FROM 6.4 TO 6.5 PL	
		LOGGED BY: J. Springer	
		CHECKED BY:	

DEPTH (feet)	DESCRIPTION	GRAPHIC LOG		Water Content	Piezometer Data	SAMPLES				REMARKS (Drill Rate, Fluid Loss, Odor, etc.)
		Lithology	Piezometer Installation			Drive Number	Sample Number	Recov. (Feet)	Blow Counts	
0 - 5	Clay (CH) black, plastic, little silt, damp									0 ppm HNu Reading
5 - 7.5	Clay (CH) olive green, plastic, damp									
7.5 - 10.6	Clay (CH) mottled olive brown and gray									300 ppm HNu Reading Strong Hydrocarbon Odor
10.6 - 15	Clayey Sand (SC), brown, coarse-grained									Lost sample, went back, and drove sampler an additional 6"
15 - 17.5	Clay (CH) olive brown, plastic, wet									75 ppm HNu Reading Hydrocarbon Odor
17.5 - 20.6	Clay (CH) mottled olive brown and steel gray, plastic, damp									
20.6 - 20.9	Augered to 20.9'									
20.9 - 25										
25 - 30										
30 - 35										

Piezometer Legend

- Slotted Well Screen
- Sand Pack
- Bentonite Pellets
- Cement/Bentonite Grout

Woodward-Clyde Consultants





PROJECT NAME NED CLYDE GW MONITORING no. 8910023B

Add Inv 15/4W27H6 01-033# M

BORING LOCATION MW-3 <i>North Side of Property</i>		ELEVATION AND DATUM N/A	
DRILLING AGENCY ENSCO	DRILLER G. Nunes	DATE STARTED May 11, 1989	
DRILLING EQUIPMENT Mobile B-53		COMPLETION DEPTH 15'	SAMPLER 2.5" Modified California Type
DRILLING METHOD 8" Hollow-stem Auger	DRILL BIT 8" Auger	NO. OF SAMPLES DIST. N/A	UNDIST. 2
SIZE AND TYPE OF CASING 2" Schedule 40 PVC		WATER LEVEL FIRST 11'	COMPL. N/A 24 HRS. N/A
TYPE OF PERFORATION .010" Slotted	FROM 5.0 TO 15.0 FL.	LOGGED BY: S. Clarke	
SIZE AND TYPE OF PACK #1/20 Lonestar Monterey Sand	FROM 5.0 TO 15.0 FL.		
TYPE OF SEAL	FROM 4.0 TO 5.0 FL.		
NO. 1 Bentonite Pellets	FROM 0.4 TO 4.0 FL.	CHECKED BY:	

DEPTH (feet)	DESCRIPTION	GRAPHIC LOG		Water Content	Piezometer Data	SAMPLES					REMARKS (Drill Rate, Fluid Loss, Odor, etc.)
		Lithology	Piezometer Installation			Drive Number	Sample Number	Recov. (Feet)	Blow Counts		
0 - 5	Silty Clay (CH) Moist, dark gray Becoming gray Becoming light gray-brown										
5 - 10						1		NR	7 10 16		
10 - 15						2			7 13 13		
15 - 35	Augered to 15'										

Piezometer Legend

-  Slotted Well Screen
-  Sand Pack
-  Bentonite Pellets
-  Cement/Bentonite Grout

Woodward-Clyde Consultants

PROJECT NAME **NED CLYDE GW MONITORING** no. **8910023B**

Add Inv **1S/4W 27H7 N**

BORING LOCATION MW-4 <i>SW Corner of Property</i>		ELEVATION AND DATUM N/A	
DRILLING AGENCY ENSCO	DRILLER G. Nunes	DATE STARTED May 11, 1989	
DRILLING EQUIPMENT Mobile B-53		COMPLETION DEPTH 20'	SAMPLER 2.5" Modified California Type
DRILLING METHOD 8" Hollow-stem Auger	DRILL BIT 8" Auger	NO. OF SAMPLES DIST. N/A	UNDIST. N/A
SIZE AND TYPE OF CASING 2" Schedule 40 PVC		WATER LEVEL FIRST N/A	COMPL. N/A 24 HRS. N/A
TYPE OF PERFORATION .010" Slotted	FROM 8.0 TO 18.0 FL.	LOGGED BY: S. Clarke	
SIZE AND TYPE OF PACK #1/20 Lonestar Monterey Sand	FROM 7.0 TO 20.0 FL.		
TYPE OF SEAL	FROM 5.0 TO 7.0 FL.		
NO. 1 Bentonite Pellets	FROM 0.4 TO 5.0 FL.	CHECKED BY:	
NO. 2 Concrete/Bentonite Grout			

DEPTH (feet)	DESCRIPTION	GRAPHIC LOG				SAMPLES						REMARKS (Drill Rate, Fluid Loss, Odor, etc.)
		Lithology	Piezometer Installation	Water Content	Piezometer Data	Drive Number	Sample Number	Recovery (Feet)	Blow Counts			
0 - 2	2' Aggregate Base											
2 - 5	Silty Clay (CH) Moist, dark gray											
5 - 10	Silty Clay (CL) Moist, light brown Becoming brown with medium sand											
10 - 13	Gravel to 1/2"					1				6 10 15		
13 - 15	Clayey Sandy Silt (ML) Moist, light brown, fine sand											
15 - 18						2				5 8 8		
18 - 20	Augered to 20'											
20 - 35												

Piezometer Legend

- Slotted Well Screen
- Sand Pack
- Bentonite Pellets
- Cement/Bentonite Grout

Woodward-Clyde Consultants

Add Inv **LSHW 27H8** 01-033
 PROJECT NAME **NED CLYDE GW MONITORING** NO. **8910023B**

BORING LOCATION MW-5 <small>South Side of Property</small>		ELEVATION AND DATUM N/A	
DRILLING AGENCY ENSCO	DRILLER G. Nunes	DATE STARTED May 11, 1989	
DRILLING EQUIPMENT Mobile B-53		COMPLETION DEPTH 20'	SAMPLER 2.5" Modified California Type
DRILLING METHOD 8" Hollow-stem Auger	DRILL BIT 8" Auger	NO. OF SAMPLES DIST. N/A	UNDIST. N/A
SIZE AND TYPE OF CASING 2" Schedule 40 PVC		WATER LEVEL FIRST N/A	COMPL. N/A 24 HRS. N/A
TYPE OF PERFORATION .010" Slotted	FROM 8.0 TO 18.0 FL.	LOGGED BY: S. Clarke	
SIZE AND TYPE OF PACK #1/20 Lonestar Monterey Sand	FROM 7.0 TO 18.0 FL.		
TYPE OF SEAL	FROM 5.0 TO 7.0 FL.		
	NO. 1 Bentonite Pellets	FROM 0.4 TO 5.0 FL.	CHECKED BY:
	NO. 2 Concrete/Bentonite Grout		

DEPTH (feet)	DESCRIPTION	GRAPHIC LOG		Water Content	Piezometer Data	SAMPLES				REMARKS (Drill Rate, Fluid Loss, Odor, etc.)
		Lithology	Piezometer Installation			Drive Number	Sample Number	Recov. (Feet)	Blow Counts	
0 - 1	1' Gravel Base									
1 - 5	Silty Clay (CH) Moist, dark gray									
5 - 10	Silty Clay (CL) Moist, light brown Becoming brown with medium sand									
10 - 15	Silty Fine Sand (SM) Medium dense, moist					1			2 10 25	
15 - 20	Silty Gravelly Sand (SM) Gravel to 3/4" Less gravel									
20 - 20'	Augered to 20'									

Piezometer Legend

- Slotted Well Screen
- Sand Pack
- Bentonite Pellets
- Cement/ Bentonite Grout

Woodward-Clyde Consultants





PROJECT NAME NED CLYDE GW MONITORING NO. 8910023B 01-033

Add Inv 15/4W27H9

BORING LOCATION MW-6 SE Corner of Property		ELEVATION AND DATUM N/A	
DRILLING AGENCY ENSCO	DRILLER G. Nunes	DATE STARTED DATE FINISHED May 11, 1989	
DRILLING EQUIPMENT Mobile B-53		COMPLETION DEPTH 18'	SAMPLER 2.5" Modified California Type
DRILLING METHOD 8" Hollow-stem Auger	DRILL BIT 8" Auger	NO. OF SAMPLES DIST. 1	UNDIST. N/A
SIZE AND TYPE OF CASING 2" Schedule 40 PVC		WATER LEVEL FIRST 11'	COMPL. N/A 24 HRS. N/A
TYPE OF PERFORATION .010" Slotted		FROM 8.0 TO 18.0 FL.	LOGGED BY: S. Clarke
SIZE AND TYPE OF PACK #1/20 Lonestar Monterey Sand		FROM 7.0 TO 18.0 FL.	
TYPE OF SEAL	NO. 1 Bentonite Pellets	FROM 5.0 TO 7.0 FL.	
	NO. 2 Concrete/Bentonite Grout	FROM 0.4 TO 5.0 FL.	CHECKED BY:

DEPTH (feet)	DESCRIPTION	GRAPHIC LOG		Water Content	Piezometer Data	SAMPLES				REMARKS (Drill Rate, Fluid Loss, Odor, etc.)	
		Lithology	Piezometer Installation			Drive Number	Sample Number	Recov. (Feet)	Blow Counts		
0 - 5	Silty Clay (CH) Moist, dark gray										
5 - 7	Silty Clay (CL) Gray-brown, moist										
7 - 10	Sandy Silty Clay (CL) Light brown, fine sand										
10 - 12	Sandy Silt (ML) Light brown, fine sand					1			8 10 15		
12 - 18	Gravel layer										
18 - 20	Augered to 18'										

Piezometer Legend

-  Slotted Well Screen
-  Sand Pack
-  Bentonite Pellets
-  Cement/Bentonite Grout



01-547R-T

MW-4 01504W 27602
MW-5 01-894 G03
MW-6 G04

ALAMEDA COUNTY FLOOD CONTROL AND WATER CONSERVATION DISTRICT
5987 PARKSIDE DRIVE * PLEASANTON, CALIFORNIA 94588 * (415) 494-2600

GROUNDWATER PROTECTION ORDINANCE PERMIT APPLICATION

FOR APPLICANT TO COMPLETE

FOR OFFICE USE

LOCATION OF PROJECT Pacific Cryogenics ←
2311 Magnolia Street
Oakland, CA 94607

PERMIT NUMBER 92607
LOCATION NUMBER _____

CLIENT
Name Aldo Guidotti / Estate of Jean Josephine
Address Bates Blvd #300 Phone _____
City Orinda Zip 94536

PERMIT CONDITIONS

Circled Permit Requirements Apply

APPLICANT
Name Hageman-Agular, Inc.
3732 MC Diablo Blvd
Address Suite 372 Phone (510) 284-1661
City Lafayette Zip 94549

- (A) GENERAL
 1. A permit application should be submitted so as arrive at the Zone 7 office five days prior proposed starting date.
 2. Submit to Zone 7 within 60 days after completion of permitted work the original Department Water Resources Water Well Drillers Report equivalent for well projects, or drilling log and location sketch for geotechnical projects.
 3. Permit is void if project not begun within days of approval date.
- (B) WATER WELLS, INCLUDING PIEZOMETERS
 1. Minimum surface seal thickness is two inches cement grout placed by tremie.
 2. Minimum seal depth is 50 feet for municipal or industrial wells or 20 feet for domestic or irrigation wells unless a lesser depth specially approved. Minimum seal depth for monitoring wells is the maximum depth practical or 20 feet.
- (C) GEOTECHNICAL. Backfill bore hole with compacted cuttings or heavy bentonite and upper two feet with compacted material. In areas of known or suspected contamination, tremied cement grout shall be used place of compacted cuttings.
- (D) CATHODIC. Fill hole above anode zone with concrete placed by tremie.
- (E) WELL DESTRUCTION. See attached.

TYPE OF PROJECT
 All Construction
 Cathodic Protection
 Water Supply
 Monitoring
 Geotechnical Investigation
 General
 Contamination
 Well Destruction

PROPOSED WATER SUPPLY WELL USE
 Domestic
 Municipal
 Industrial
 Irrigation
 Other _____

DRAINING METHOD: excavation backfill wells
 Air Rotary
 Air Rotary
 Auger
 Other X

DRILLER'S LICENSE NO. NONE (excavation backfill wells) bb

ALL PROJECTS
Drill Hole Diameter _____ in. Maximum
Casing Diameter 4 in. Depth 15 ft.
Surface Seal Depth 3 ft. Number 3

GEOTECHNICAL PROJECTS
Number of Borings _____ Maximum
Hole Diameter _____ in. Depth _____ ft.

ESTIMATED STARTING DATE 11/19/92
ESTIMATED COMPLETION DATE 11/19/92

I hereby agree to comply with all requirements of this District and Alameda County Ordinance No. 73-68.

APPLICANT'S SIGNATURE Hary Aguiar Date 11/18/92


Approved Wymarr Hong Date 19 Nov 92
Wymarr Hong

121989

bb


SCALE 1:24,000

01-5472-T

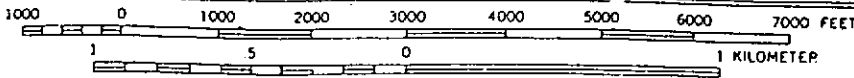

CONTOUR INTERVAL 20 FEET
DOTTED LINES REPRESENT 5-FOOT CONTOURS
NATIONAL GEODETIC VERTICAL DATUM OF 1929

15/4W 2762-4

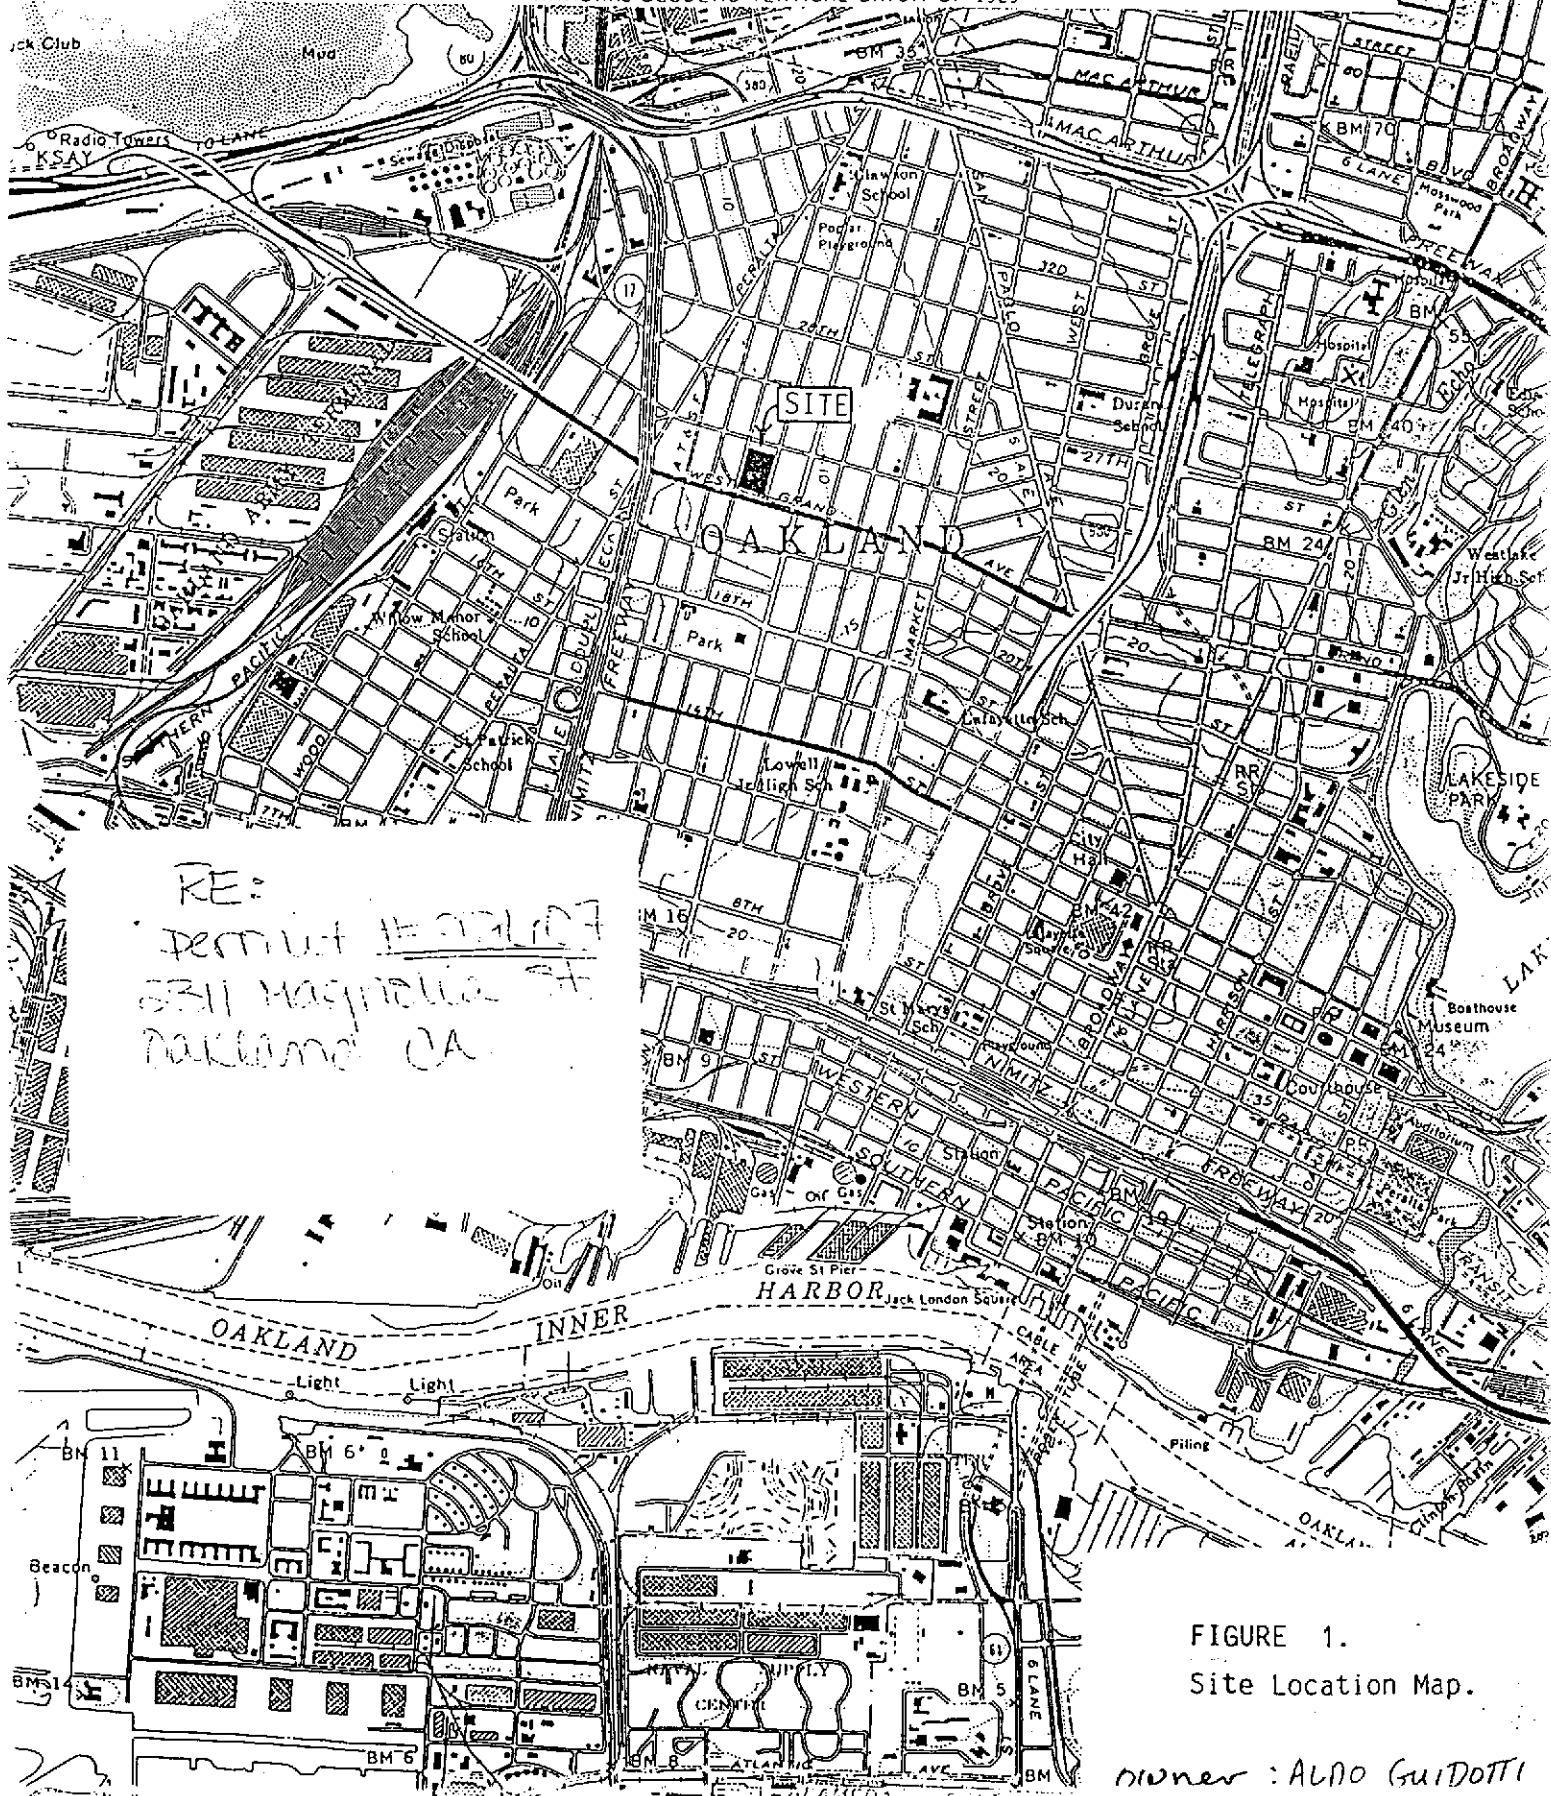

RE:
Permit # 071127
5311 Magnolia St
Oakland CA

FIGURE 1.
Site Location Map.

owner: ALDO GUIDOTTI



385

01-547 R-T


15/4W-2762-4

UNION STREET


MAGNOLIA STREET

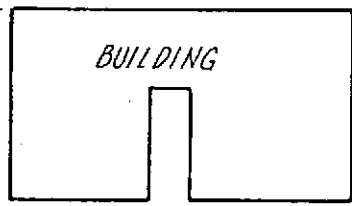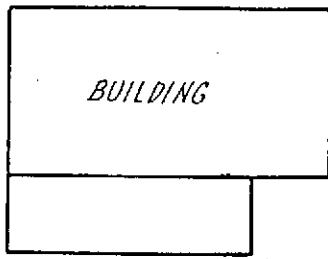


← PREVIOUS
8,000-GAL DIESEL TANK

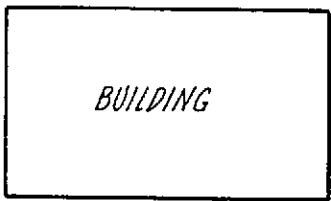

MW-3

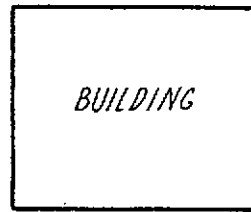

PREVIOUS
1,000-GAL
GASOLINE TANK

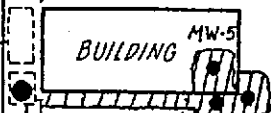

MW-5

MW-1


MW-6

MW-4


EXCAVATION

PREVIOUS
550-GAL
WASTE OIL TANK

MW-2

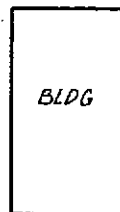

BUILDING

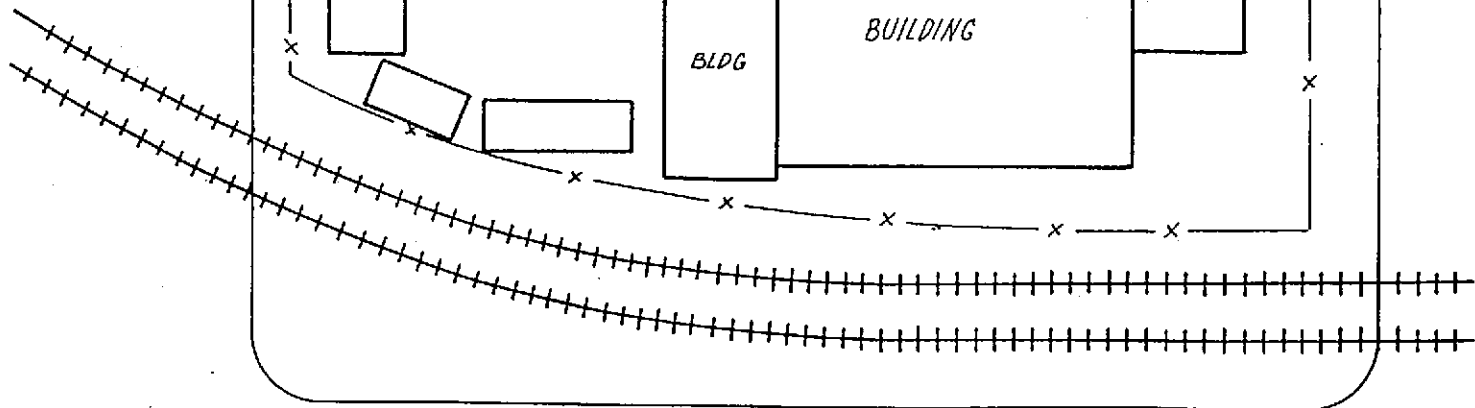

WEST GRAND AVENUE

MW-3


485

01-547 R-T


15/4W-2762-4

Locations of Backfill Wells
MW-4, MW-5 and MW-6

2311 Magnolia Street
Oakland, CA

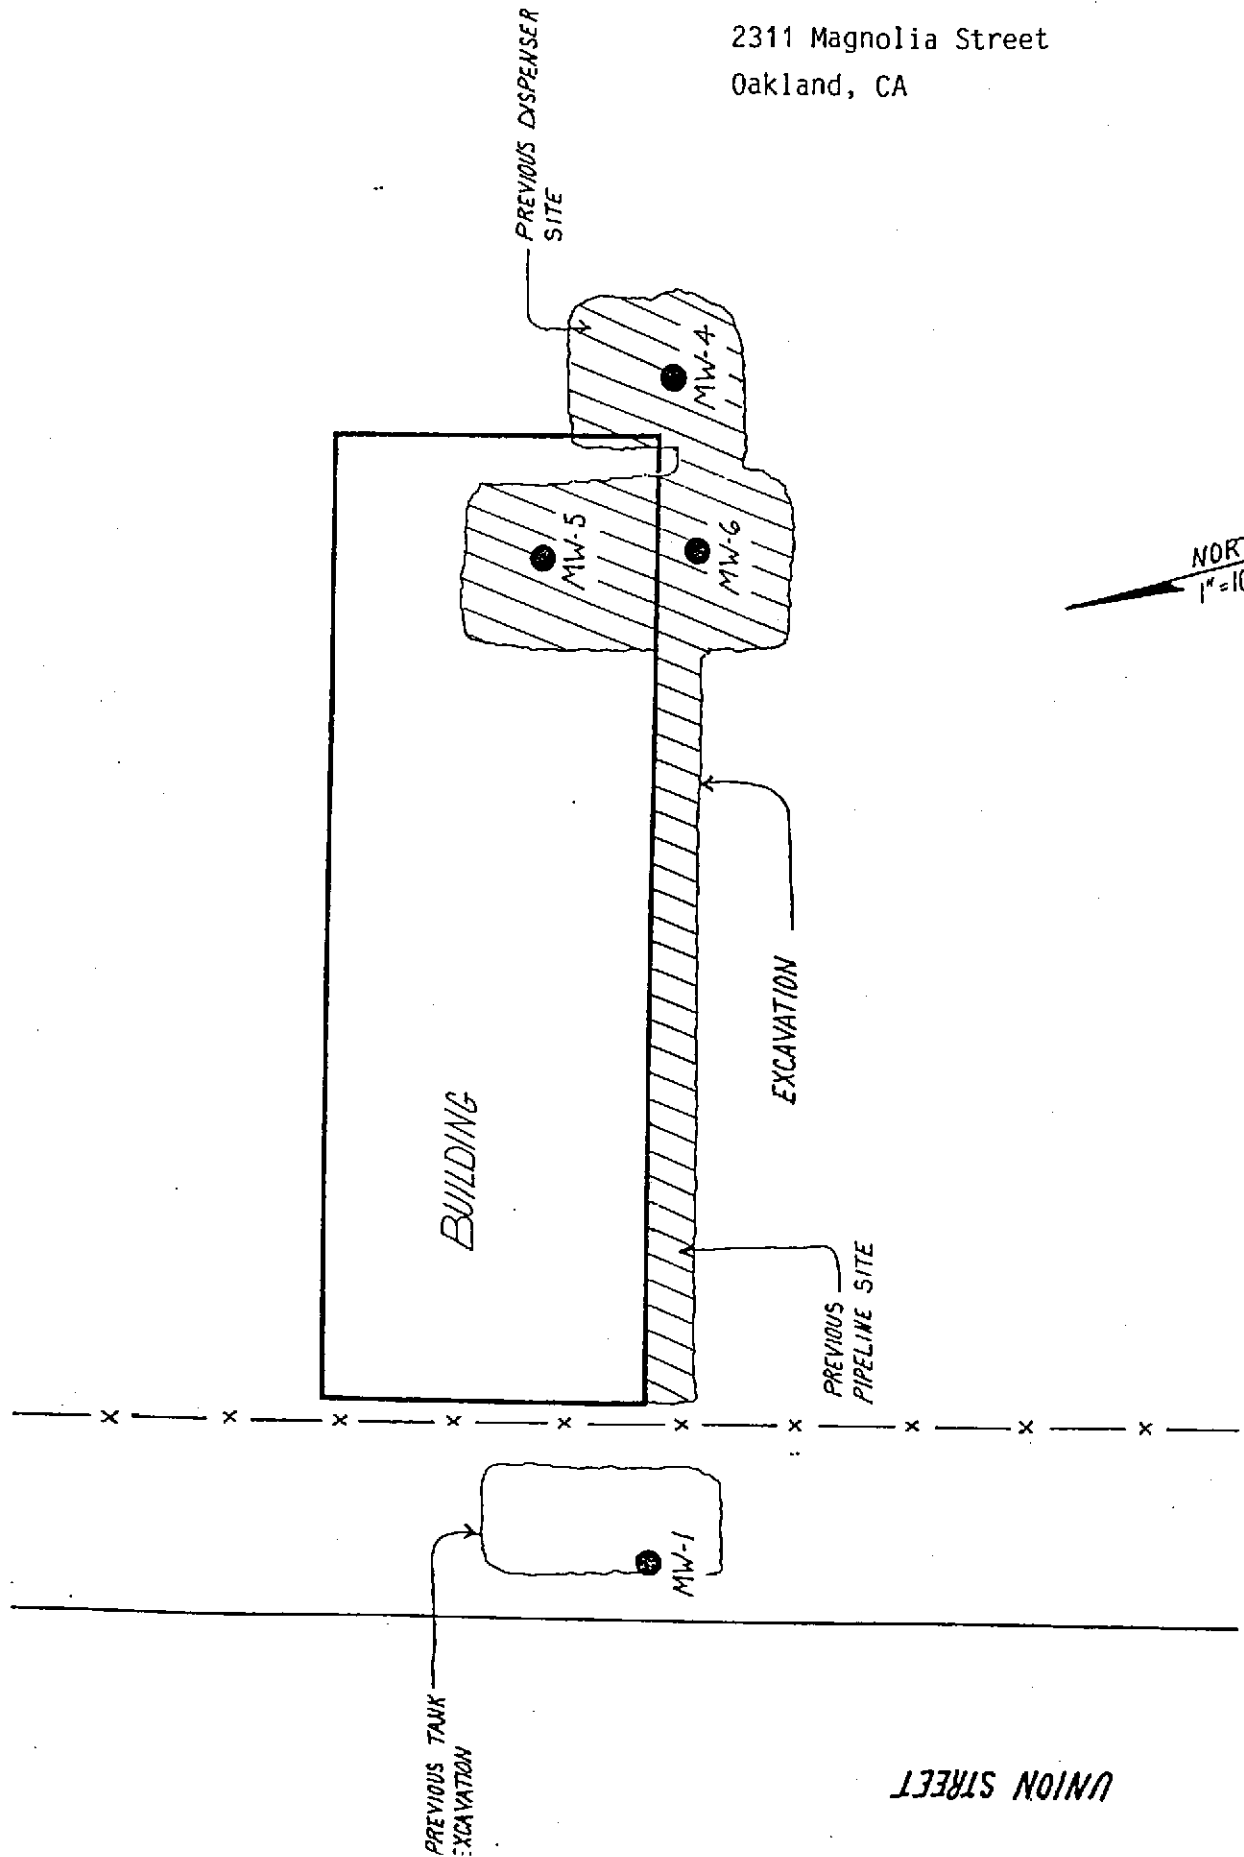

UNION STREET

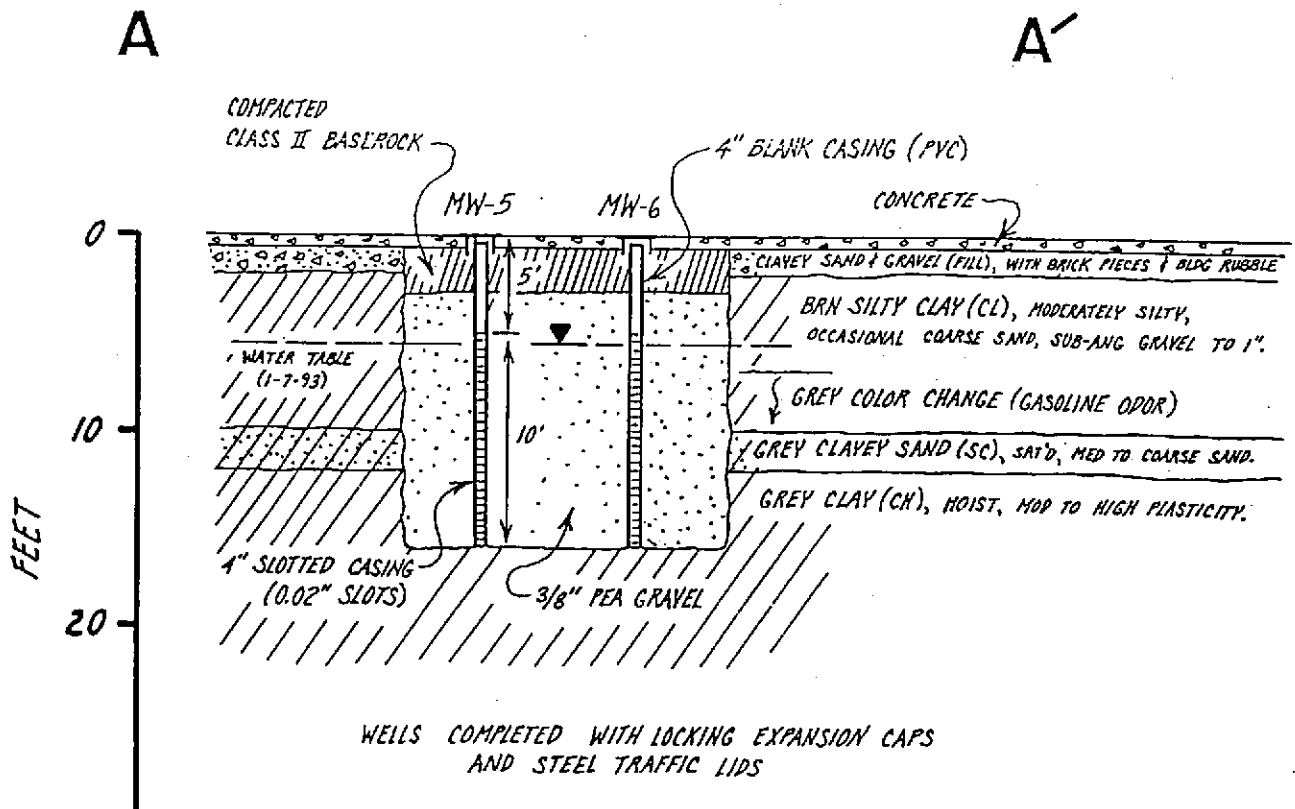

SCALE


HORIZ: 1"=10'
VERT: 1"=10'

2311 Magnolia Street
Oakland, California

MW-4, MW-5, MW-6 all have similar data

were excavations - backfilled

Client **Guidott** Date **9.27.90**

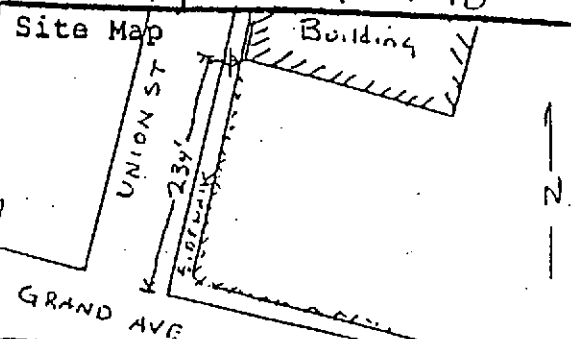Location **2210 Union St** Site Map 

Oakland Ca.

Driller **Aqua Science #487000**

Method **8" Hollow Stem Auger Mobile Drill B5**

Sampler **Cal. F. 2" 140# w/ 30" Fall**

Logger **B. Halsted** Inspector

Sample Number	Depth	Blows/ft	Moisture	Hydracell	Depth	USCS	Description of Subsurface Materials	Completion Data
					0		Concrete	
					5		Backfill; Import soil	PORTLAND CEMENT SANITARY SEAL
					6.5		--- BAY MUD No Odor	2" PVC BURN TRIM
					6.5		WATER LEVEL	3 1/2 BENTONITE
58-1	8 1/2 - 10			MAST DOWN DROVE SAMPLER	10	OH	BAY MUD No Odor	#3 AMIC LONG STAR LAPIS LUSTRE SAND PILL
					15	OH		TRINOC 2" 1070 SLURRY PVC 15'
58-2	13 1/2 - 15			DRILLED W/ HAMMER				
					20	GL	GRAVEL/SAND/MUD	5" PVC LAP
58-3	19 1/2 - 21			TRAIL LING, SAMPLER W/			BOH @ 21'	Bentolite
				HEAD ELECTRIC LINE, SAMPLER W/				
				LOW OVER. HEAD ELECTRIC LINE, SAMPLER W/				
				UNABLE TO DRIVE				
				DUE TO				


Total Depth **19.5'** Water Level **6.5'** Sanitary Seal **3.5'**

Permit **90577** Agency **Alameda Co. Flood Control** WATER CONSERVATION DIST

2046 7

1514W 27G1

01-471Z

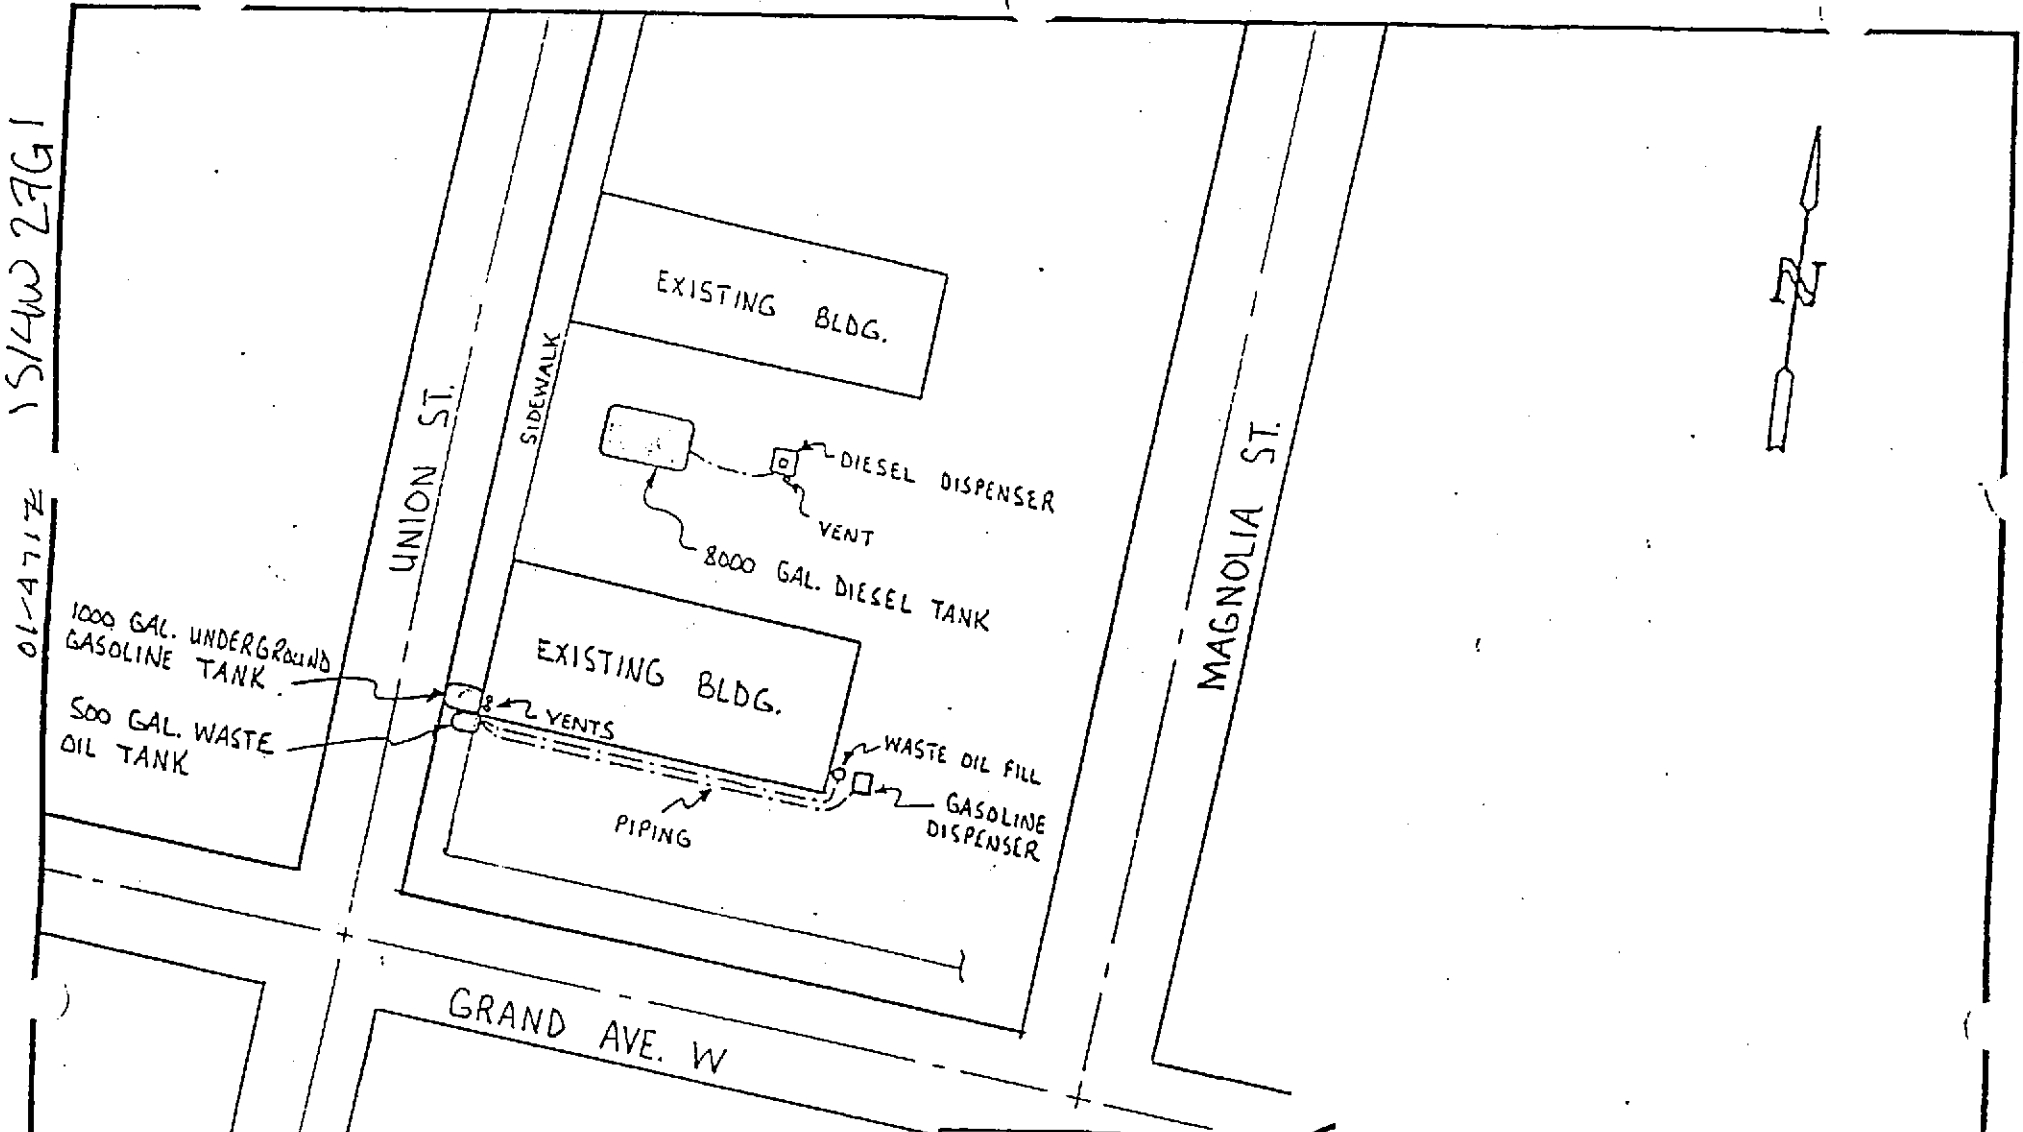

Geo-Environmental
Technology

SCALE: NONE
DATE: 14 JUNE 89

PLOT PLAN FOR:
ALDO GUIDOTTI

DRAWN BY *JM*
REVISED

2311 MAGNOLIA ST.
OAKLAND, CA 94607

260 Cristich Lane
Campbell, CA 95008 (408) 559-1220

PLATE 1

screened interval, and extended to approximately 1 foot above the screen. A bentonite and concrete seal was placed from the top of the sand pack to the ground surface. A locking cap and protective traffic-rated vault box was installed on the top of the well.

Potentially contaminated soil cuttings and samples not retained for chemical analysis were contained in secured 55 gallon storage on-site. The storage drums were properly sealed and labeled. All drilling and sampling equipment was steam-cleaned upon completion of well installation.

Groundwater Sampling Procedure

Groundwater sampling was performed by GET using techniques approved by the Environmental Protection Agency (EPA), and the California Regional Water Quality Control Board, (RWQCB). These techniques require that:

1. Wells will be developed until the water is free of fine-grained sediments and/or until field measurements of pH, electrical conductivity, and temperature stabilize. Approximately four to ten well volumes of water will be removed during development of the well.
2. Equipment inserted into the well during development will be decontaminated by washing or steam cleaning prior to and after its use.

GET's sampling procedure consisted of first measuring the water level in the well and then checking for the presence of floating petroleum product using a clear teflon bailer. Because no free product was detected, the well was purged of four casing volumes of water. In order to ensure that a representative sample was obtained, the pH, electrical conductivity and temperature were monitored and documented on a well sampling field sheet. (See Figure 4). Using a teflon bailer, two samples entitled 9070-1 and 9070-2 were collected on 10/26/90 at 1:30 pm. They had a pH of 7.4, an electrical conductivity of .01, and a temperature of 65 degrees. Samples were placed into appropriate EPA-approved containers, labeled, logged onto chain-of-custody documents, and transported to the laboratory. All sampling equipment was properly decontaminated with a trisodiumphosphate, (TSP), solution followed with a tap water rinse. A field blank sample (9070-2) was prepared for quality control purposes, prior to collection of groundwater samples. Potentially contaminated purge water and decontaminant rinsate was contained in secured 55-gallon storage drums on-site. The drums were properly sealed and labeled.

Site Description

A site map showing the current layout of the site is presented in Figure 2. This figure shows the locations of existing structures and the former underground storage tanks, as well as adjacent streets. Site sketch maps showing the sources of the samples are shown in figures 3 and 4

Well Installation

In order to determine if site operations have impacted groundwater, GET installed one groundwater monitoring well within the tank pit excavation area. The well is within five feet of the former waste oil storage tank location in the estimated downgradient direction. The well location is shown on Figure 2 entitled Site Map and Soil Sample Plot Plan and on Figure 3 entitled Boring Log MW-1.

The soils boring was drilled using an 8-inch diameter continuous-flight hollow-stem B-57 mobile drill augur. The boring was logged by a Professional Engineer using the Unified Soil Classification System and standard geologic techniques. (See Appendix A) Soil samples for logging and chemical analysis were collected at 9', 14', and 20' depths and were entitled SB-1, SB-2 and SB-3 respectively. These samples were collected by advancing a California-modified split-spoon sampler with brass liners into undisturbed soil beyond the tip of the auger. The sampler was driven 18 inches, using a 140-pound hammer with a 30" drop. Soil samples above groundwater were retained in brass liners, capped with aluminum foil and plastic end caps, and sealed in clean glass containers for possible chemical analysis. The samples were placed on ice and transported to the laboratory accompanied by the appropriate chain-of-custody documentation. All drilling and sampling equipment was thoroughly steam-cleaned prior to utilization.

The boring for the monitoring well (appendix A) penetrated 14.5 feet through the water bearing zone to a depth of 21 feet. Permeable sand and gravel was encountered at 19.5 feet. As a result, the boring was stopped and bentonite used to seal the well between 19.5 and 21 feet. The boring was then converted to a groundwater monitoring well with the installation of a 2-inch diameter, flush-threaded Schedule 40 PVC casing and 0.020-inch factory slotted Triloc screen. 13 feet of screen was placed through the entire saturated section extending to two feet above the static water level in order to account for fluctuations in groundwater elevation. A 2 X 12 graded #3 RMC Lone Star Lapis Lustre sand pack was placed in the annular space across the