




TDA

Thomas Dolan
Architecture
Architecture
Urban Design
Planning and
Development Consultation
tel. (510) 839 7200
fax. (510) 839 7208
tdarch@live-work.com
www.live-work.com




Alameda County
DEC 30 2002
Environmental Health

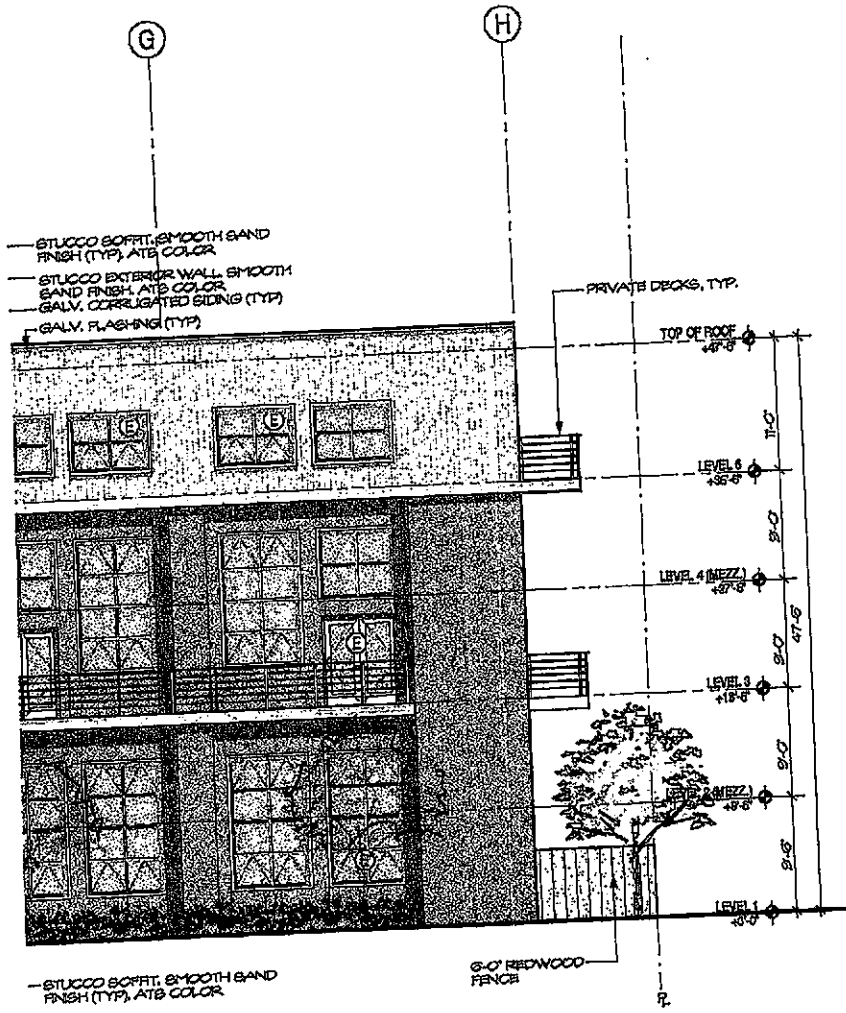


FOUNDRY
LOFTS
2868 HANNAH ST.
OAKLAND, CA

ISSUE	DESCRIPTION	DATE
	AS BUILT SET	04-01-01
	DESIGN REVIEW SET	06-05-01
	SCHEMATIC DESIGN SET	07-02-01

DATE: 07-02-01
JOB NO.: 01-115
DRAWN: CPC
SHEET NO.:

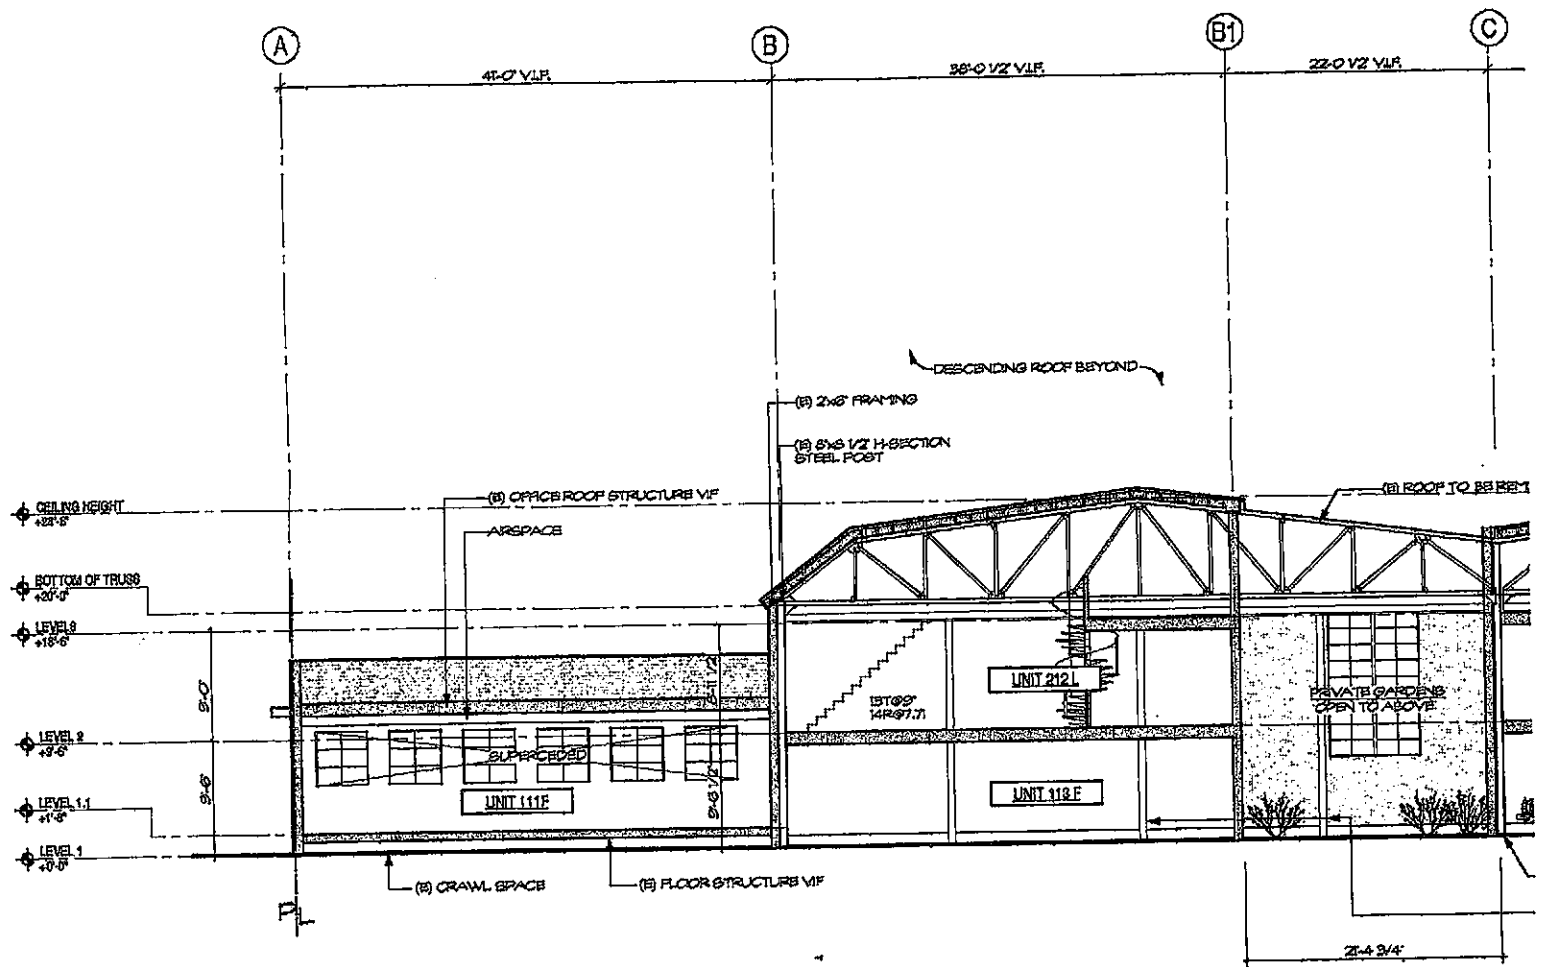

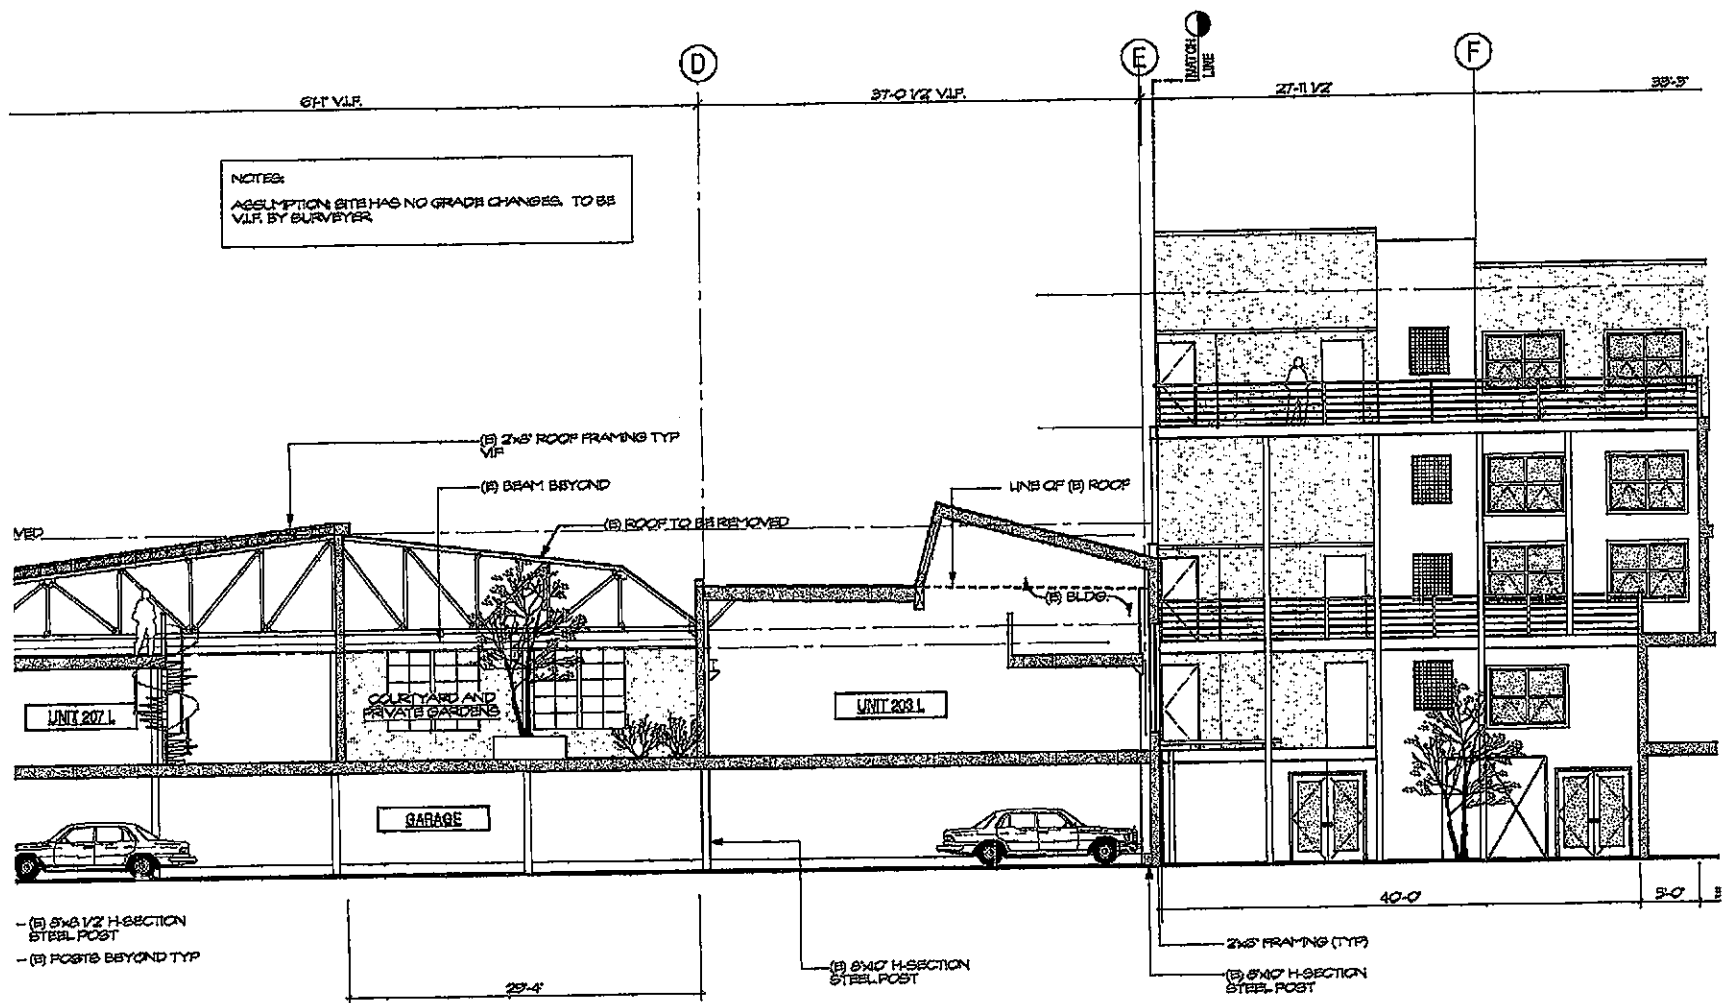




TDA

Thomas Dolan
Architecture

Architecture
Urban Design
Planning and
Development Consultation

tel. (510) 839 7200
fax. (510) 839 7208
tdarch@tde-work.com
www.tde-work.com

Richardson Witt
Robert Sreen
California

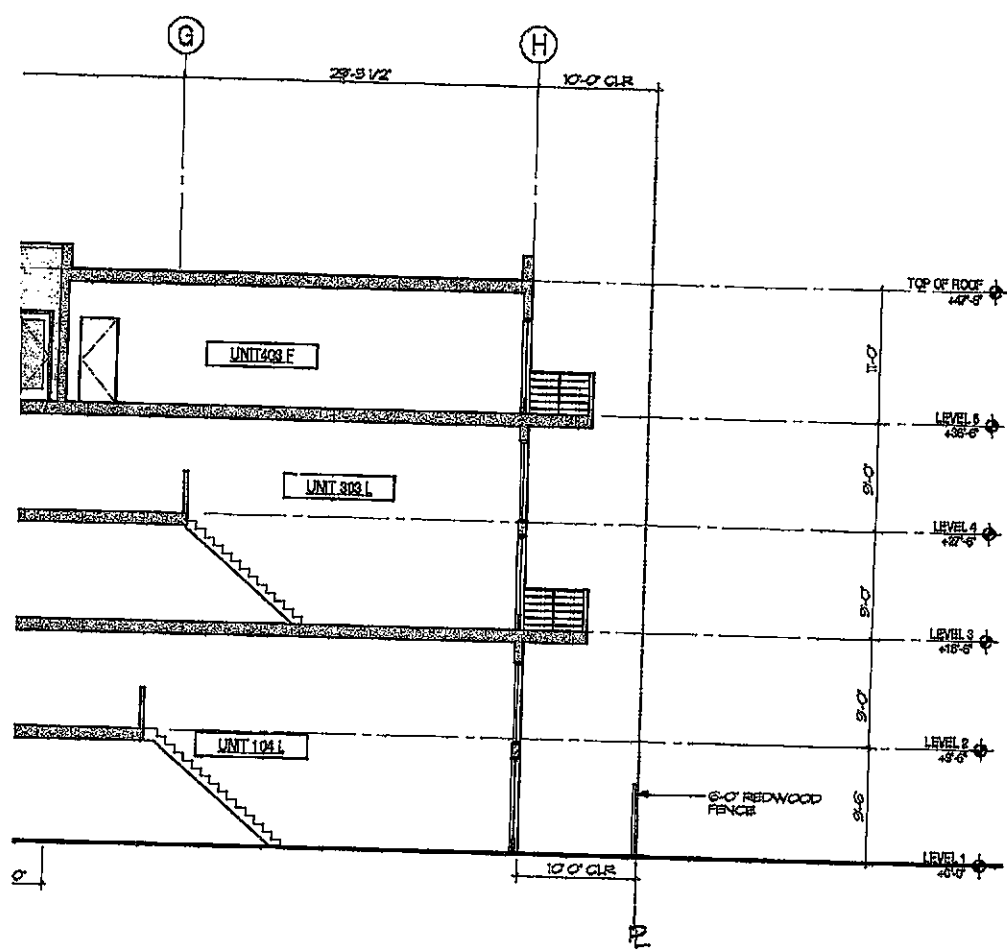


FOUNDRY LOFTS


2868 HANNAH ST.
OAKLAND, CA

ISSUE	DESCRIPTION	DATE
	AS BUILT SET	04-01-01
	DESIGN REVIEW SET	06-09-01
	SCHEMATIC DESIGN SET	07-02-01

DATE: 07-02-01
JOB NO.: 01.115
DRAWN: CPC

SHEET NO.

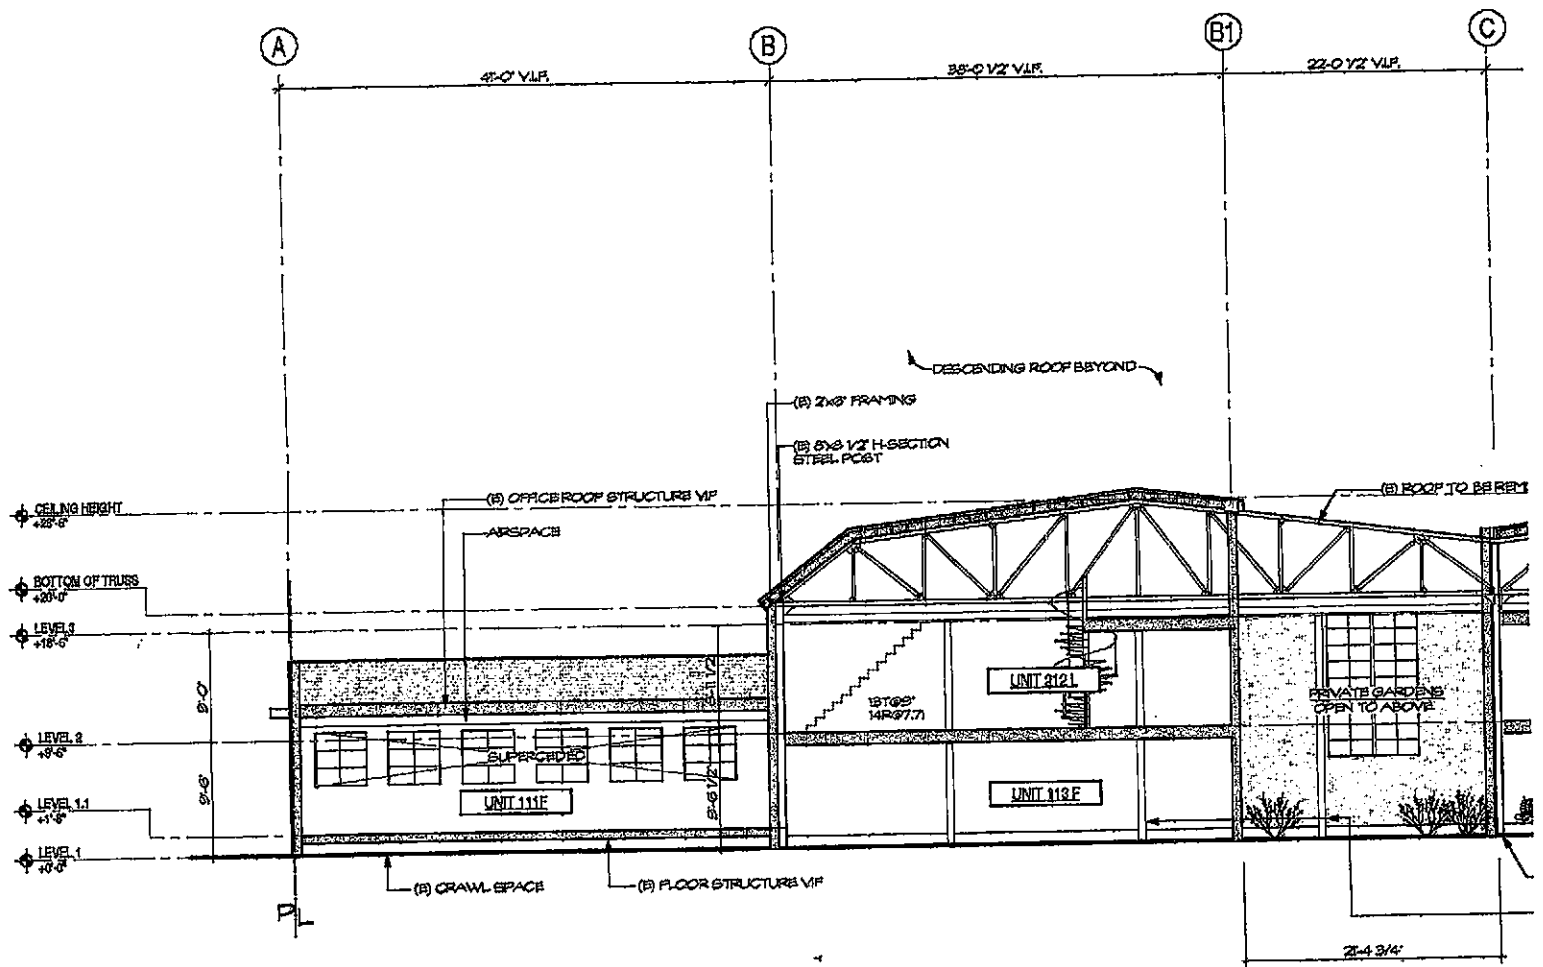

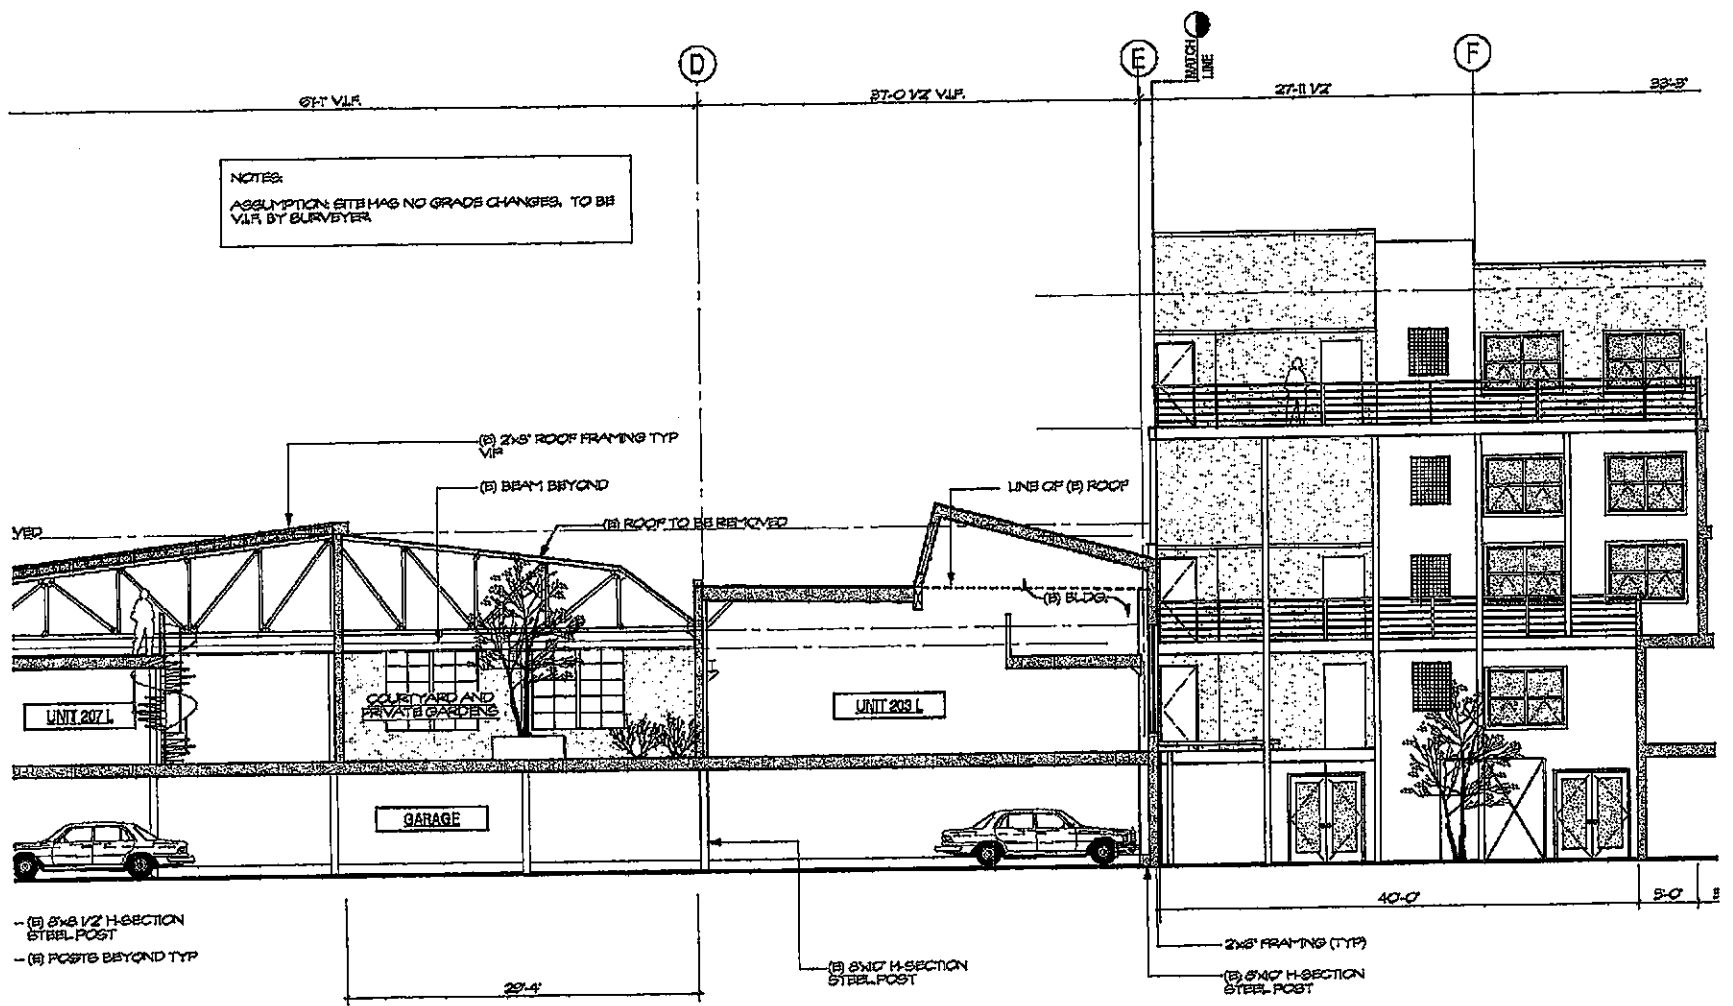




TDA

**Thomas Dolan
Architecture**

Architecture
Urban Design
Planning and
Development Consultation

tel. (510) 859 7200
fax. (510) 859 7208
tda.arch@lfrw-work.com
www.lfrw-work.com

Robert Schroeder West
Architectural Group
San Francisco, California

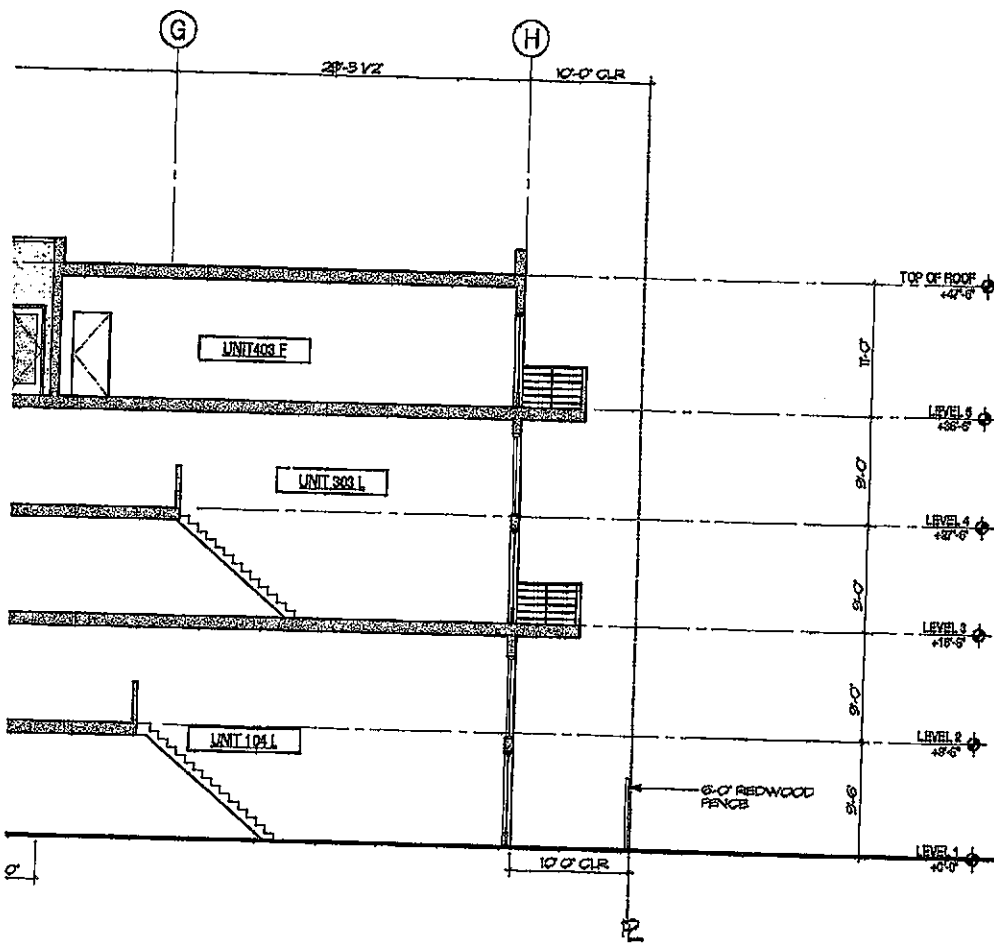

FOUNDRY LOFTS


2868 HANNAH ST.
OAKLAND, CA

ISSUE	DESCRIPTION	DATE
	AS BUILT SET	04-01-01
	DESIGN REVIEW SET	06-09-01
	SCHEMATIC DESIGN SET	07-02-01

DATE: 07-02-01
JOB NO.: 01.115
DRAWN: CPC


SHEET NO.

1
2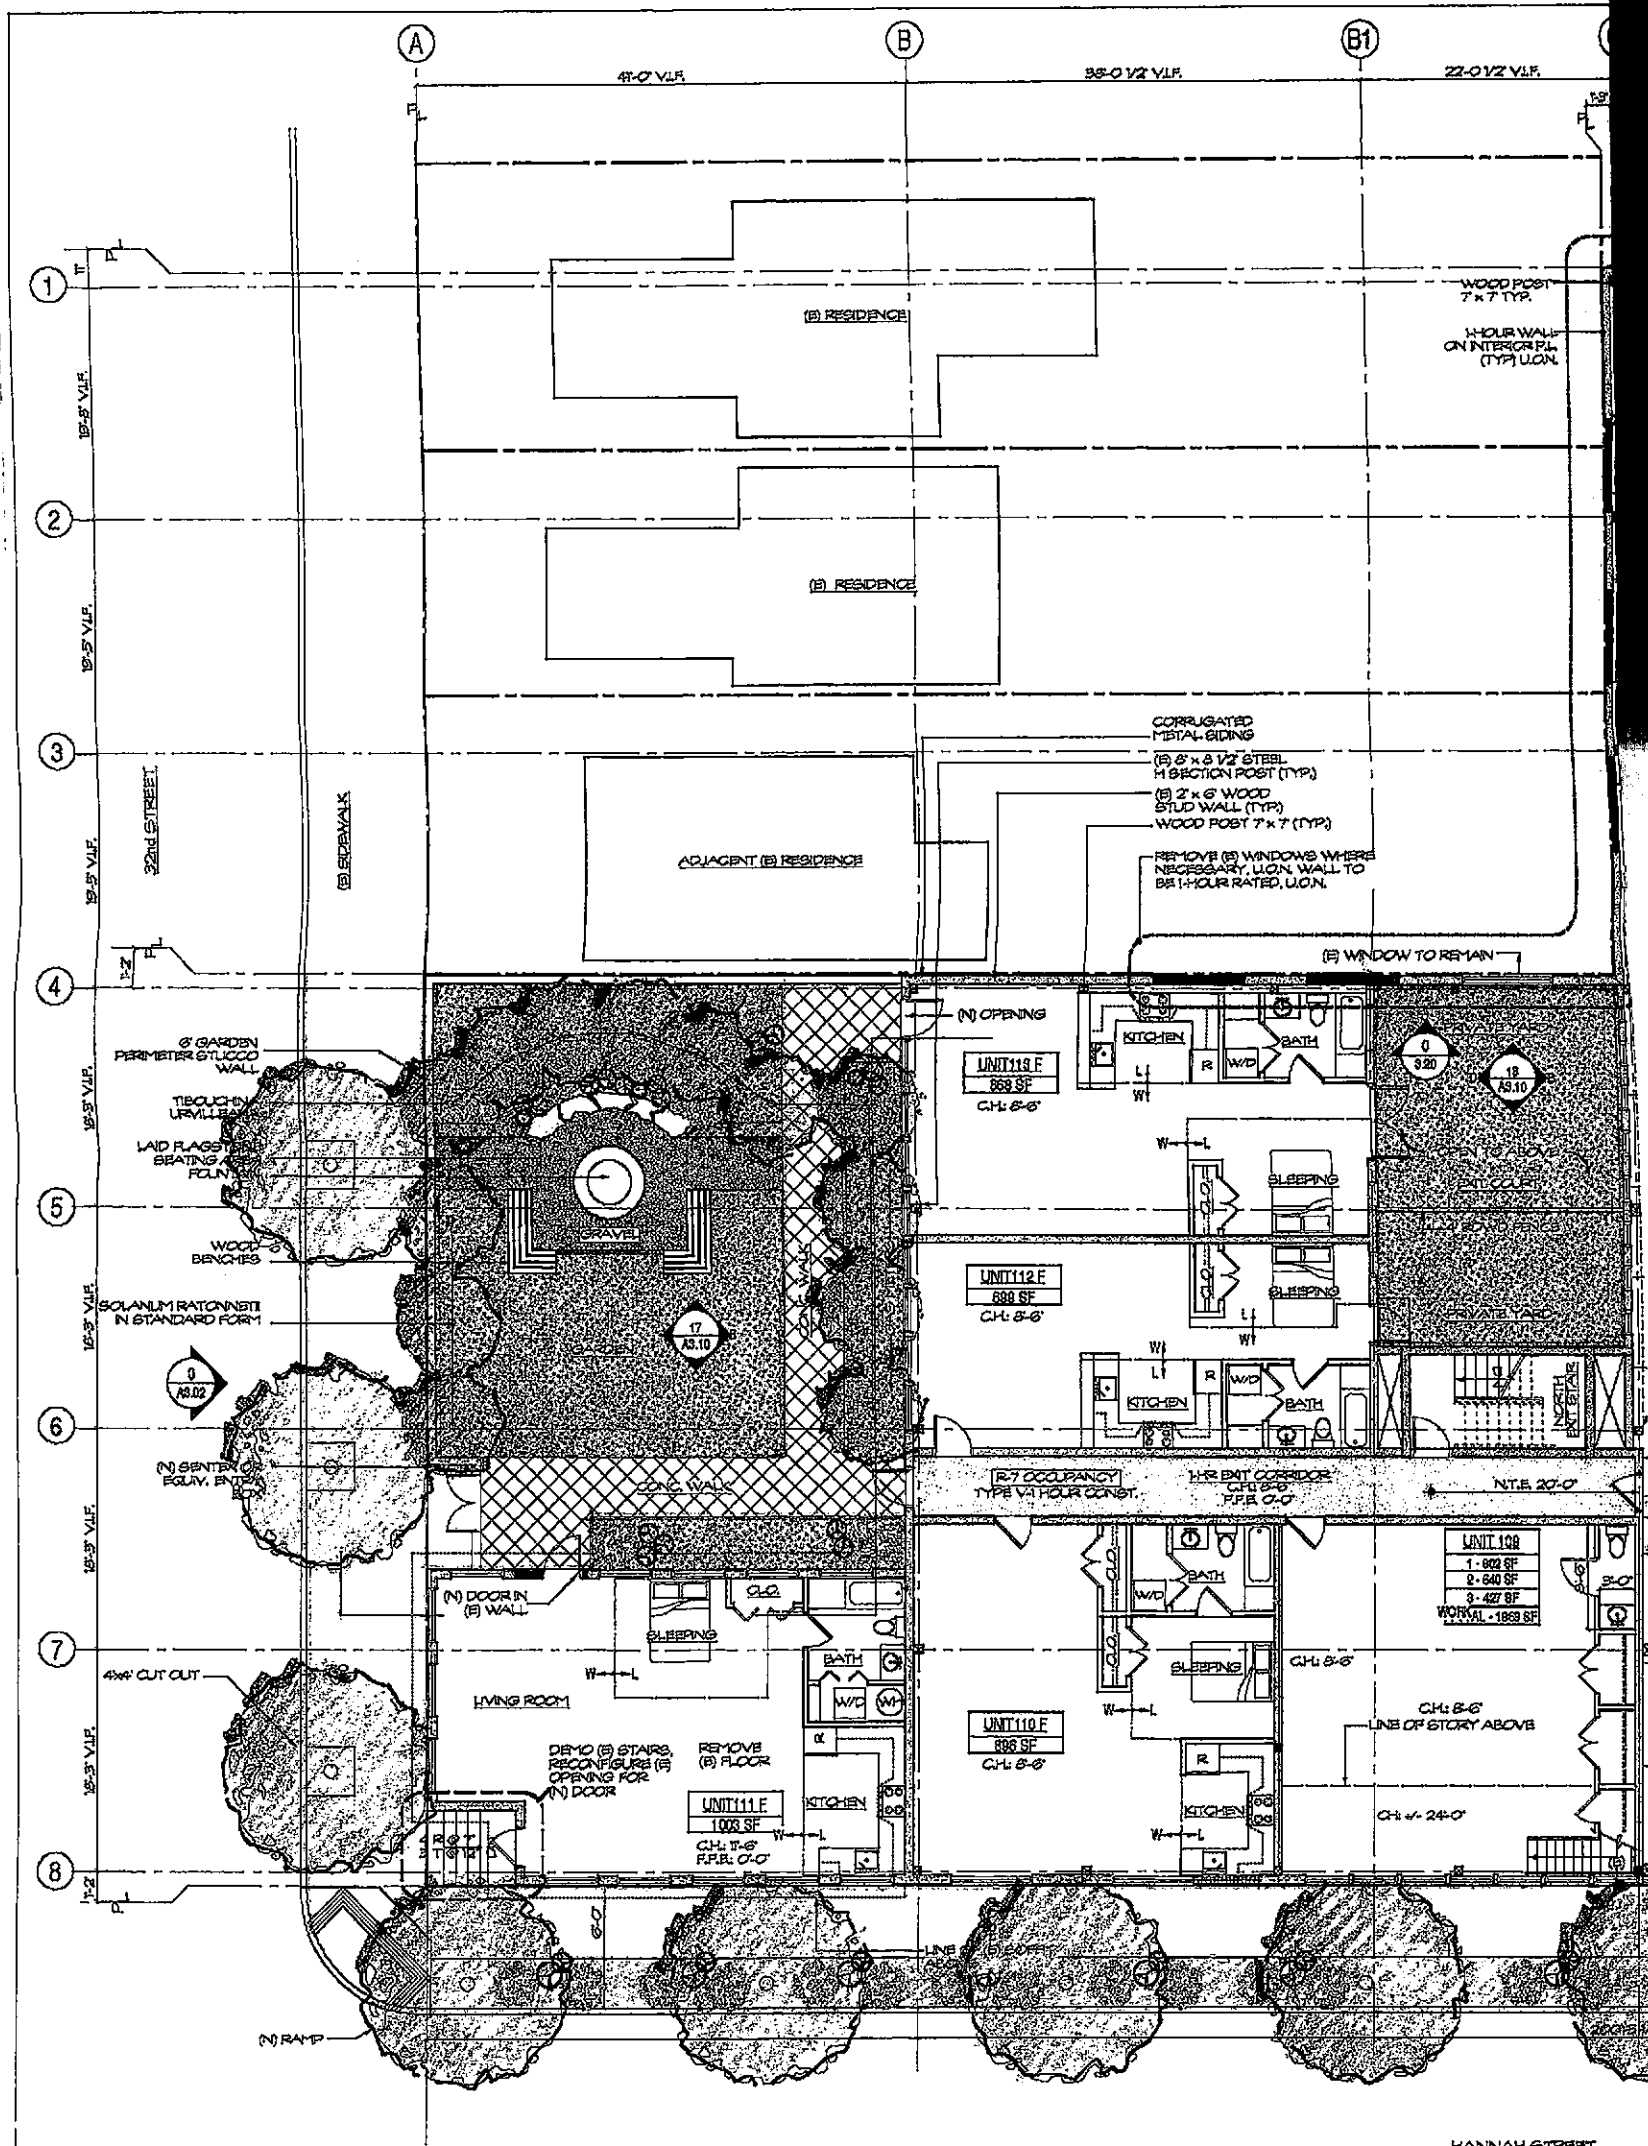
1 GROUND LEVEL PLAN
 1/8" = 1'-0"

HANNAH STREET

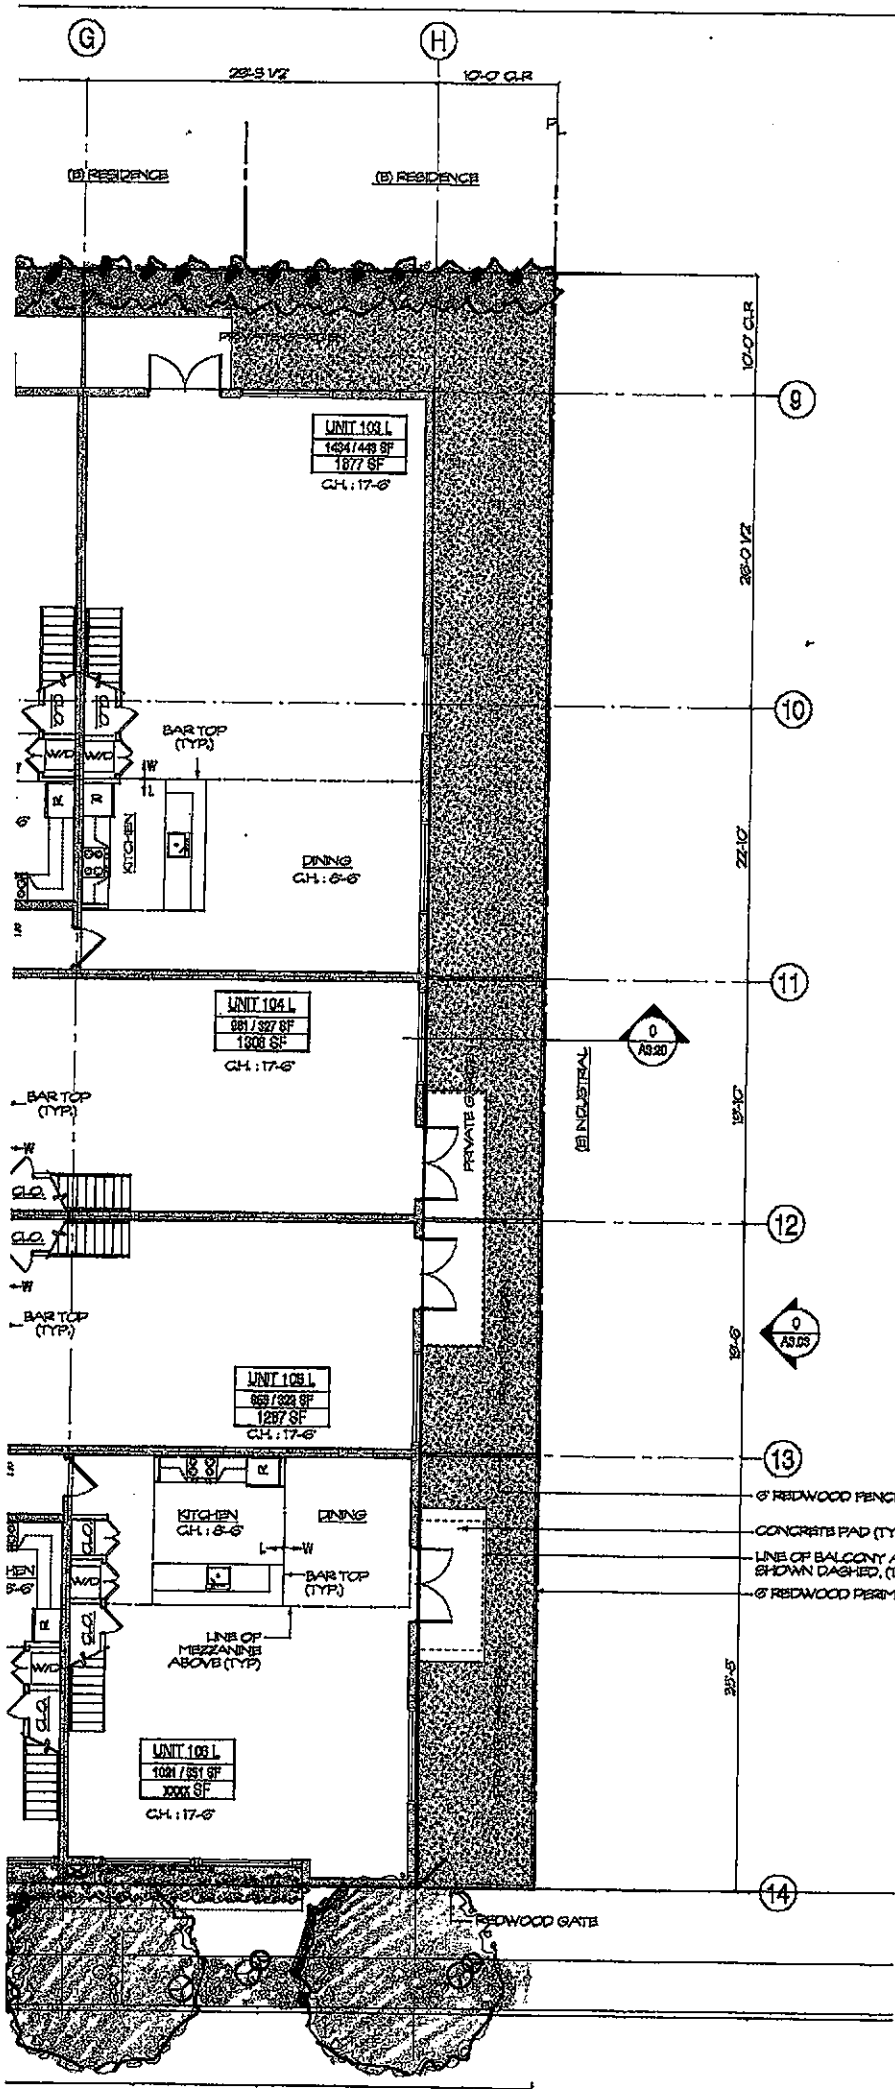

NOTES

1. WHERE BRICK MASONRY INFILL OCCURS, USE CLEANED BRICK MASONRY UNITS FROM ON-SITE DEMO WORK WHERE POSSIBLE, ALT; USE MATCHED BRICK MASONRY UNITS, A.T.S.
2. (B) ROOF AND (B) WOOD STUD PARAPET TO BE SURVEYED TO DETERMINE DIMENSIONS, STRUCTURAL AND WATERPROOFING INTEGRITY AND CONSTRUCTION METHODS.
3. (B) BRICK MASONRY PARAPET TO BE SURVEYED TO DETERMINE DIMENSIONS, STRUCTURAL AND WATERPROOFING INTEGRITY AND CONSTRUCTION METHODS.
4. (B) MODIFIED BOWSTRING TRUSSES TO BE SURVEYED TO DETERMINE DIMENSIONS.



Thomas Dolan Architecture
 Architecture
 Urban Design
 Planning and
 Development Consultation
 tel. (510) 639 7200
 fax. (510) 639 7208
 td.arch@live-work.com
 www.live-work.com
 Embarcadero West
 173 Filbert Street
 Oakland, California
 94607 U.S.A.



FOUNDRY LOFTS

2868 HANNAH ST.
 OAKLAND, CA

**1549 32nd STREET
 GROUND LEVEL
 PLAN**


LEGEND

- STRUCTURAL MEMBERS
- 1-HR WALL
- BRICK MASONRY WALL
- PRIVATE OPEN SPACE
- CIRCULATION


ISSUE	DESCRIPTION	DATE
	AS BUILT SET	04-01-01
	DESIGN REVIEW SET	05-02-01
	SCHEMATIC DESIGN SET	07-03-01

DATE 07-02-01
 JOB NO. 01.113
 DRAWN CPC

SHEET NO. **A2.11**

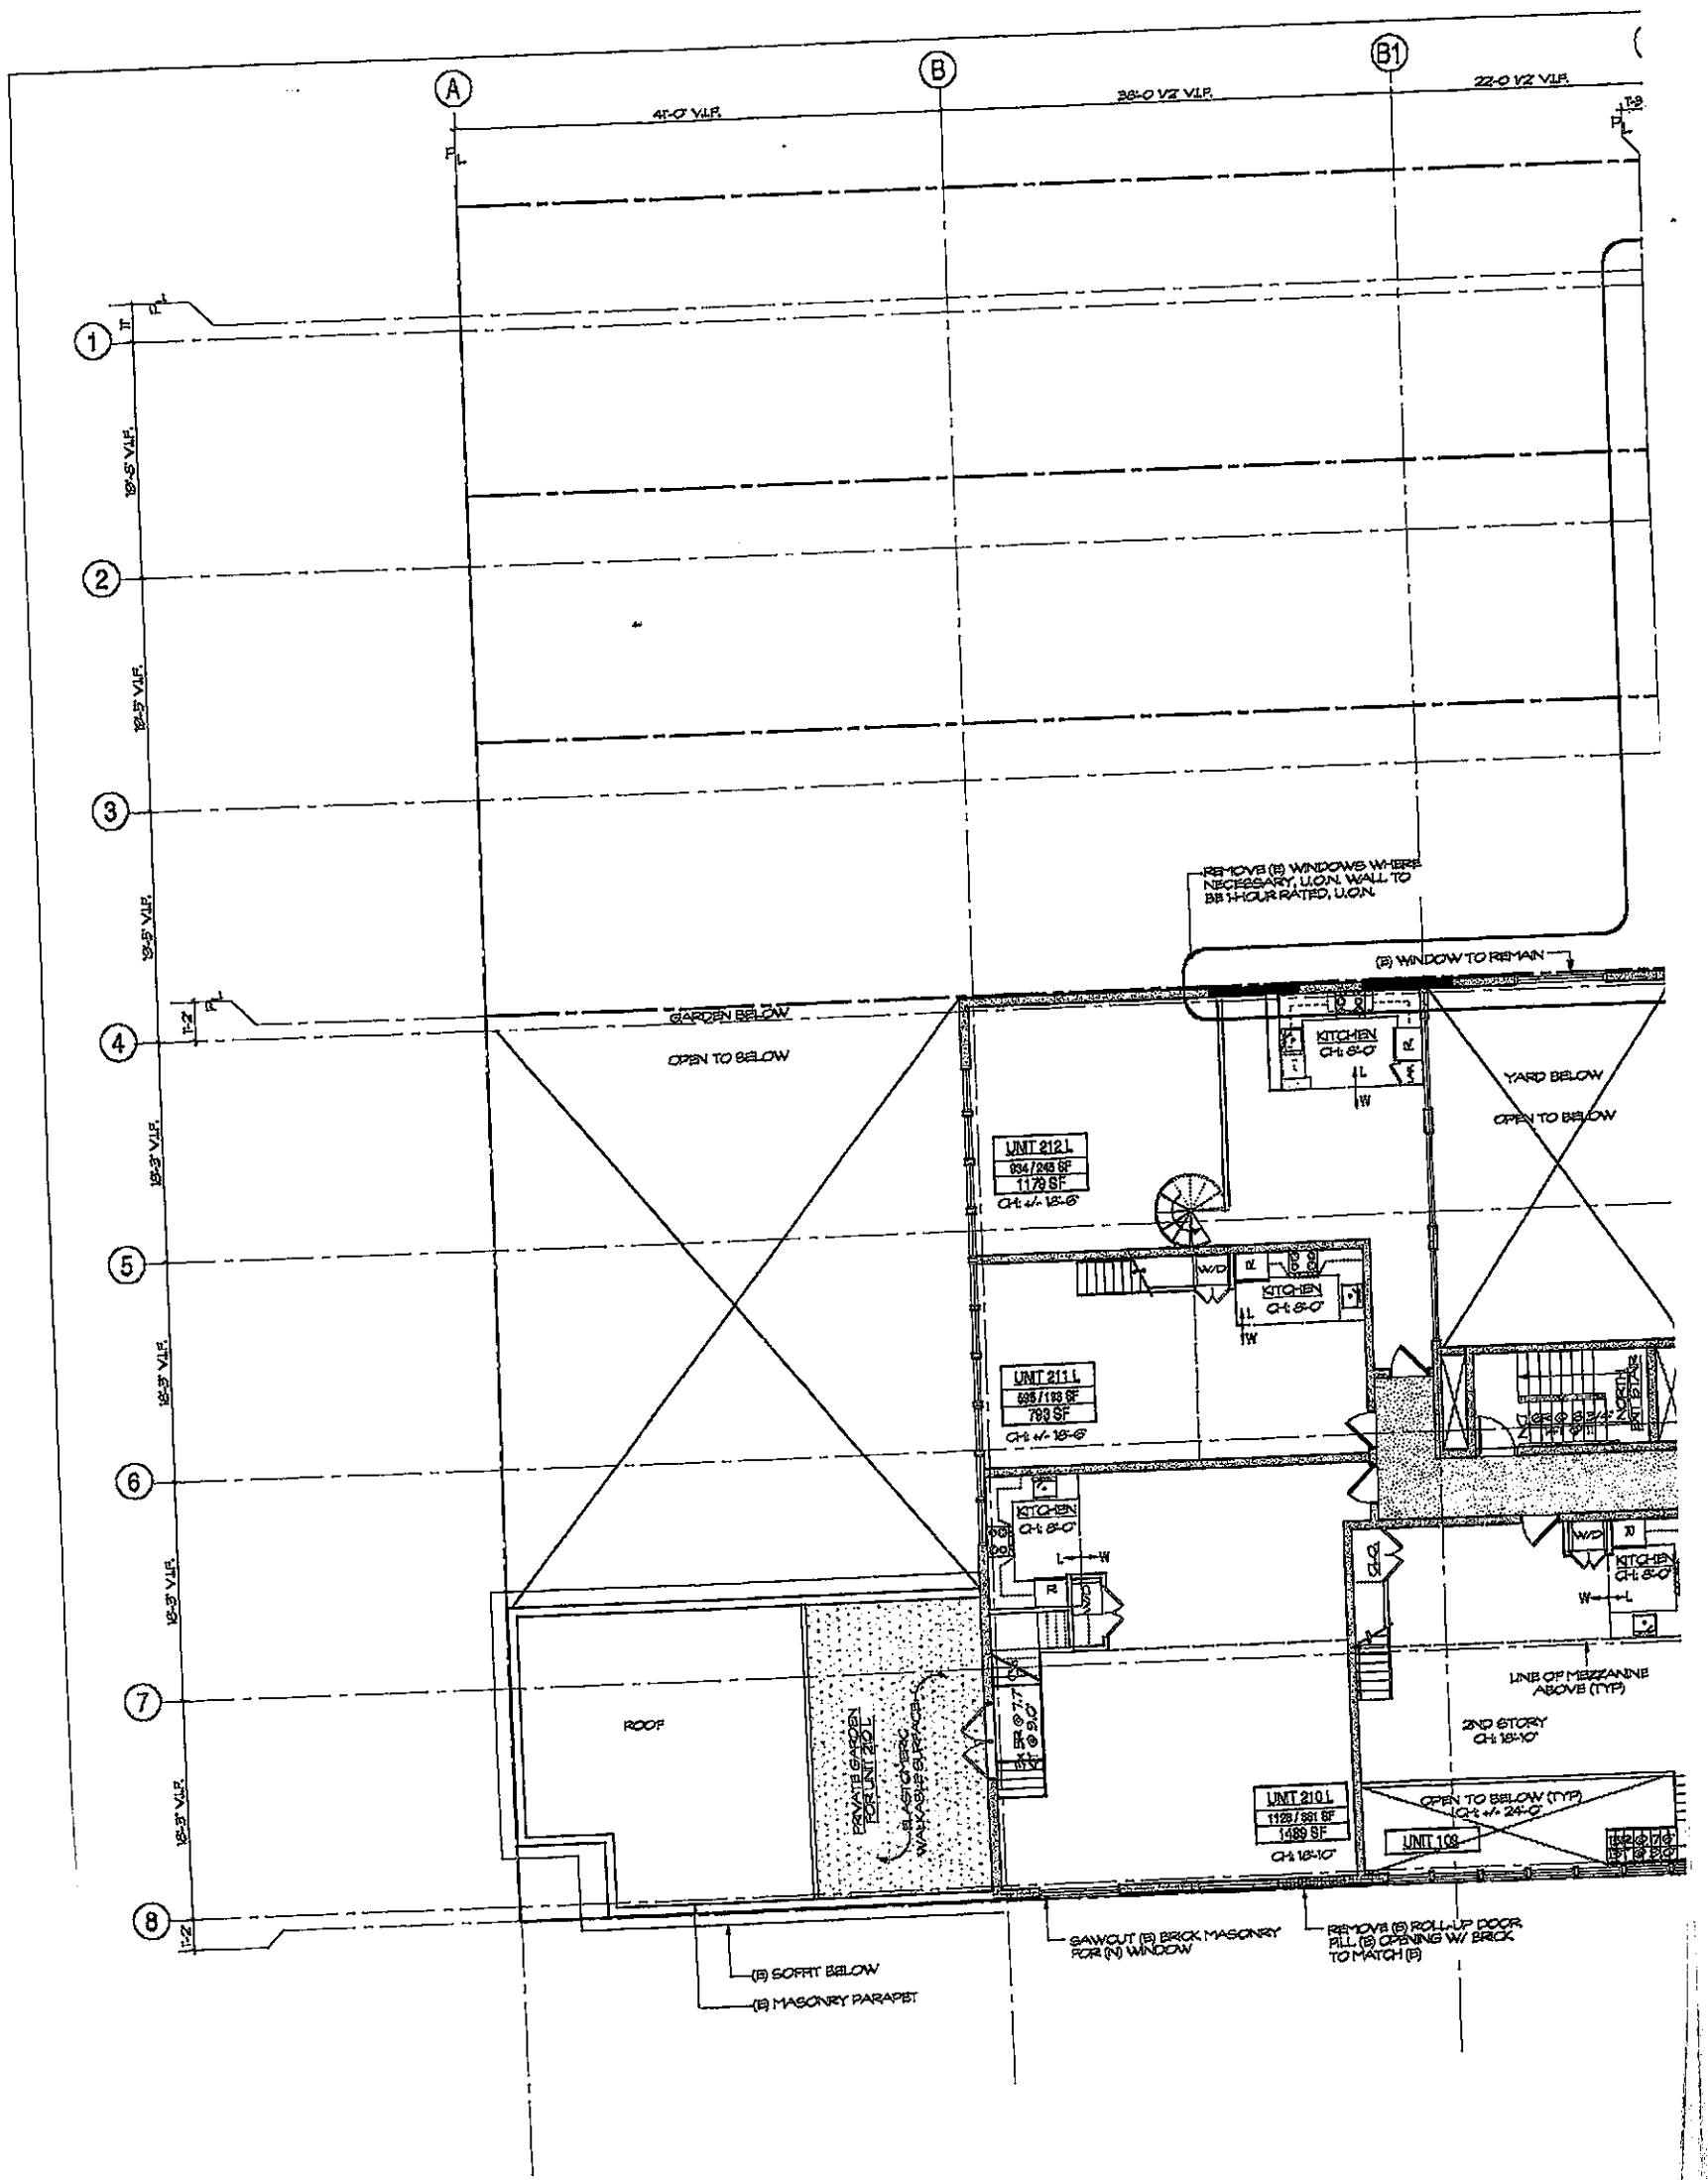

1 SECOND LEVEL PLAN
1/8" = 1'-0"

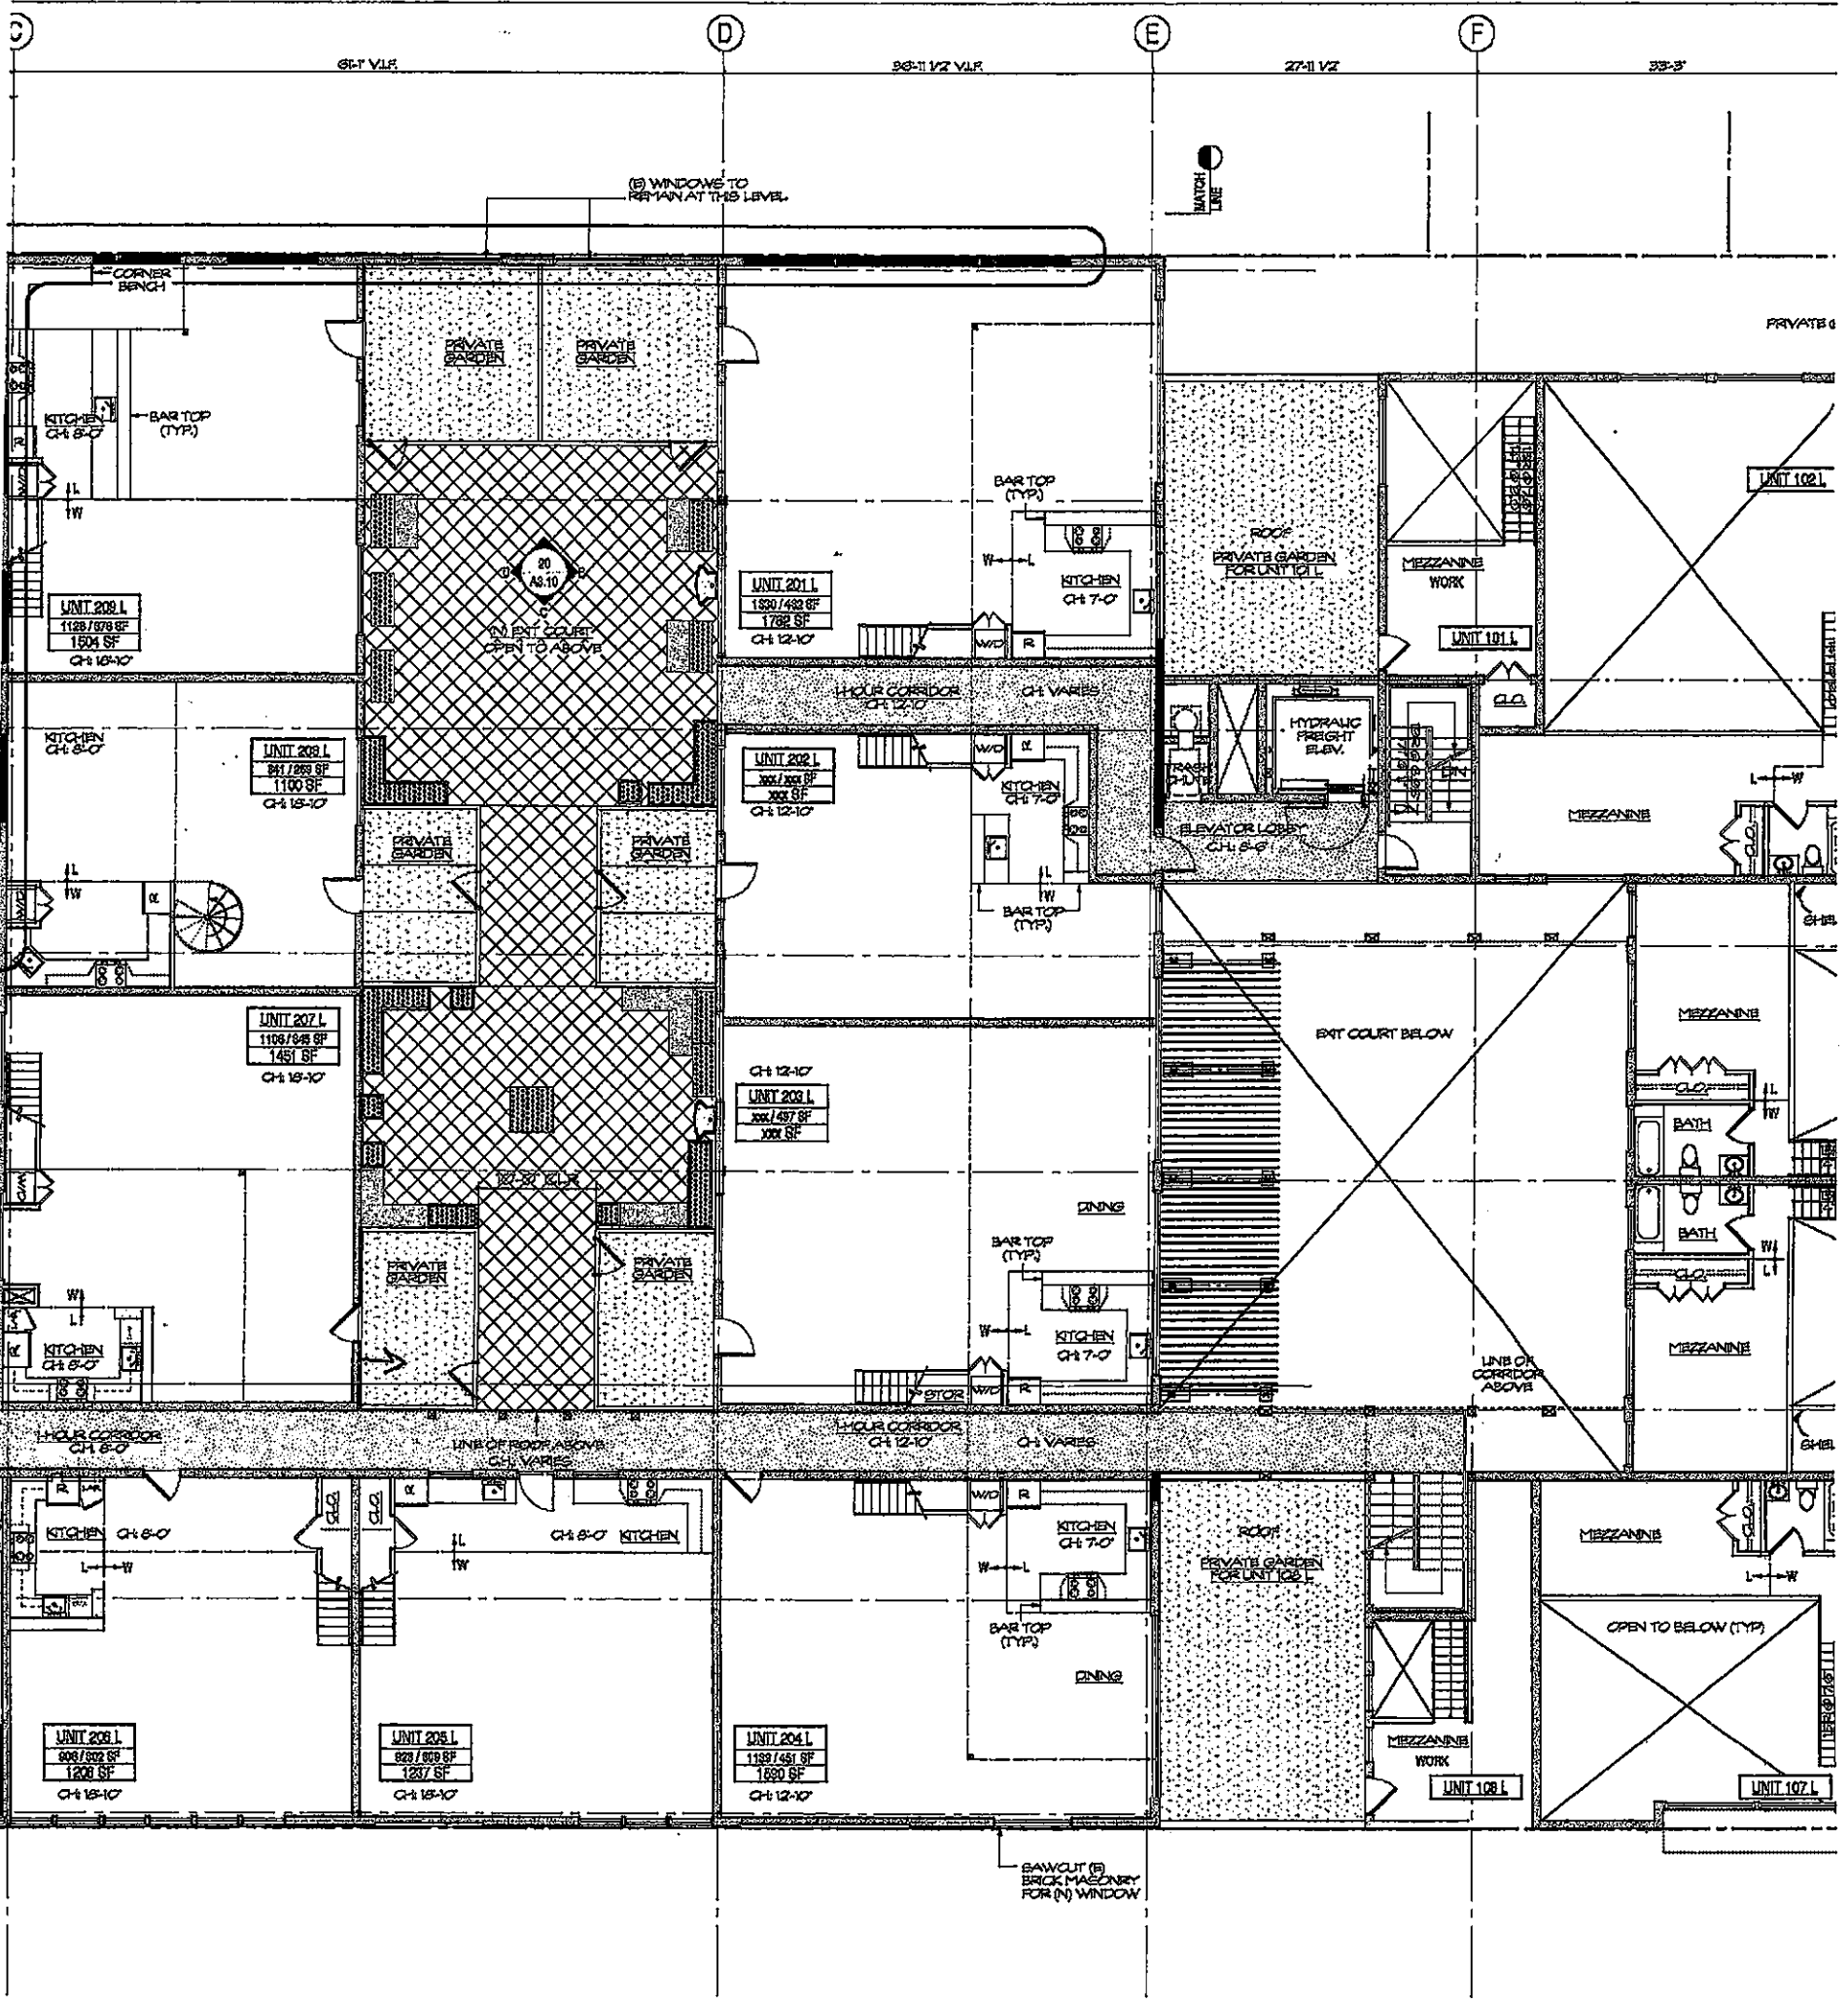



**Thomas Dolan
Architecture**
Architecture
Urban Design
Planning and
Development Consultation
tel. (510) 839 7200
fax. (510) 337 7233
td.arch@live-work.com
www.live-work.com
Embarcadero West
375 Filbert Street
Oakland, California
94607 U.S.A.



**FOUNDRY
LOFTS**


2868 HANNAH ST.
OAKLAND, CA


**2868 HANNAH ST.
SECOND LEVEL
PLAN**

ISSUE	DESCRIPTION	DATE
	AS BUILT SET	04-01-01
	DESIGN REVIEW SET	06-03-01
	SCHEMATIC DESIGN SET	07-22-01


DATE 07-02-01
JOB NO. 01.115
DRAWN CPC

SHEET NO. **A2.21**

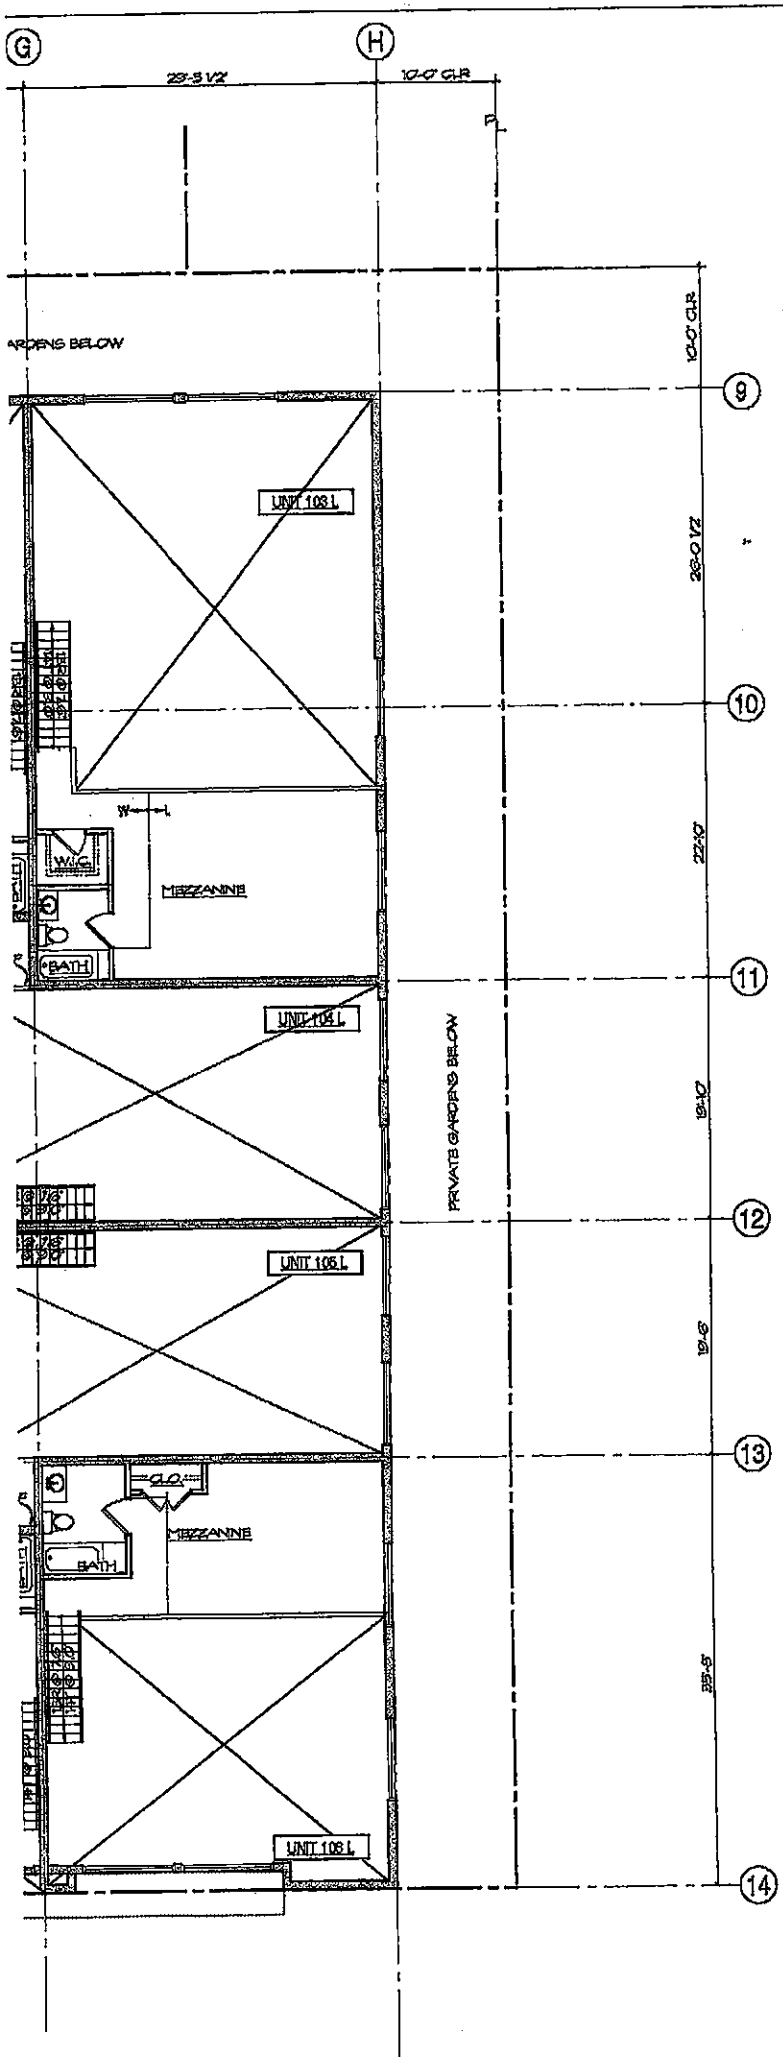

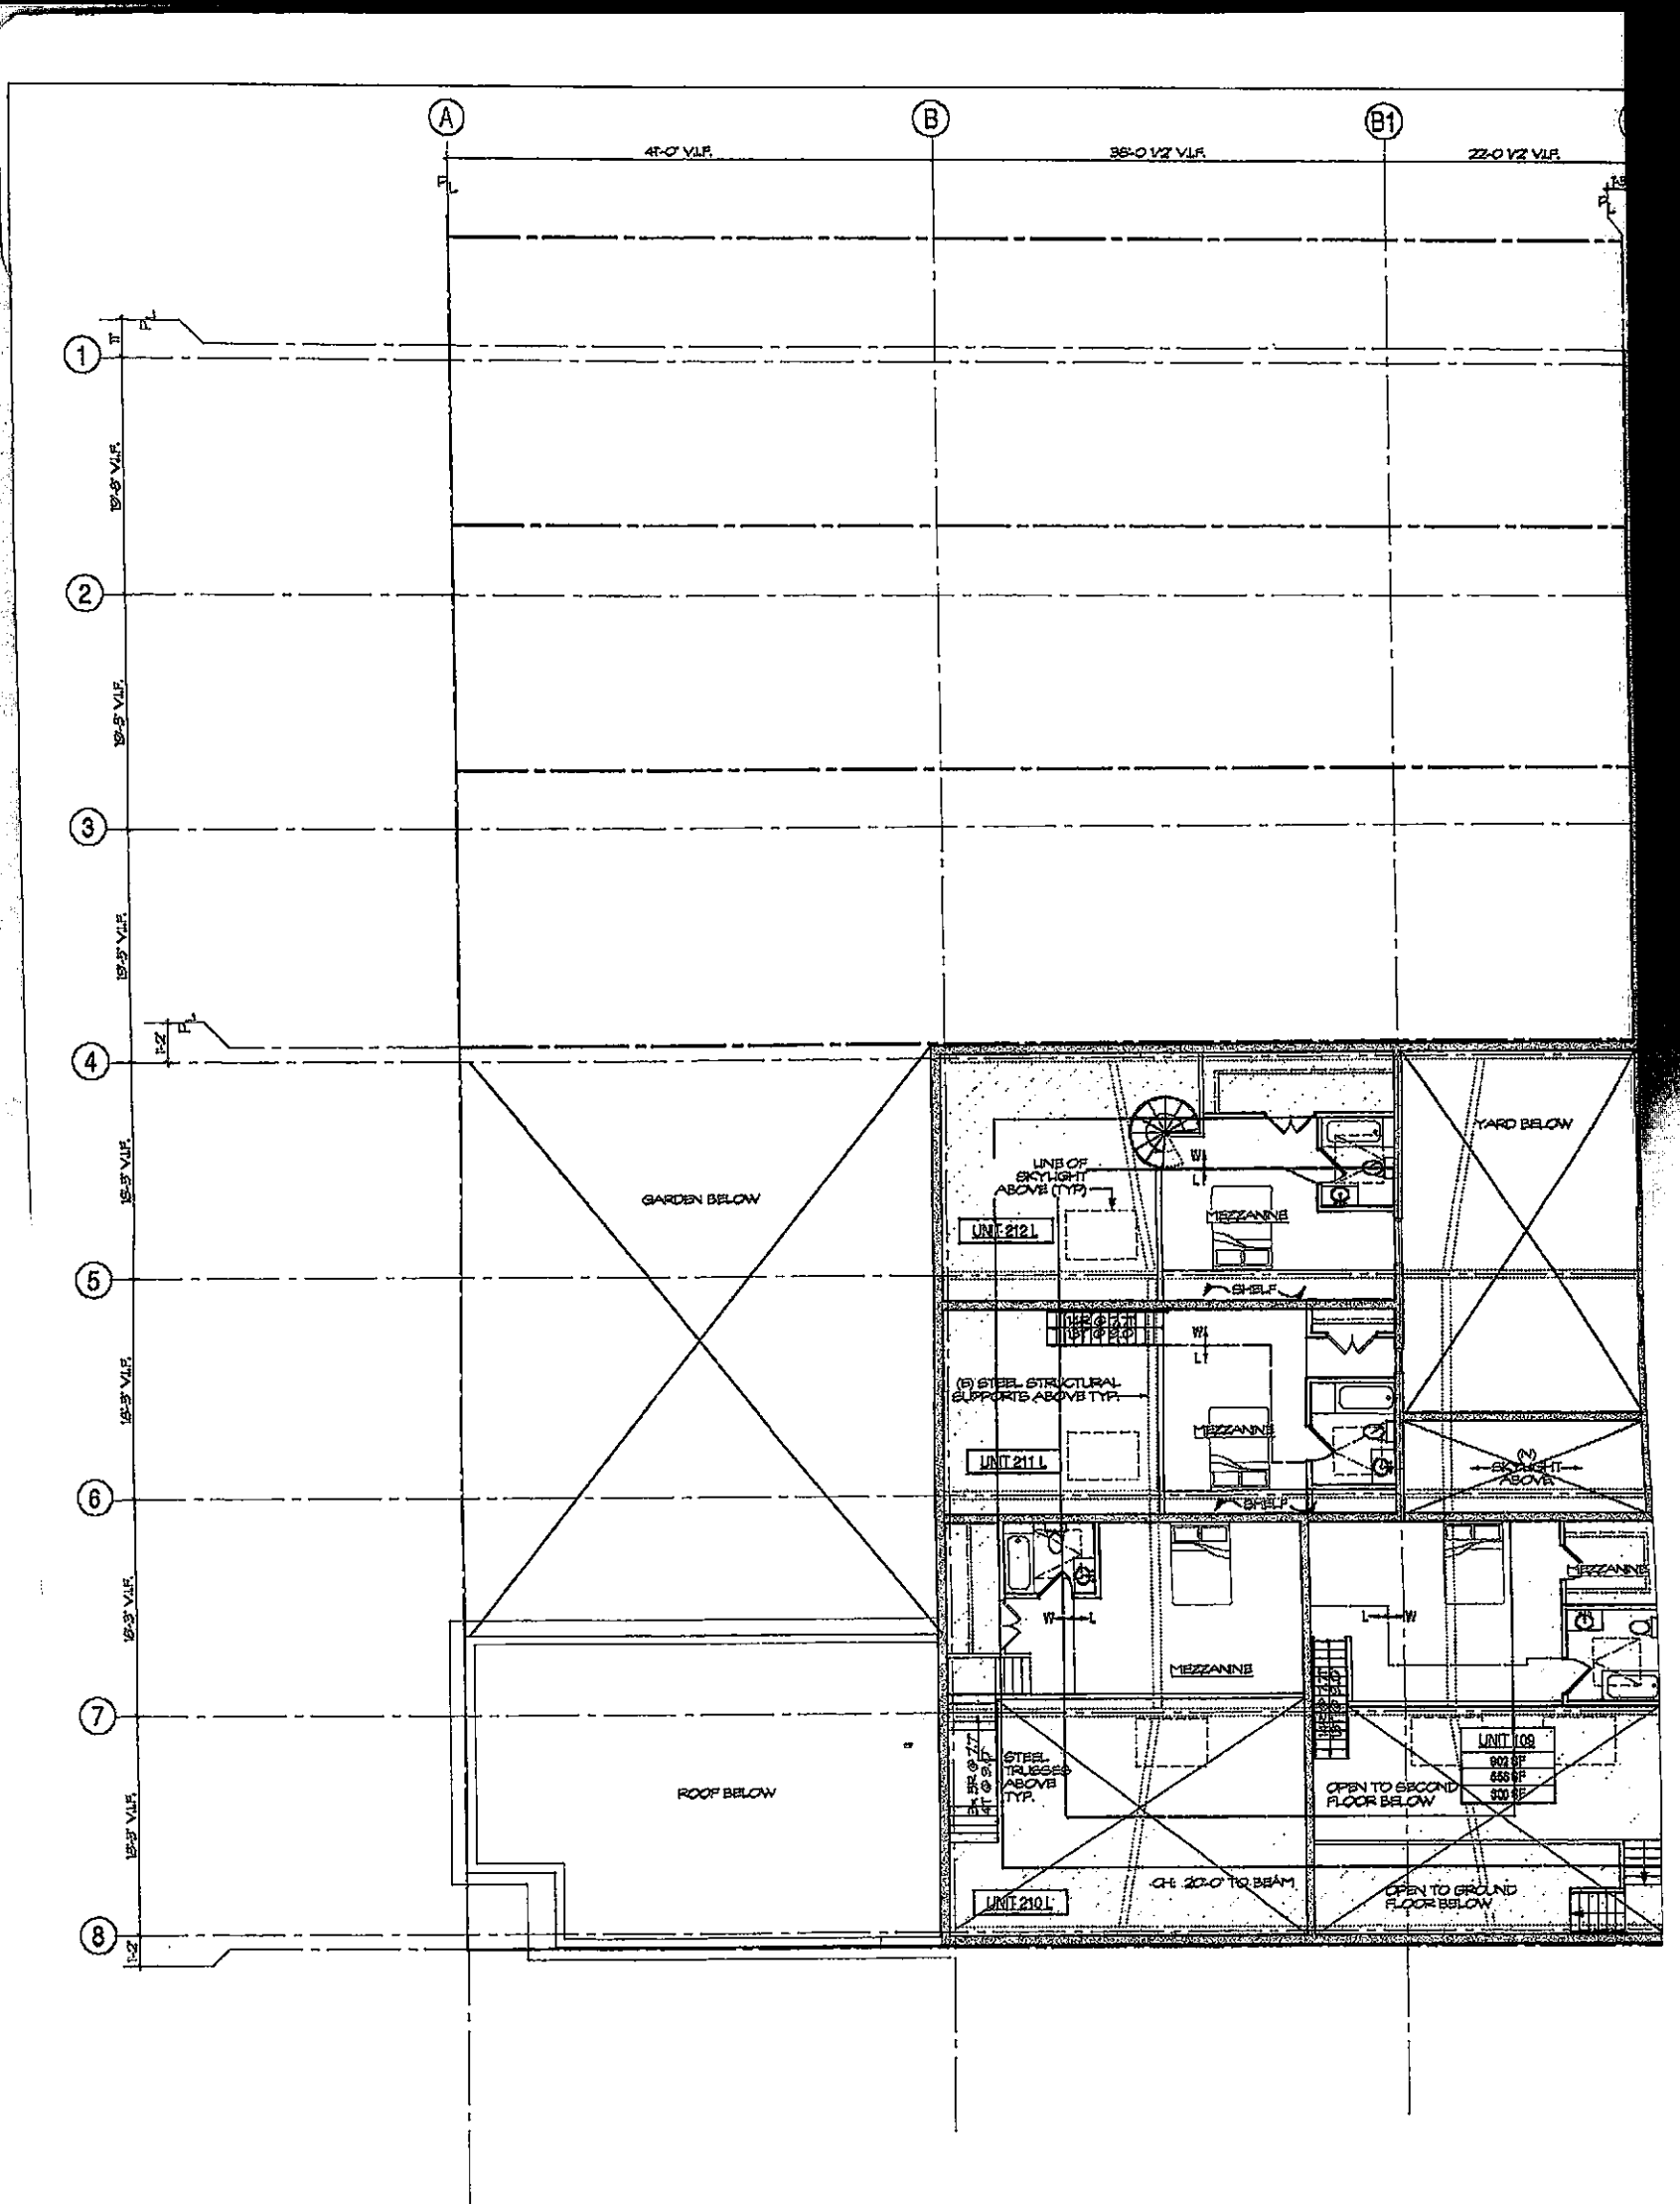

1 THIRD LEVEL PLAN
1/8" = 1'-0"

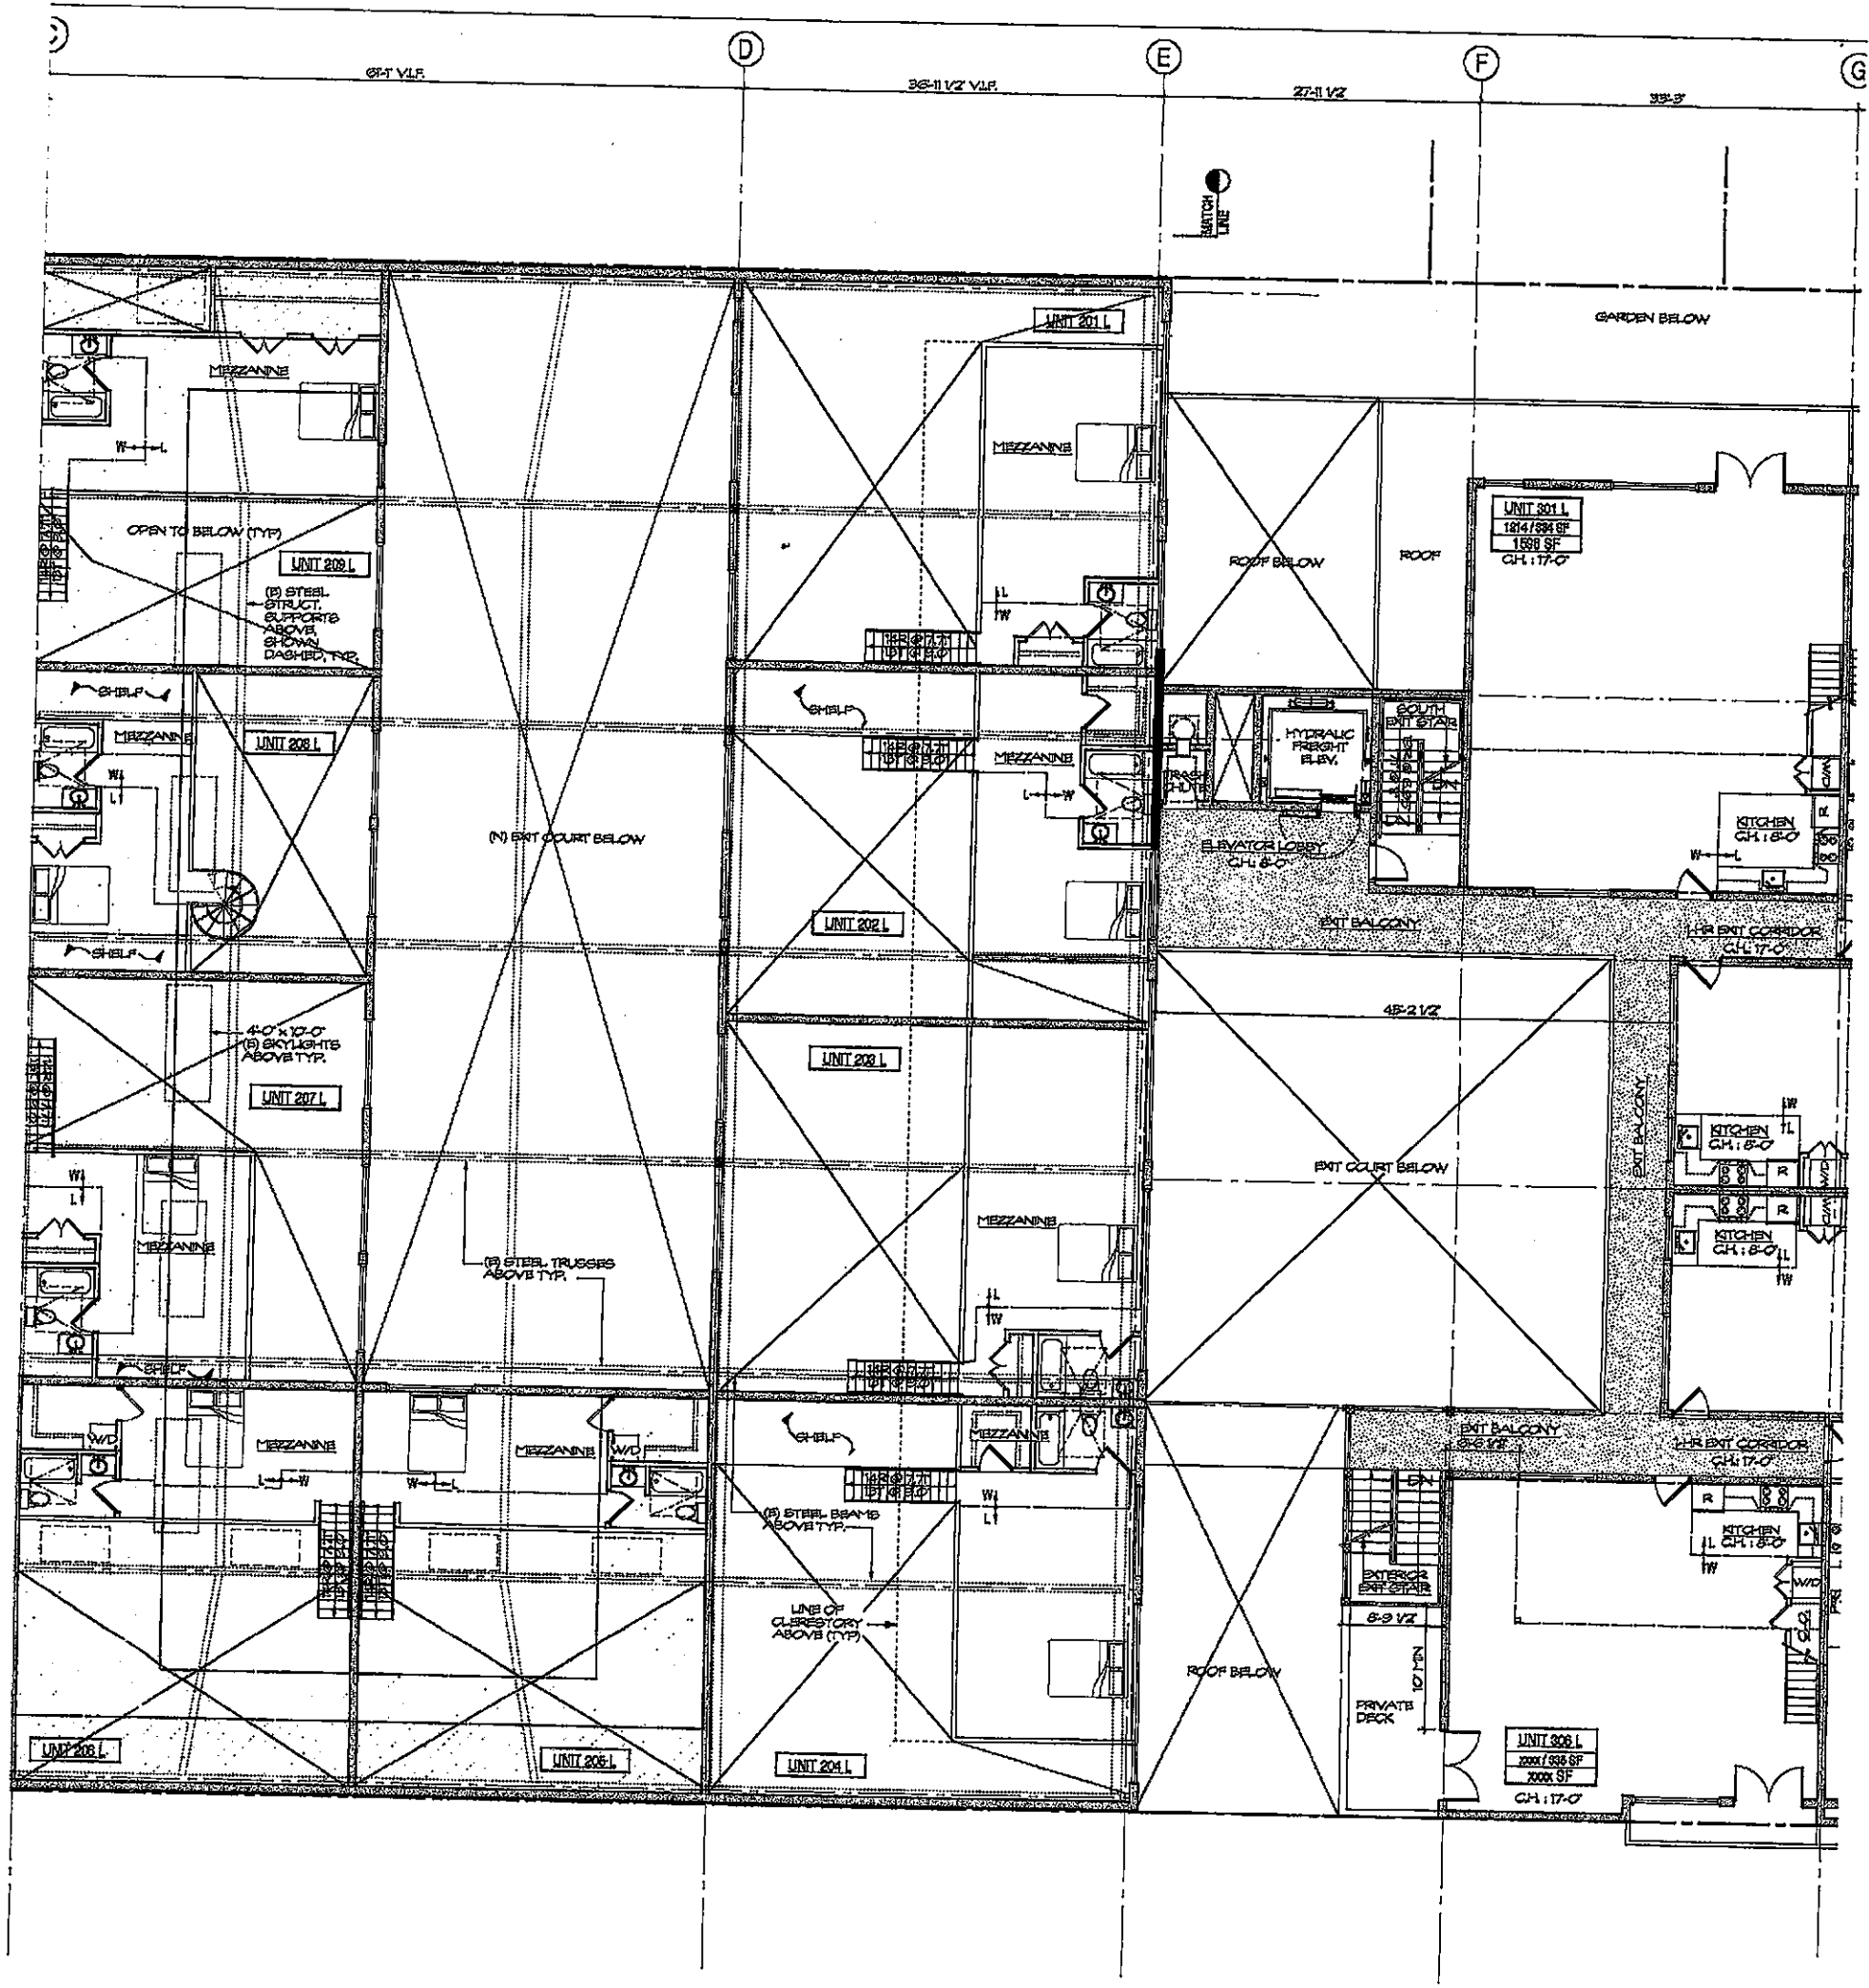



TDA

**Thomas Dolan
Architecture**
Architecture
Urban Design
Planning and
Development Consultation
Tel. (510) 839 7200
Fax. (510) 839 7208
tdarch@live-work.com
www.live-work.com
Embarcadero West
173 Filbert Street
Oakland, California
94607 U.S.A.



**FOUNDRY
LOFTS**


2868 HANNAH ST.
OAKLAND, CA


**2868 HANNAH ST.
THIRD LEVEL PLAN**

ISSUE	DESCRIPTION	DATE
	AS BUILT SET	04-01-01
	DESIGN REVIEW SET	06-05-01
	SCHEMATIC DESIGN SET	07-02-01


DATE 07-02-01
JOB NO. 01-110
DRAWN CFC


SHEET NO. **A2.31**

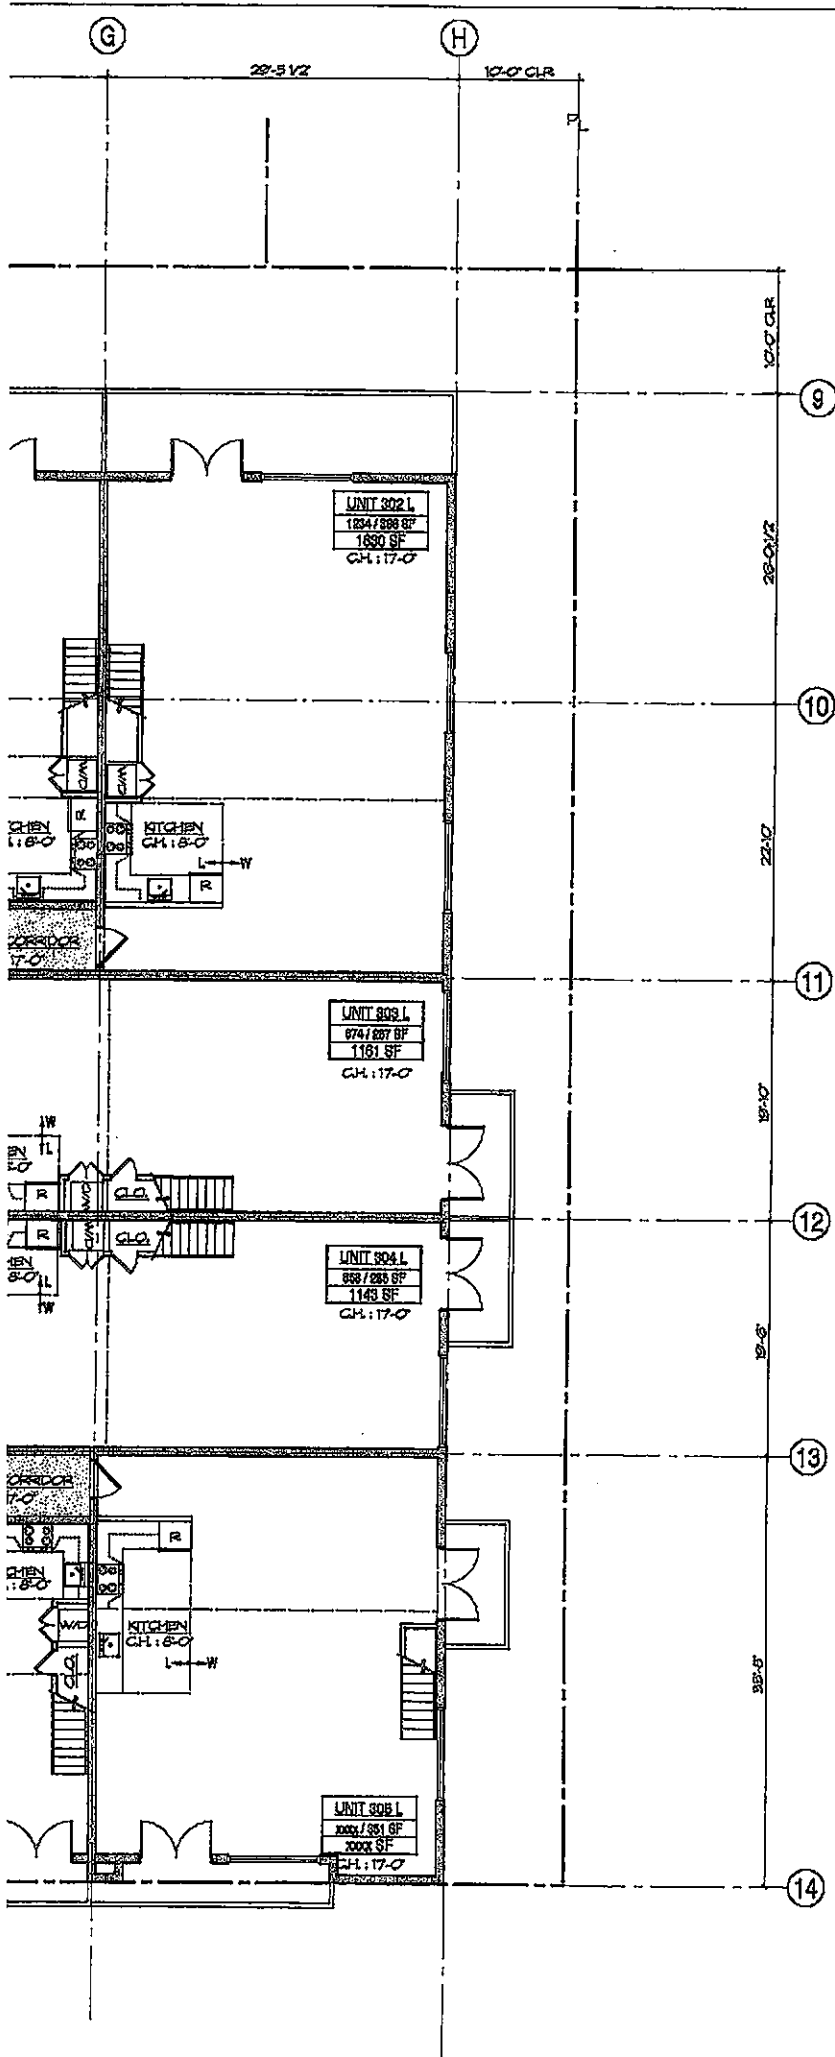

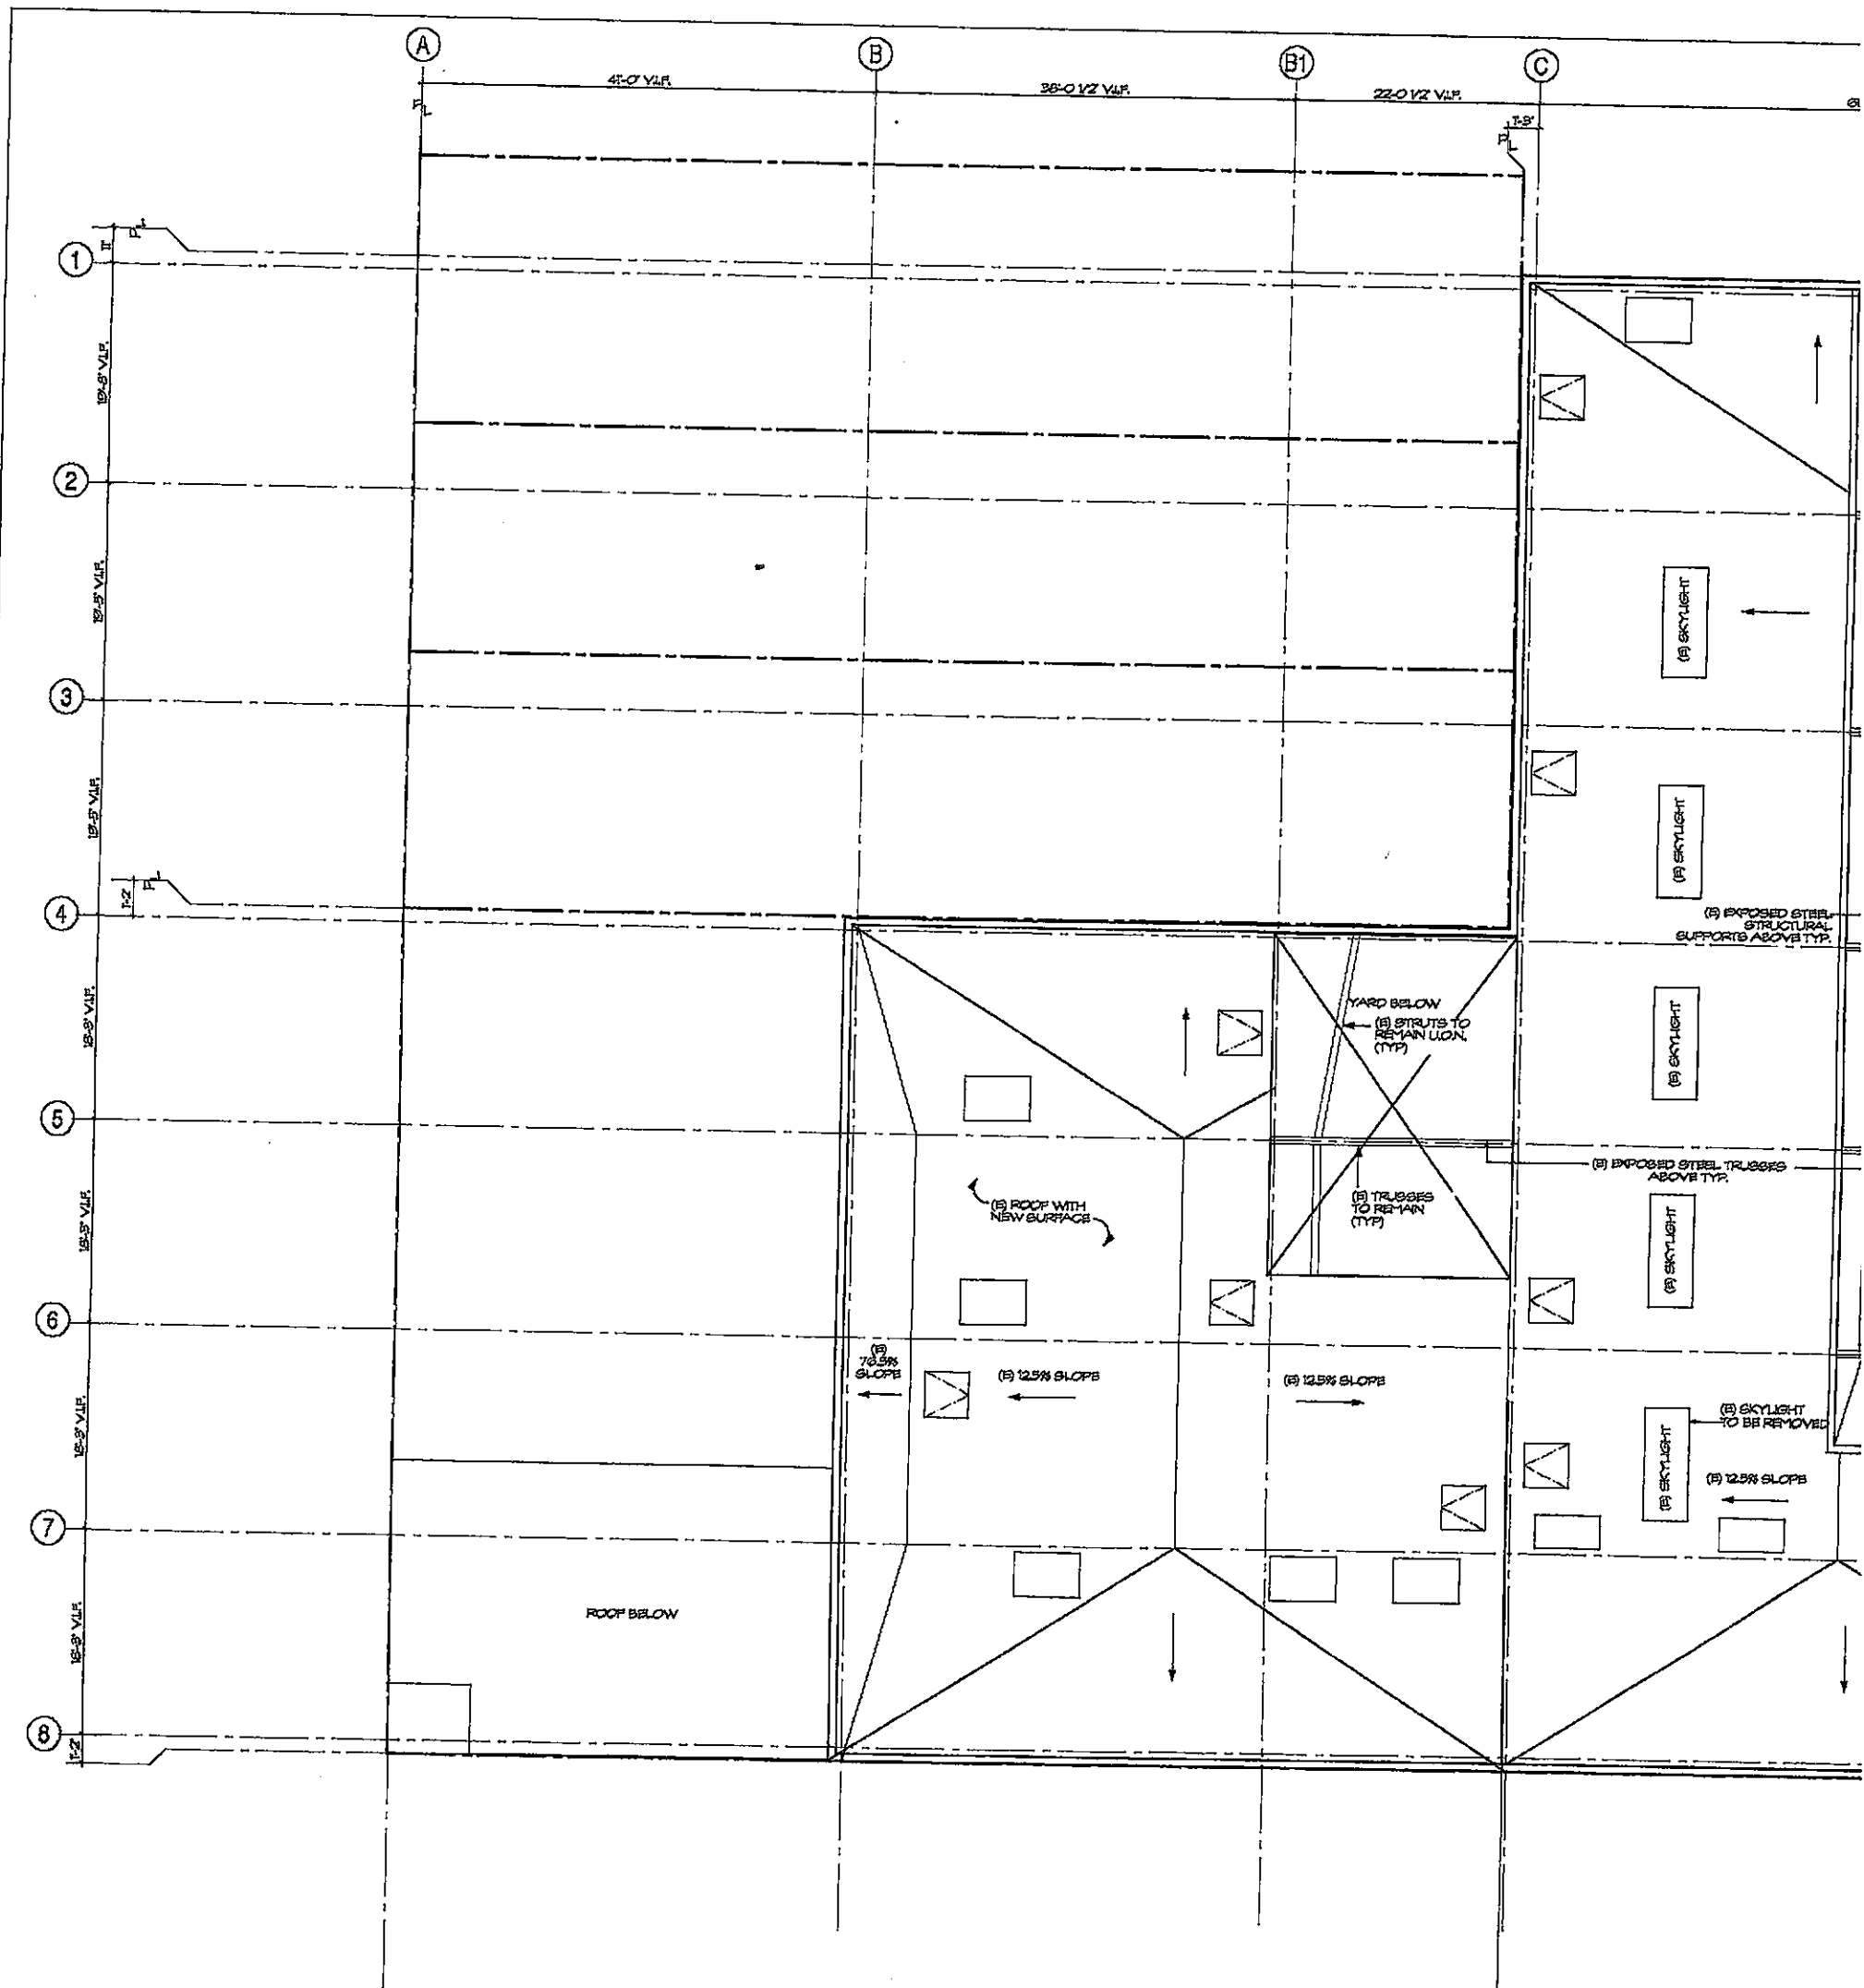

1 ROOF PLAN
1/8" = 1'-0"

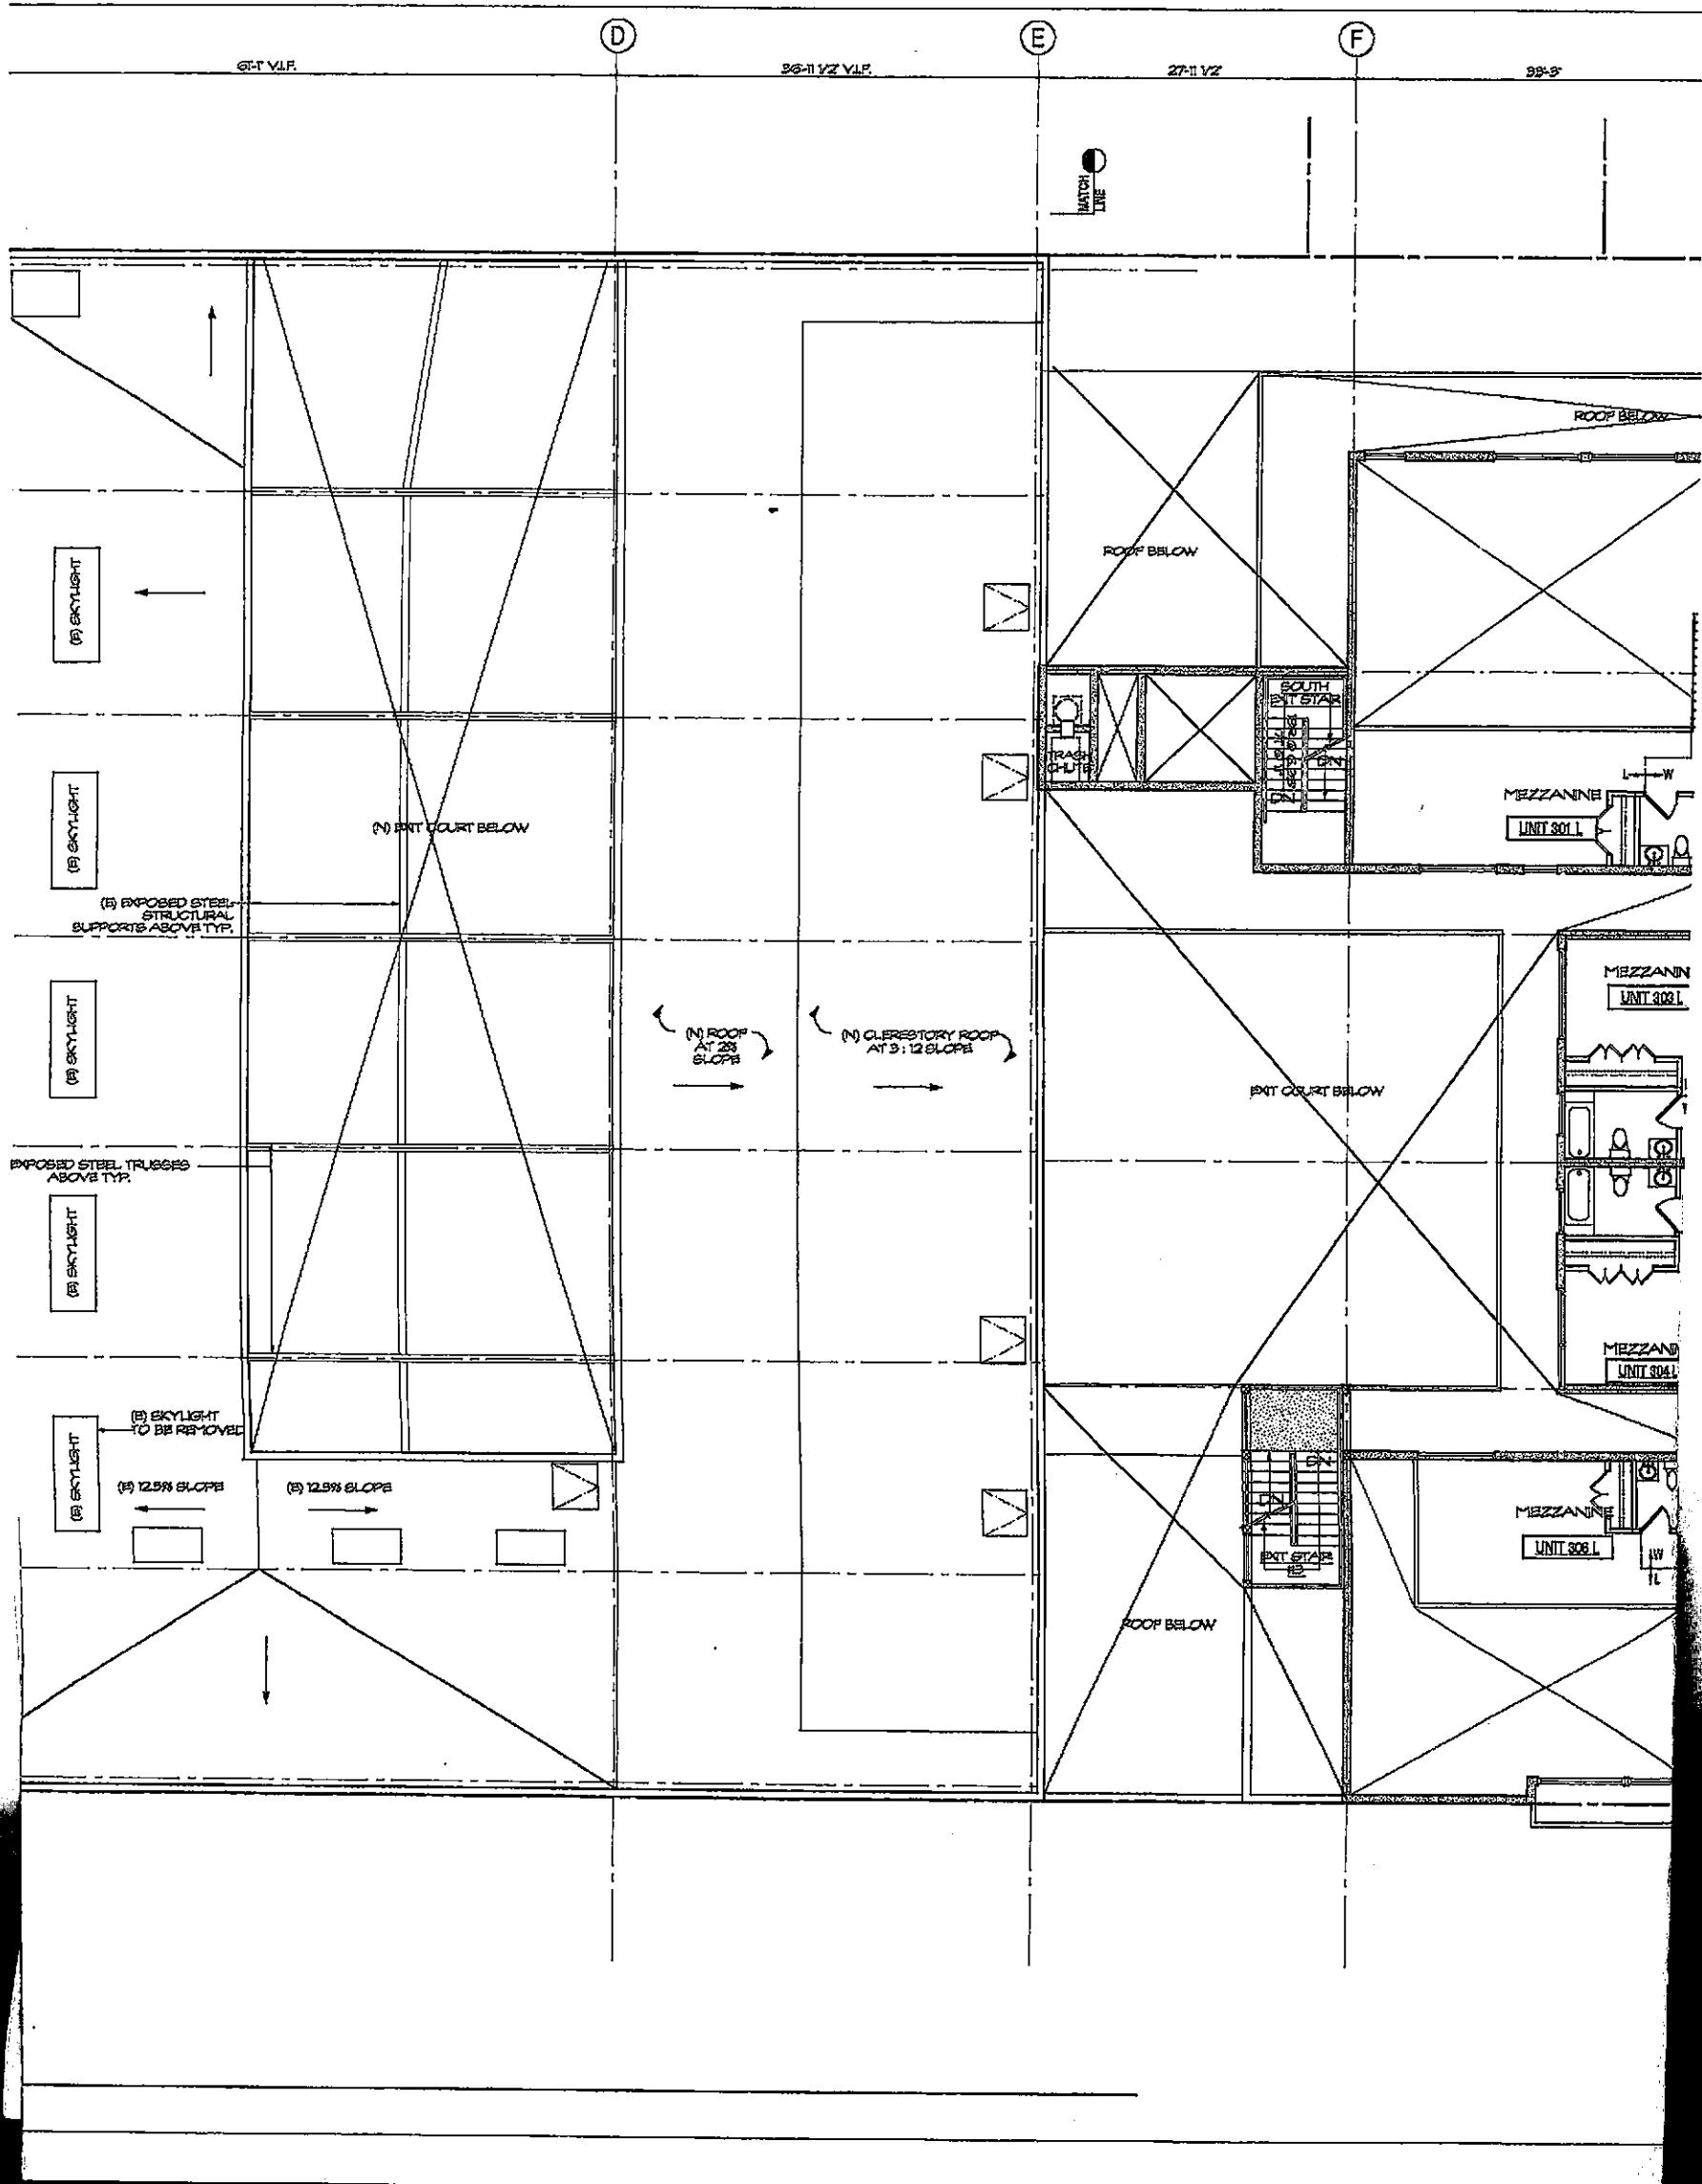

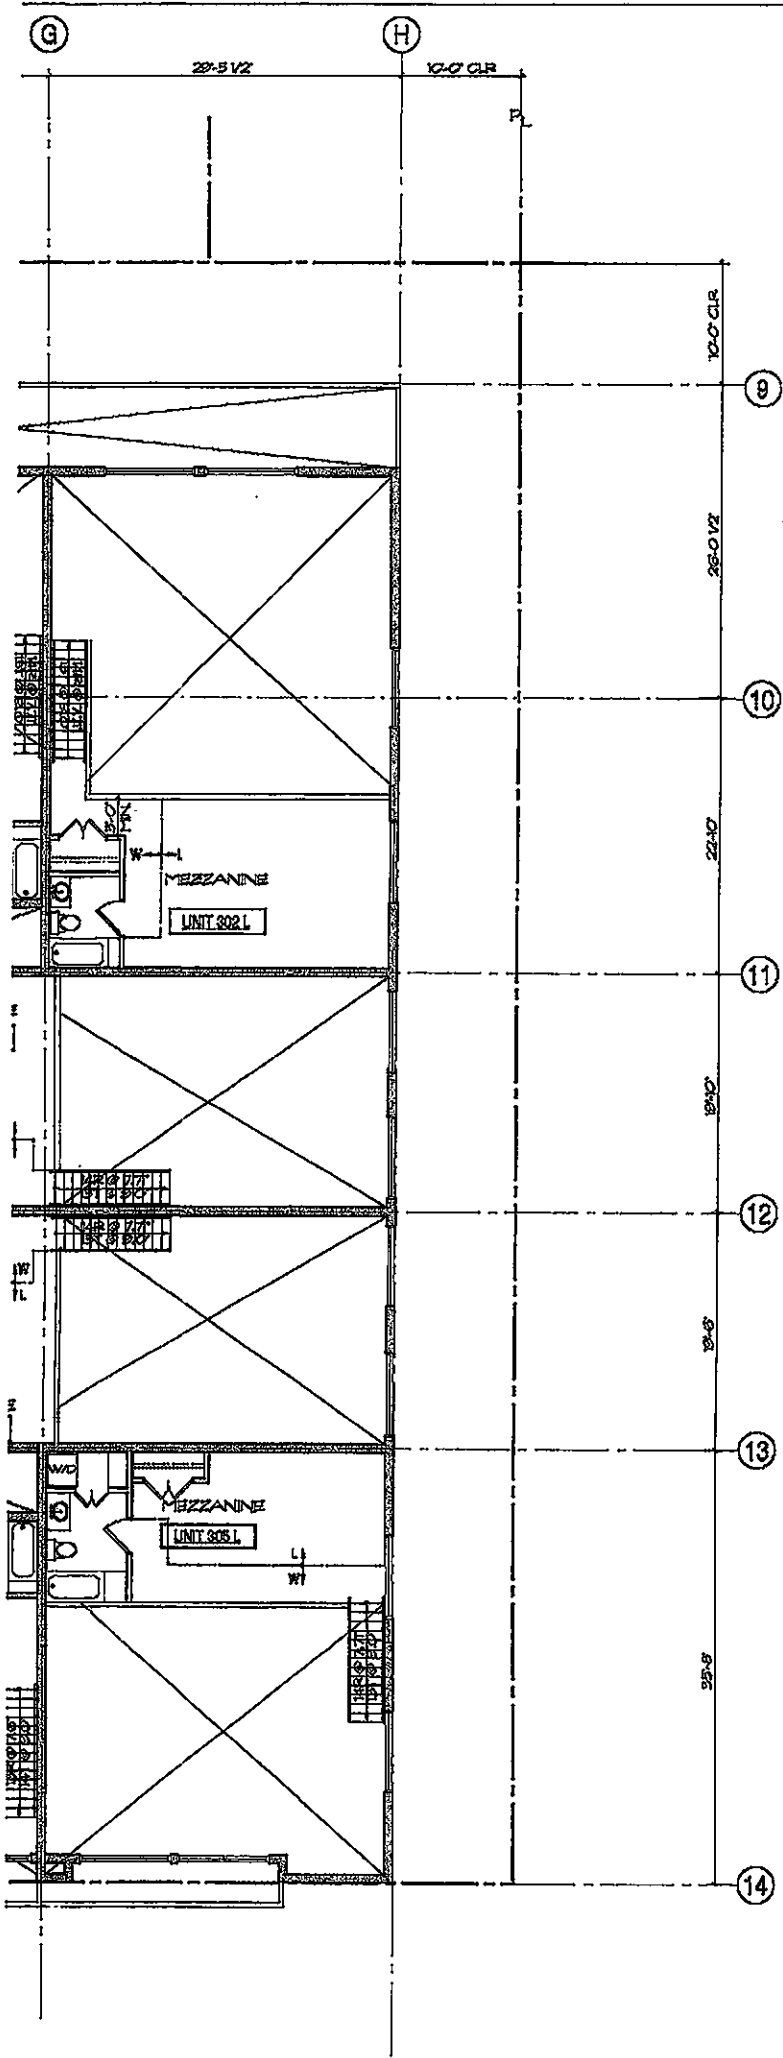

TDA

**Thomas Dolan
Architecture**

Architecture
Urban Design
Planning and
Development Consultant

tel. (510) 839 7200
fax. (510) 839 7208
td.arch@live-work.com
www.live-work.com

Embarcadero West
173 Filbert Street
Oakland, California
94607 U.S.A.



**FOUNDRY
LOFTS**


2868 HANNAH ST.
OAKLAND, CA


**2868 HANNAH ST.
FOURTH LEVEL
PLAN**

ISSUE	DESCRIPTION	DATE
	AS BUILT SET	04-01-01
	DESIGN REVIEW SET	06-05-01
	SCHEMATIC DESIGN SET	07-02-01


DATE: 07-02-01
JOB NO. 01.113
DRAWN: CPC

SHEET NO. **A2.41**

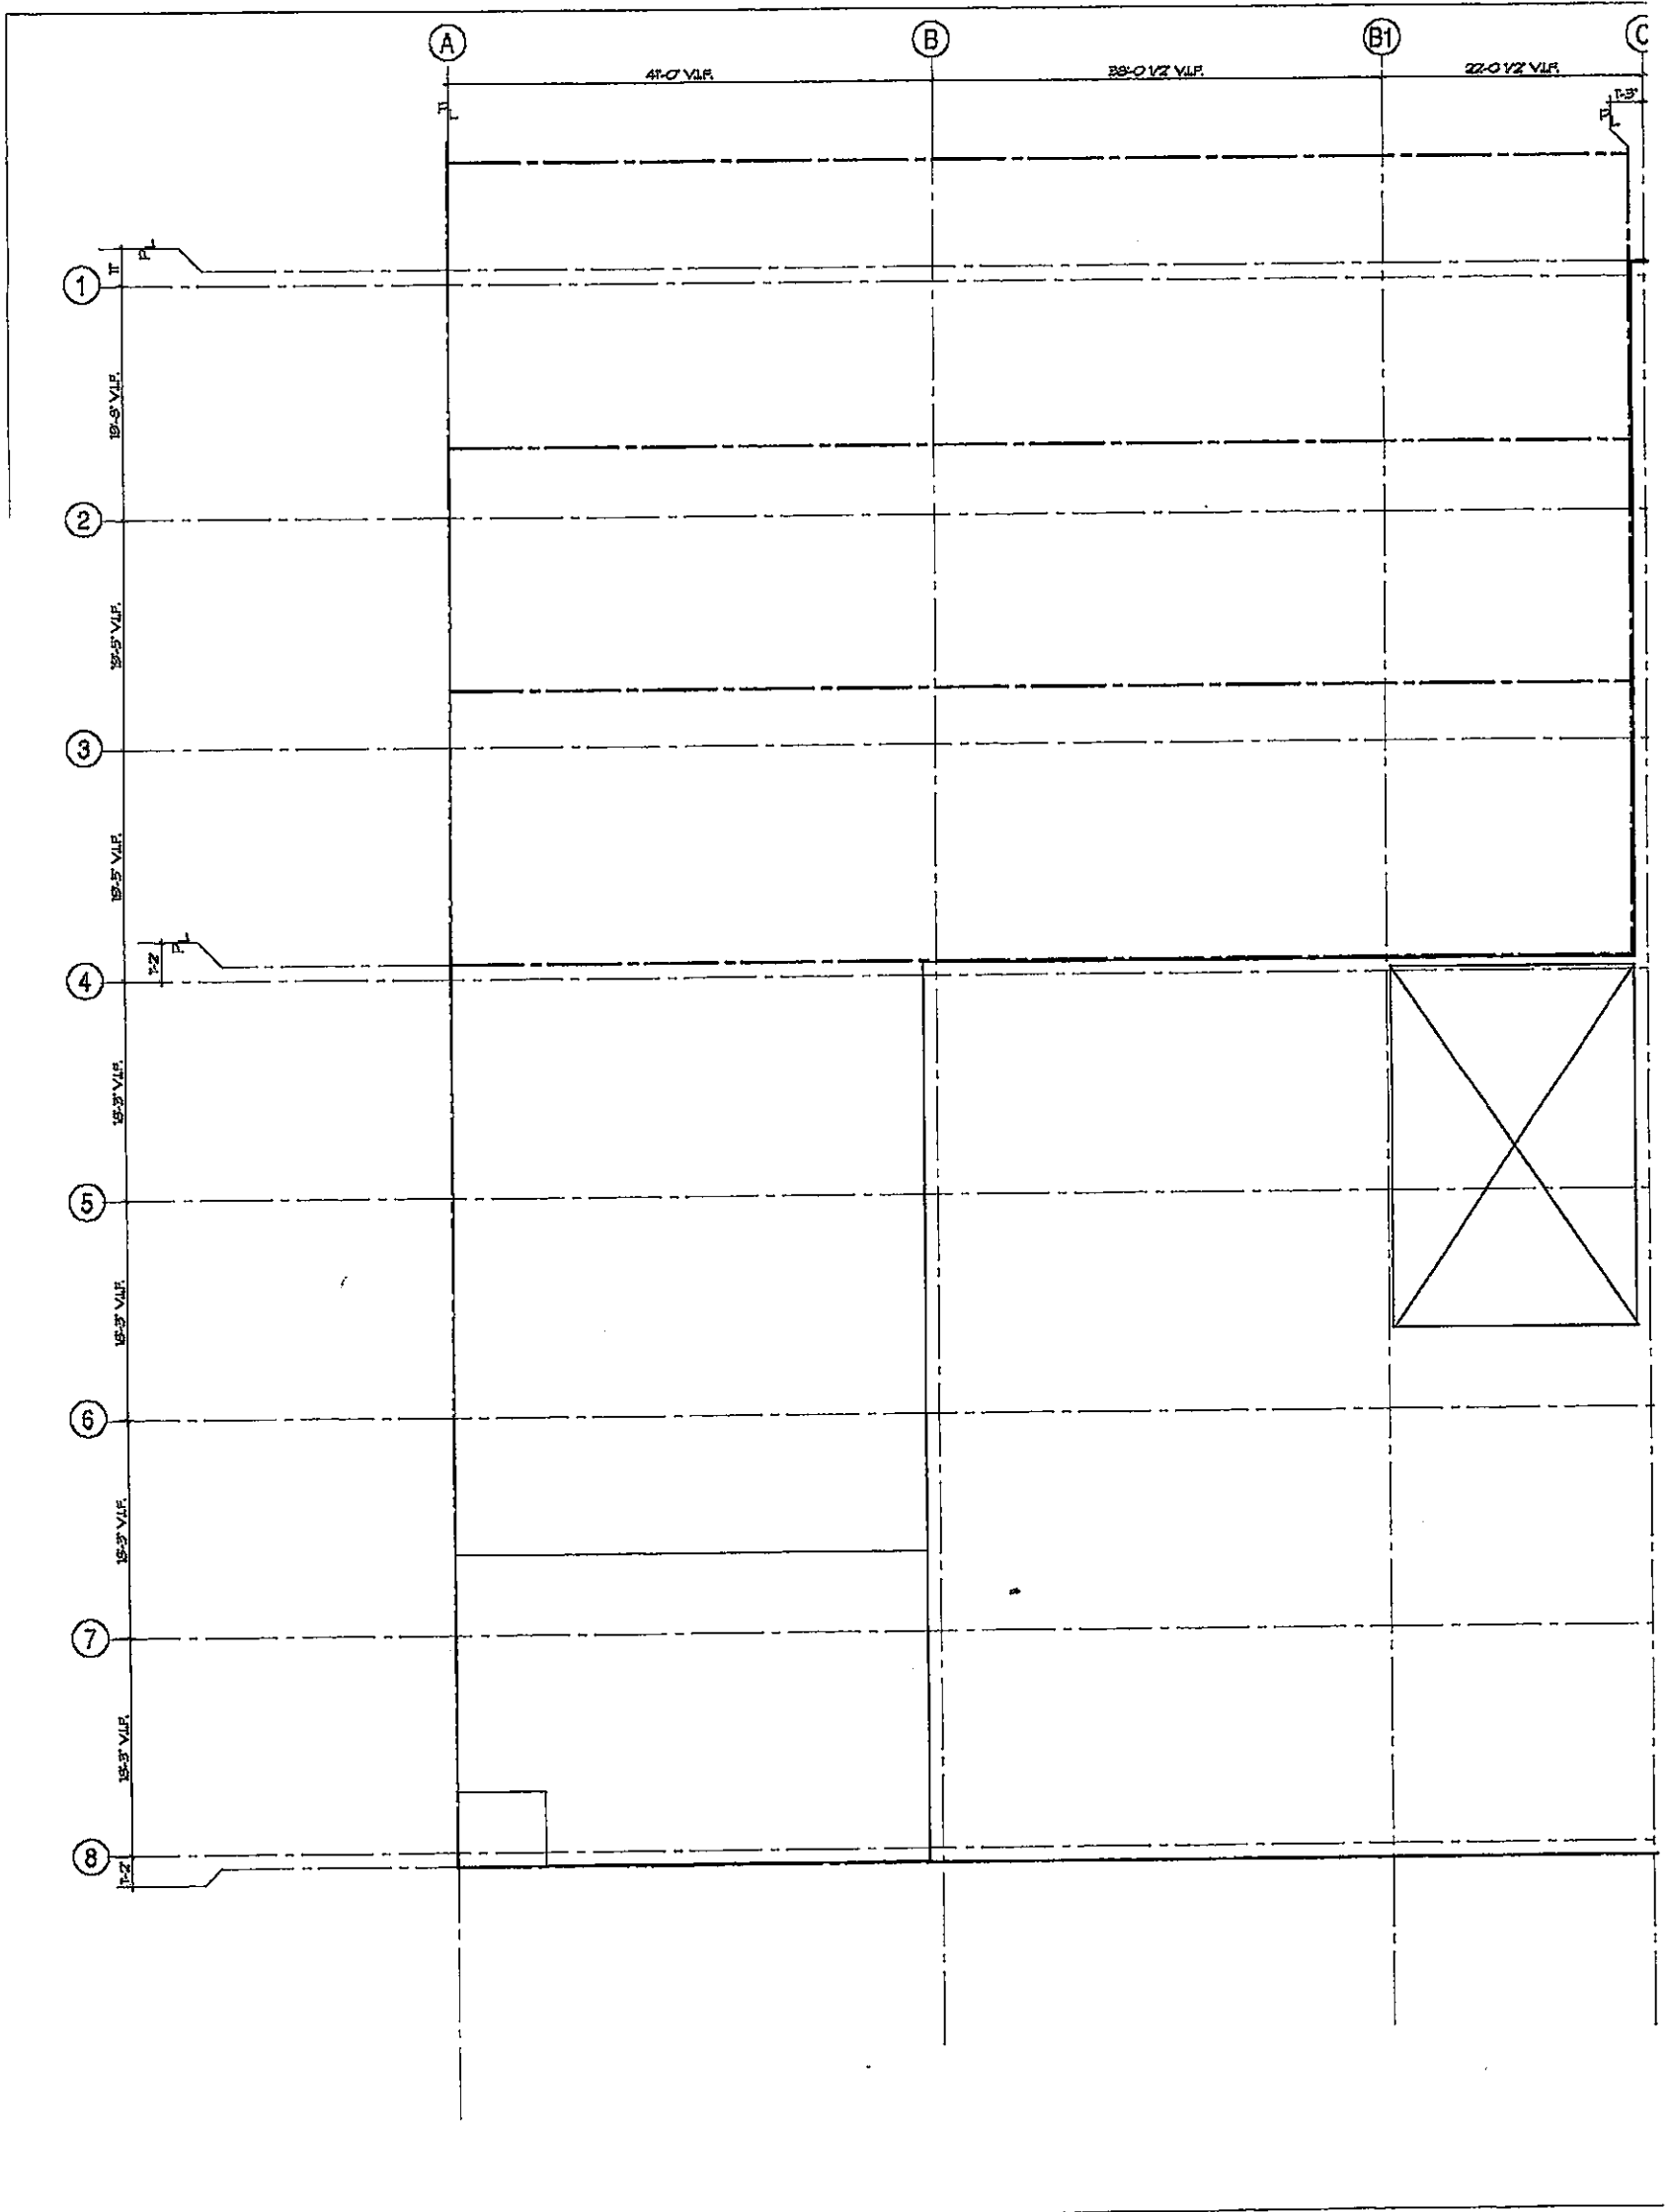

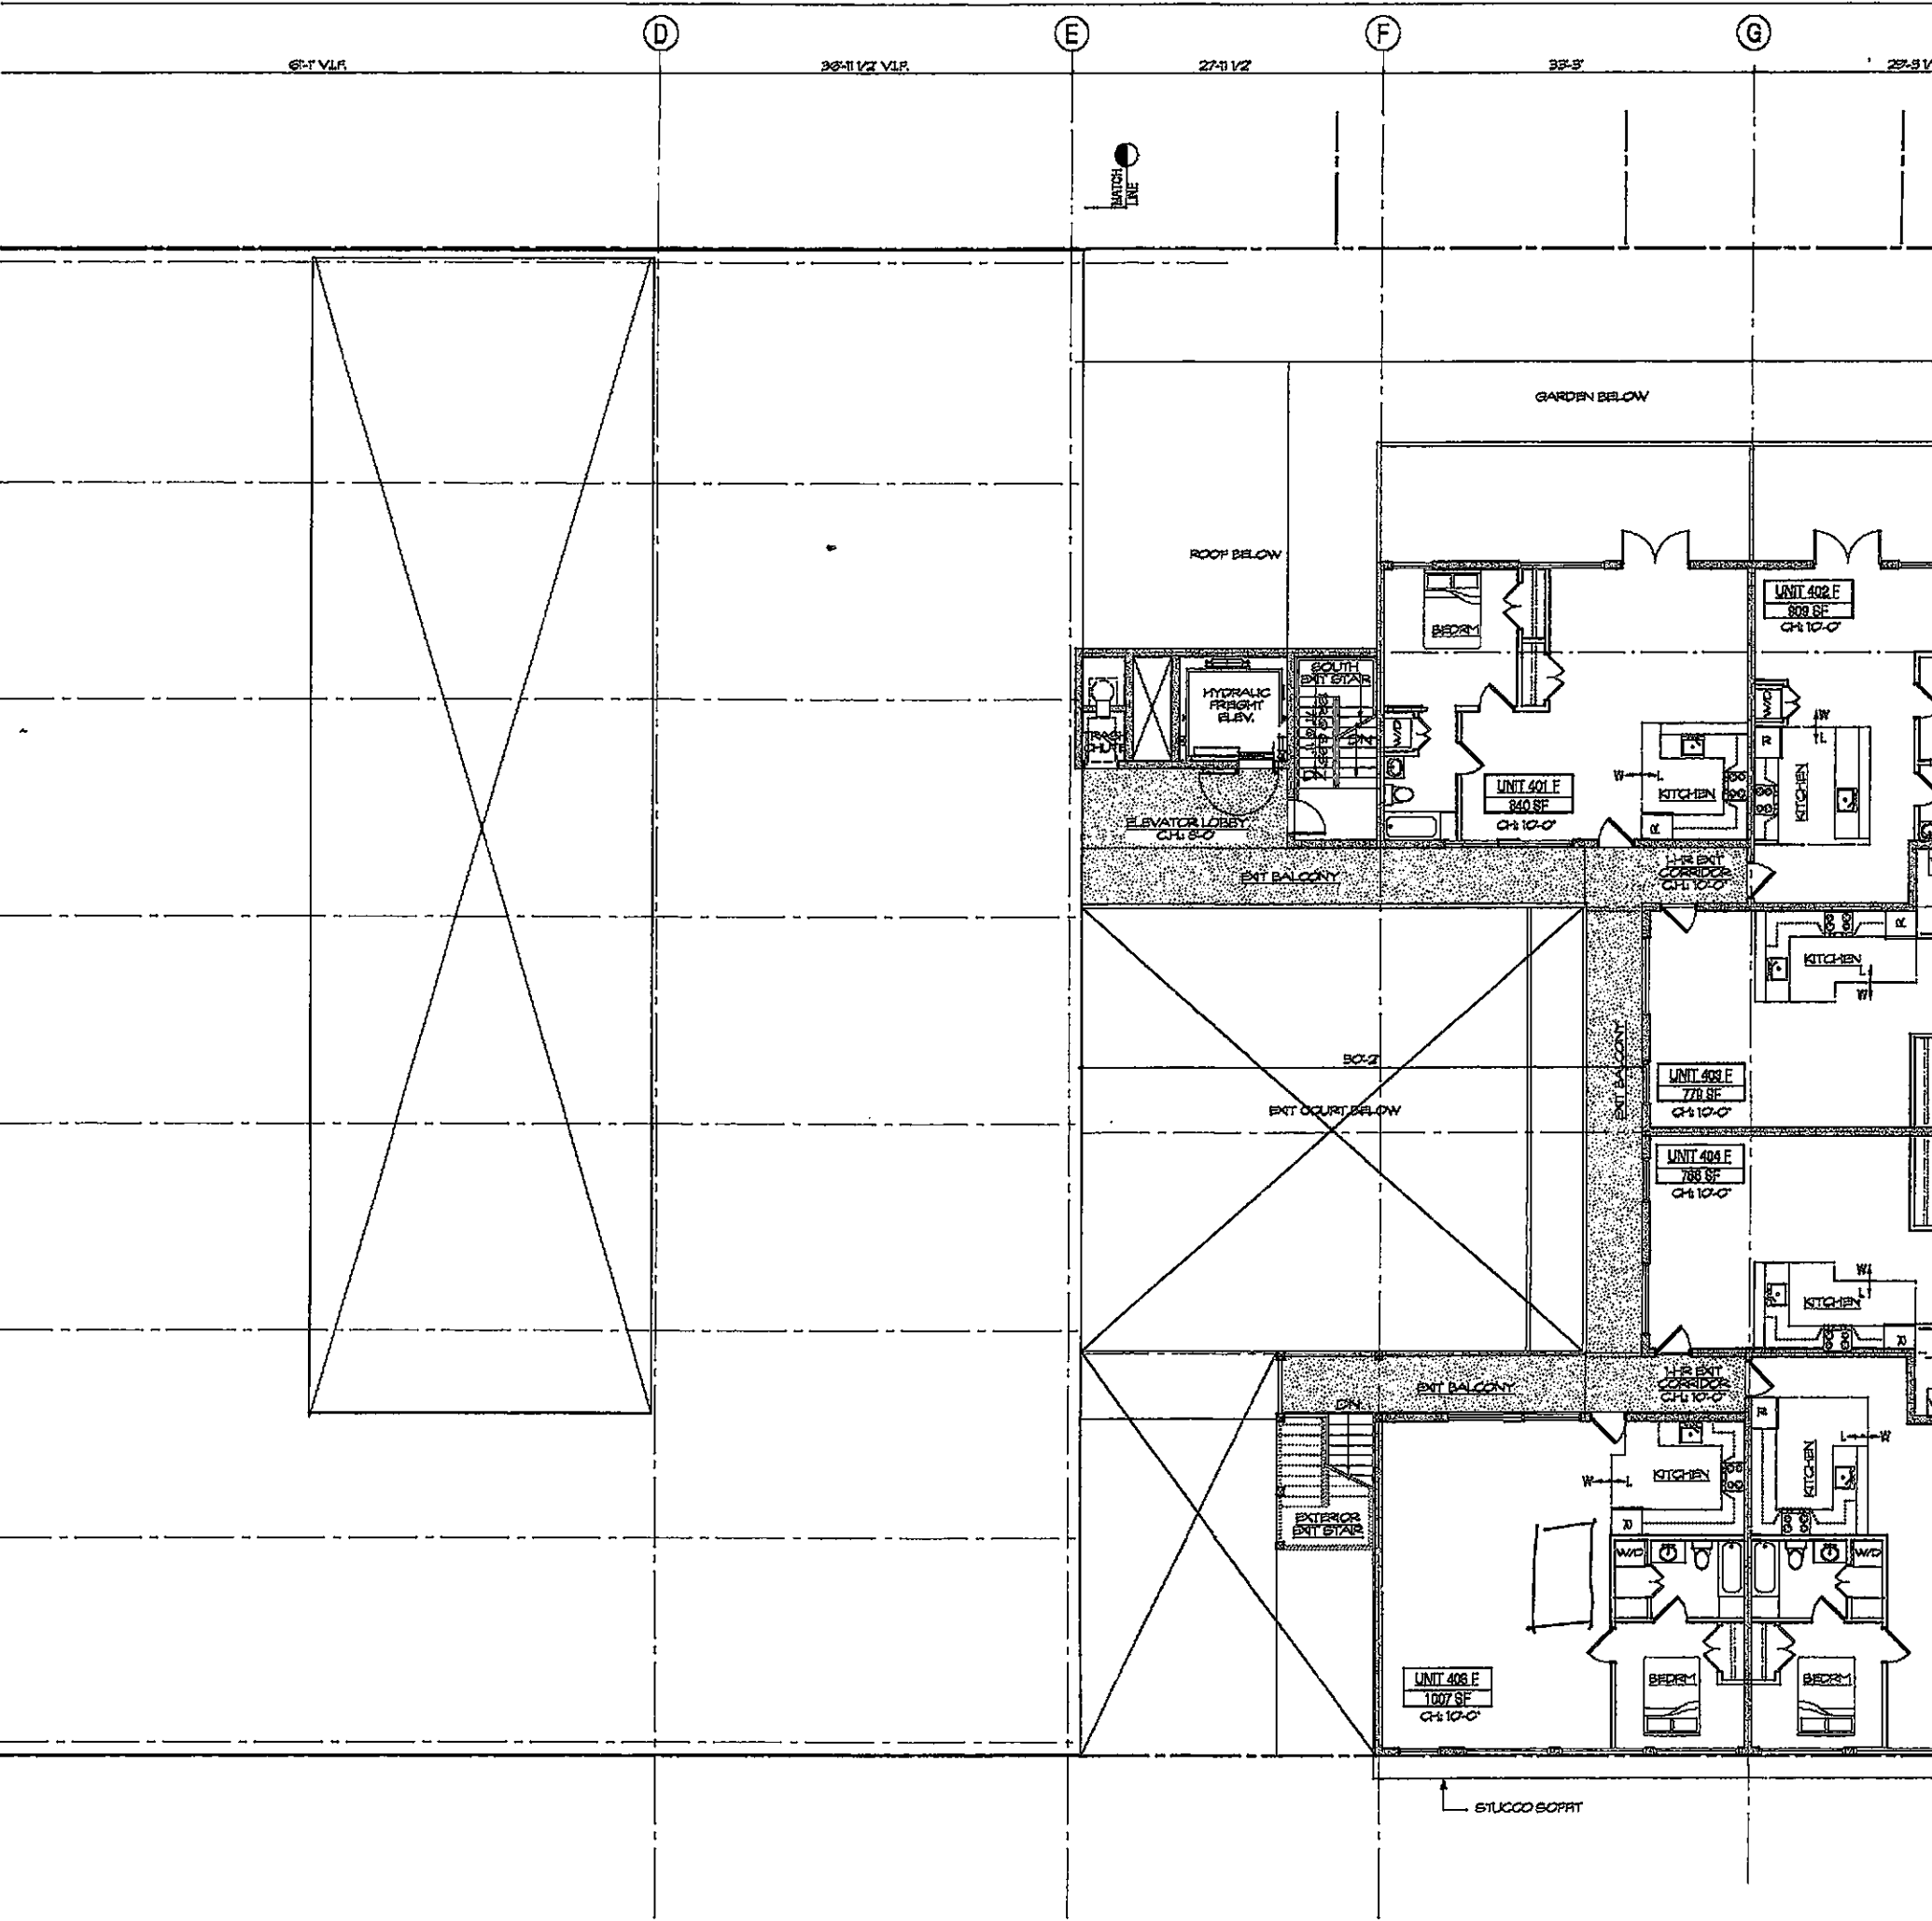

1 FIFTH LEVEL PLAN
1/8" = 1'-0"

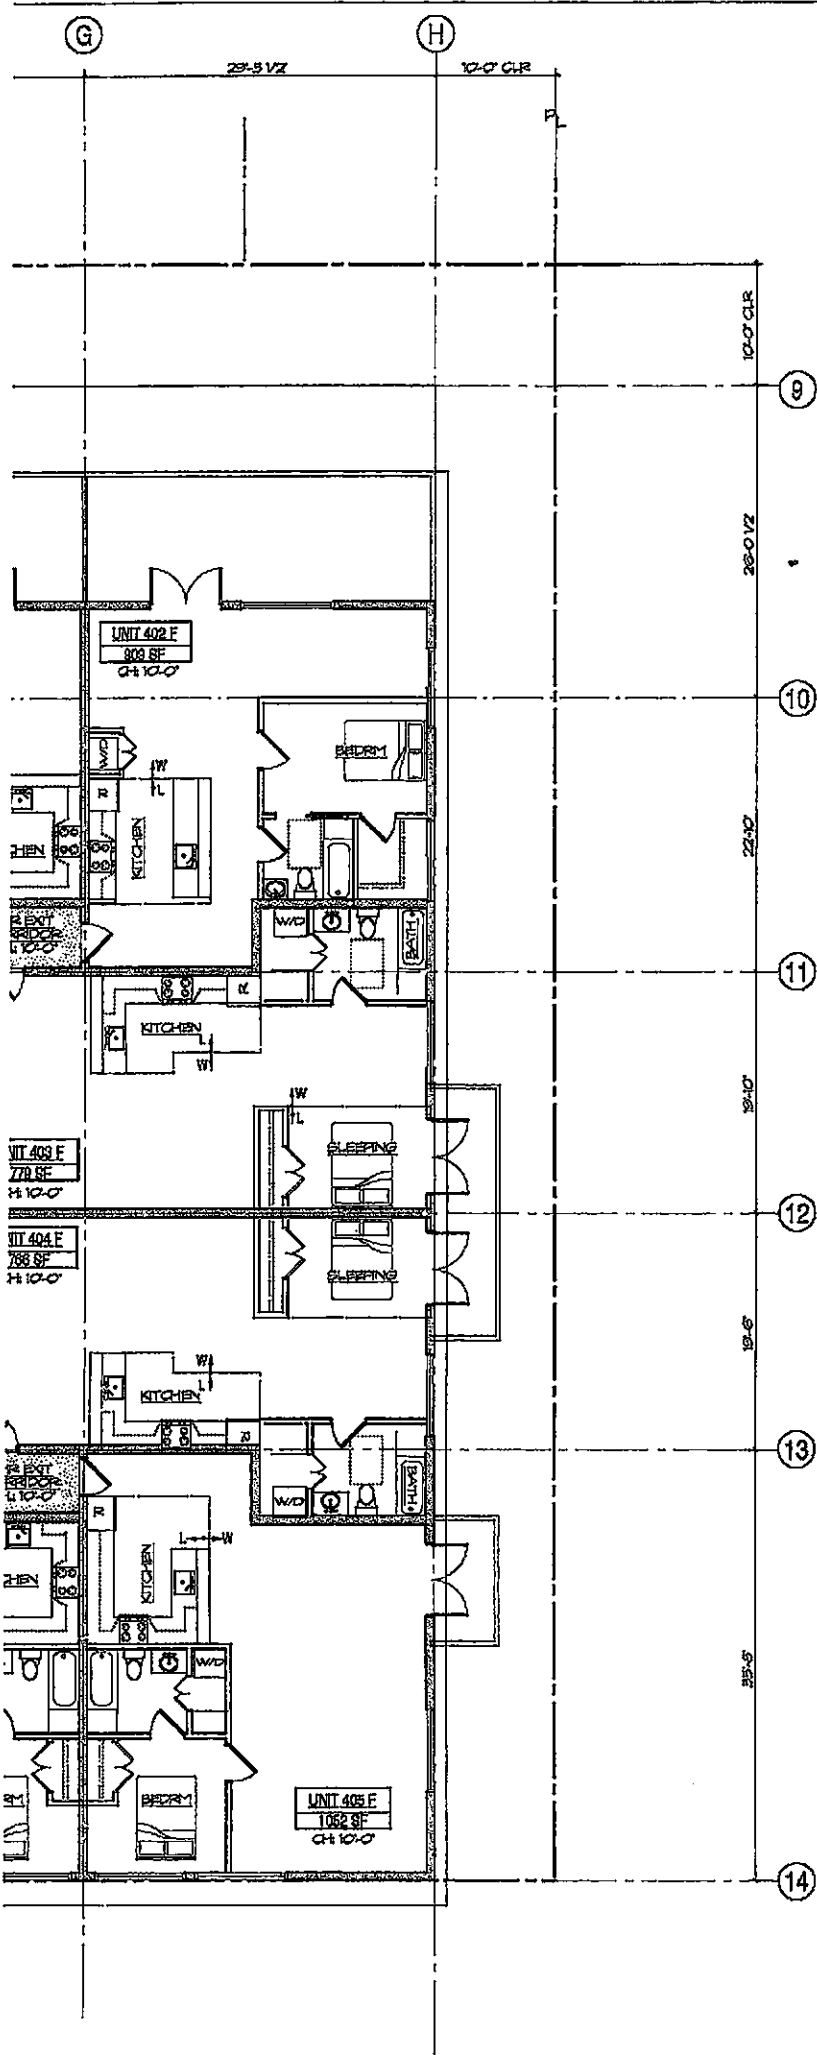

TDA

**Thomas Dolan
Architecture**

Architecture
Urban Design
Planning and
Development Consultant
tel. (510) 859 7200
fax. (510) 859 7206
td.arch@live-work.com
www.live-work.com

Embarcadero West
175 Fifth Street
Oakland, California
94607 U.S.A.



**FOUNDRY
LOFTS**


2868 HANNAH ST.
OAKLAND, CA.


**2868 HANNAH ST.
FIFTH FLOOR PLAN**

ISSUE	DESCRIPTION	DATE
	AS BUILT SET	04-01-01
	DESIGN REVIEW SET	06-05-01
	SCHEMATIC DESIGN SET	07-02-01


DATE: 07-02-01
JOB NO.: 01.113
DRAWN: CPC

SHEET NO. **A2.51**

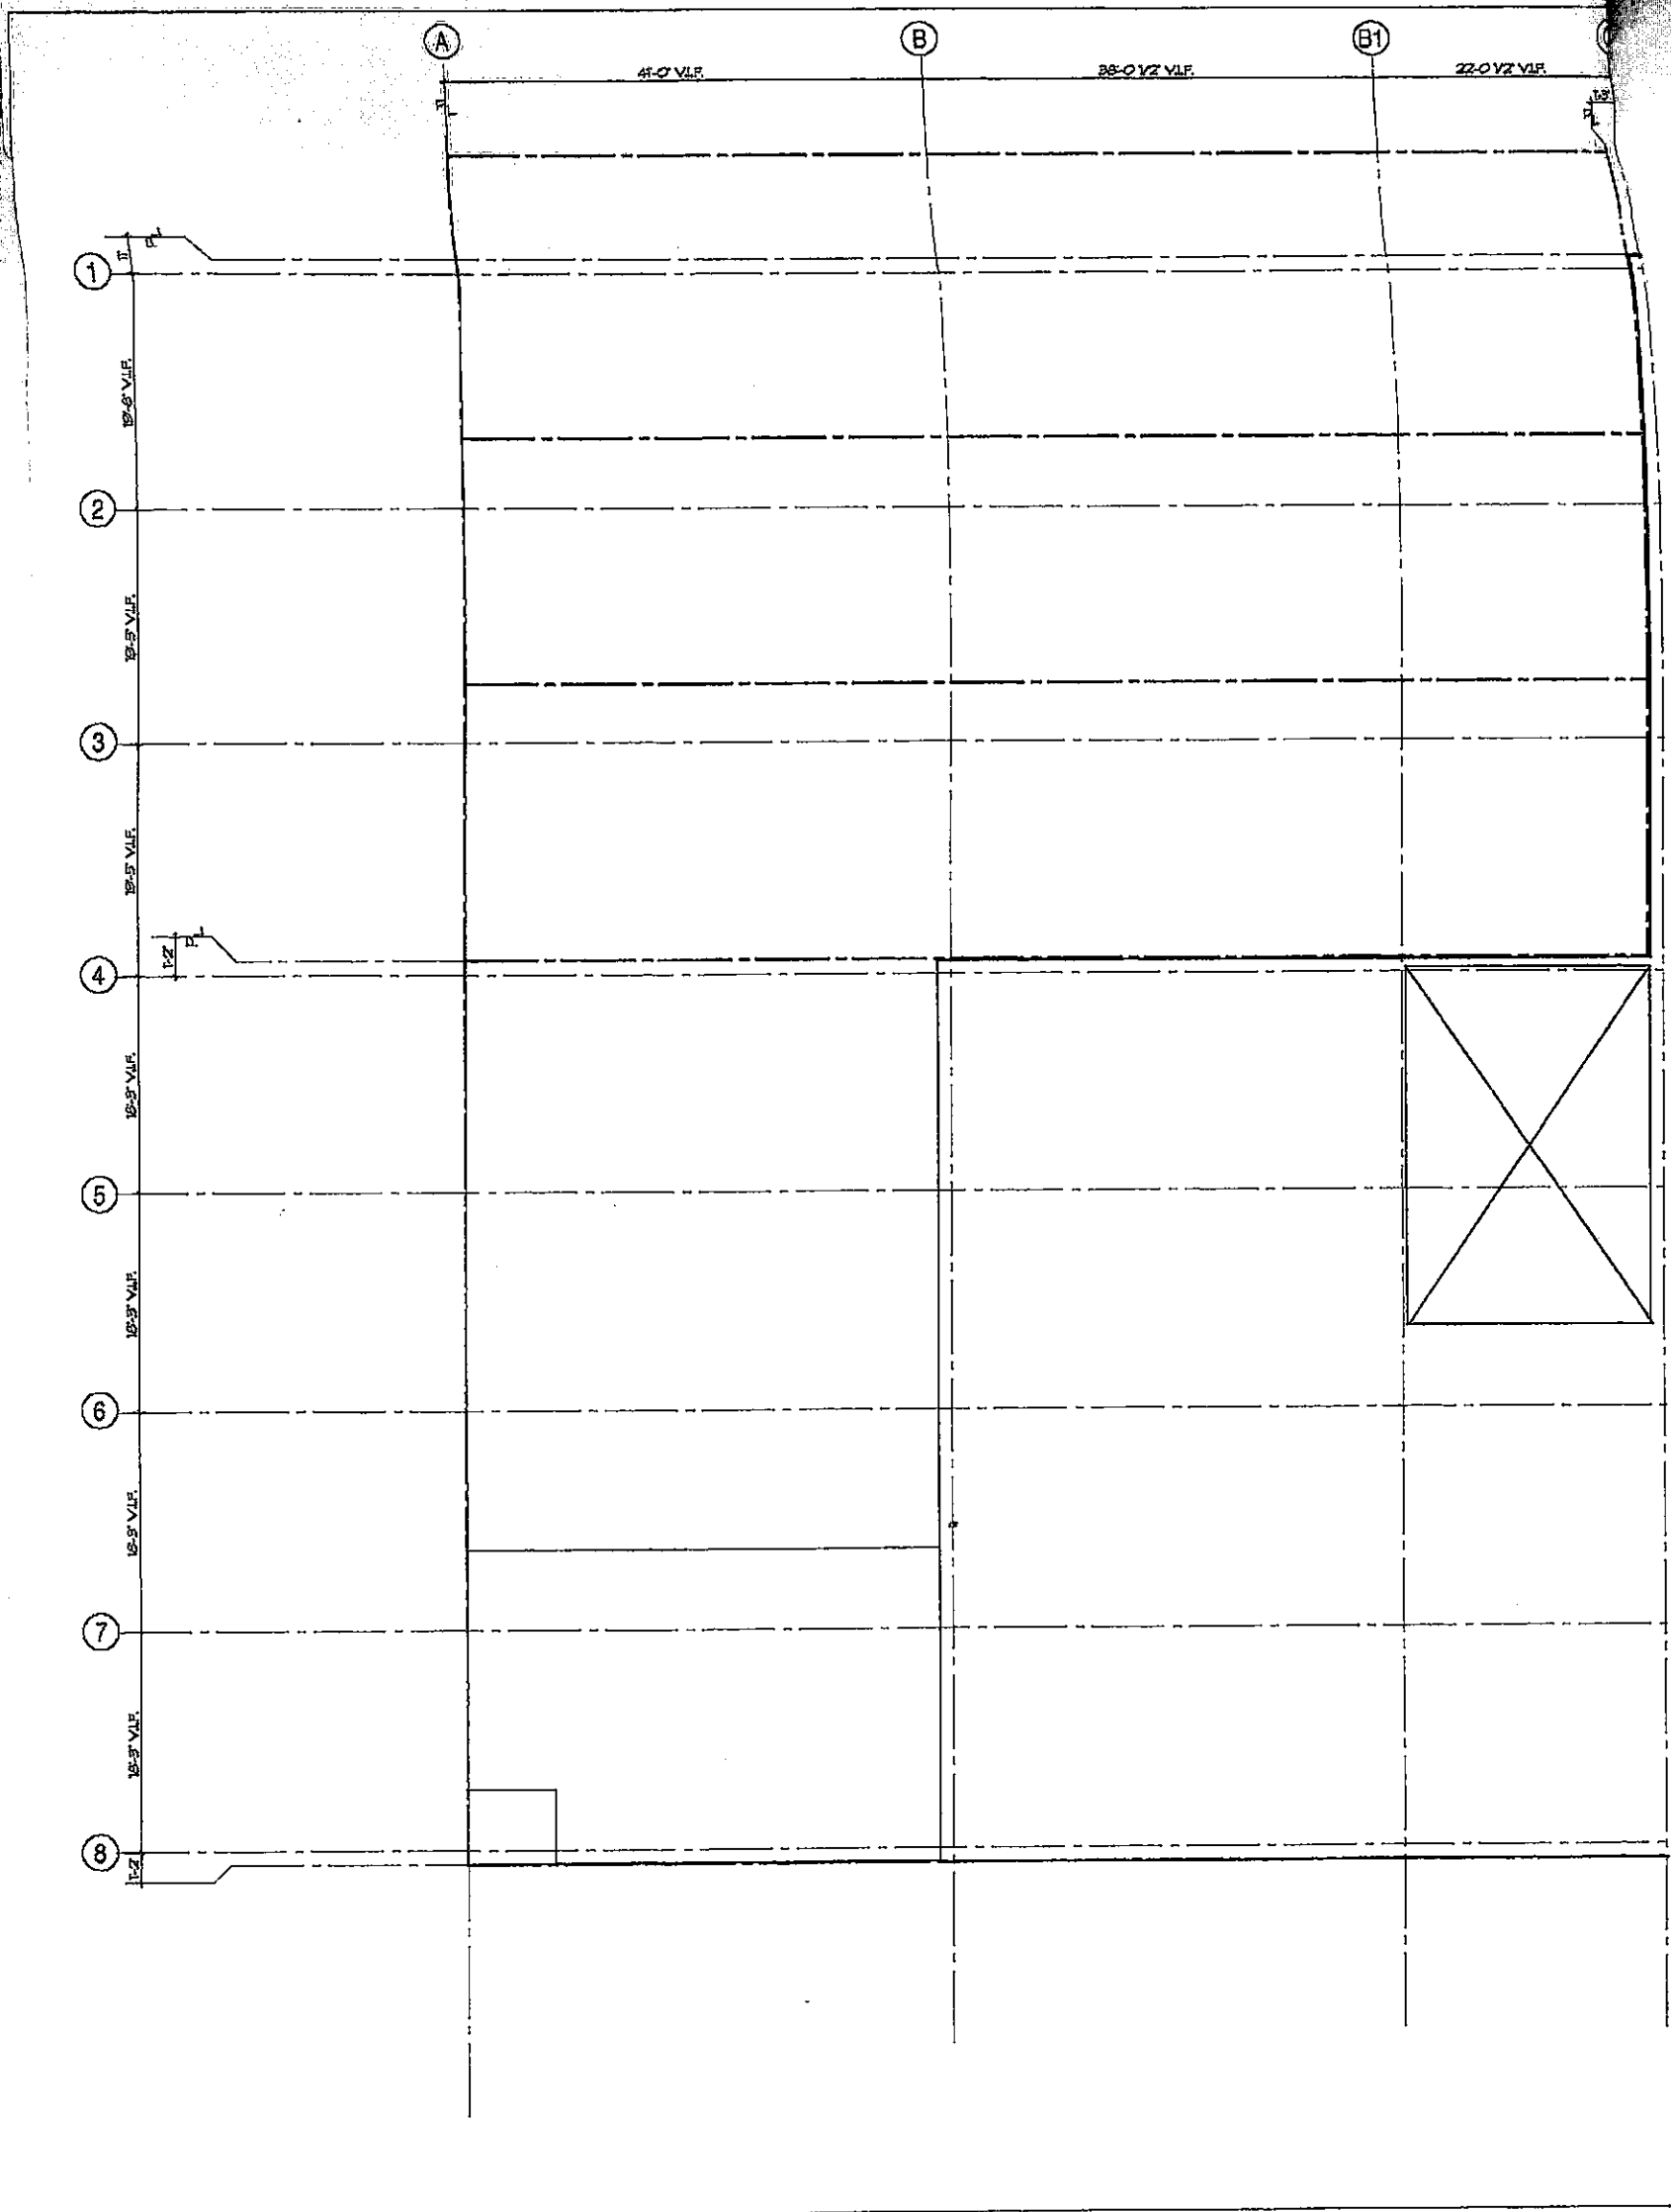

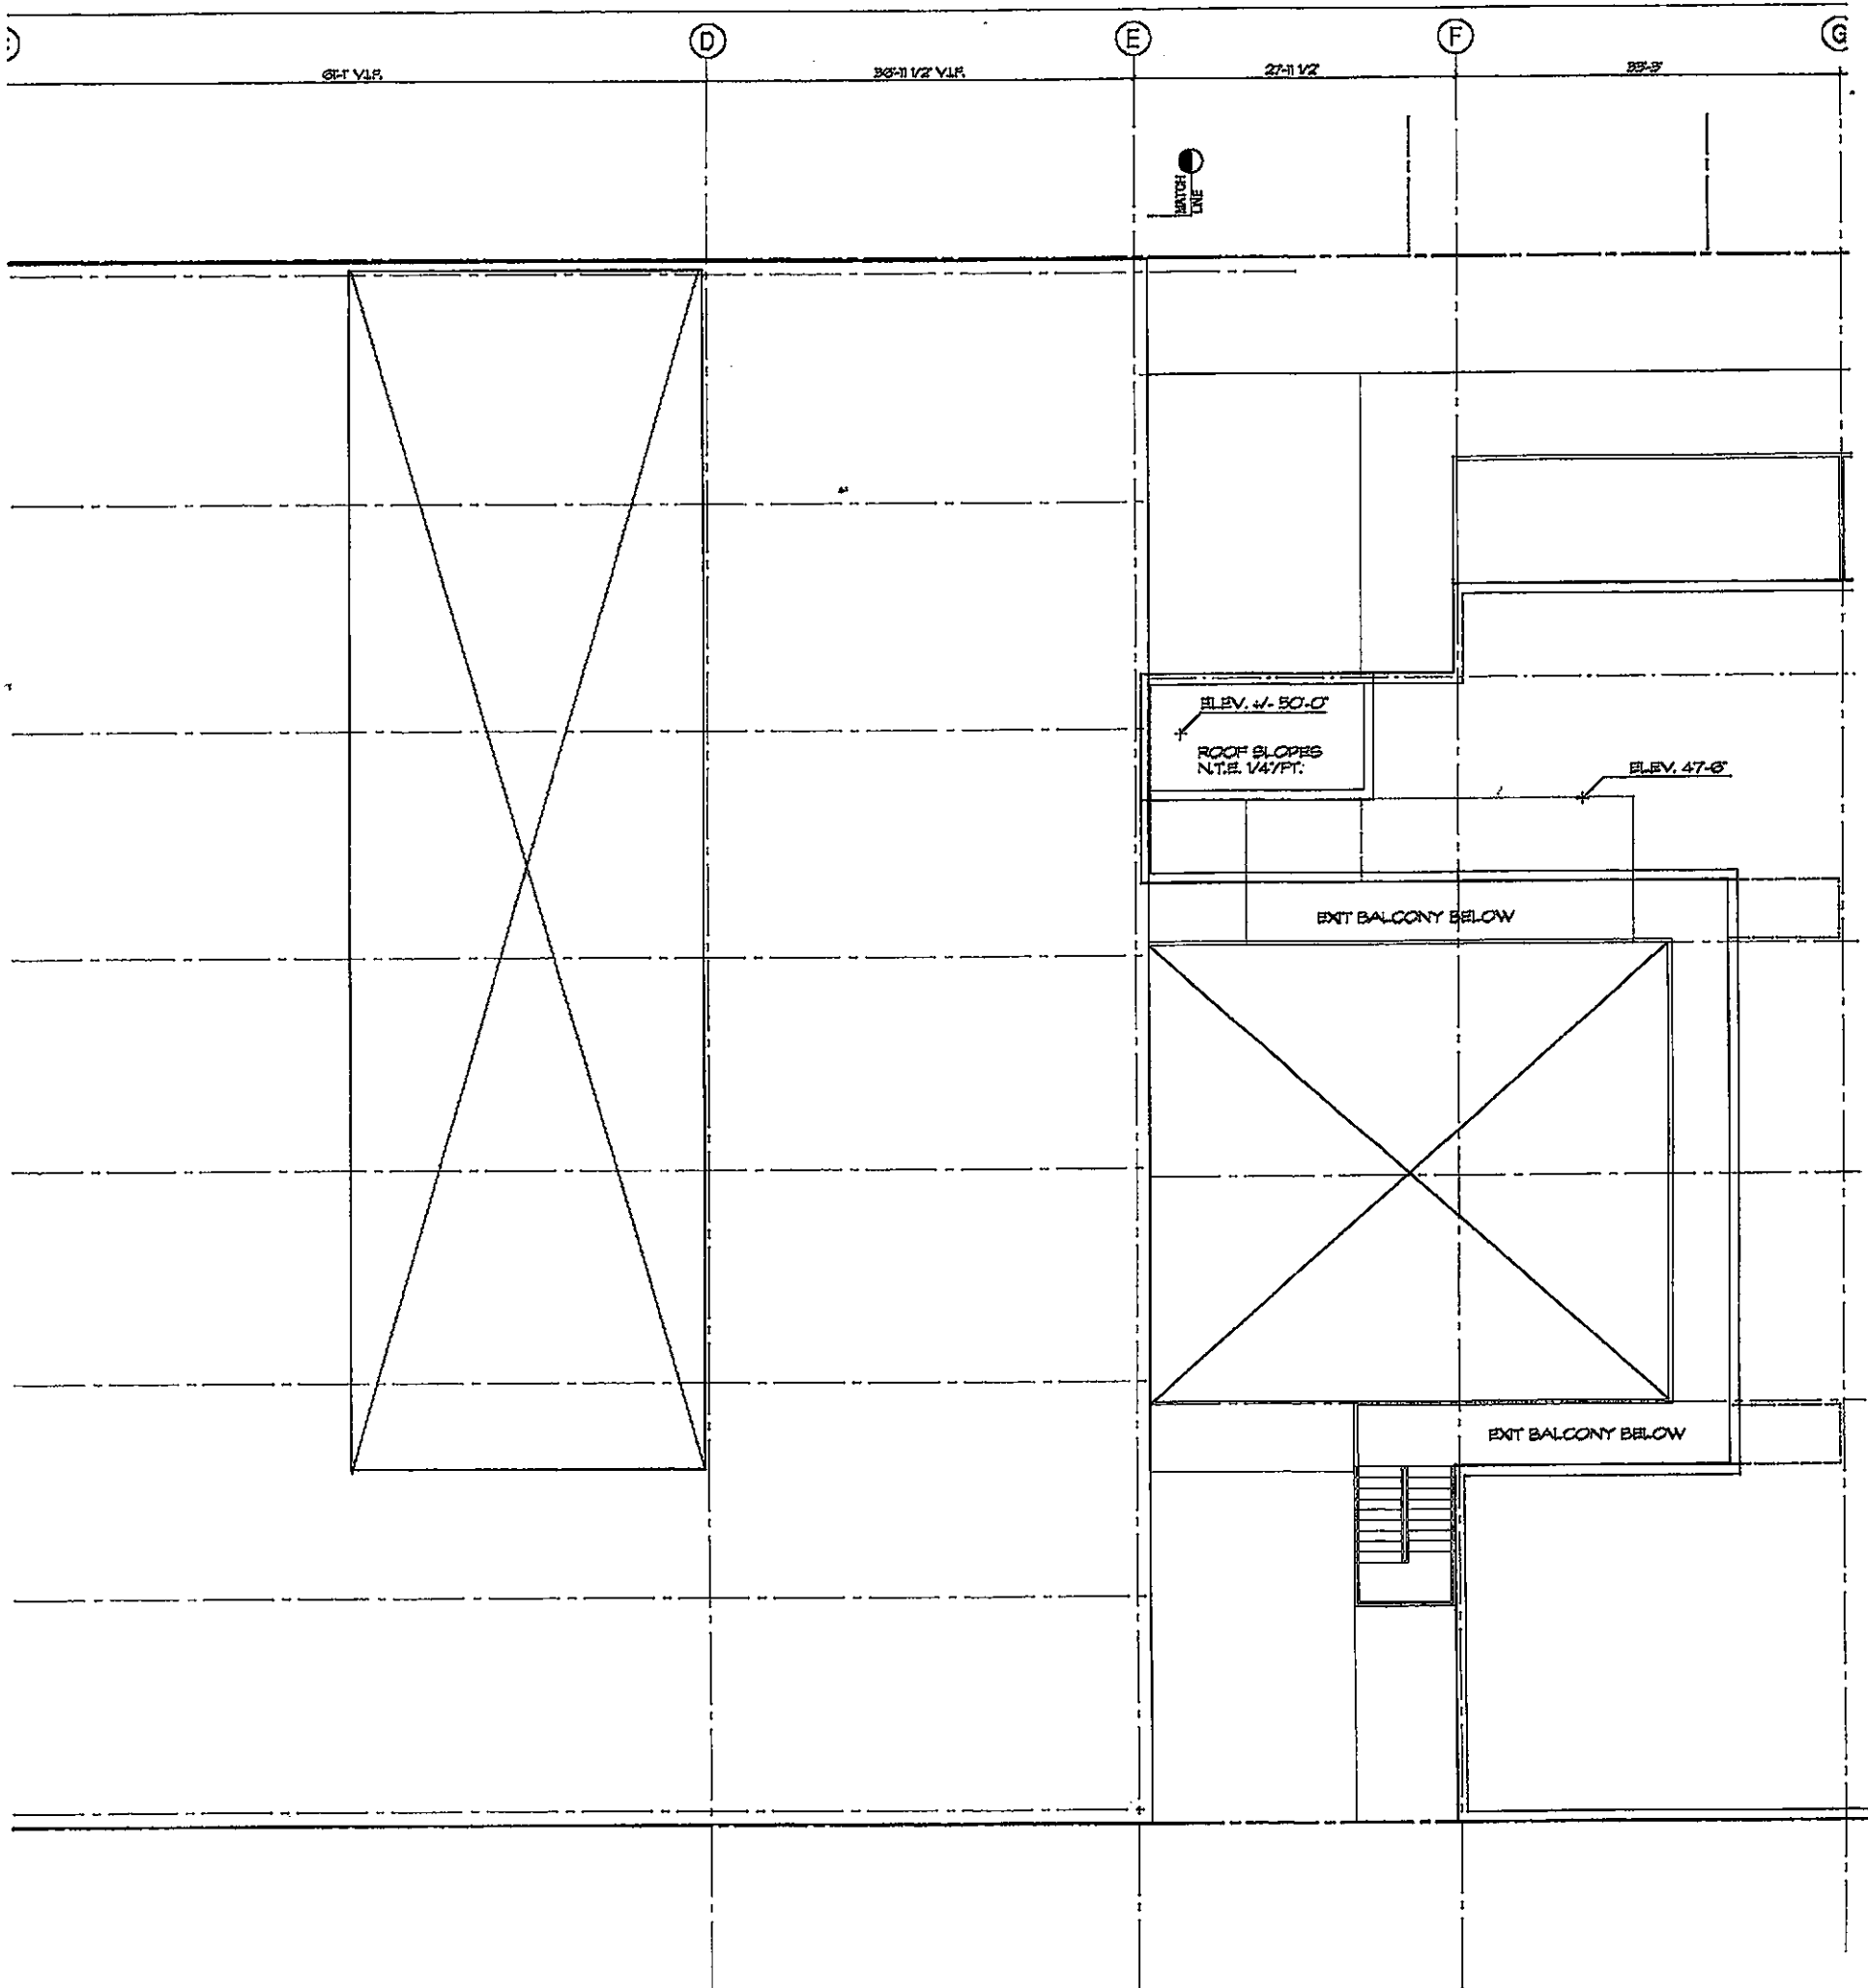

1 ROOF PLAN
1/8" = 1'-0"

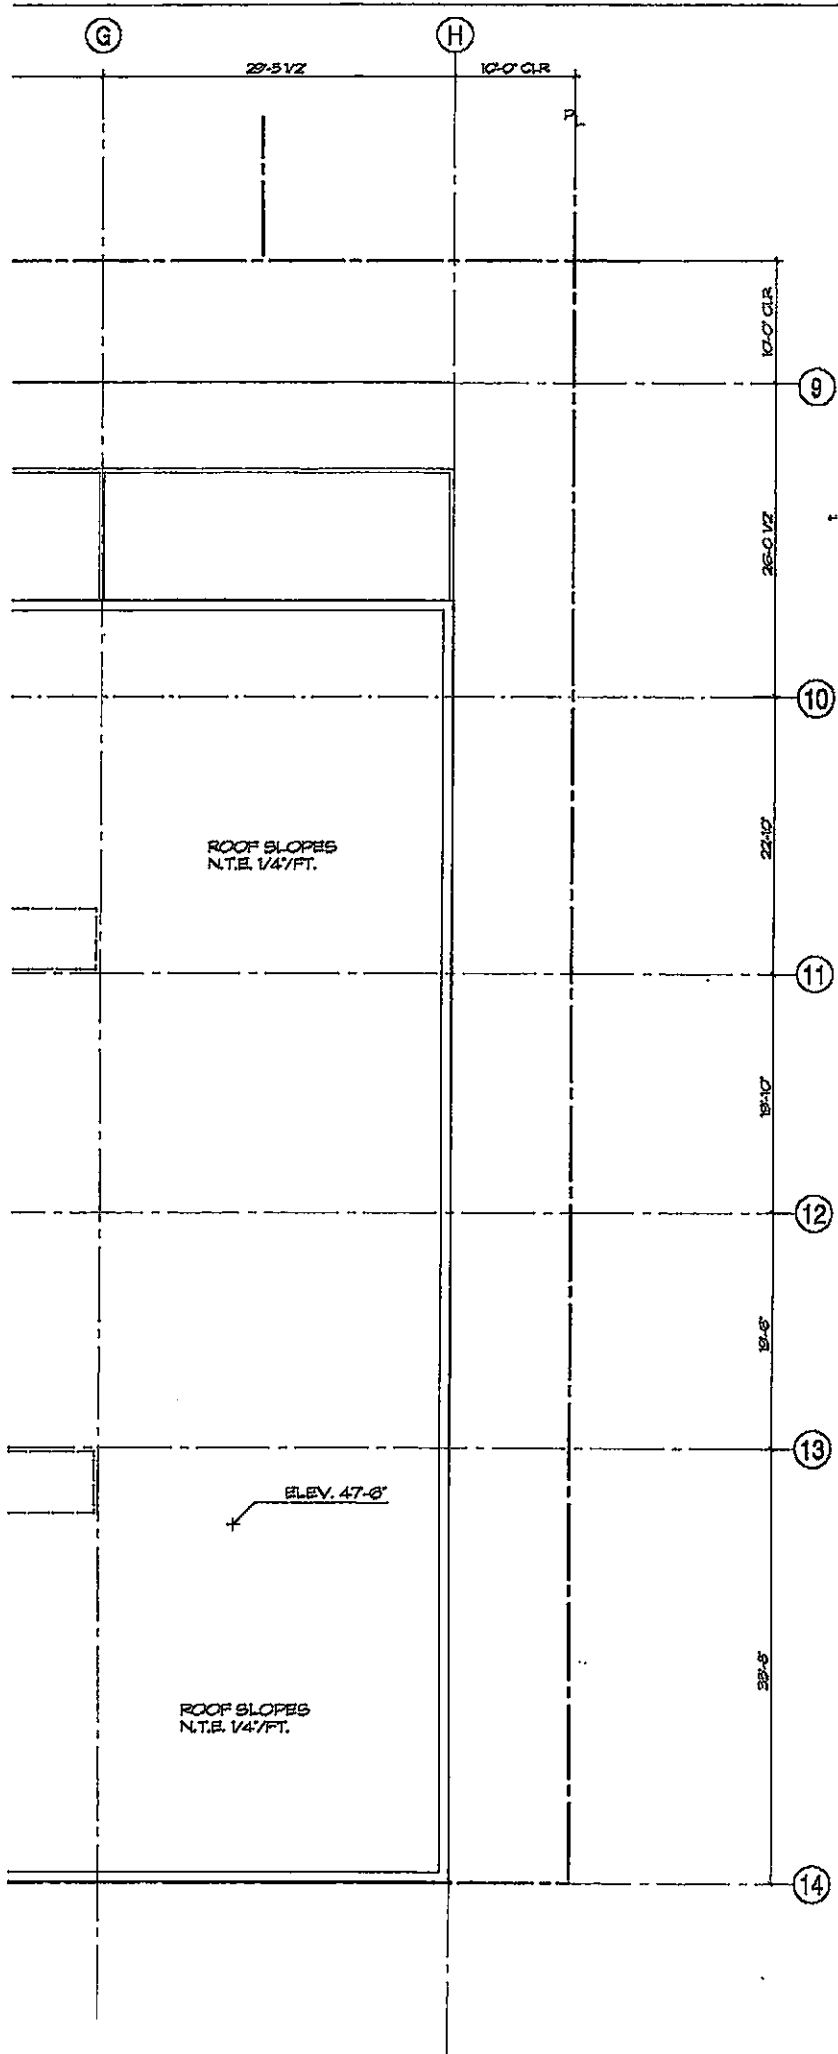

TDA

**Thomas Dolan
Architecture**

Architecture
Urban Design
Planning and
Development Consultation

tel. (510) 839 7200
fax. (510) 839 7208
td.arch@live-work.com
www.live-work.com

Embarcadero West
173 Filbert Street
Oakland, California
94607 U.S.A.



**FOUNDRY
LOFTS**

2868 HANNAH ST.
OAKLAND, CA

**2868 HANNAH ST.
ROOF PLAN**

ISSUE	DESCRIPTION	DATE
	AS BUILT SET	04-01-01
	DESIGN REVIEW SET	06-05-01
	SCHEMATIC DESIGN SET	07-02-01

DATE: 07-02-01

JOB NO. 01.116

DRAWN CPC

SHEET NO. **A2.61**